




FILE NAME = Y:\P\c\as\ANY\X2\22425\CADD\MSTN\10b214.bethel.xc.dgn
 DATE/TIME = 3/17/2014
 USER = 4916

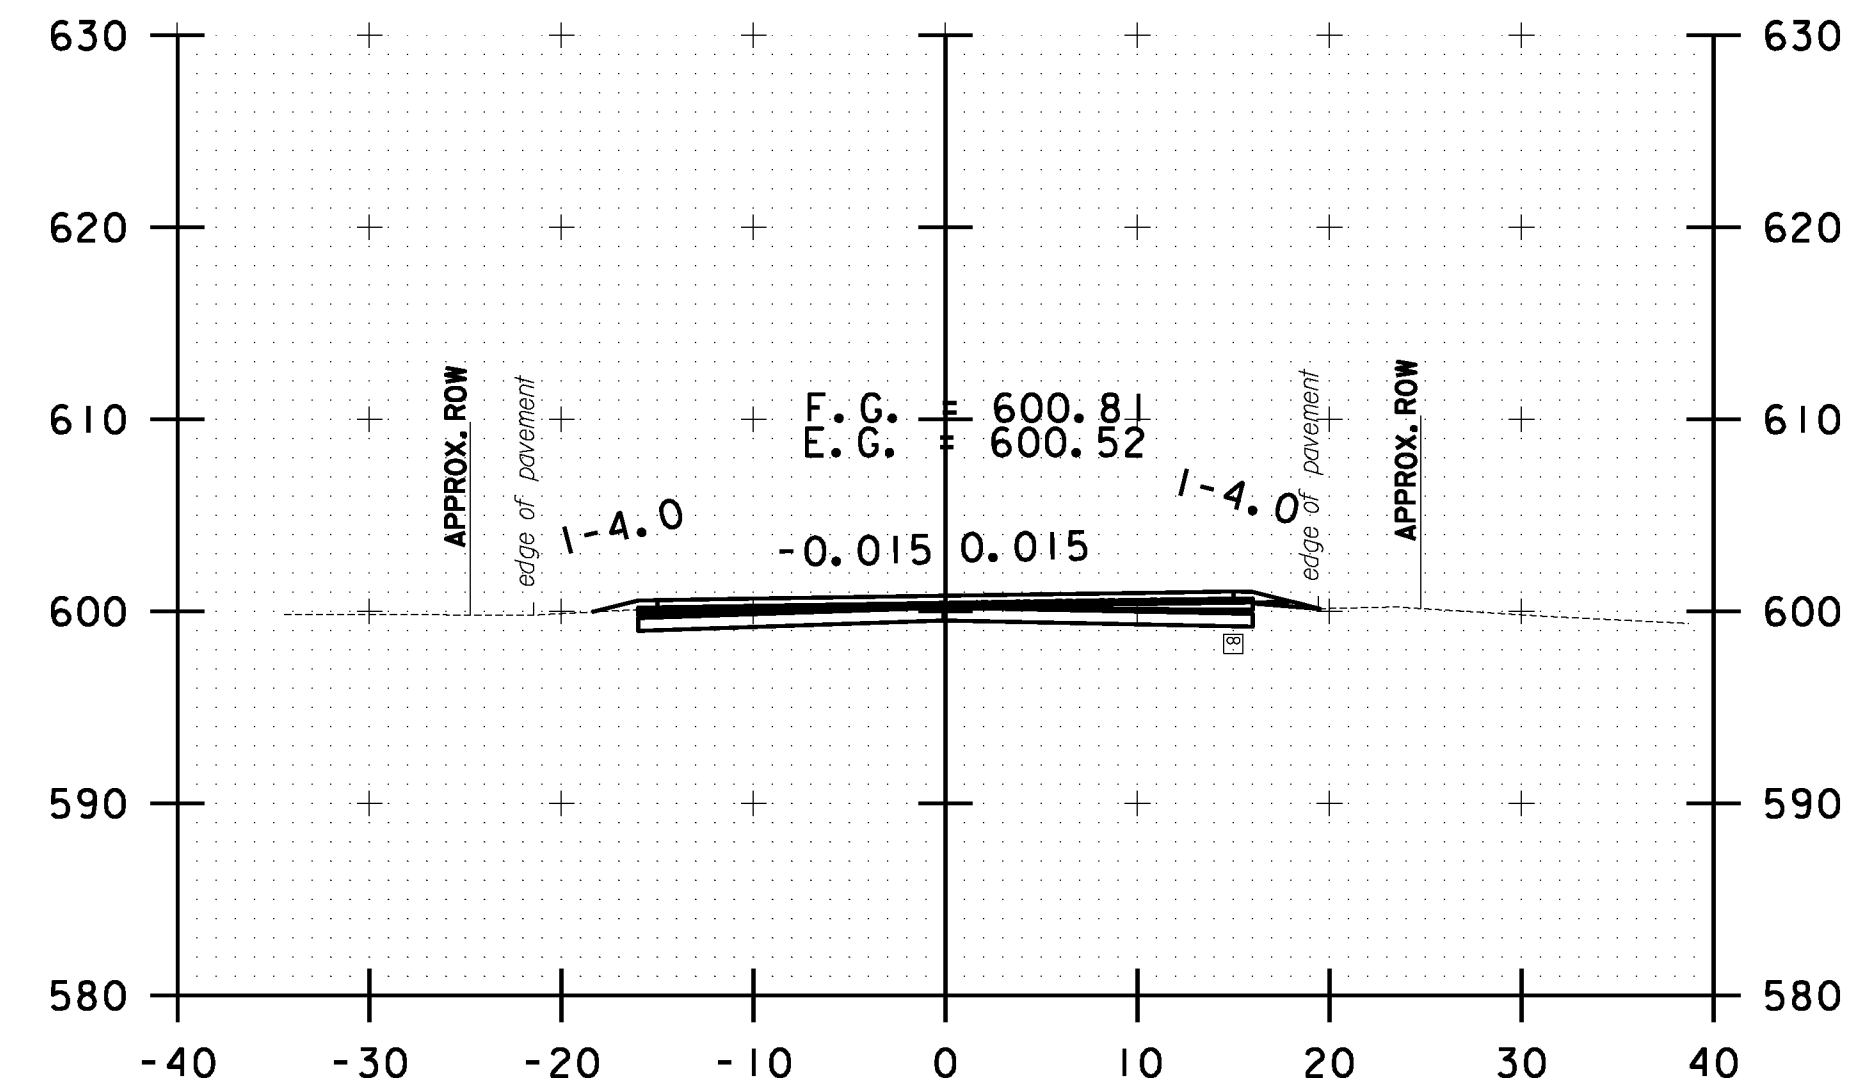


B 39+50.00

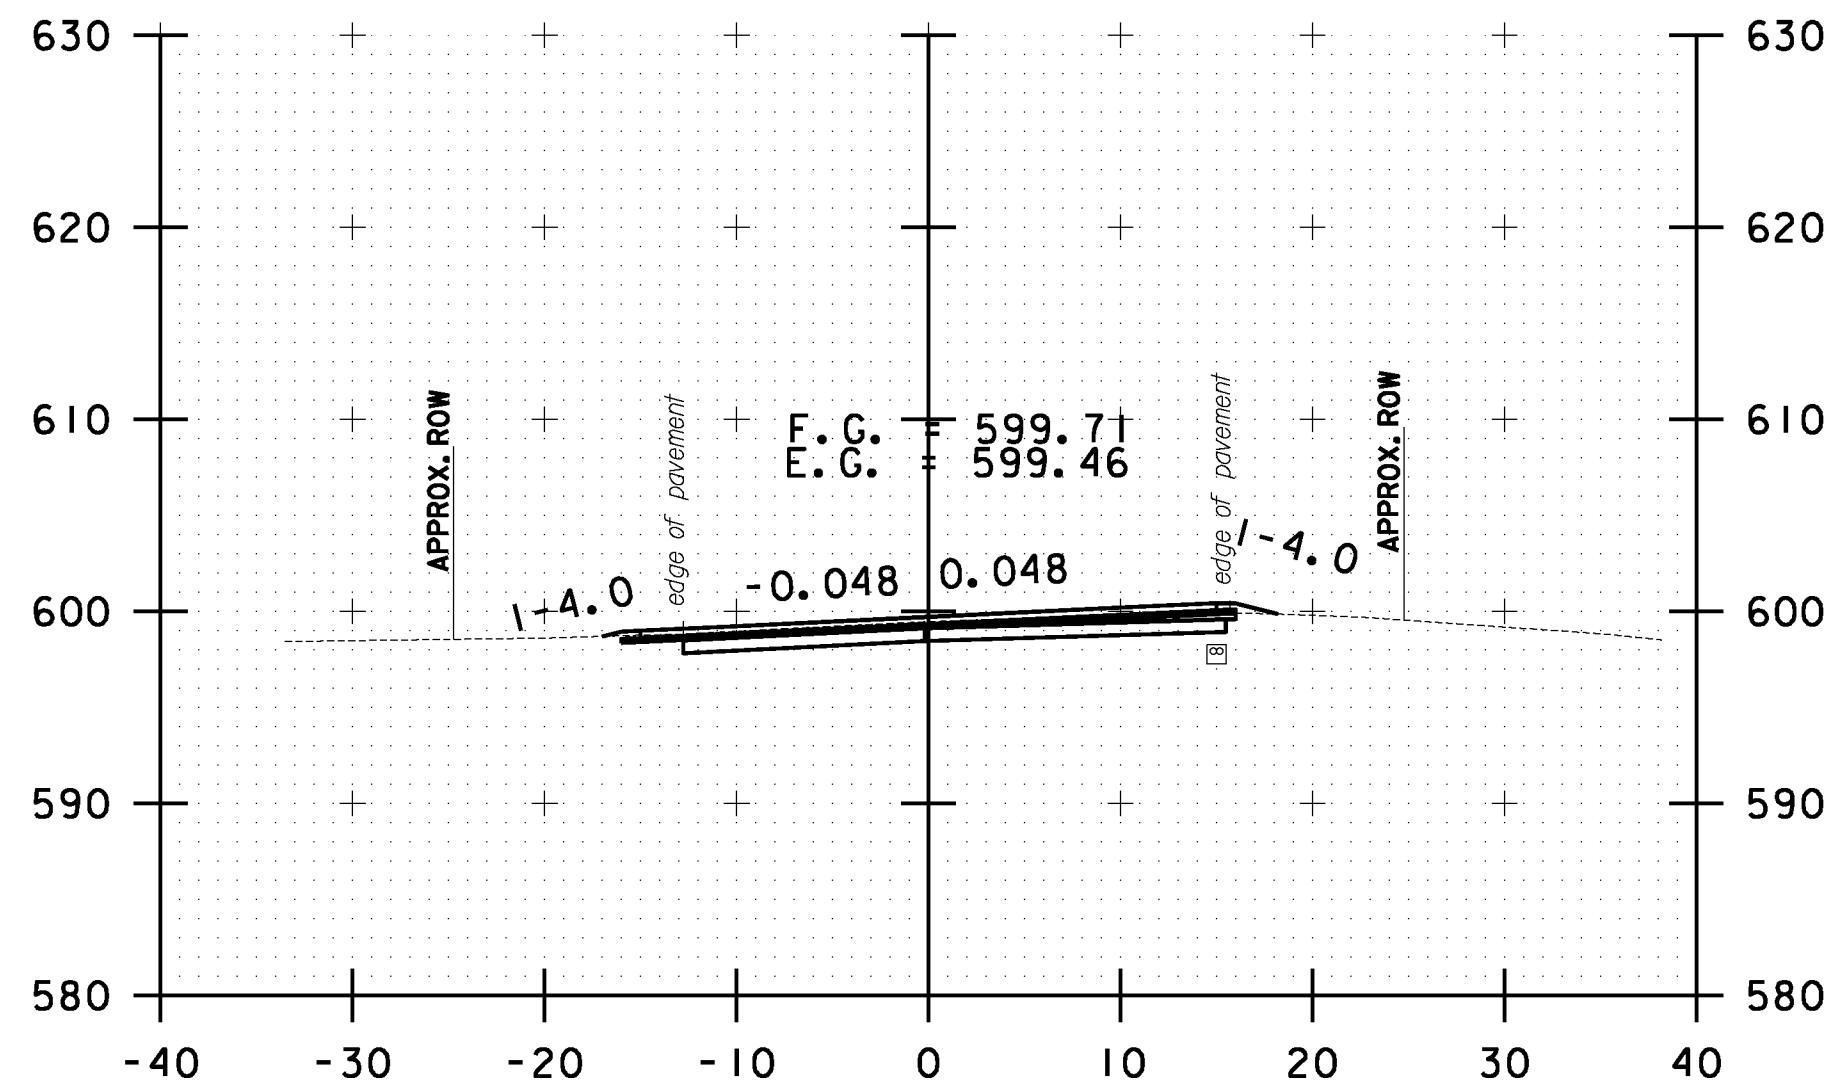


B 40+50.00

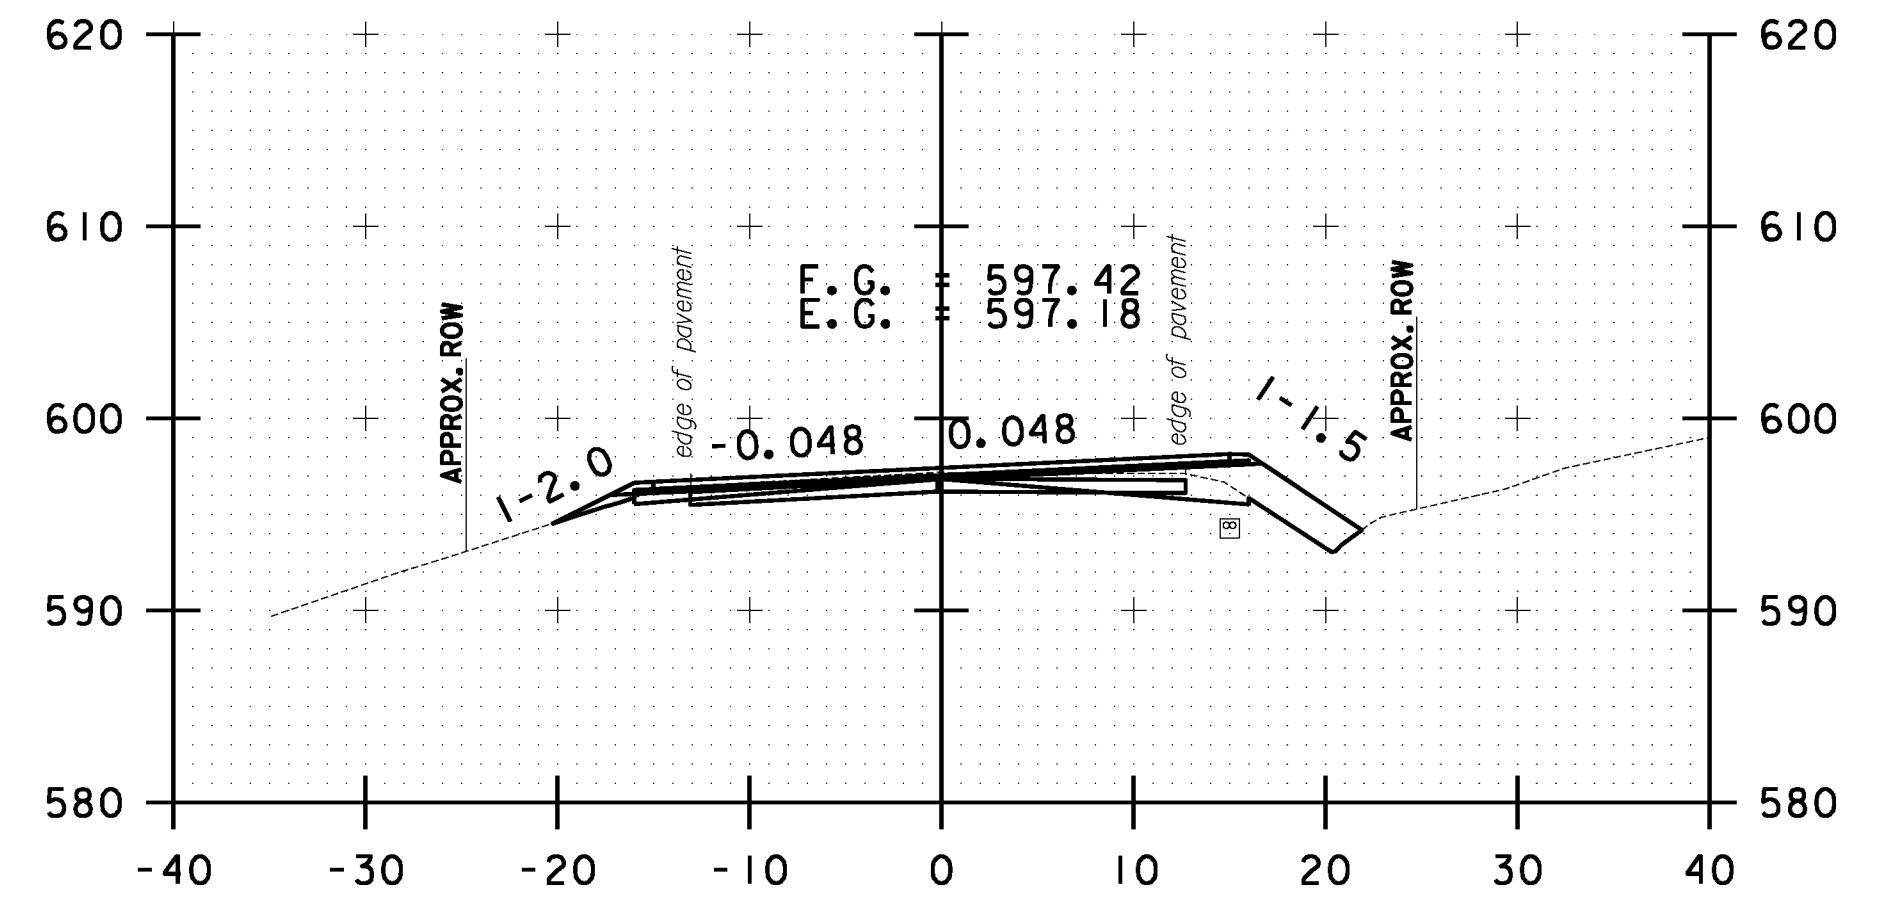


B 42+00.00

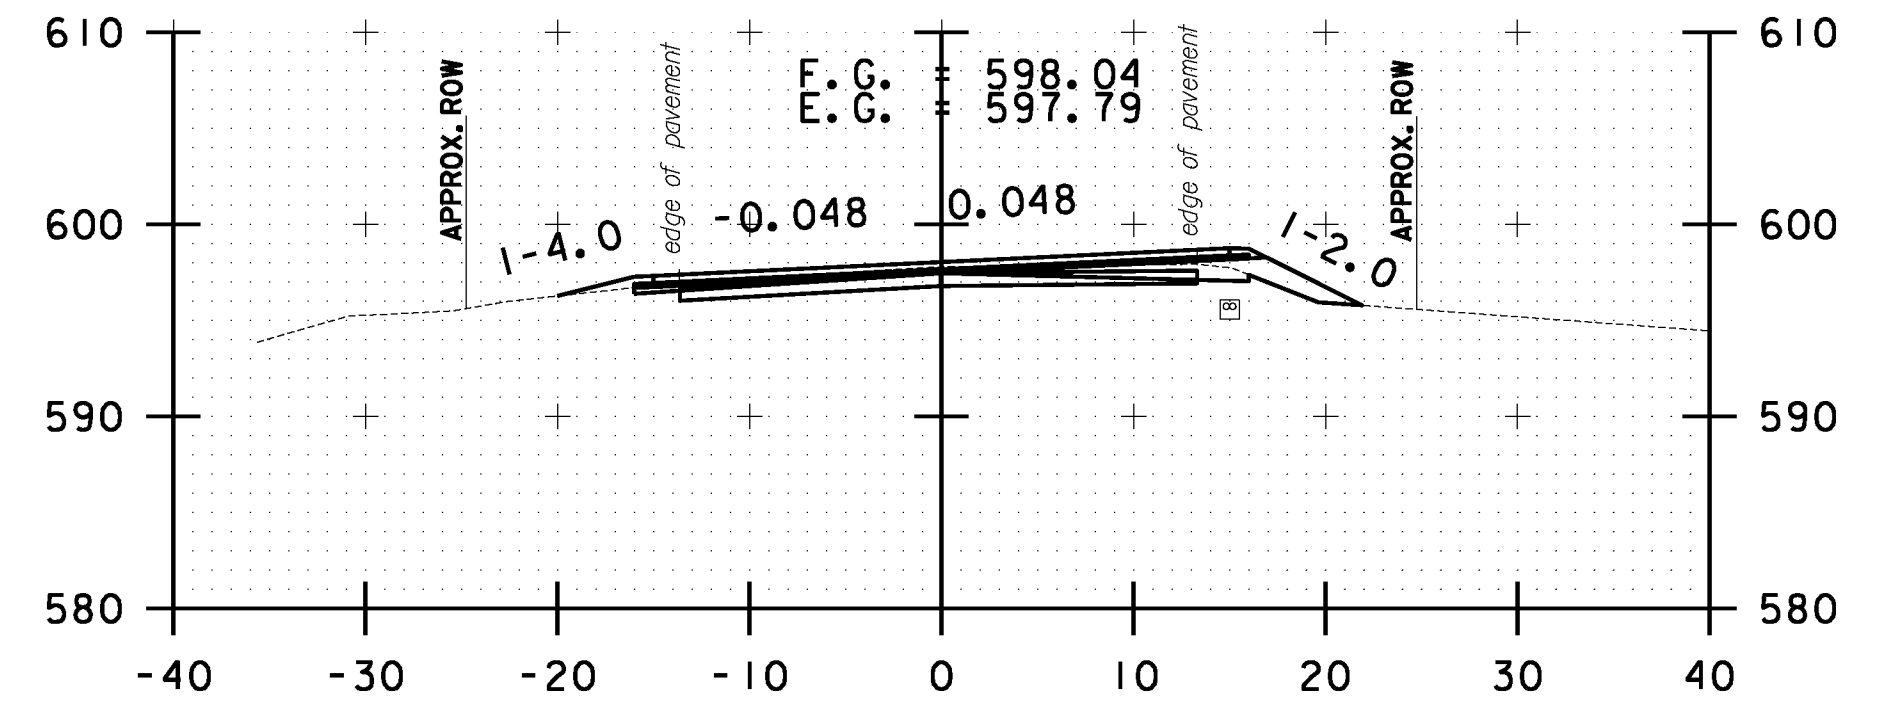


B 41+50.00

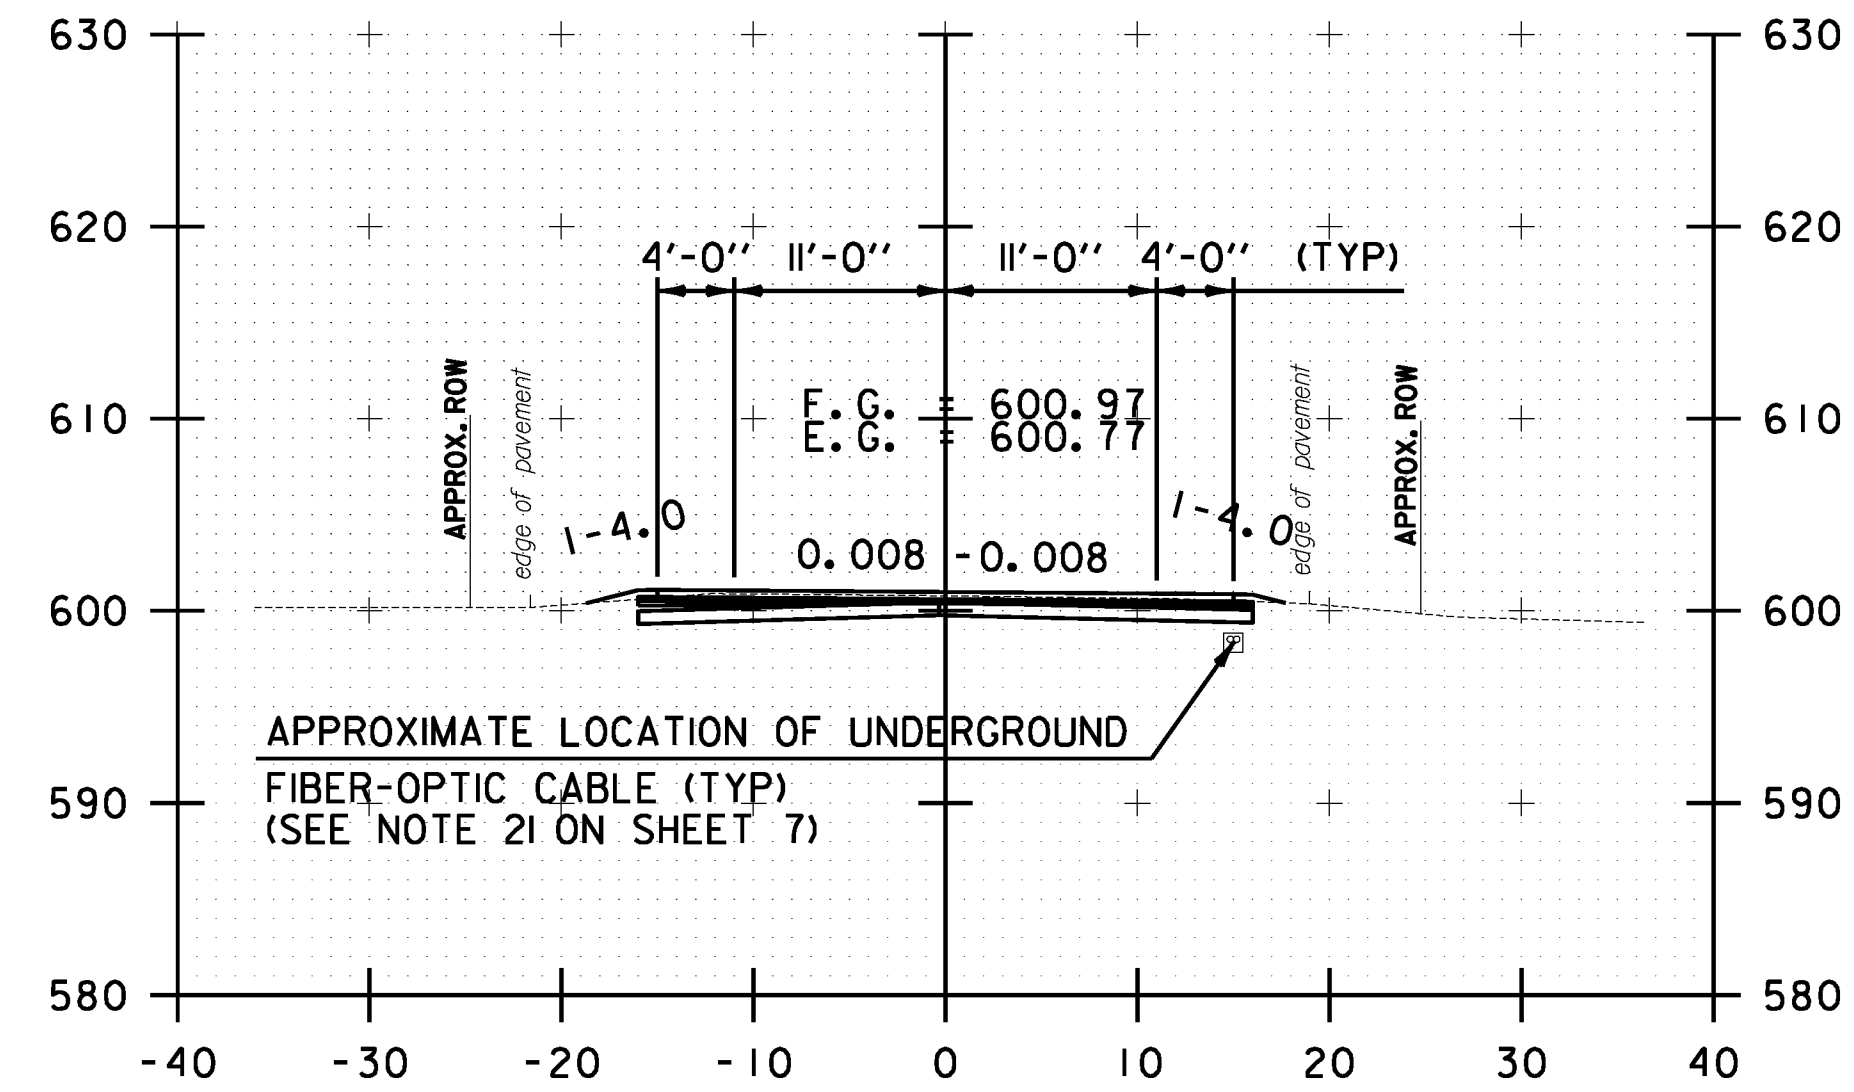

B 39+00.00

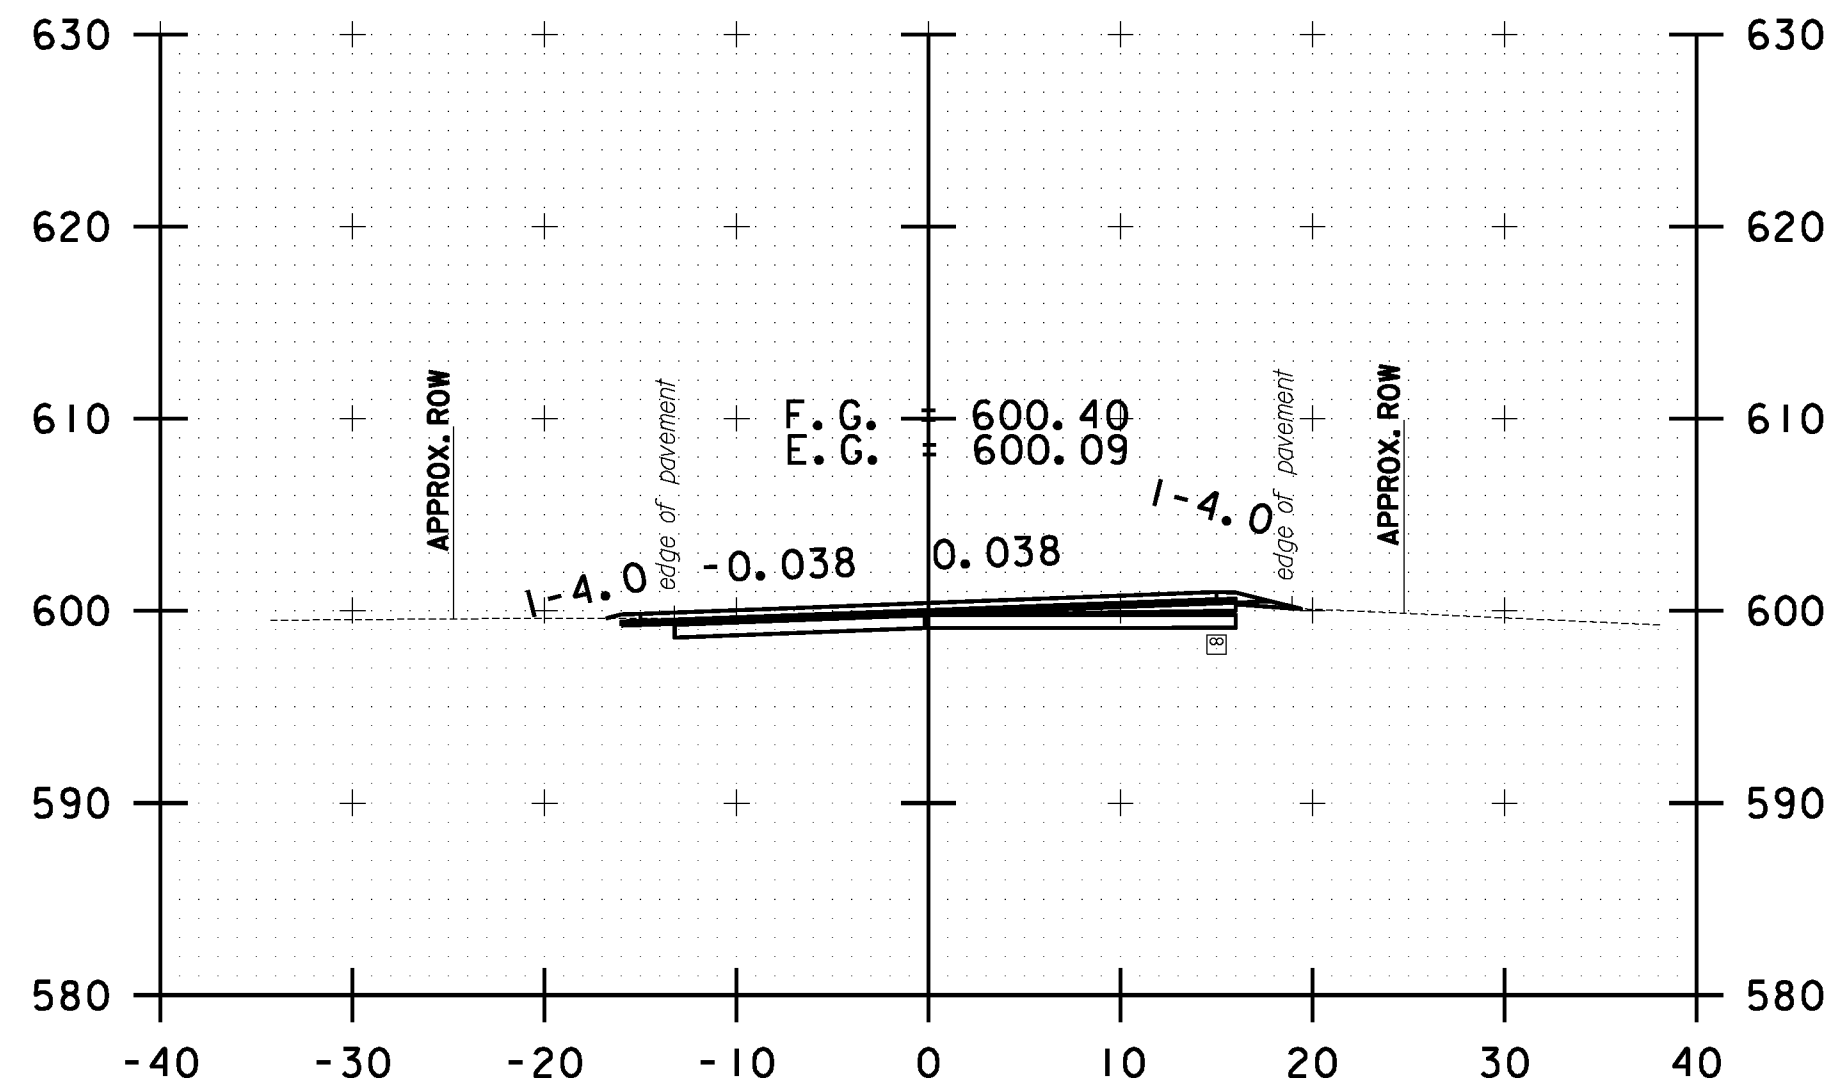

B 40+00.00

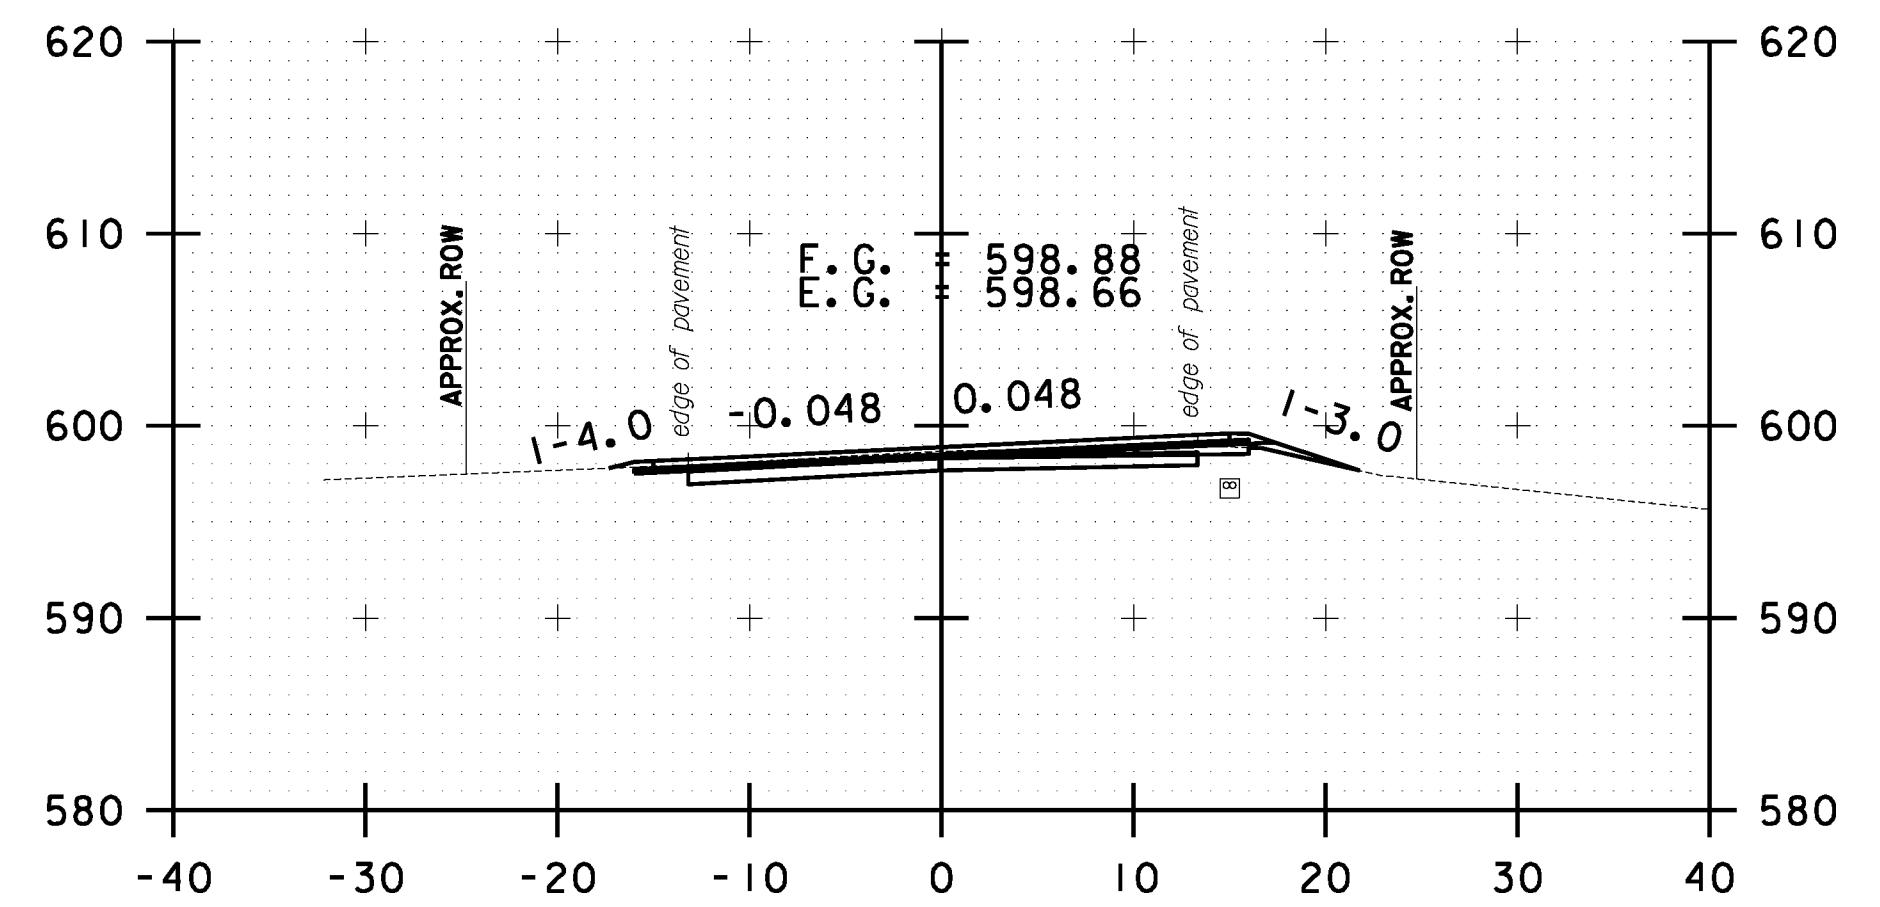

B 41+00.00



BETHEL CROSS SECTION SHEET #14	PROJECT NAME: STOCKBRIDGE-BETHEL
	PROJECT NUMBER: STP 2910(1)
	FILE NAME: z10b214.bethel.xc.dgn
	IPARM FILE: z10b214xs126.1
	PLOT DATE: 3/17/2014
	DRAWN BY: W.C.P.
	CHECKED BY: J.P.S.
	SHEET 339 OF 397