




FILE NAME = Y:\P\c\as\1\NY\2\22425\CADD\1\STN\10b214.bethel.xc.dgn
 DATE/TIME = 3/17/2014
 USER = 4916

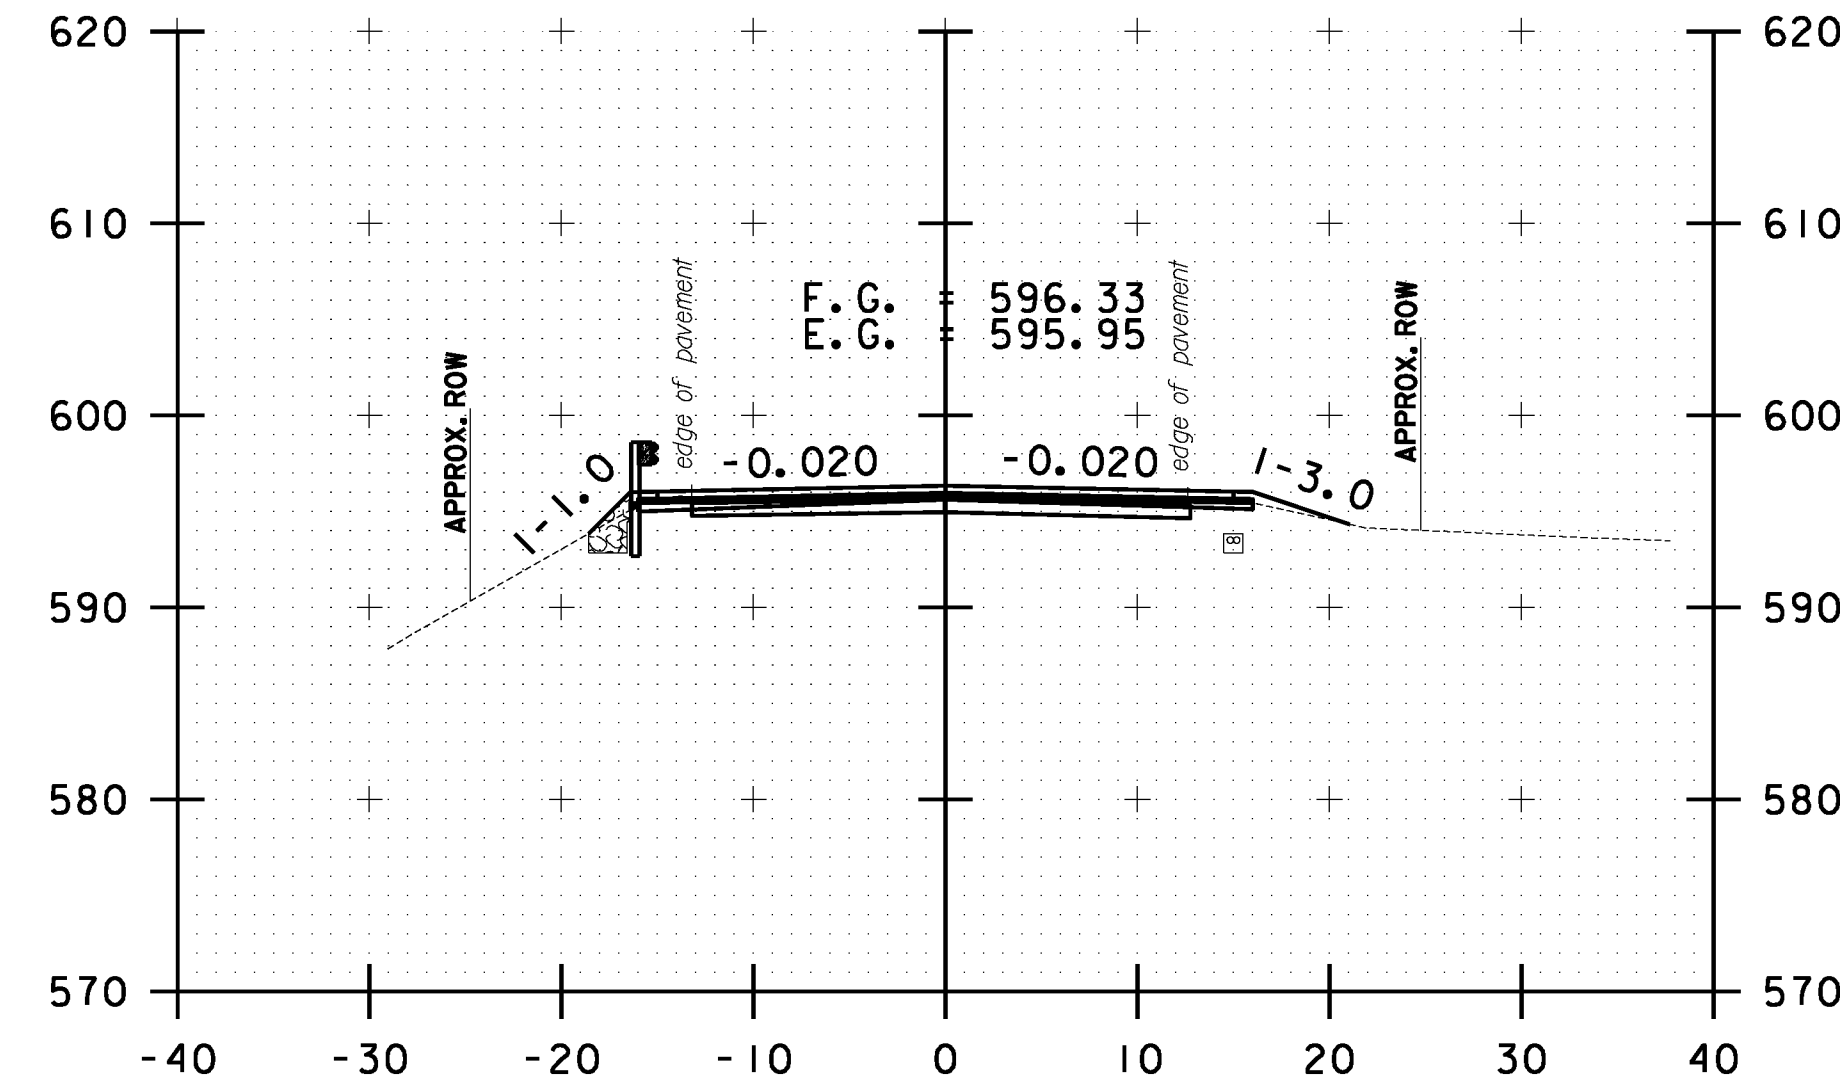


B 45+00.00

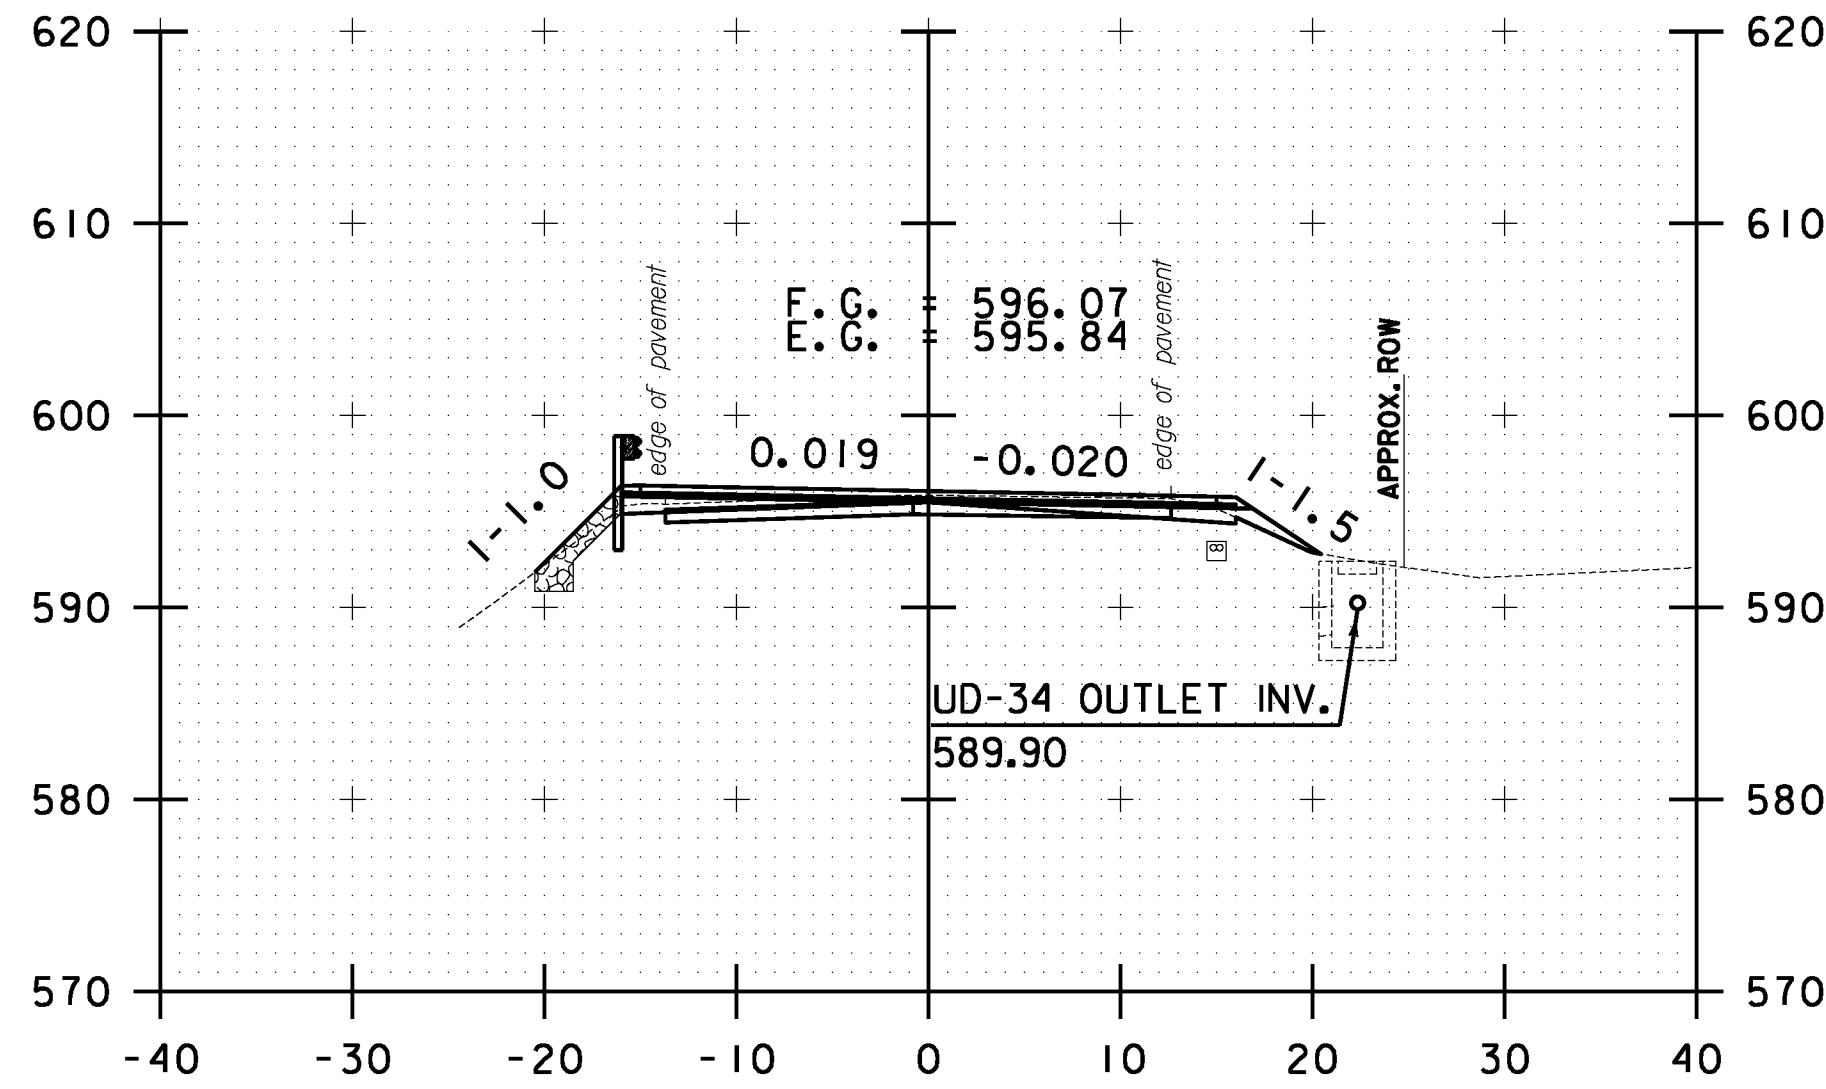


B 46+00.00

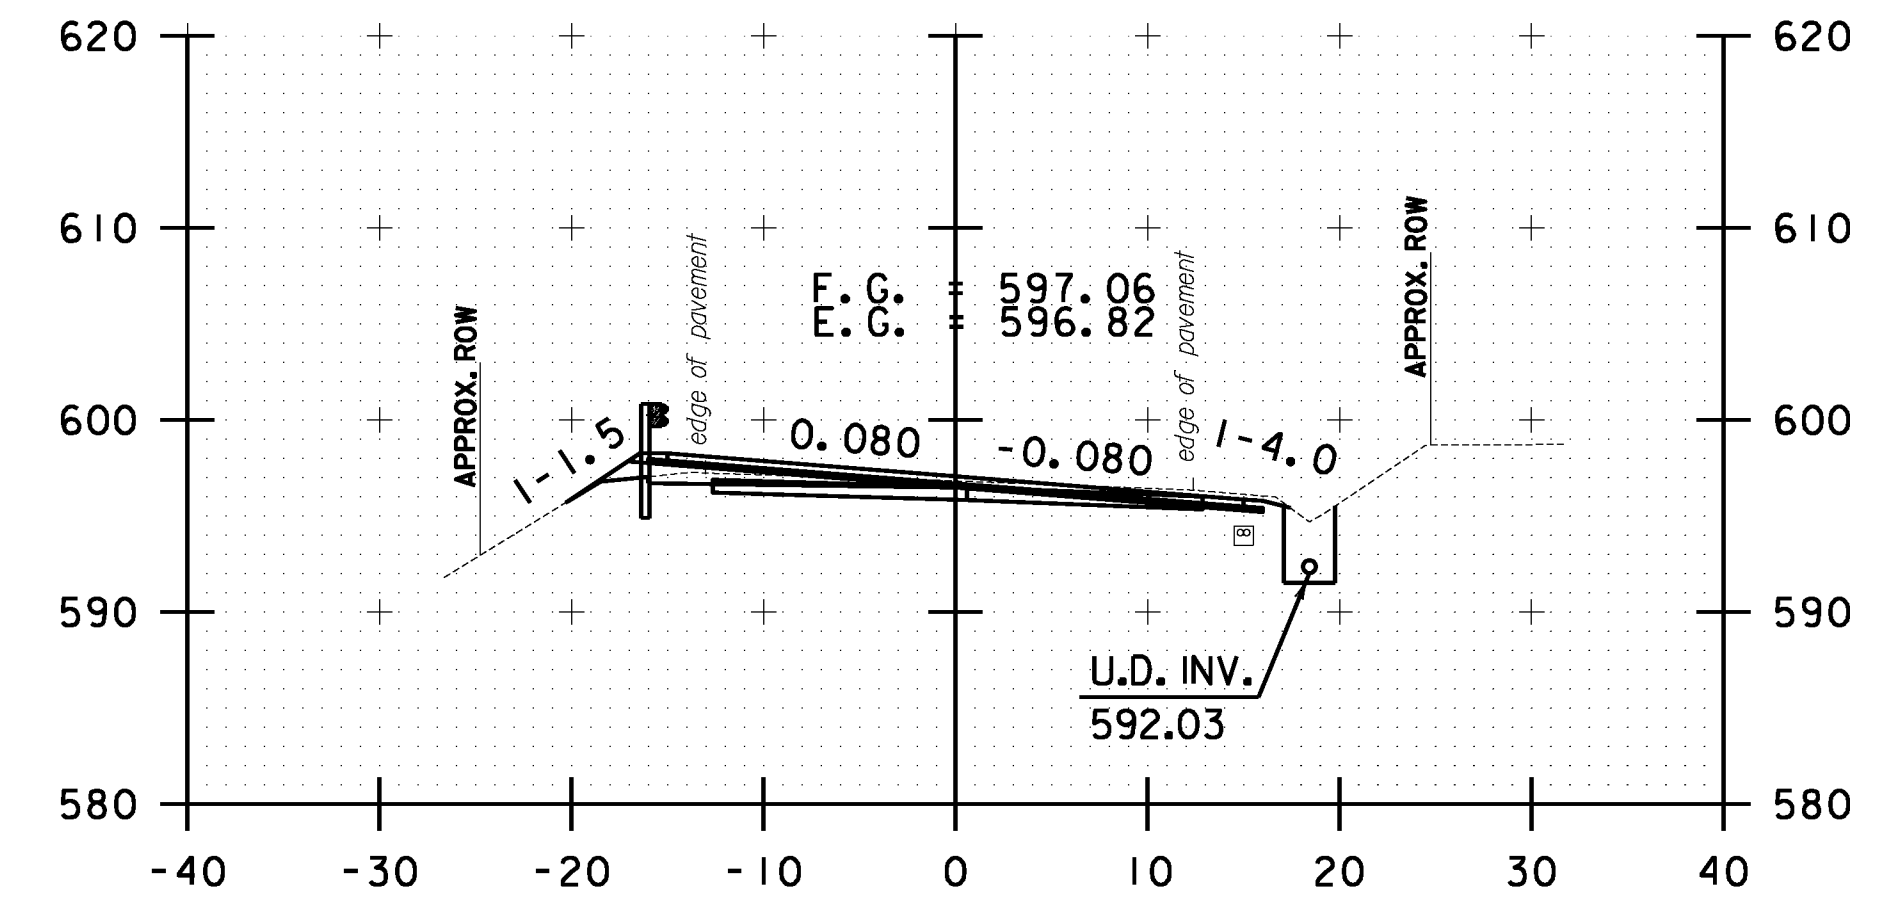


B 47+50.00

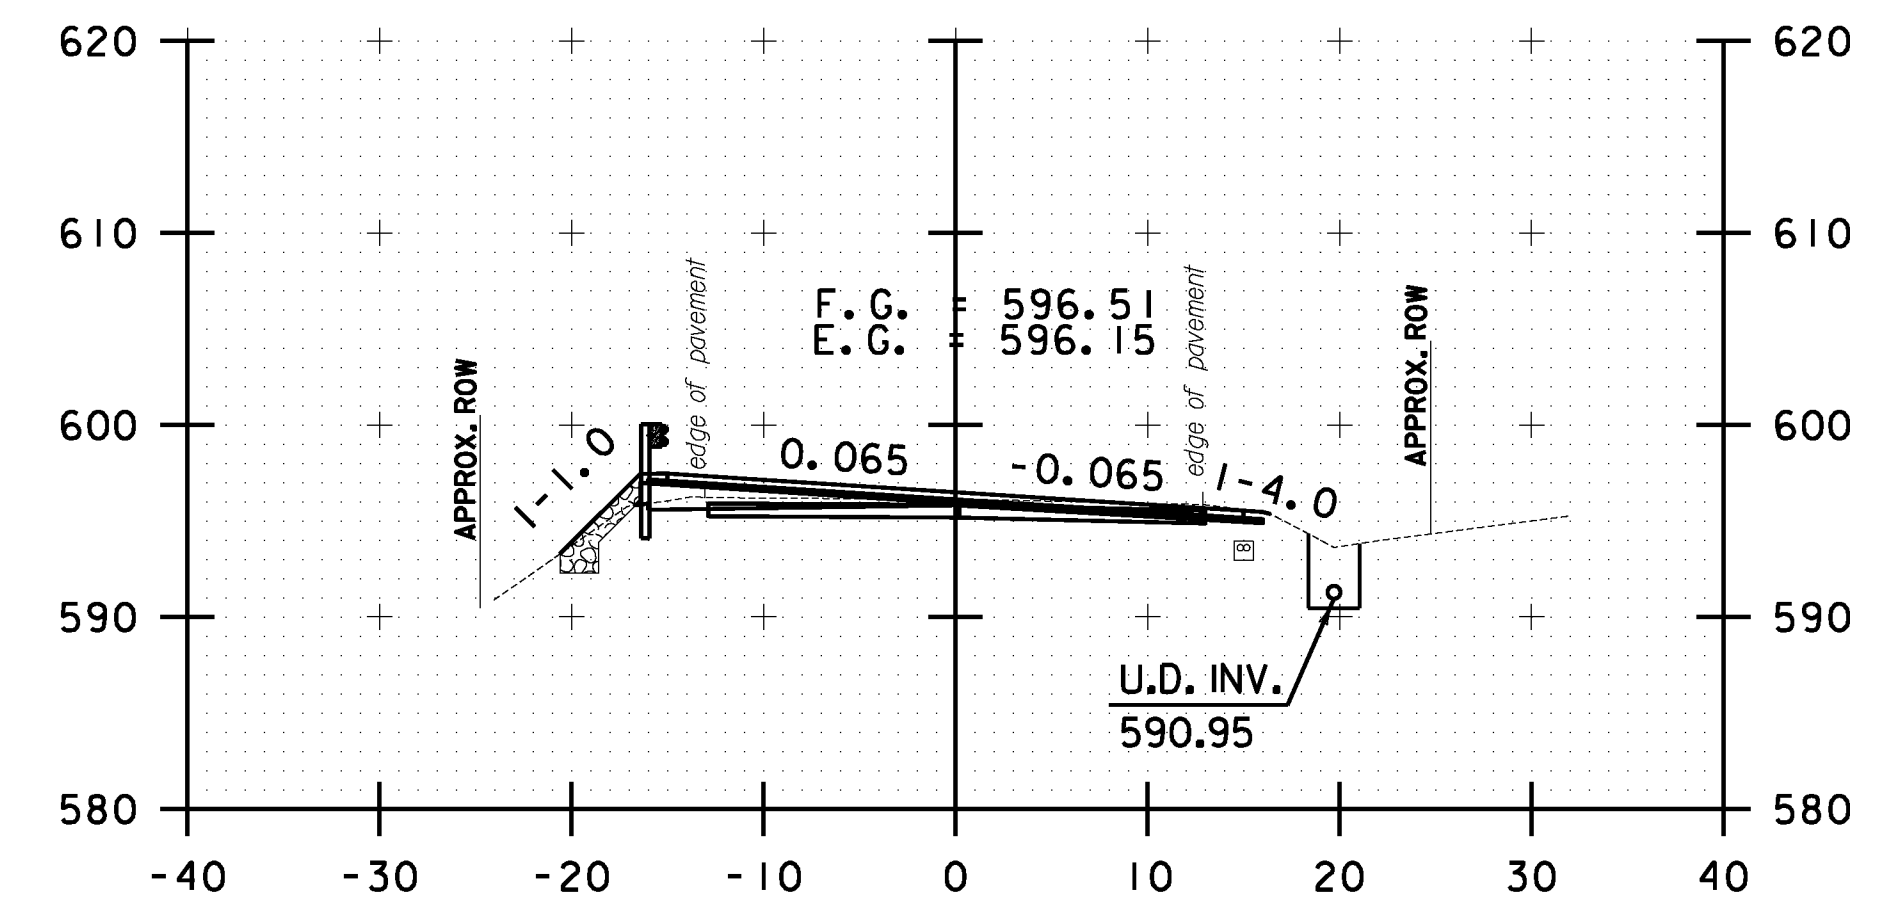


B 47+00.00

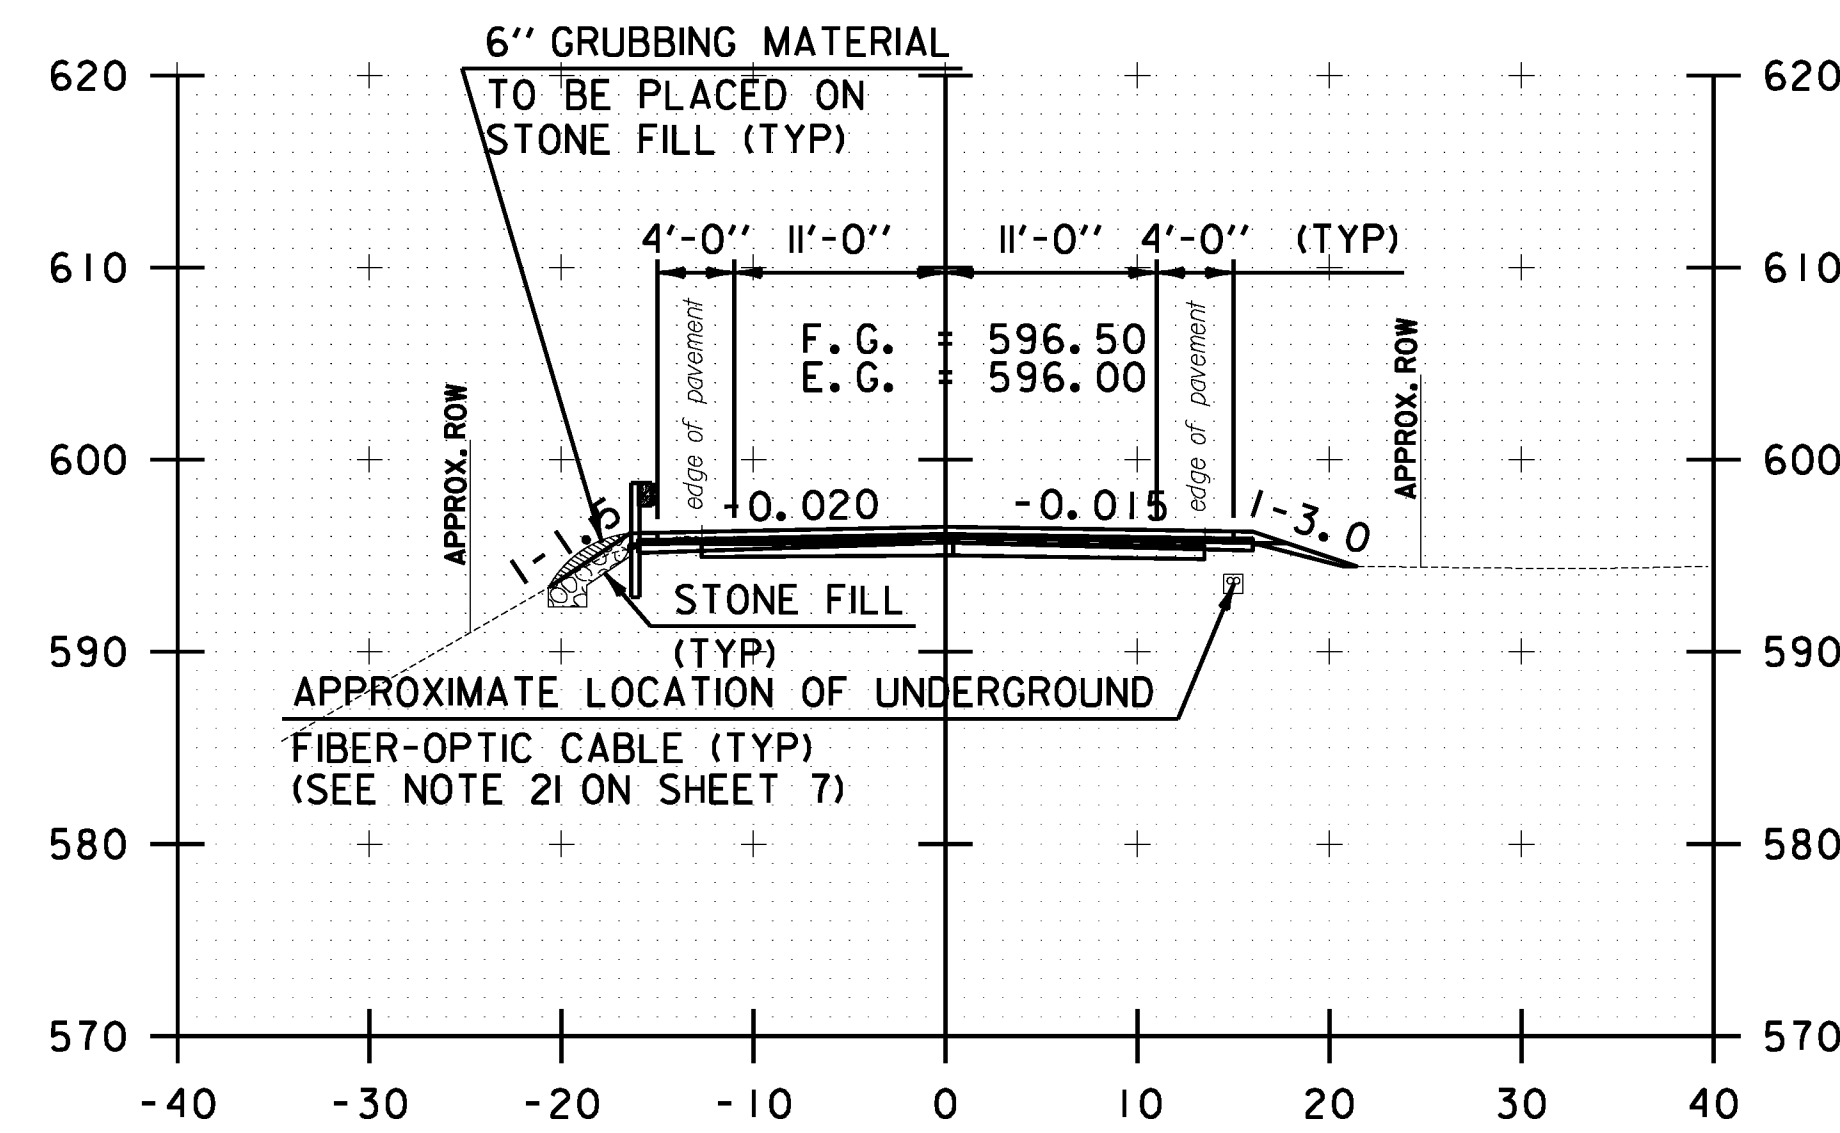

B 44+50.00

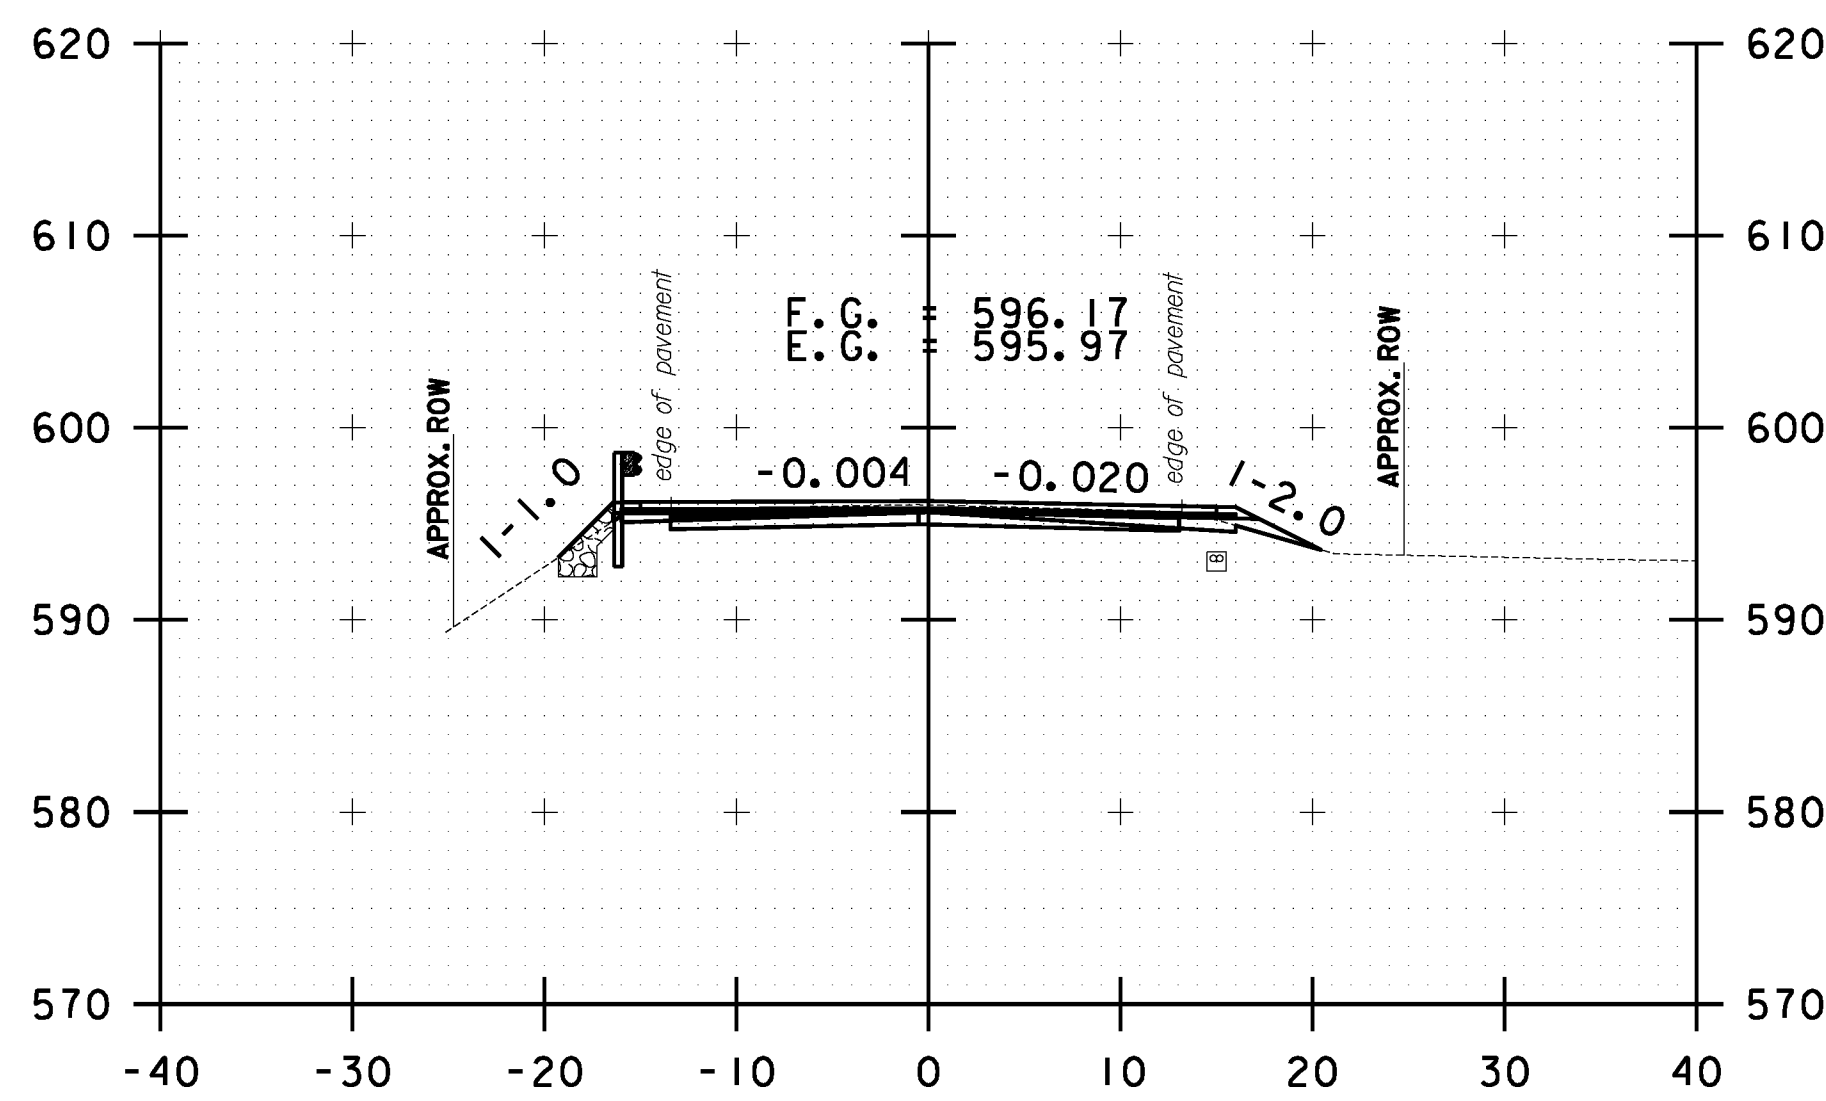

B 45+50.00

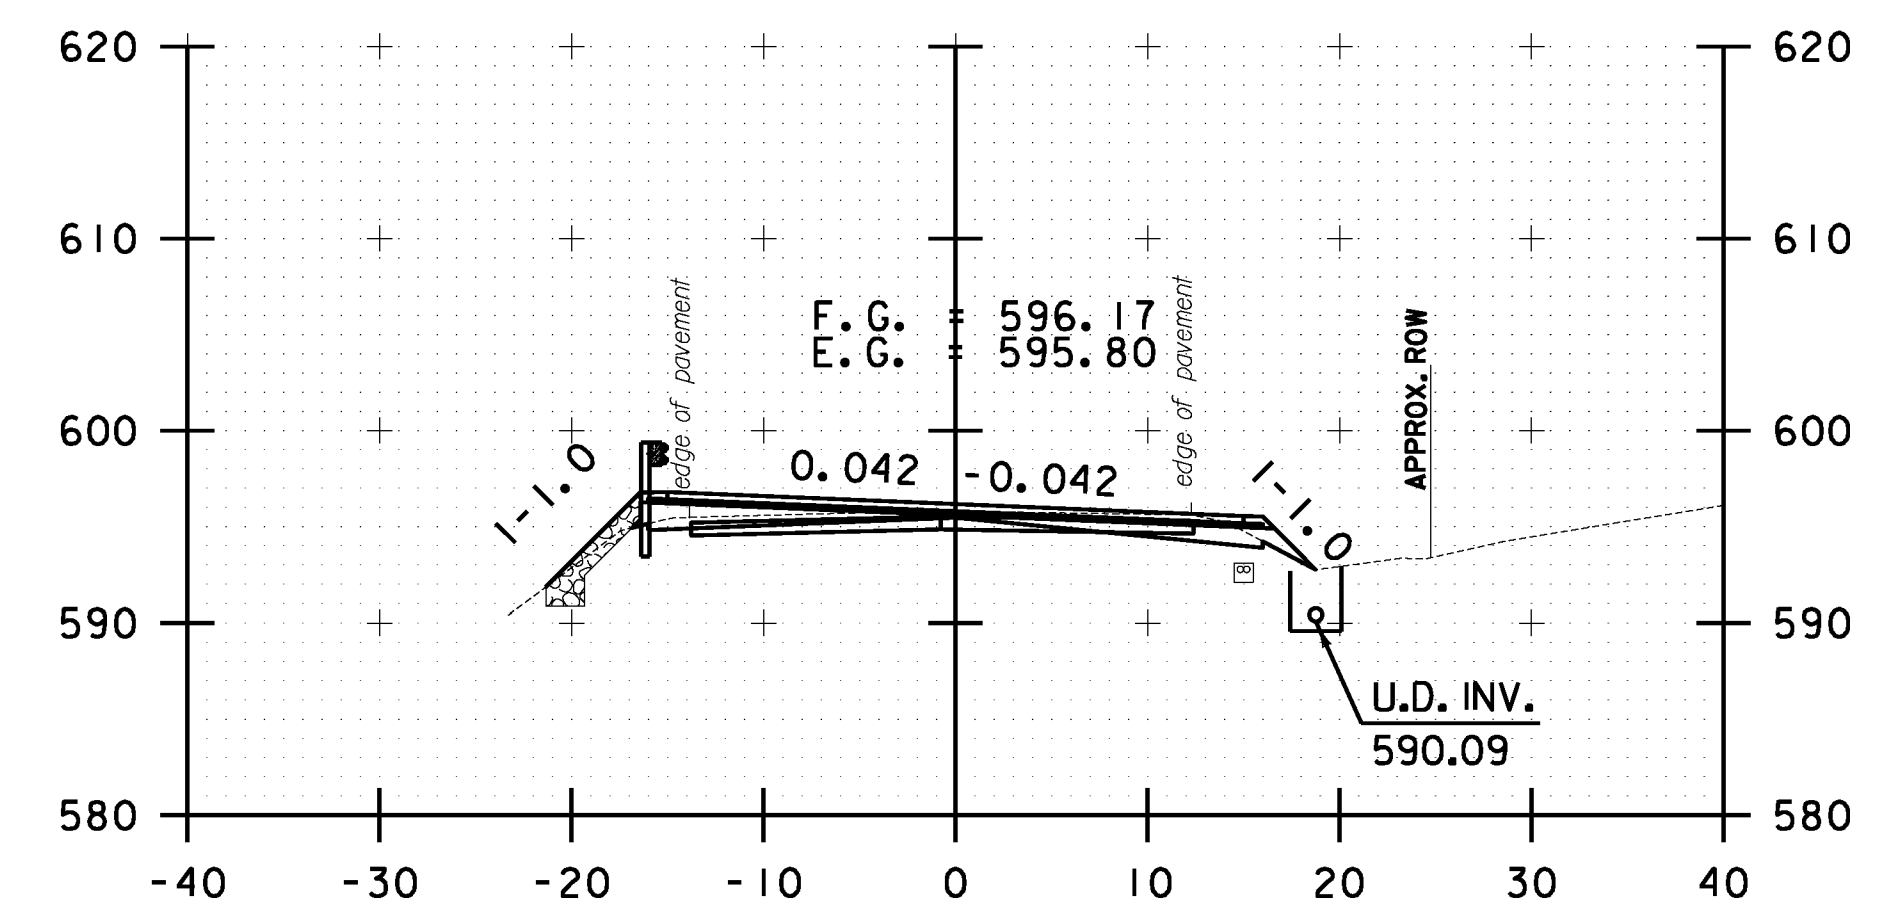

B 46+50.00



BETHEL CROSS SECTION SHEET #16	PROJECT NAME: STOCKBRIDGE-BETHEL
	PROJECT NUMBER: STP 2910(1)
	FILE NAME: z10b214.bethel.xc.dgn
	IPARM FILE: z10b214.xs128.1
	PLOT DATE: 3/17/2014
	DRAWN BY: W.G.P.
	CHECKED BY: J.P.S.
	SHEET 341 OF 397