




FILE NAME = Y:\P\c\res\any\k2\22425\CADD\...MSTN\10b214.bethel.xc.dgn
 DATE/TIME = 3/17/2014
 USER = 4916

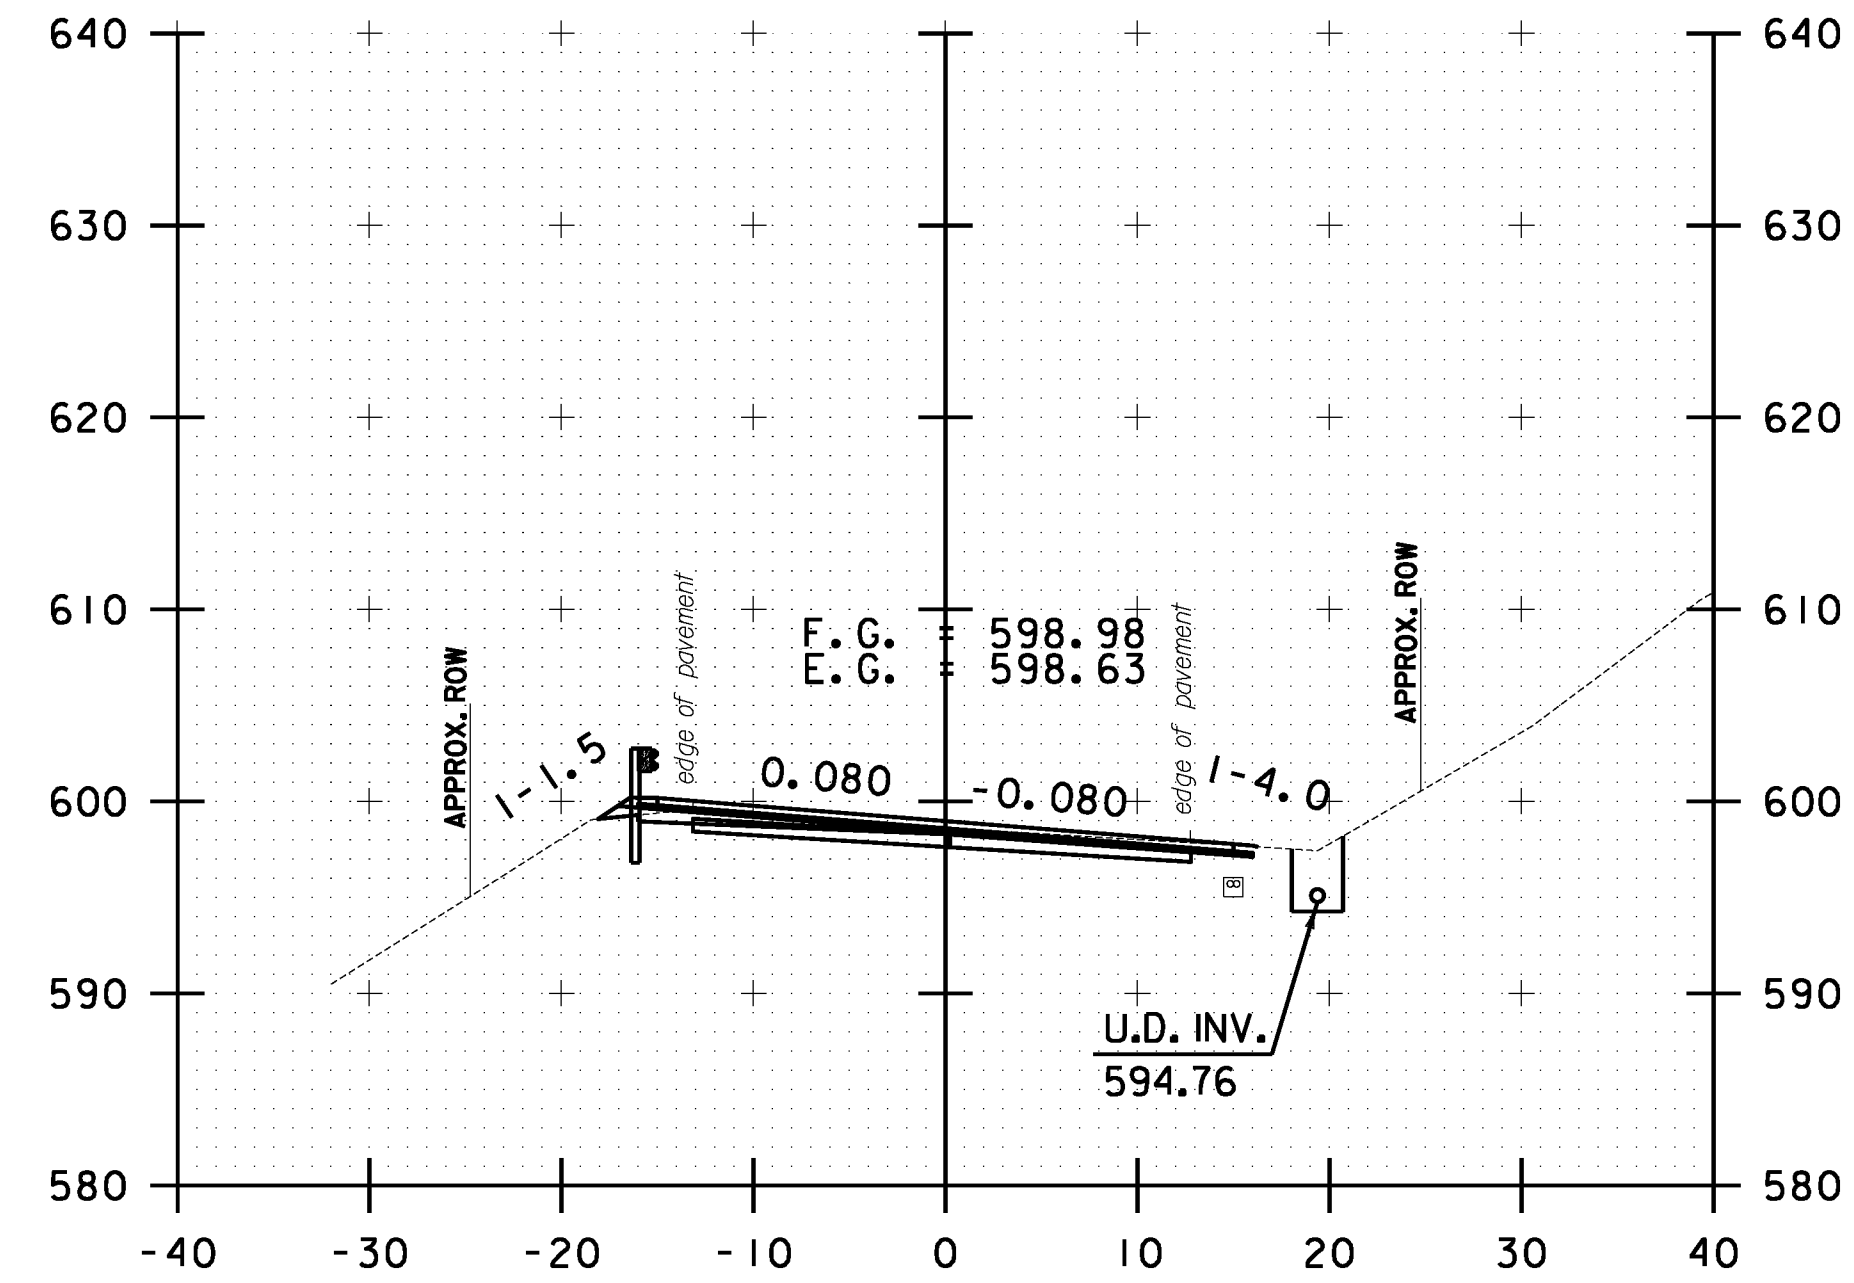


B 48+50.00

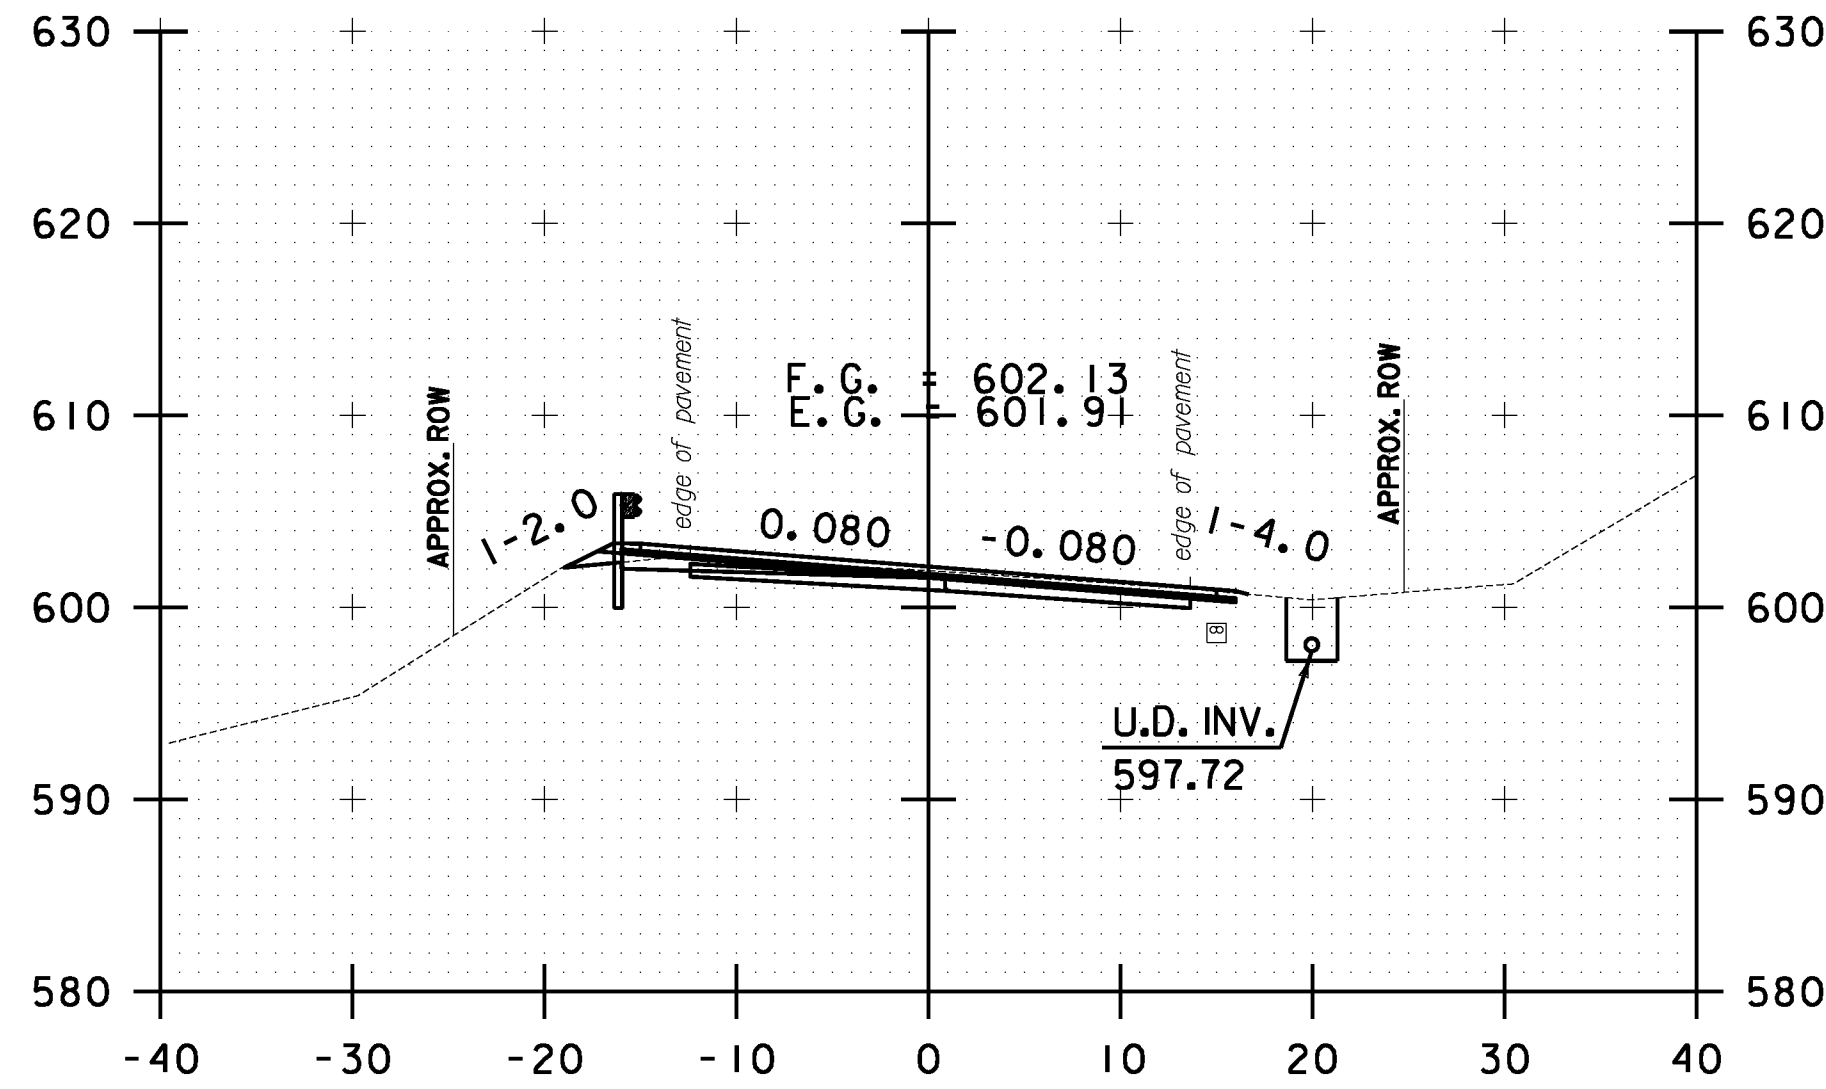


B 49+50.00

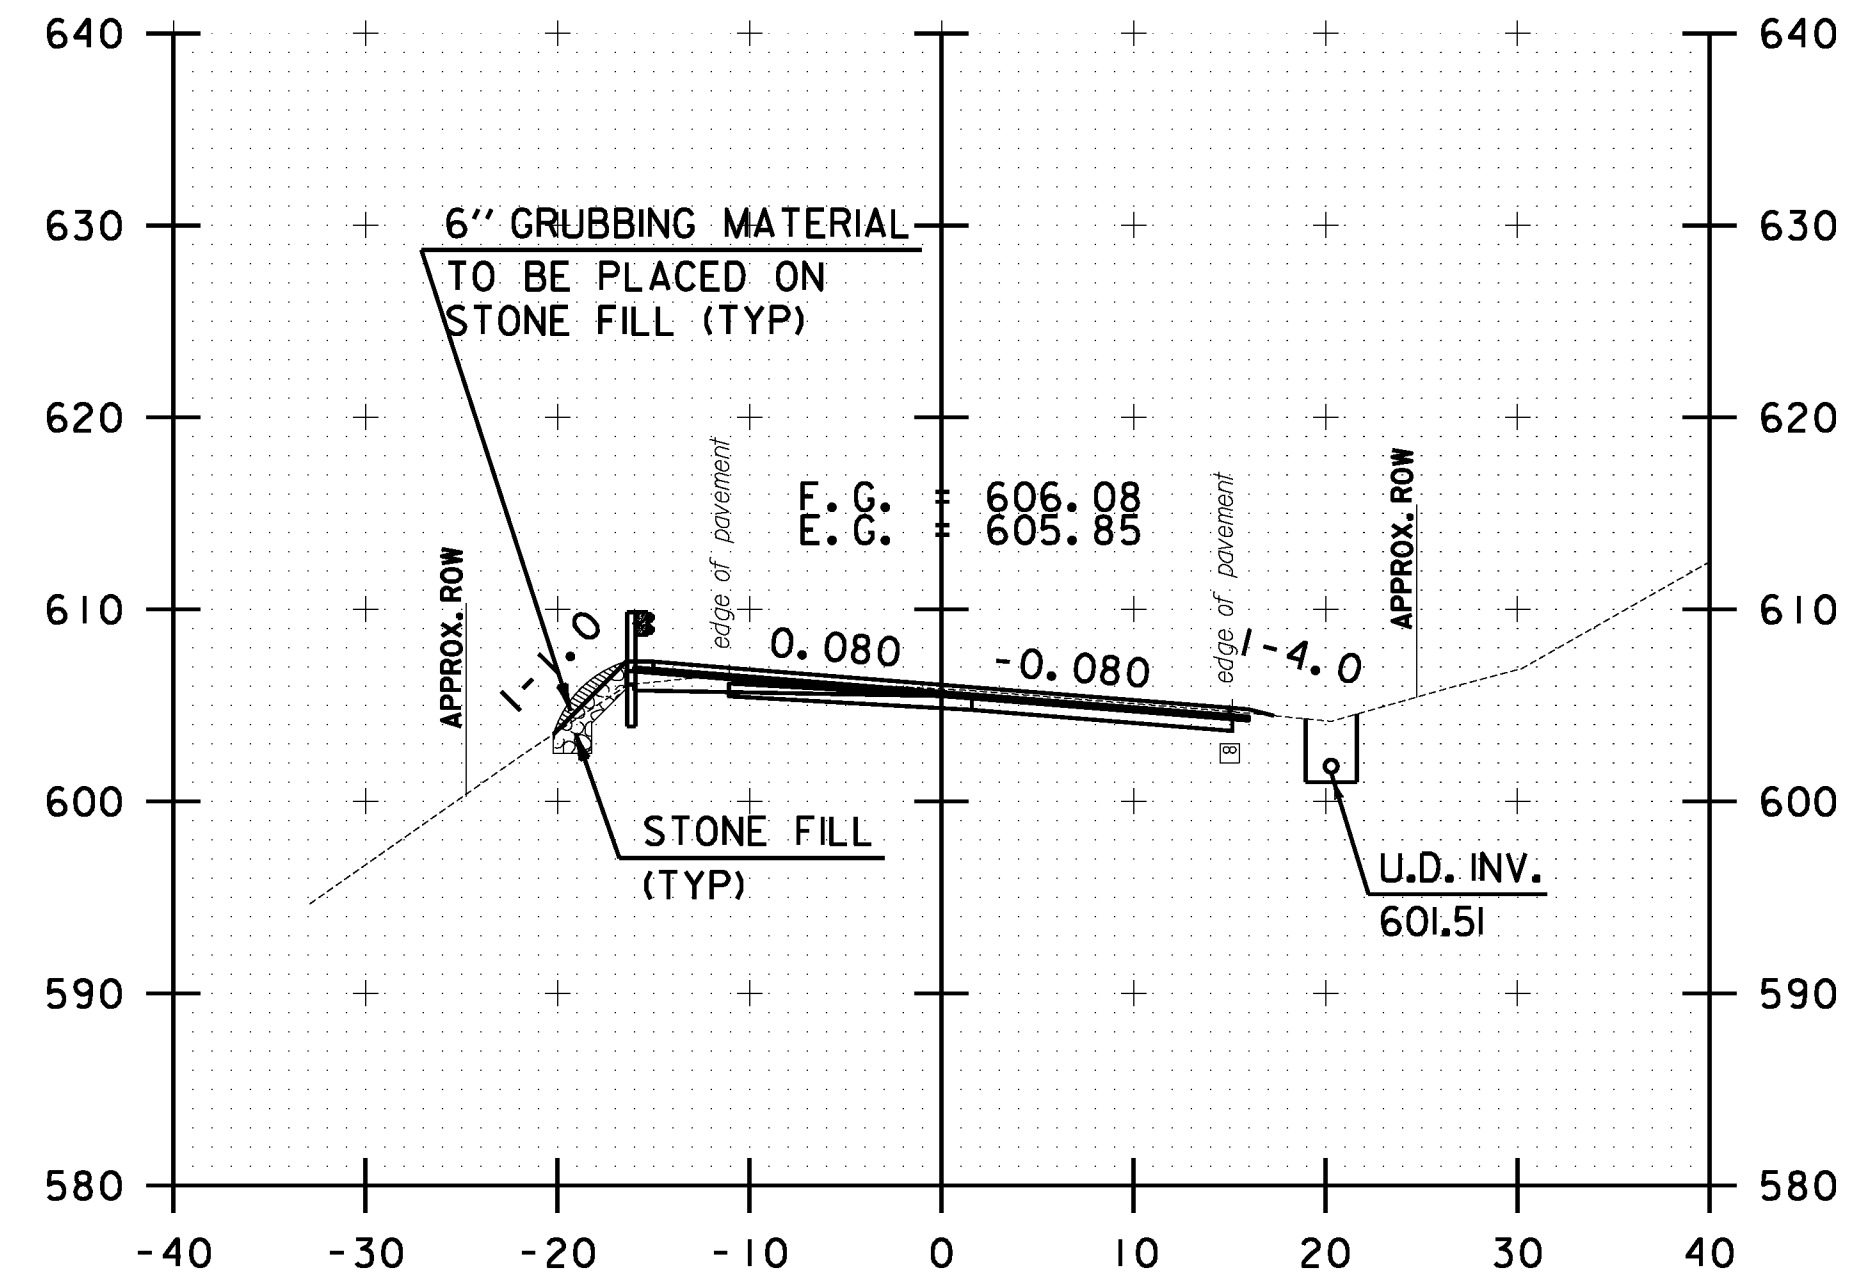


B 50+50.00

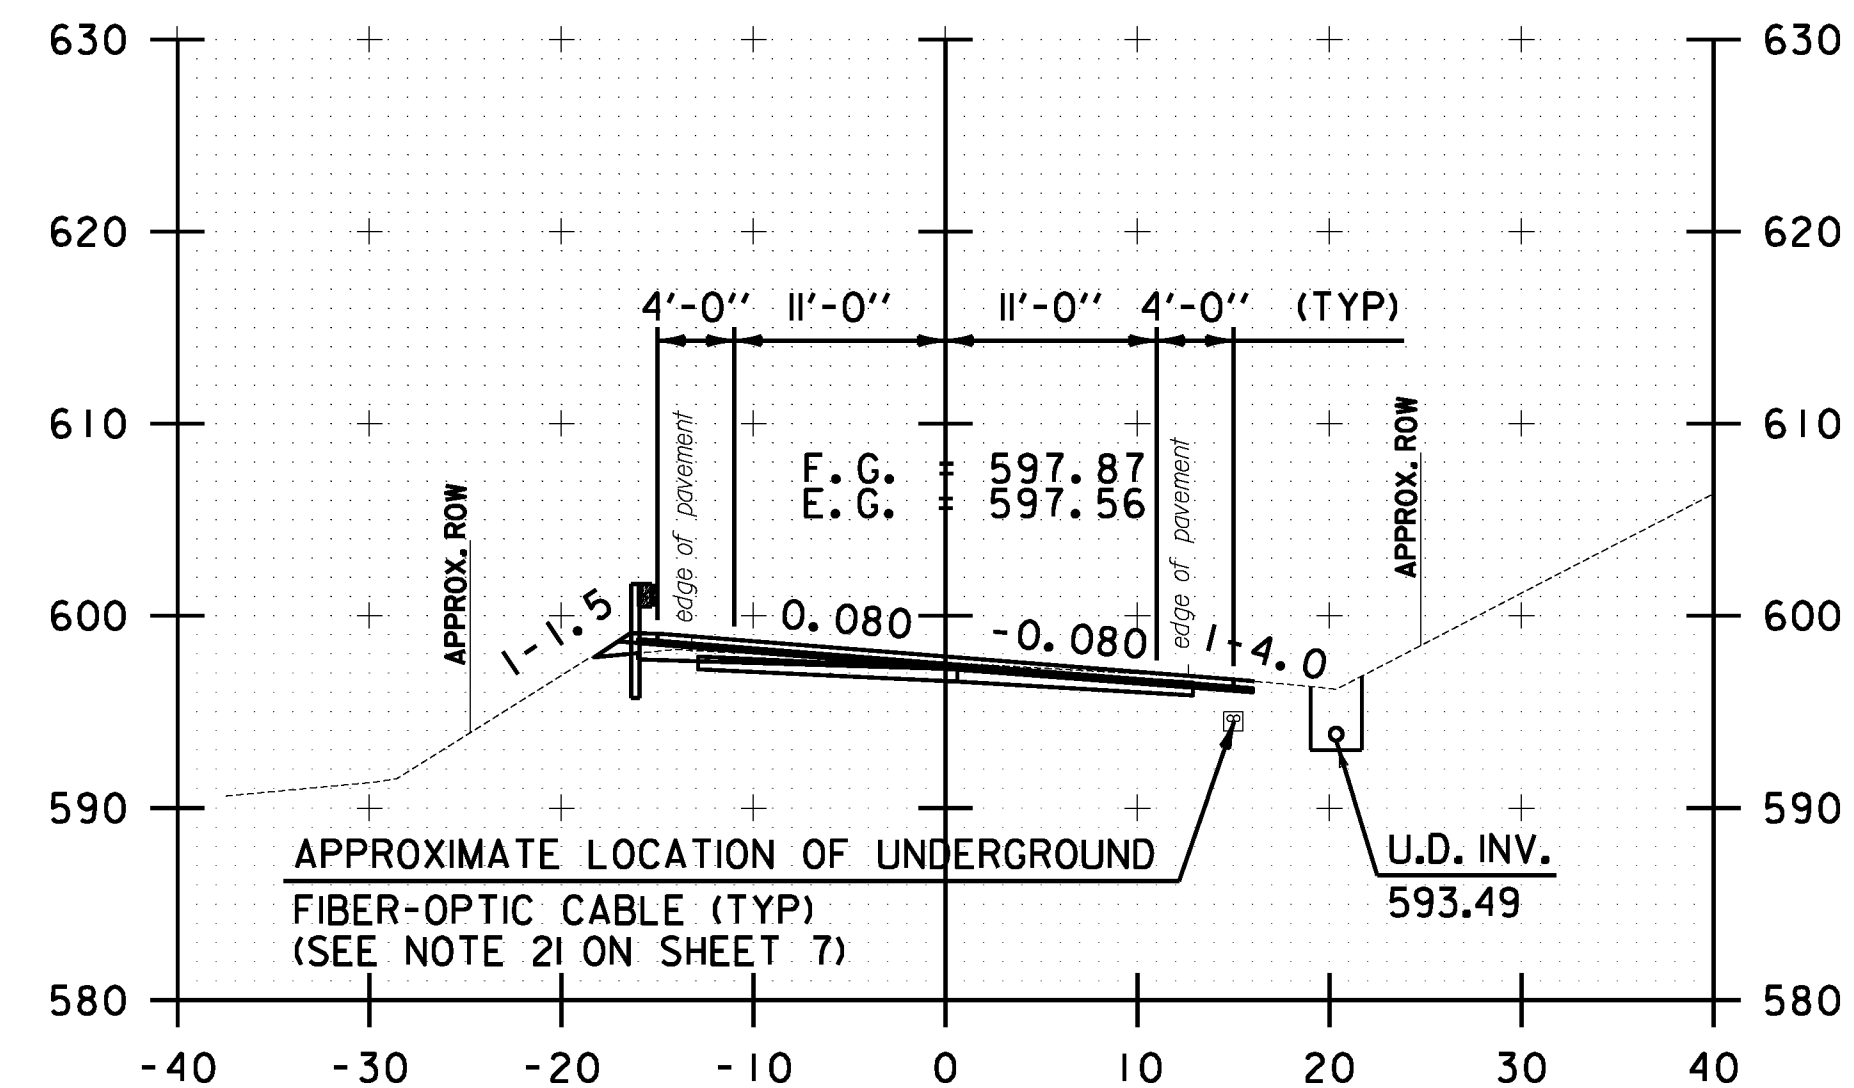

B 48+00.00

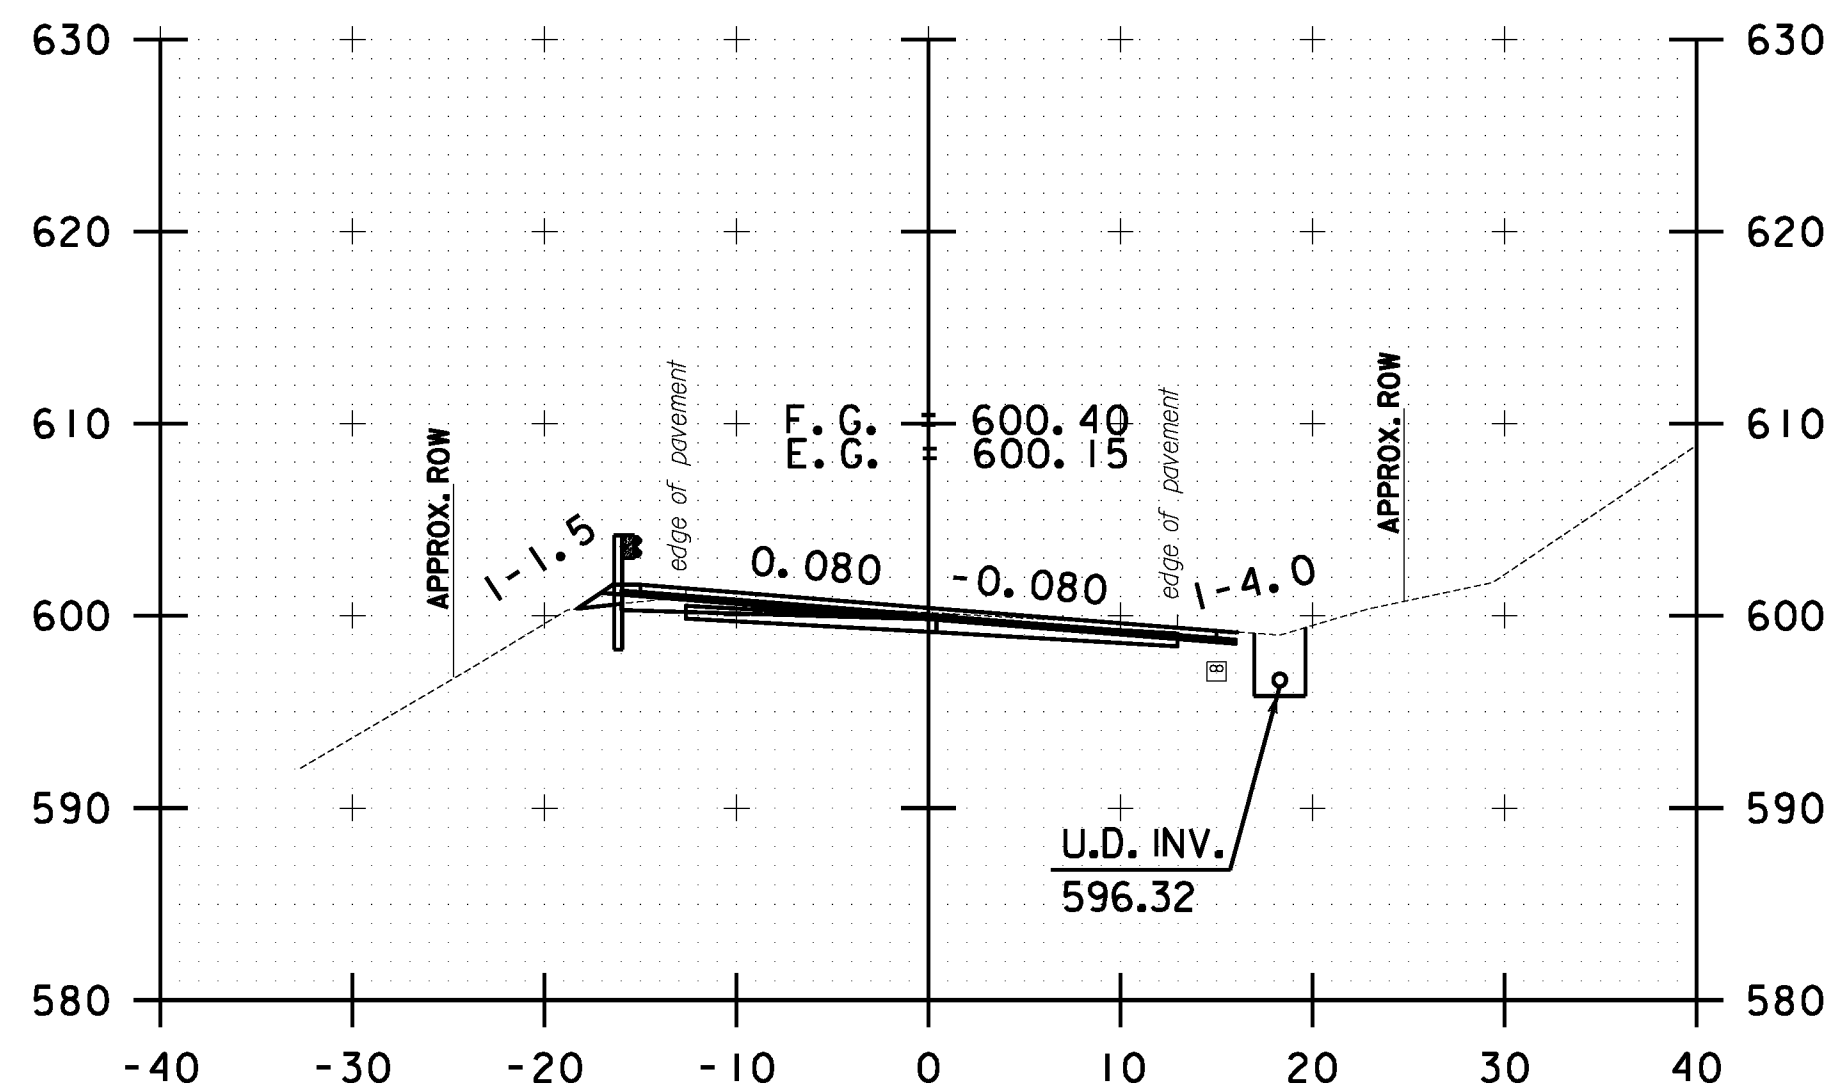

B 49+00.00

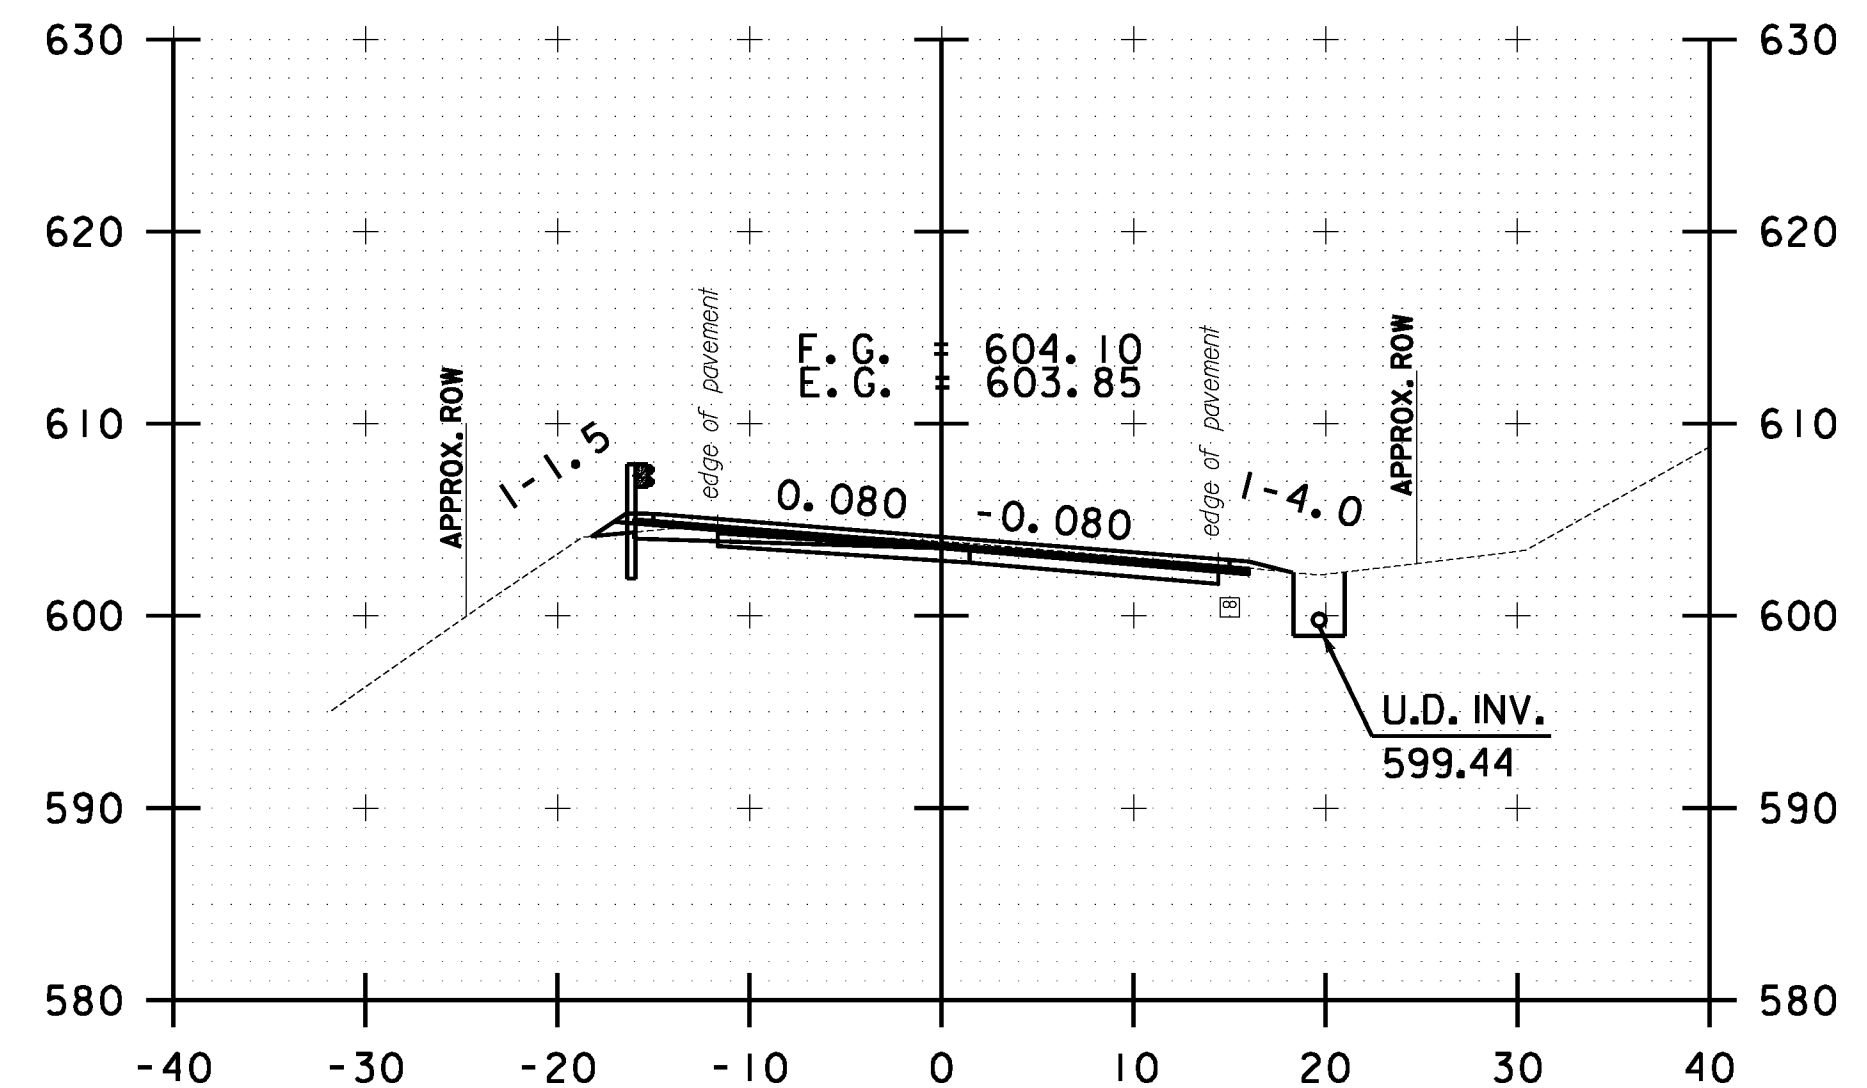

B 50+00.00



BETHEL CROSS SECTION SHEET #17	PROJECT NAME: STOCKBRIDGE-BETHEL
	PROJECT NUMBER: STP 2910(1)
	FILE NAME: z10b214.bethel.xc.dgn
	IPARM FILE: z10b214.xs129.i
	PLOT DATE: 3/17/2014
	DRAWN BY: W.C.P.
	CHECKED BY: J.P.S.
	SHEET 342 OF 397