




FILE NAME = Y:\P\c\p\sc\any\k2\22425\CA001_MSTN\10b214_bethel.xc.dgn
 DATE/TIME = 3/17/2014
 USER = 4916

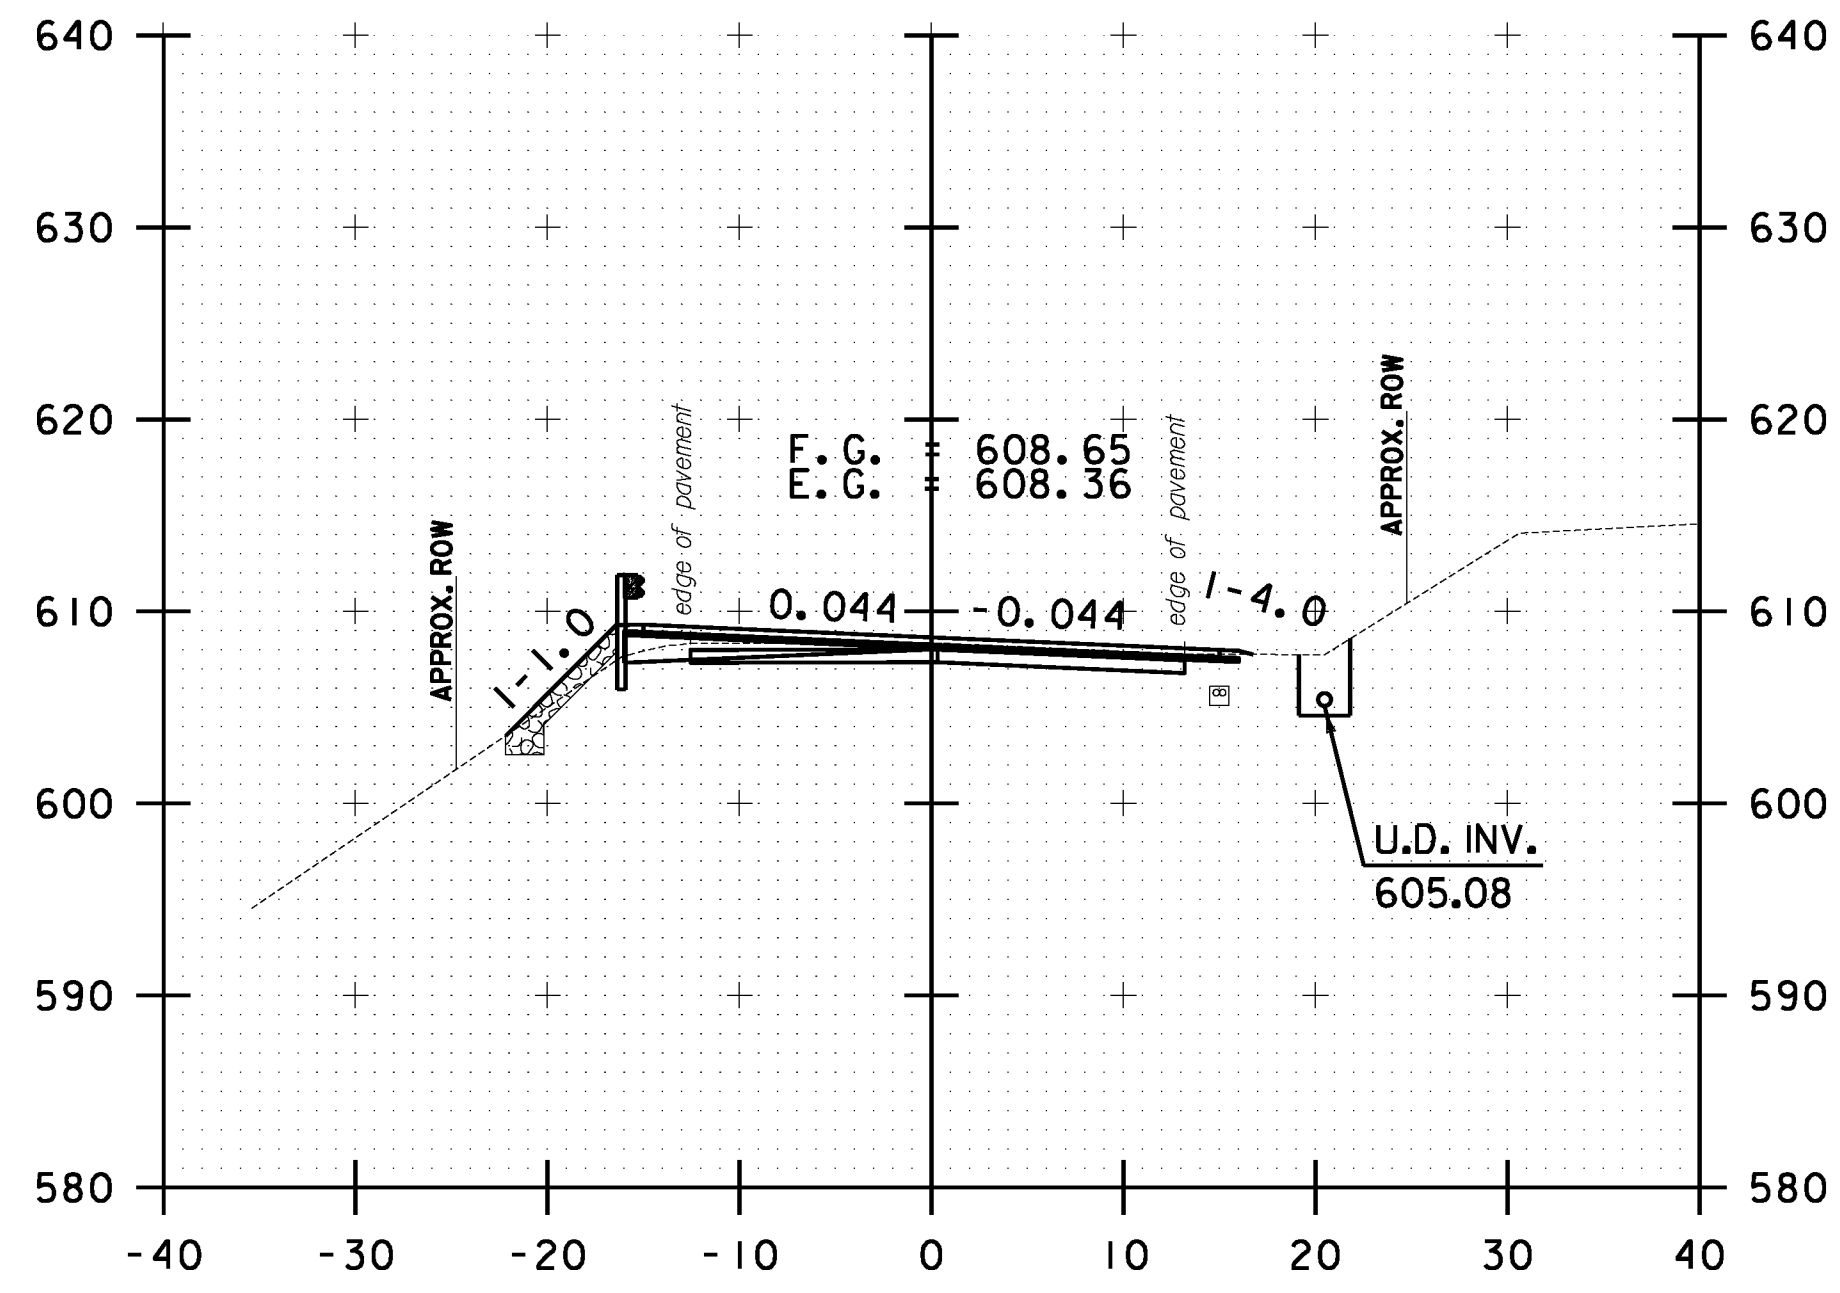


B 51+50.00

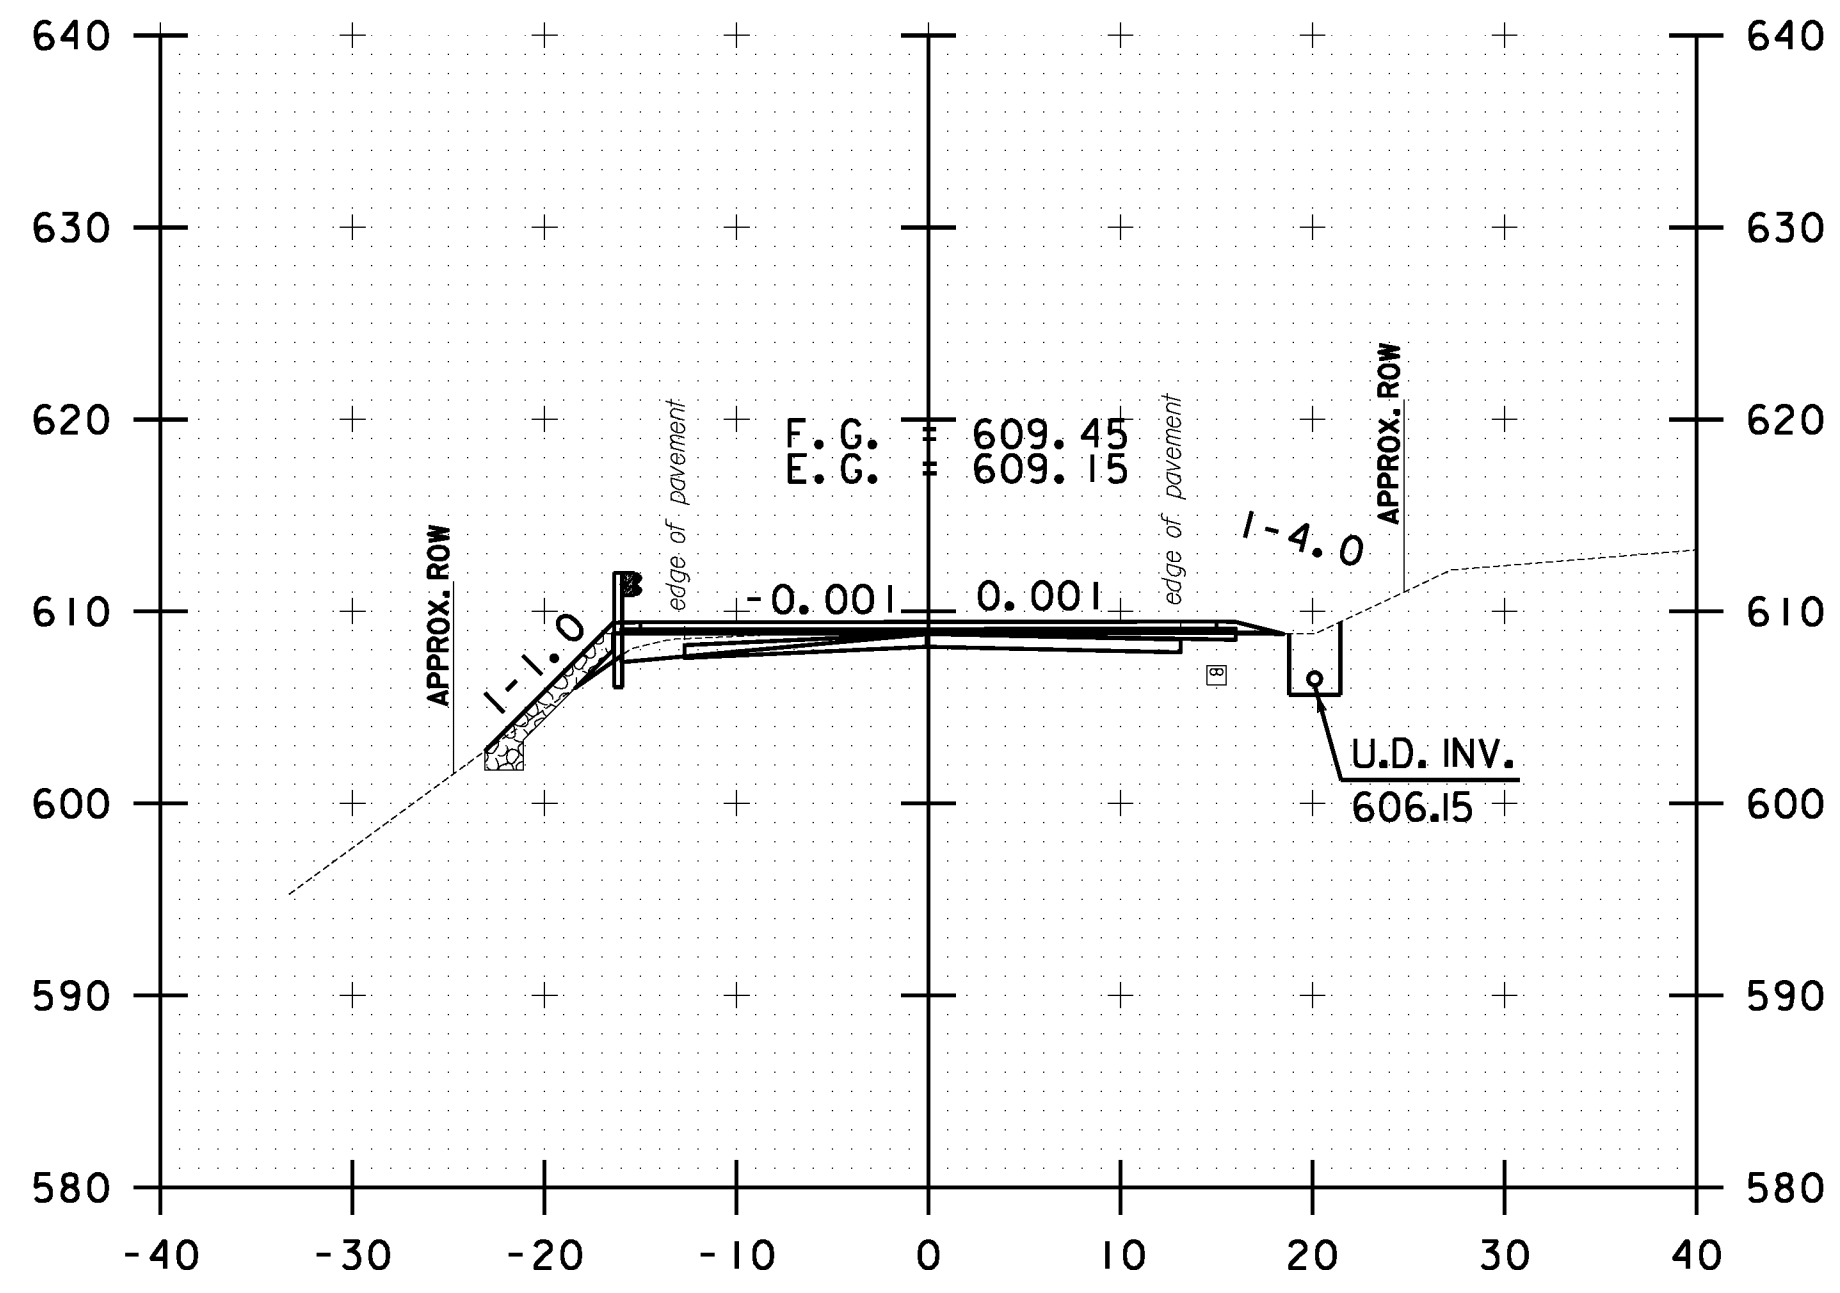


B 52+50.00

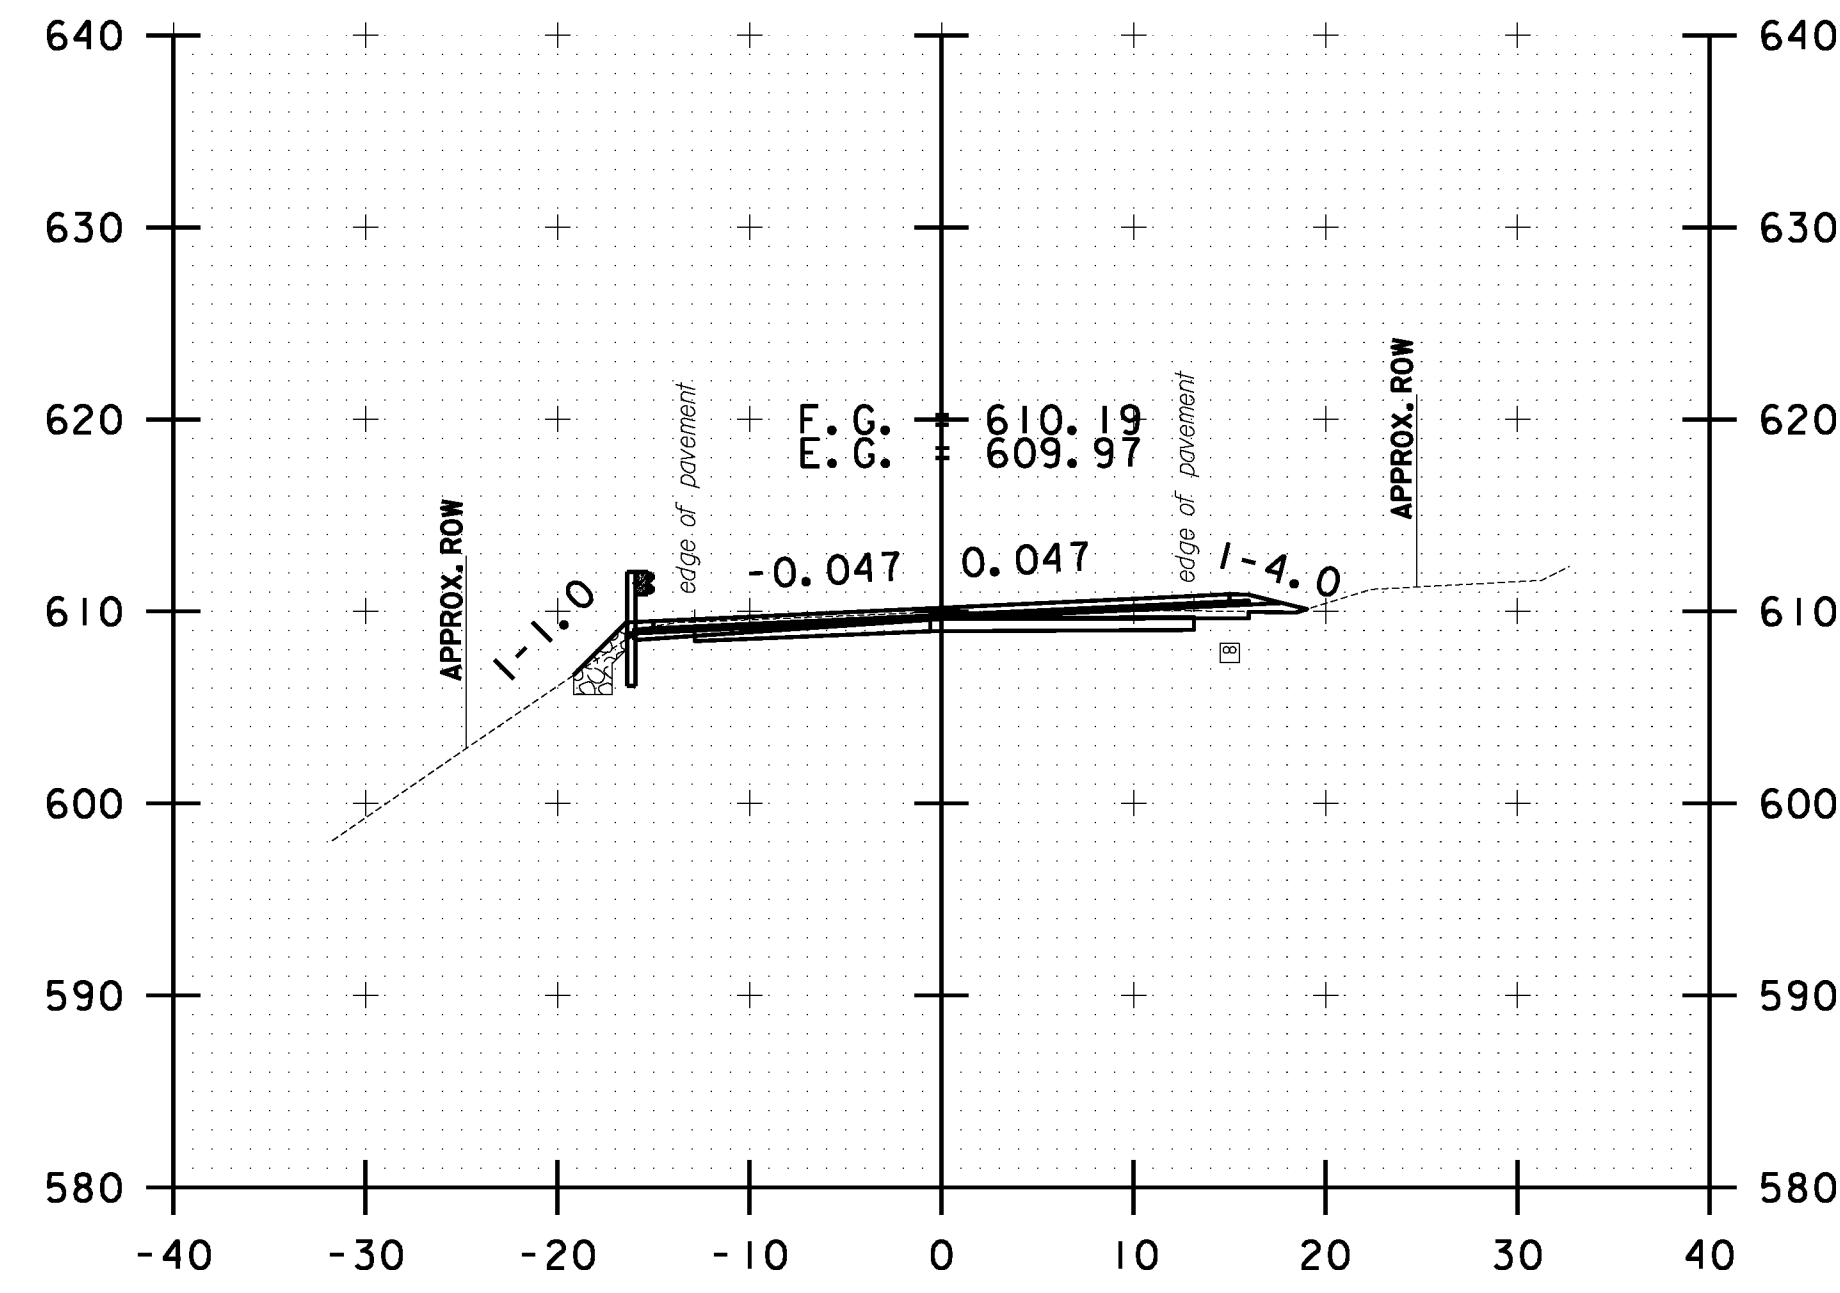


B 53+50.00

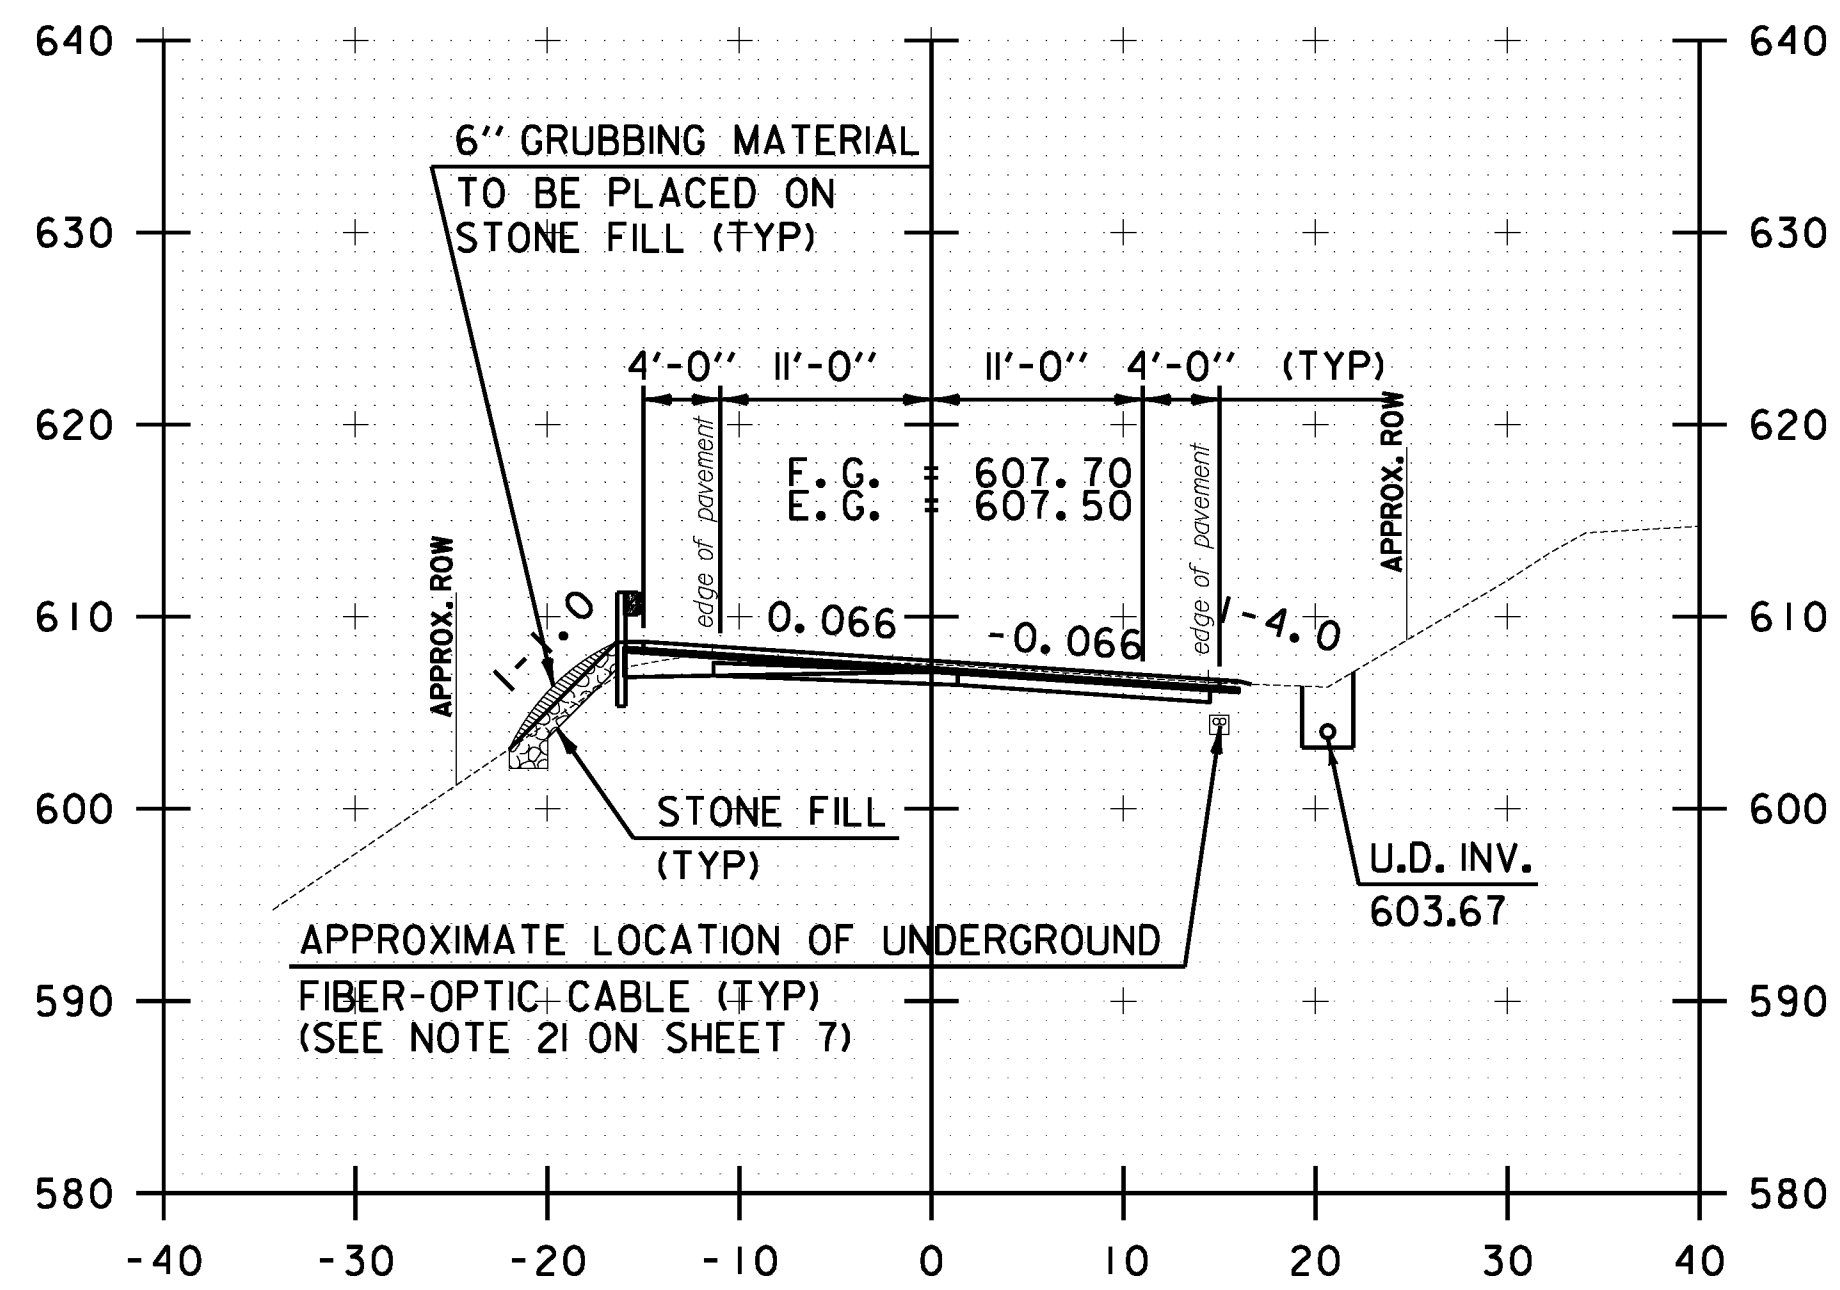


B 51+00.00

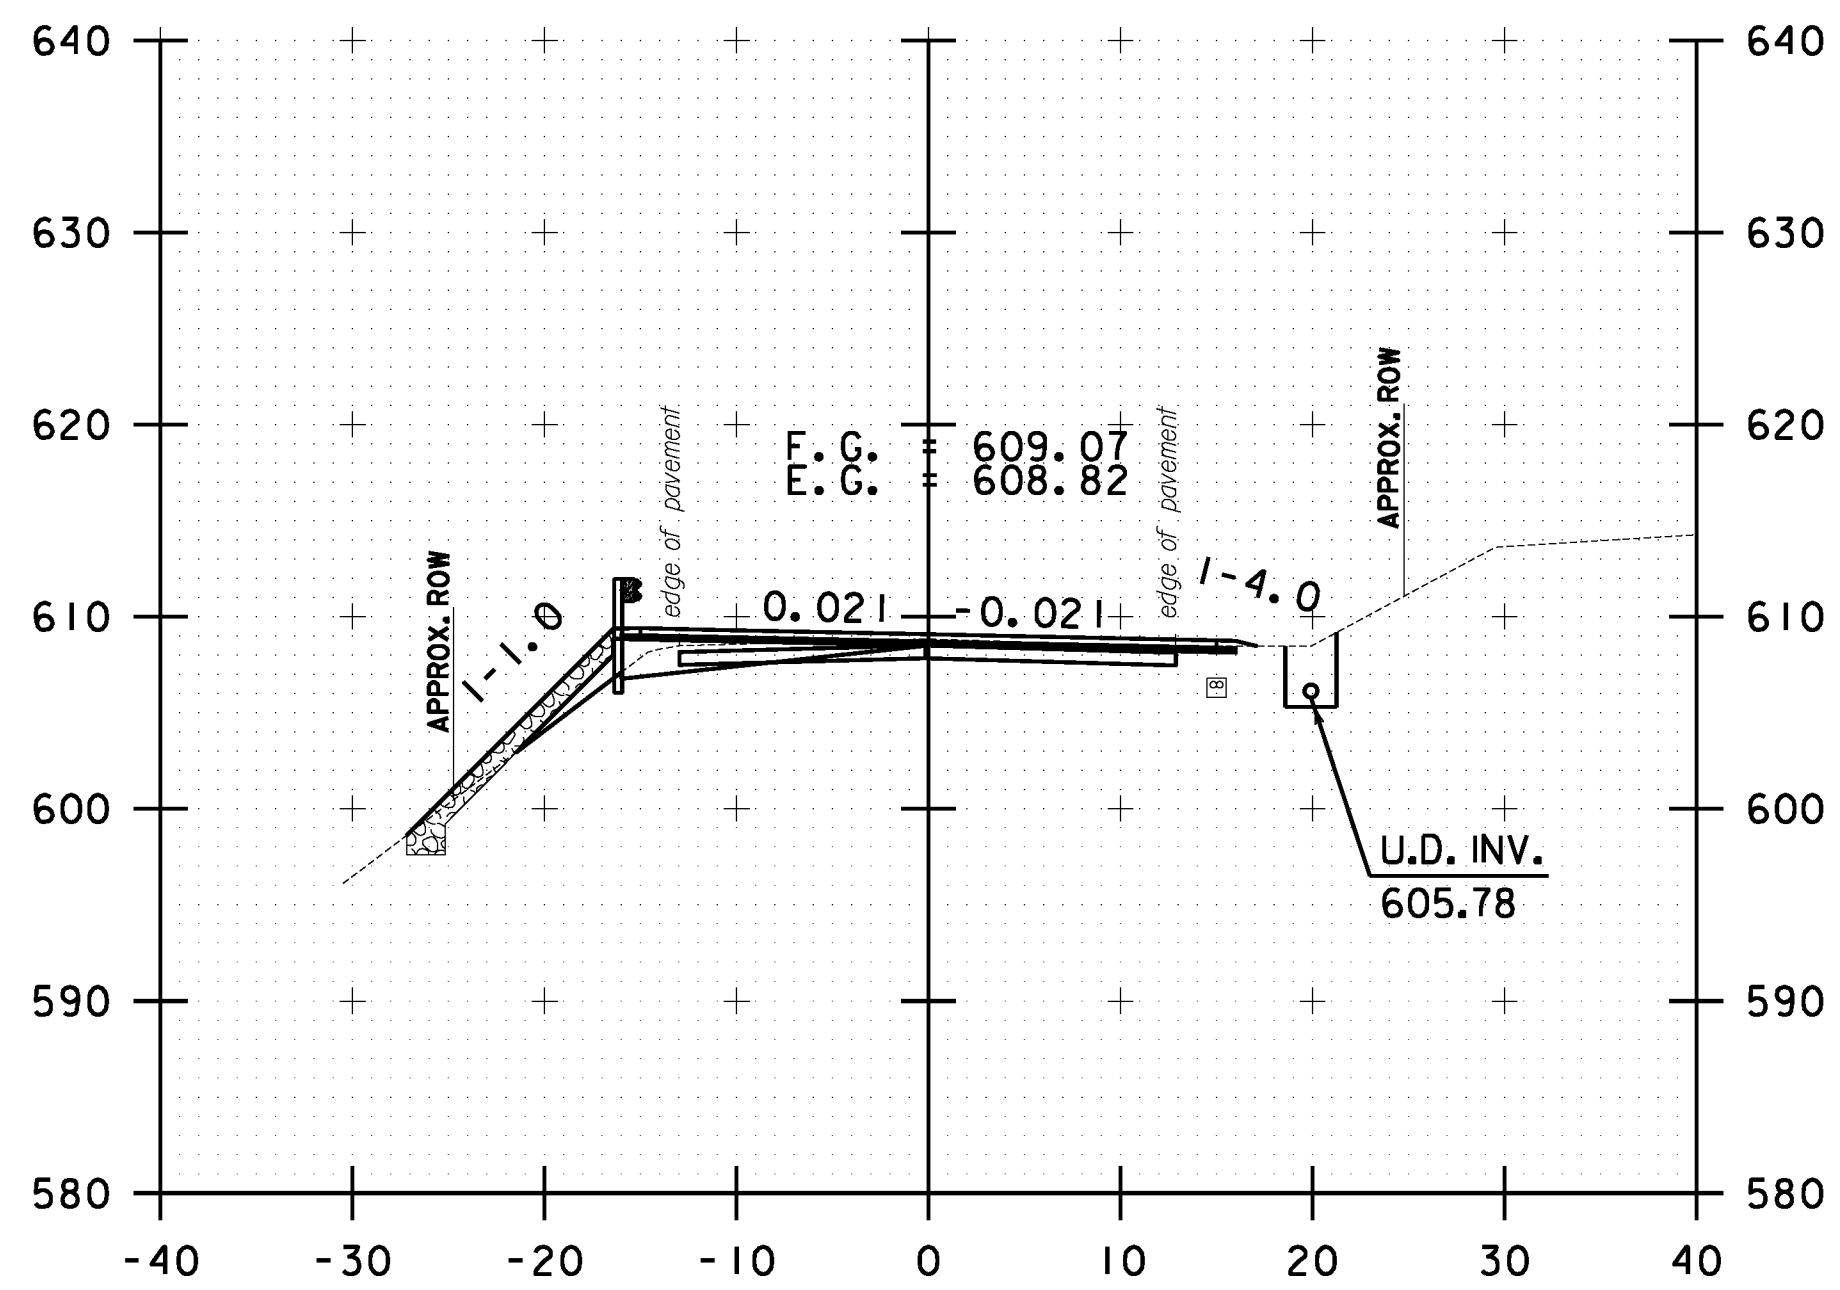

B 52+00.00

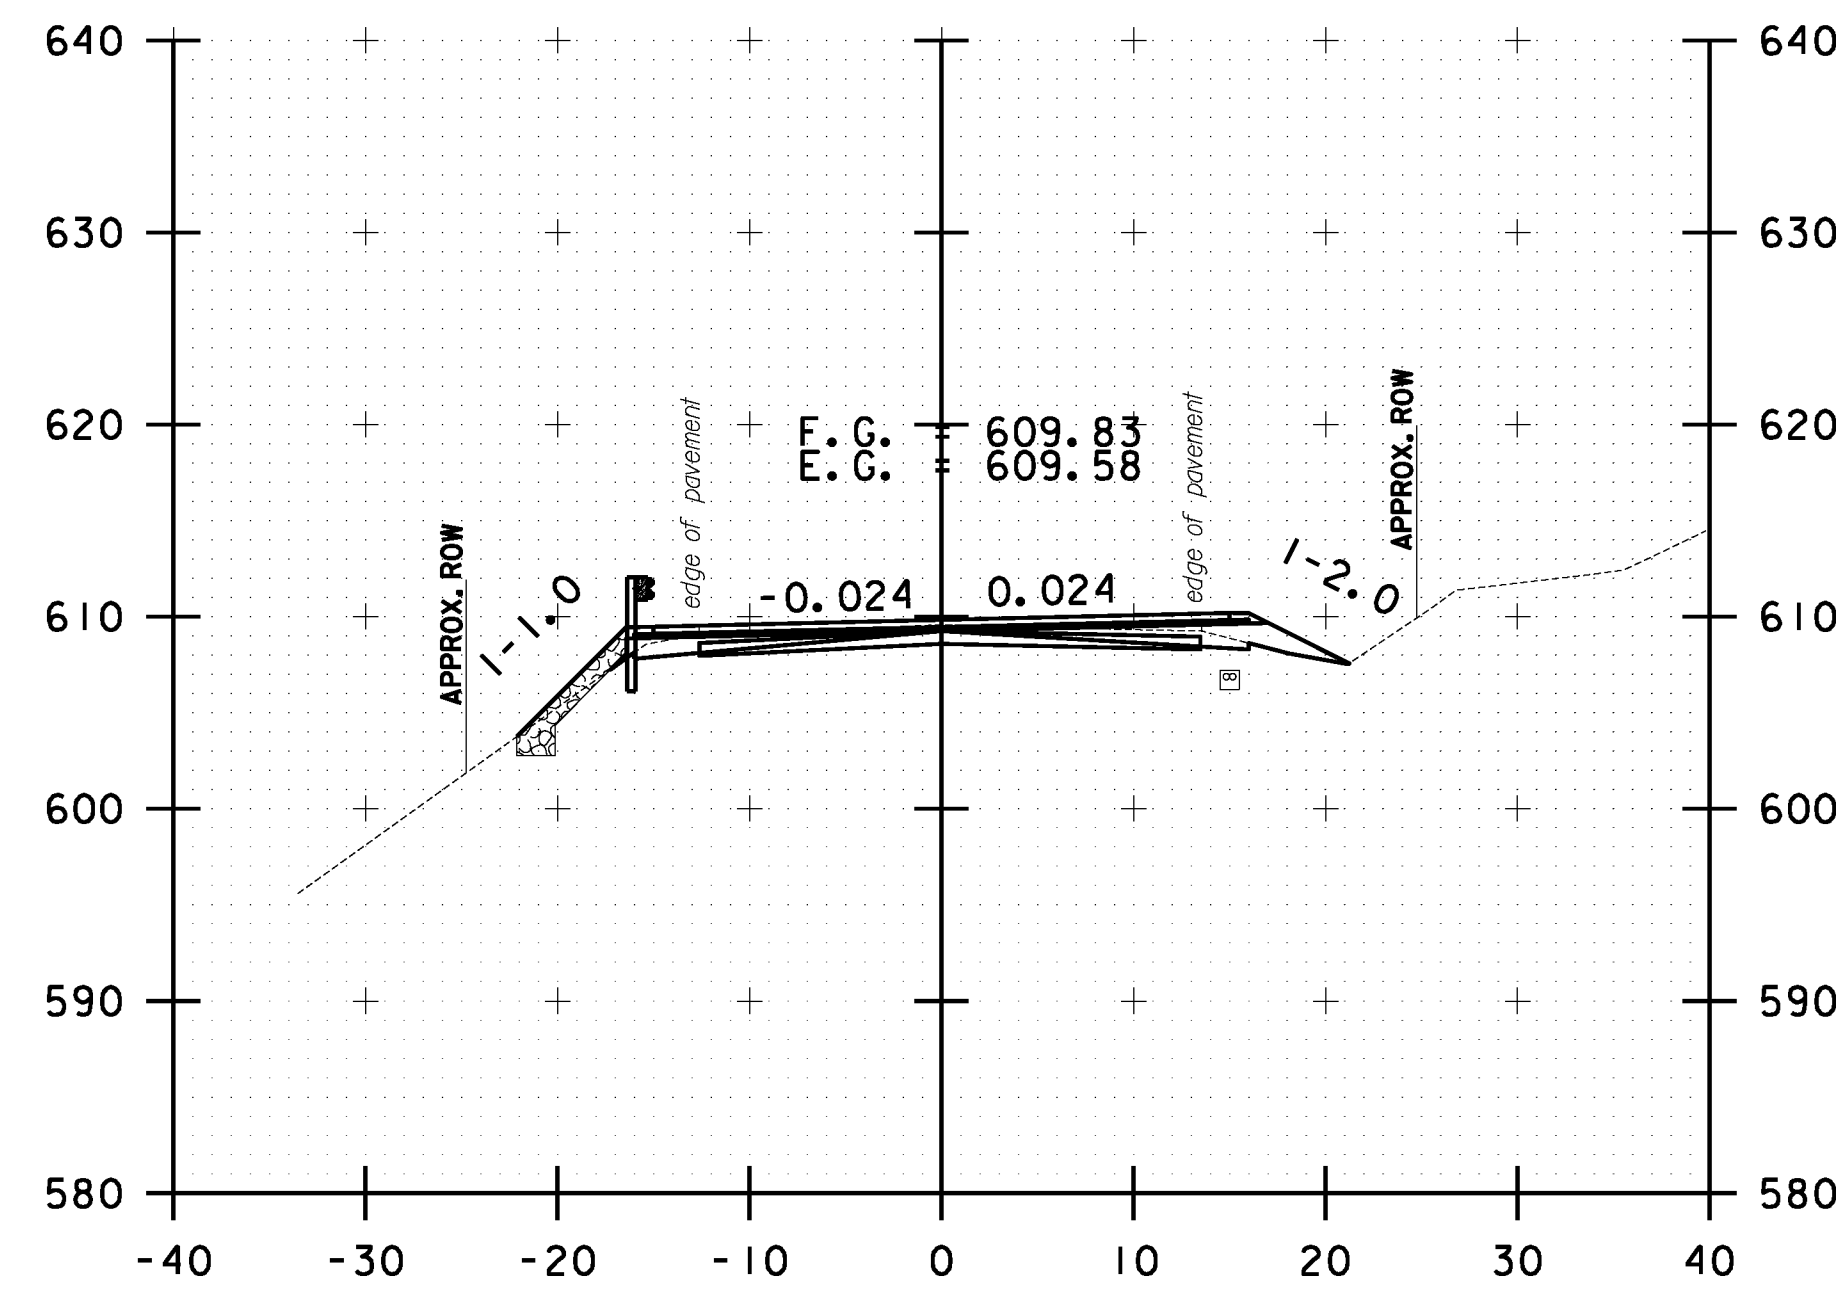

B 53+00.00

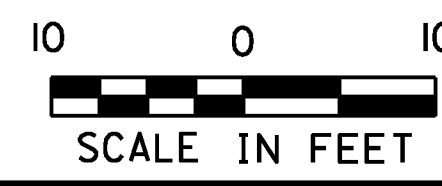

BETHEL CROSS SECTION SHEET #18	PROJECT NAME: STOCKBRIDGE-BETHEL
	PROJECT NUMBER: STP 2910(1)
	FILE NAME: z10b214_bethel.xc.dgn
	IPARM FILE: z10b214xs130.1
	PLOT DATE: 3/17/2014
	DRAWN BY: W.G.P.
	CHECKED BY: J.P.S.
	SHEET 343 OF 397