




FILE NAME = V:\P\c\res\any\k2\22425\CADD\MSTN\10b214.bethel.xc.dgn  
 DATE/TIME = 3/17/2014  
 USER = 4916

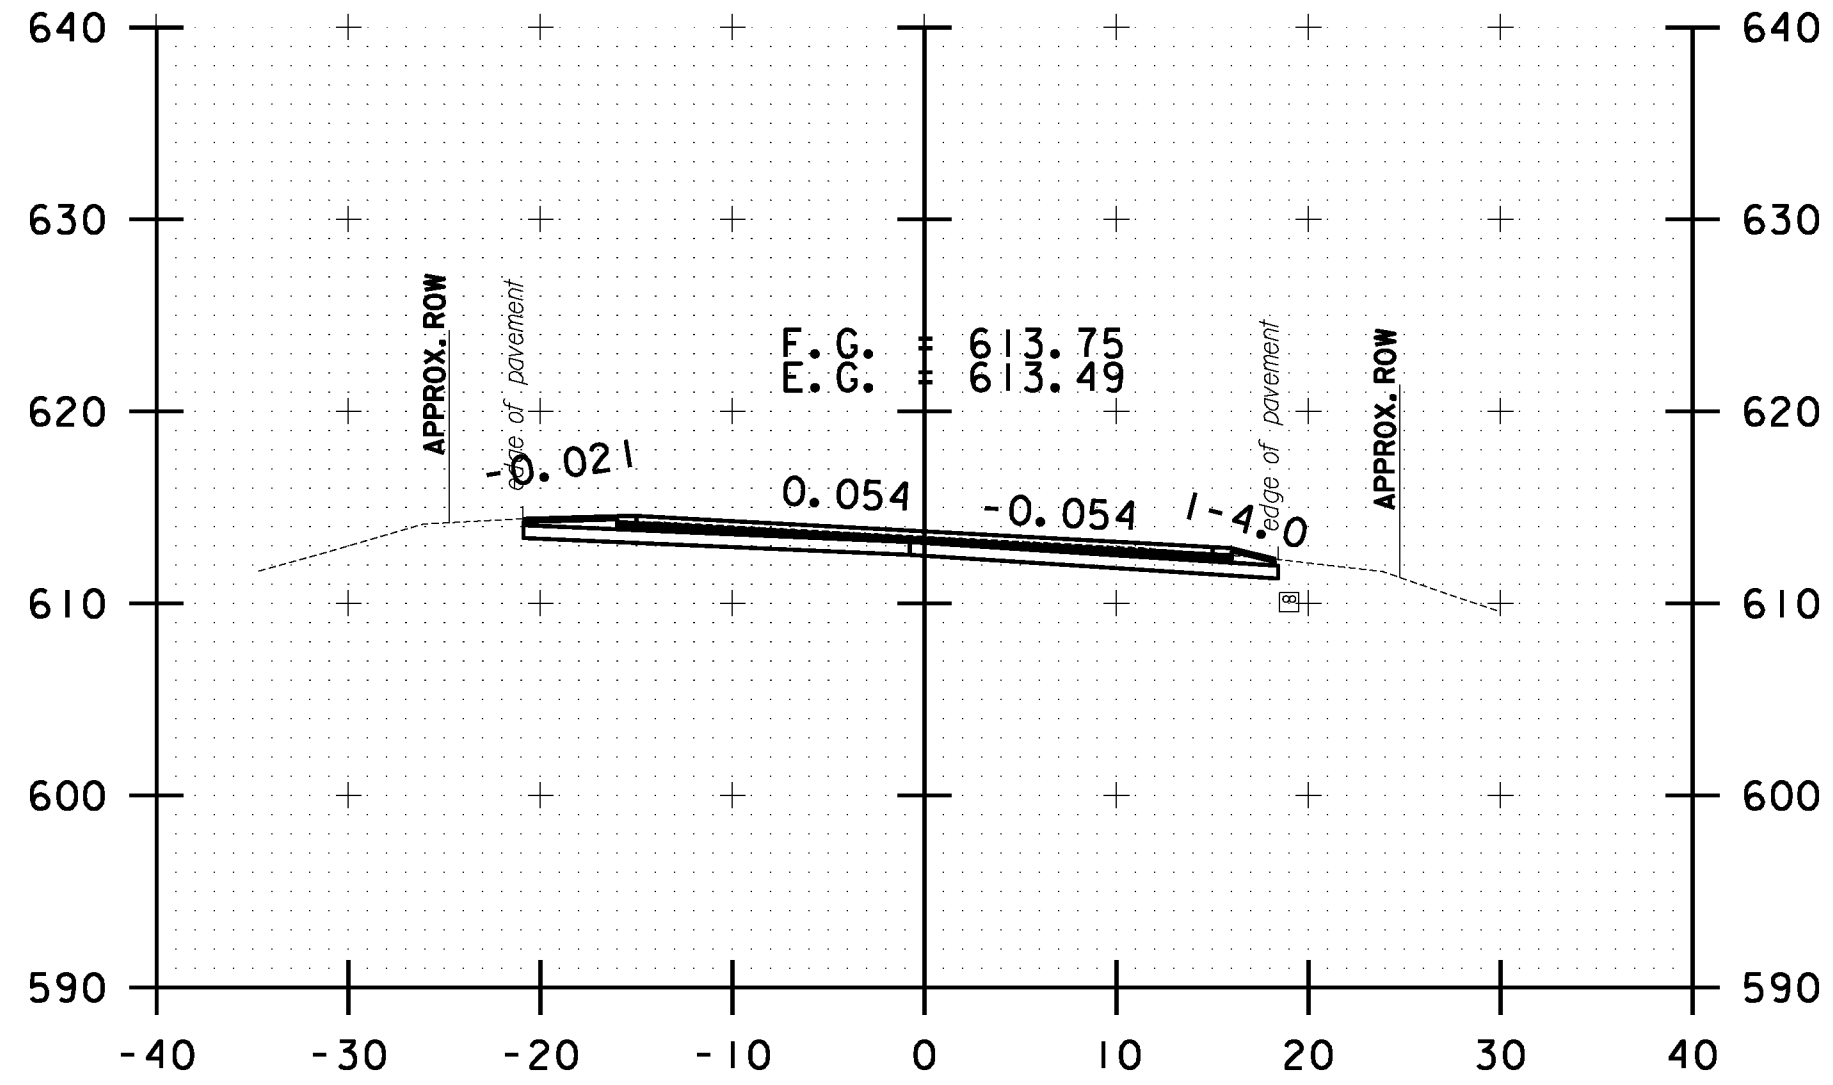


B 60+50.00

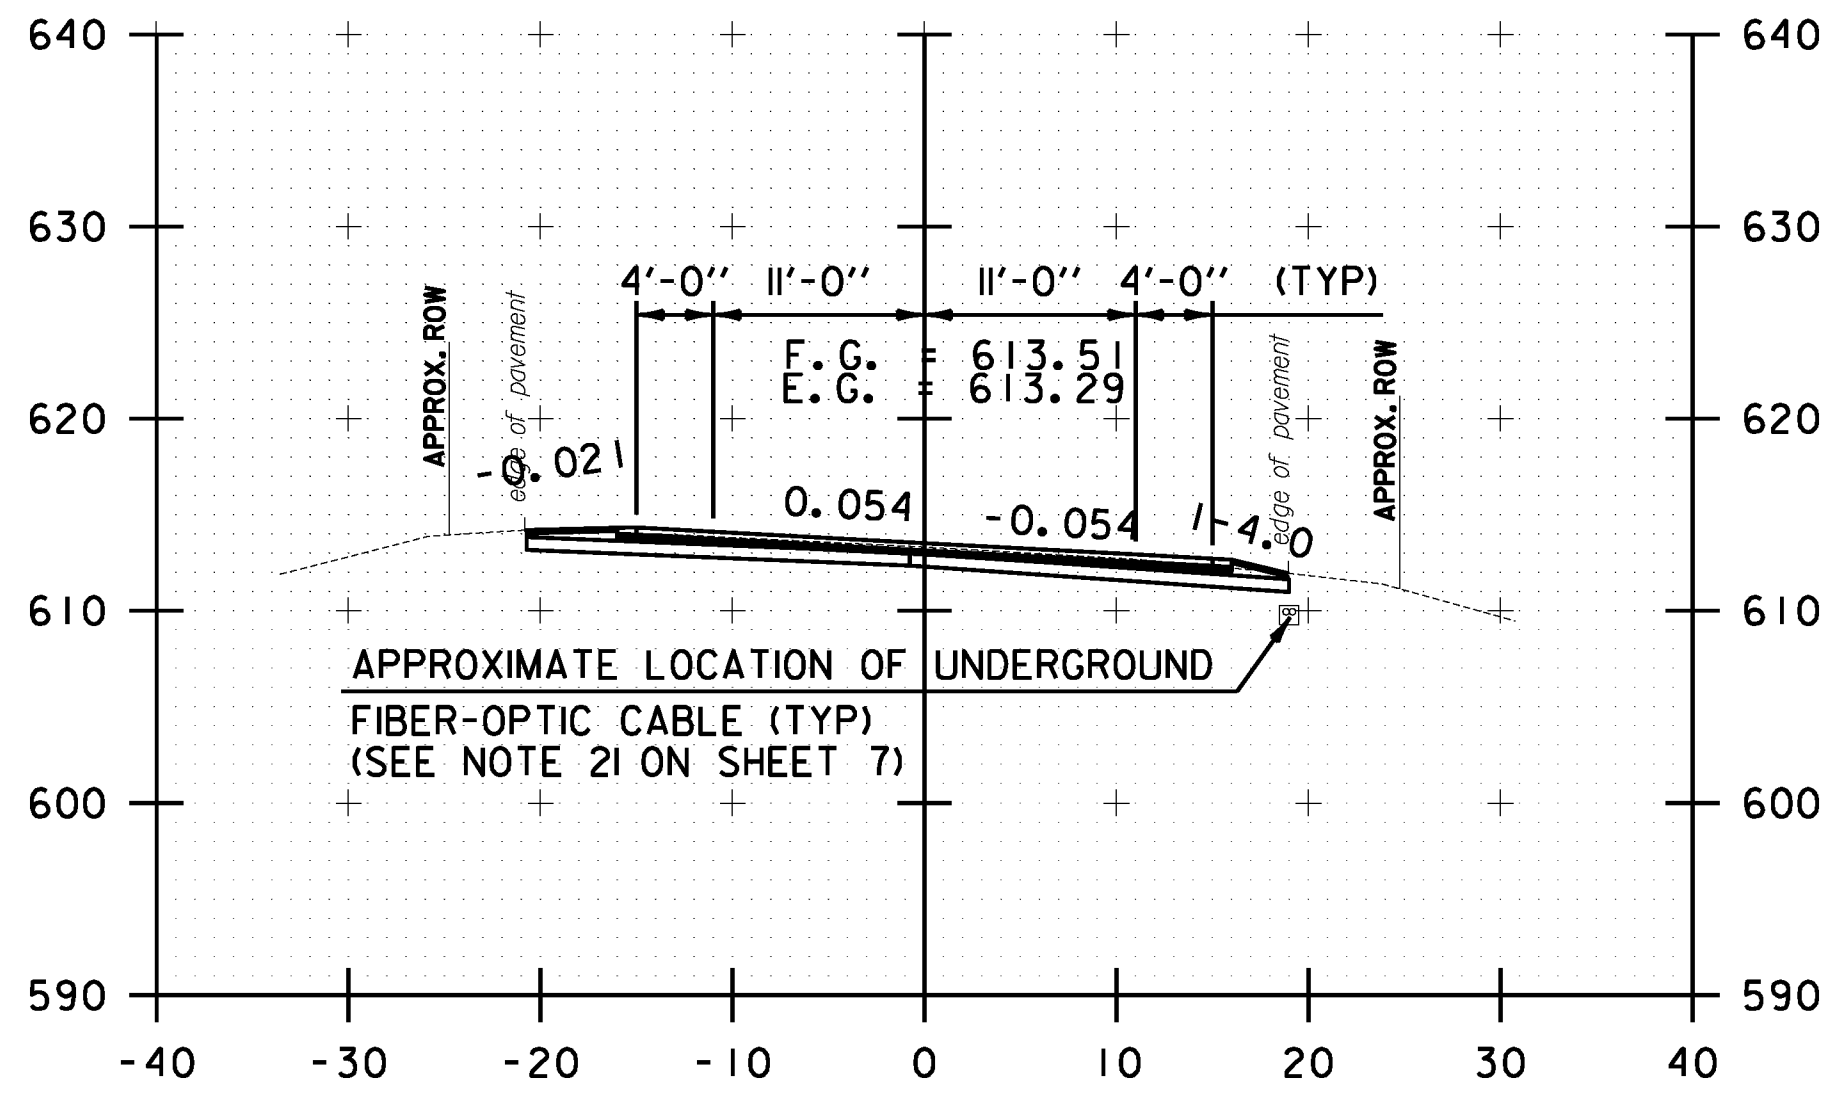


B 60+00.00

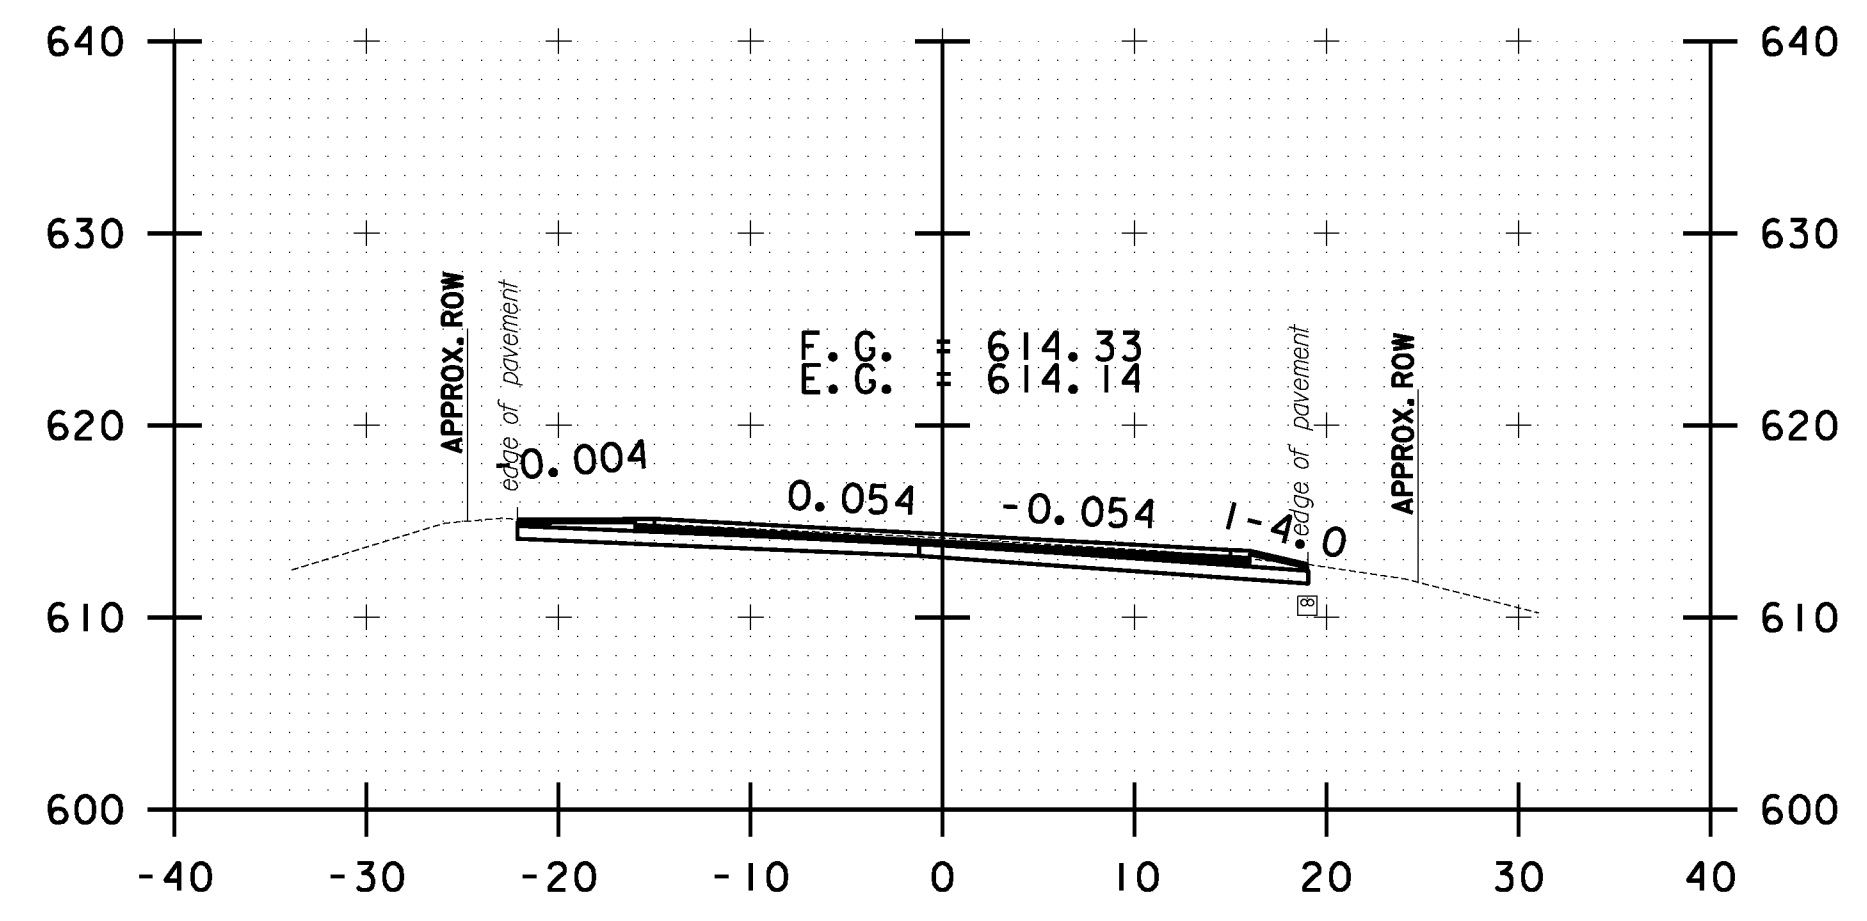


B 62+00.00

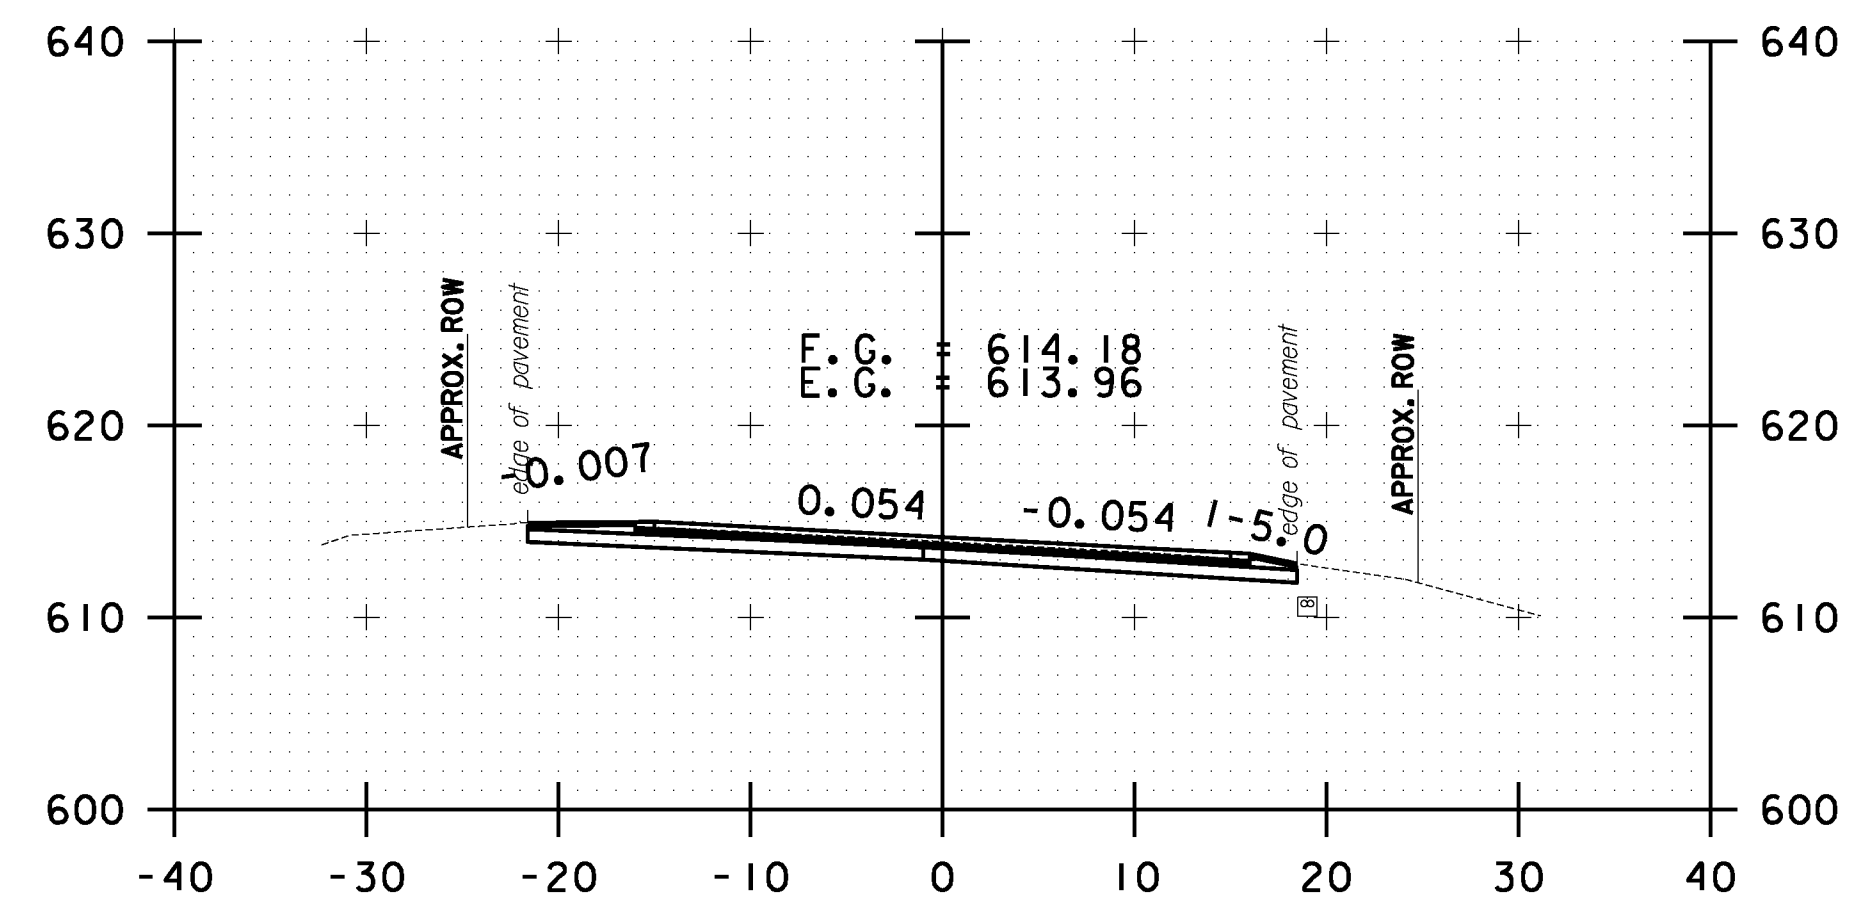


B 61+50.00

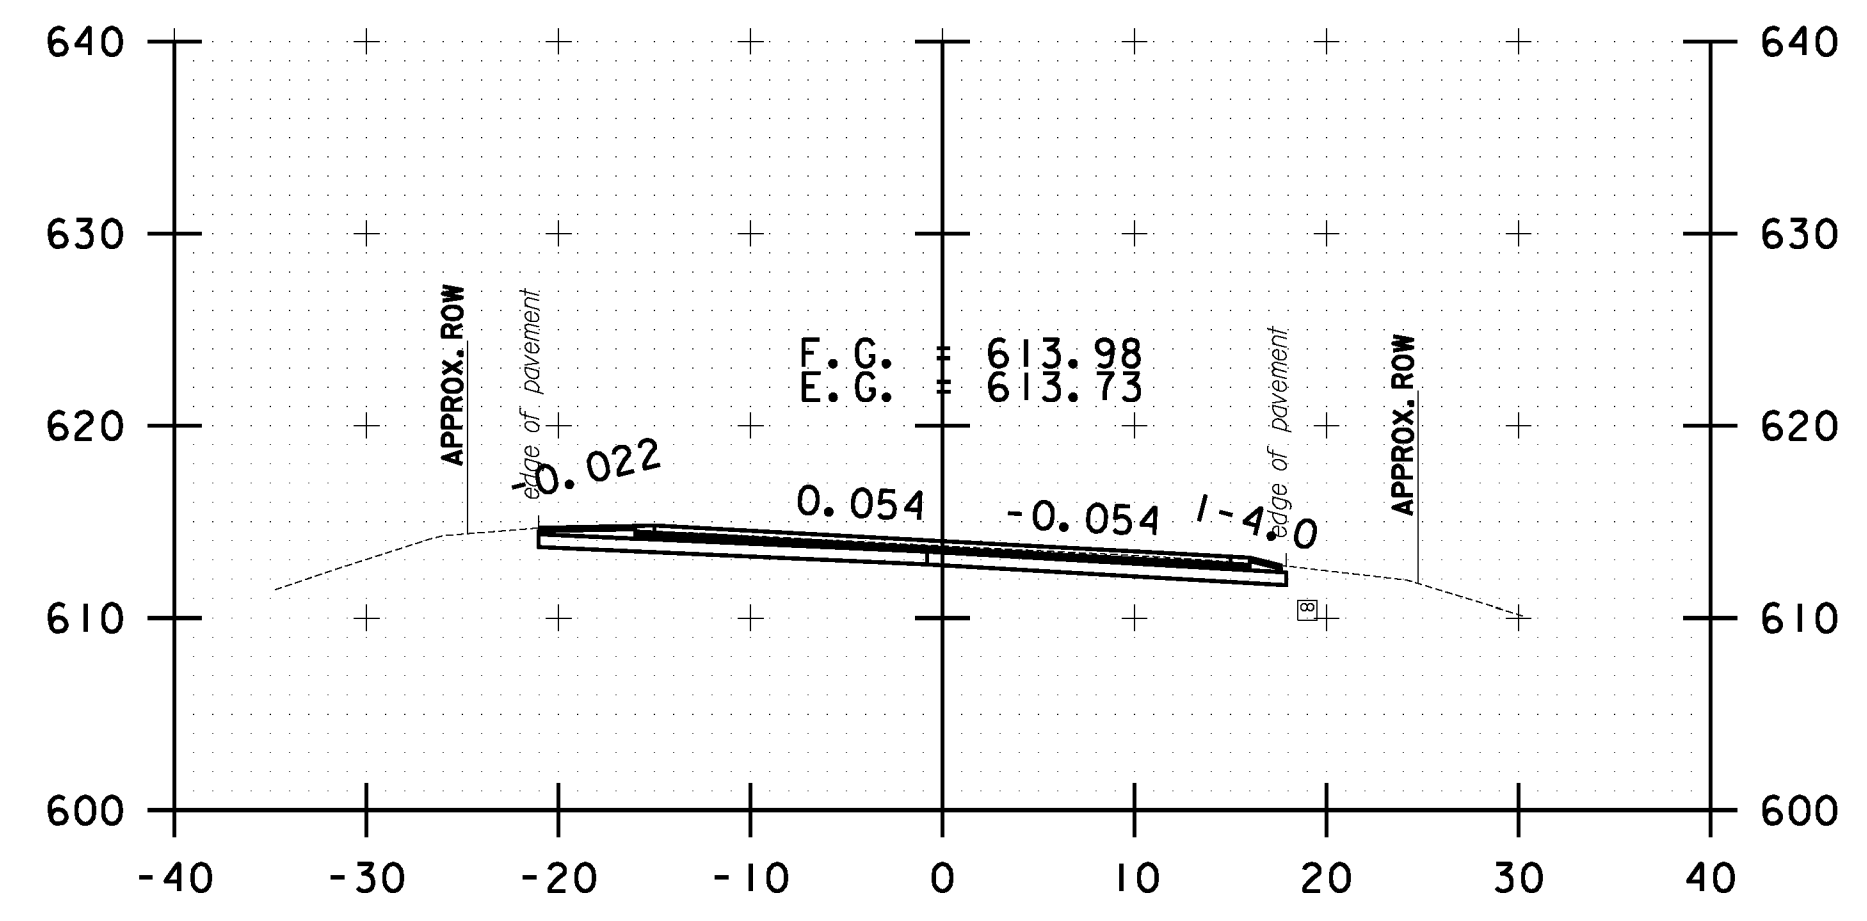


B 61+00.00

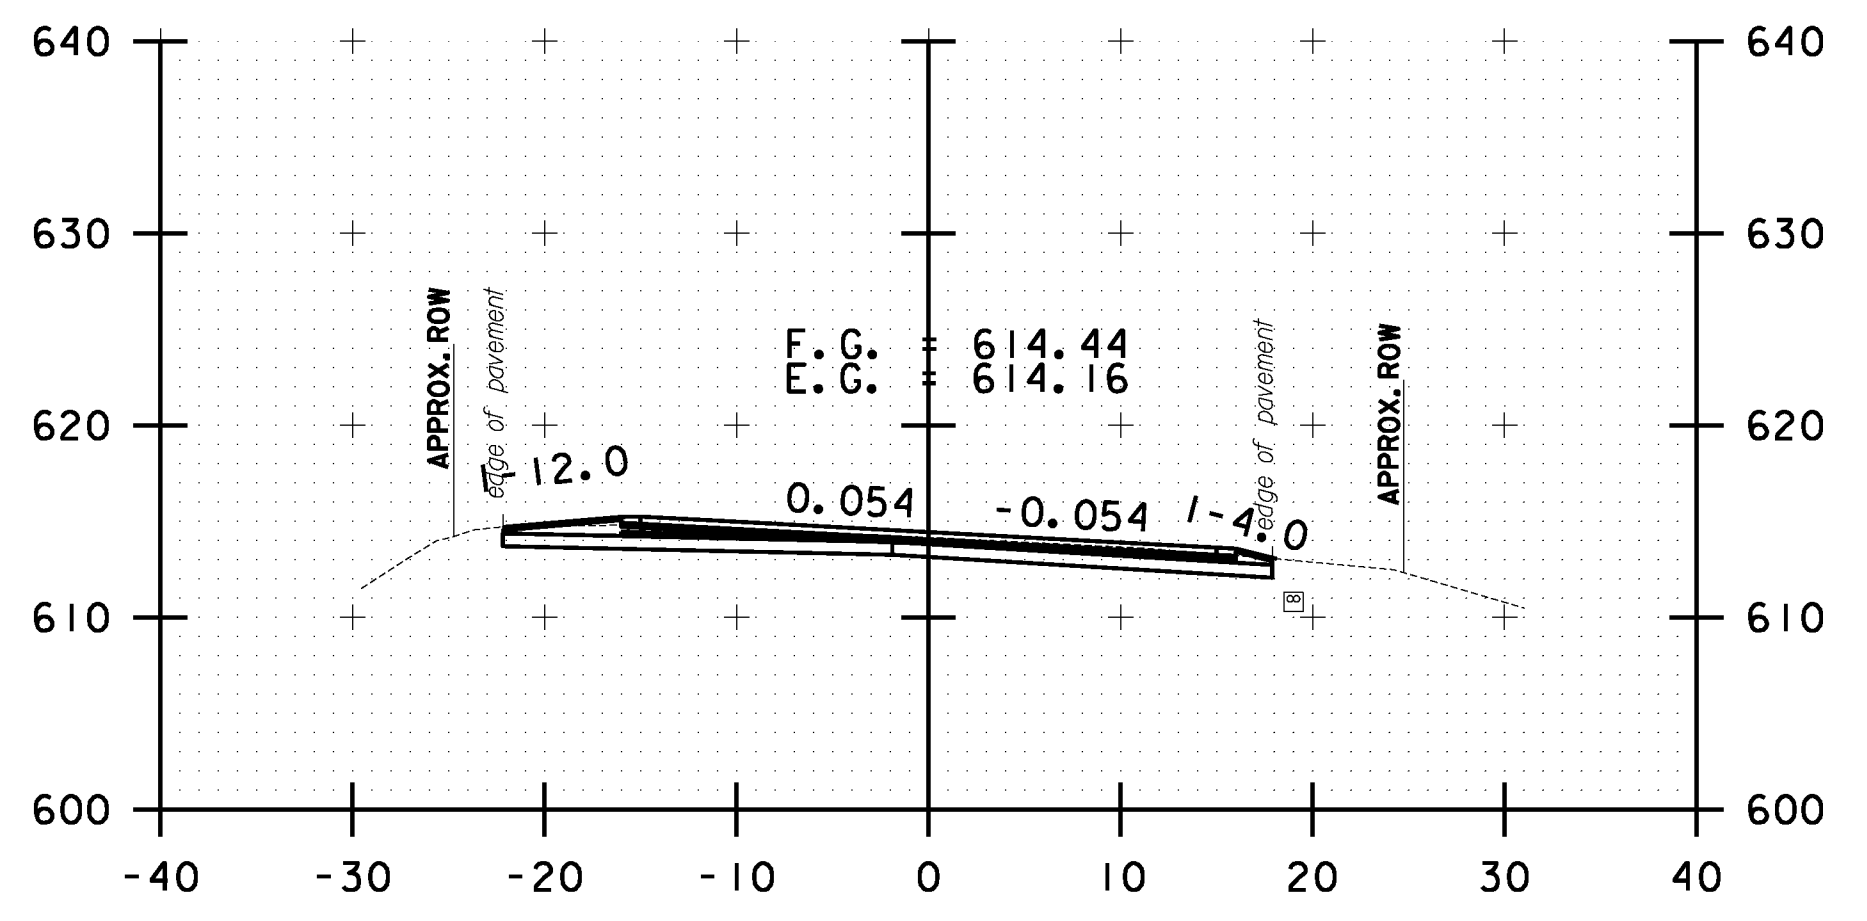


B 63+50.00

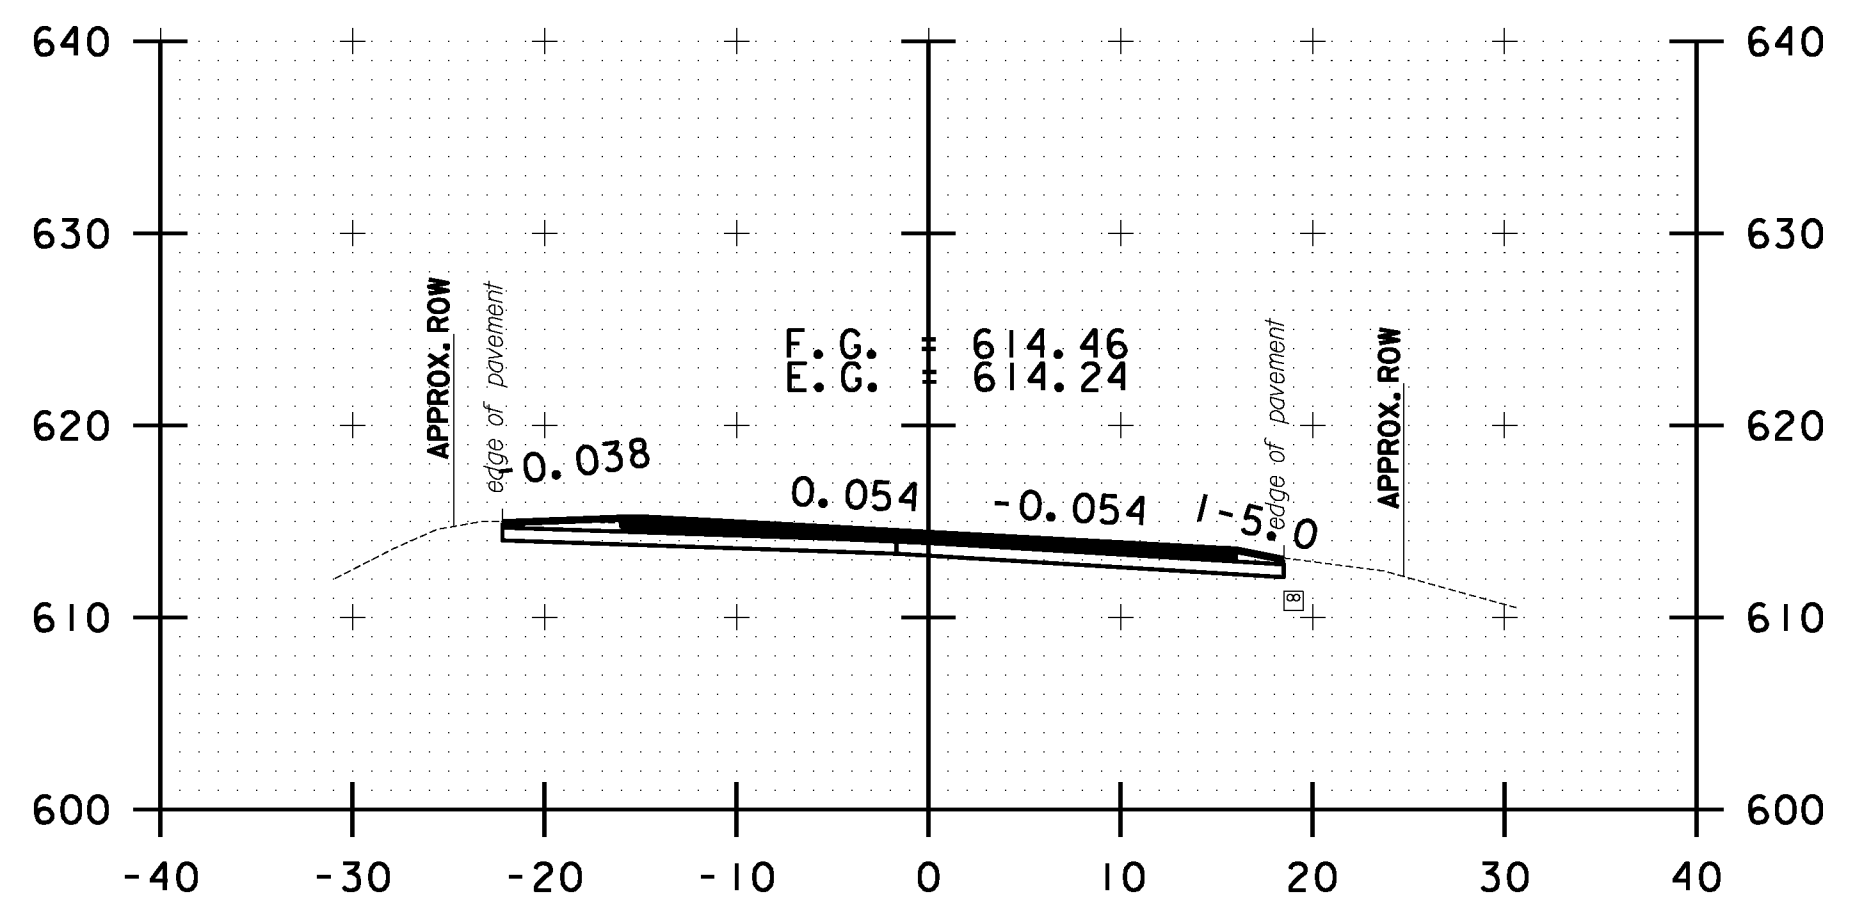

B 63+00.00

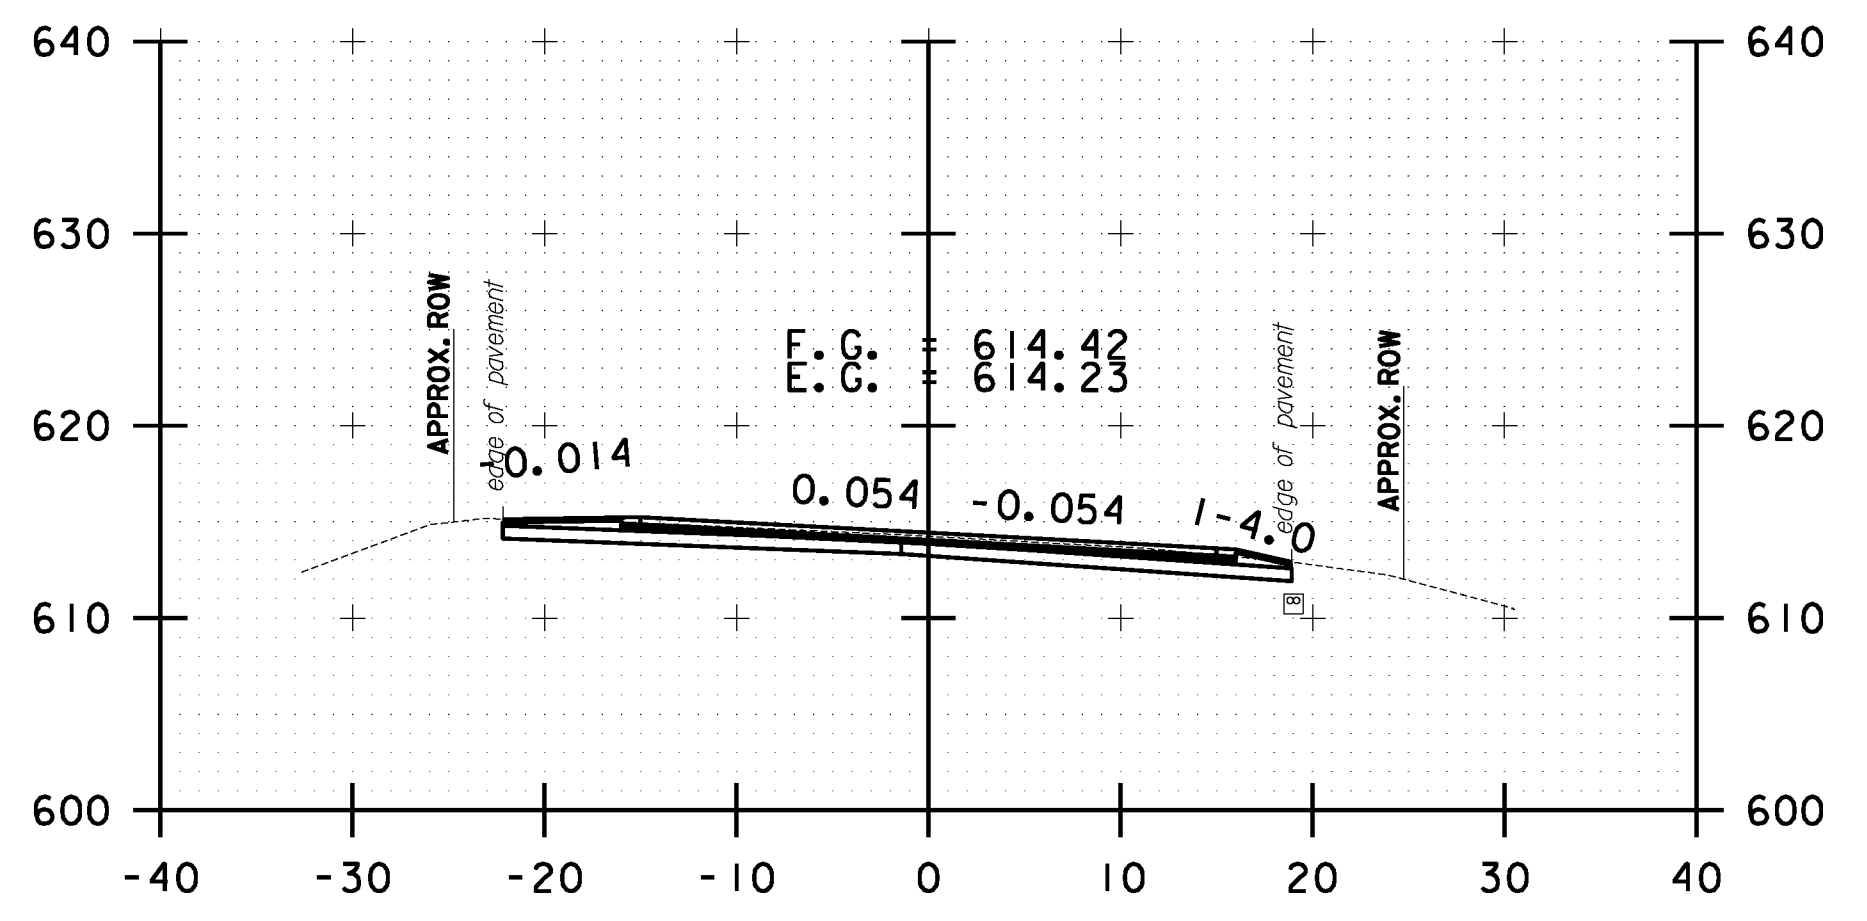

B 62+50.00

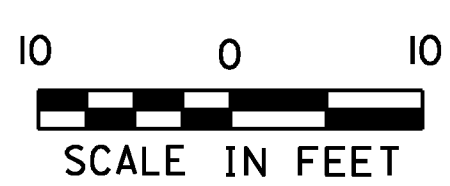

<b>BETHEL CROSS SECTION SHEET #21</b>	PROJECT NAME: STOCKBRIDGE-BETHEL
	PROJECT NUMBER: STP 2910(1)
	FILE NAME: z10b214.bethel.xc.dgn
	IPARM FILE: z10b214.xs133.1
	PLOT DATE: 3/17/2014
	DRAWN BY: W.C.P.
	CHECKED BY: J.P.S.
	SHEET 346 OF 397