




FILE NAME = V:\P\c\ass\ANY\K2\22425\CADD\MSTN\10b214.bethel.xc.dgn
 DATE/TIME = 3/17/2014
 USER = 4916

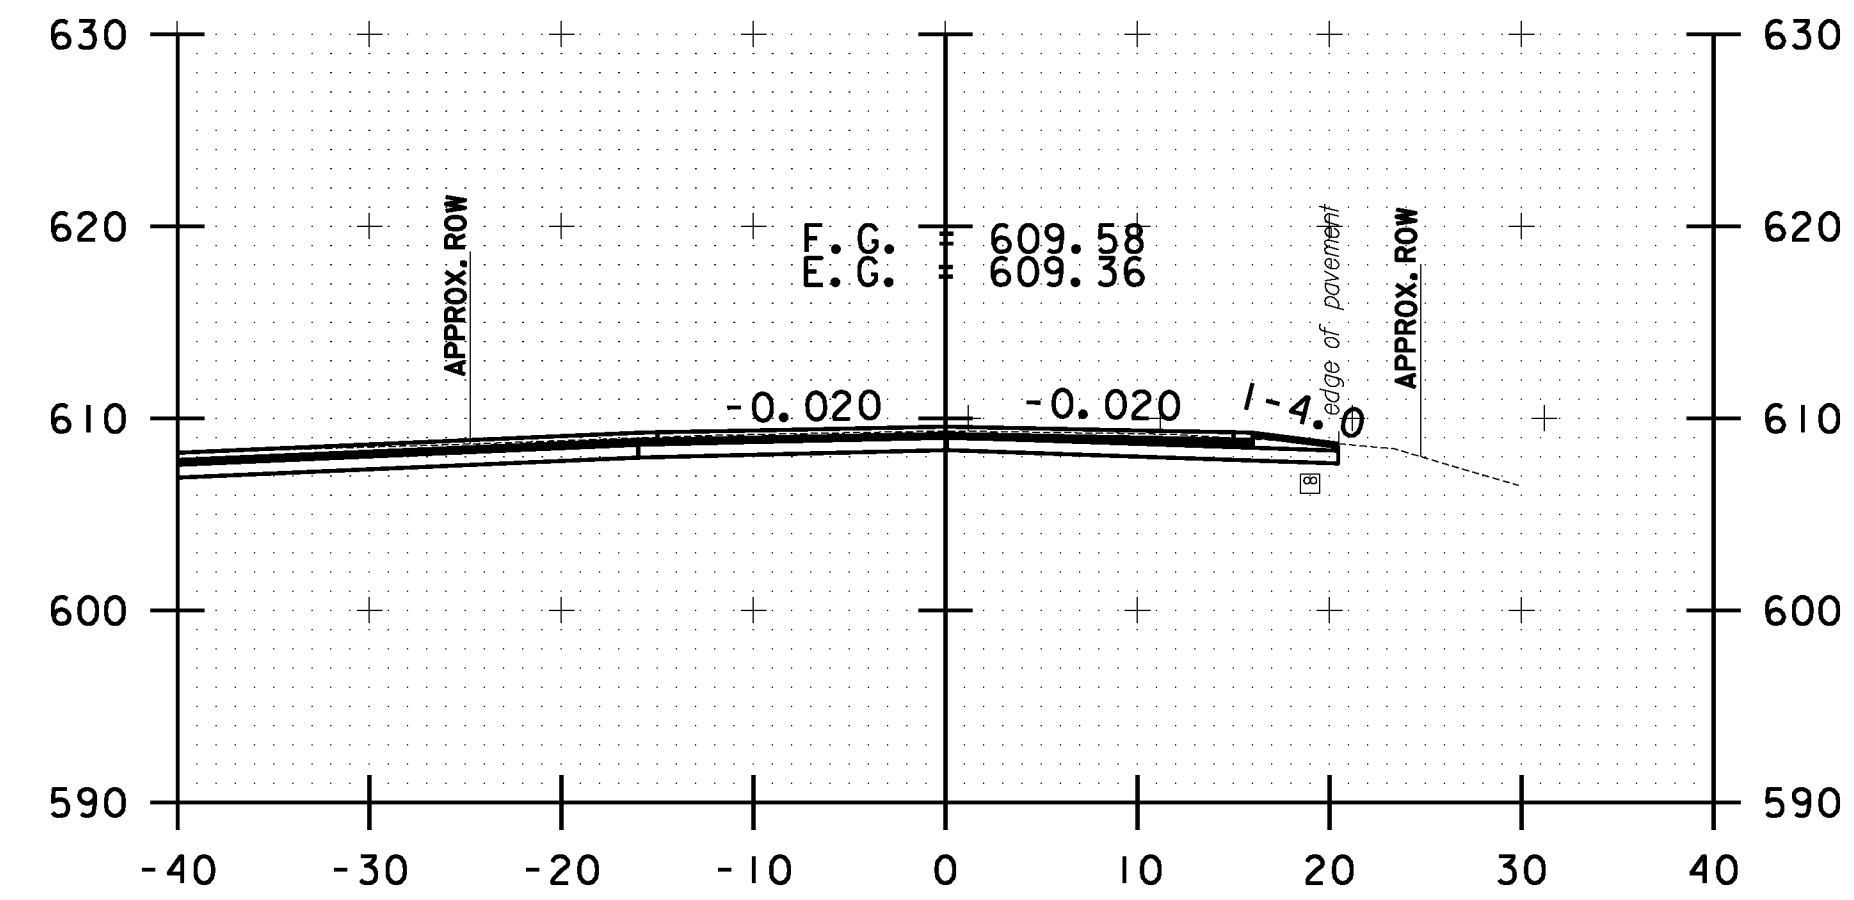


B 71+00.00

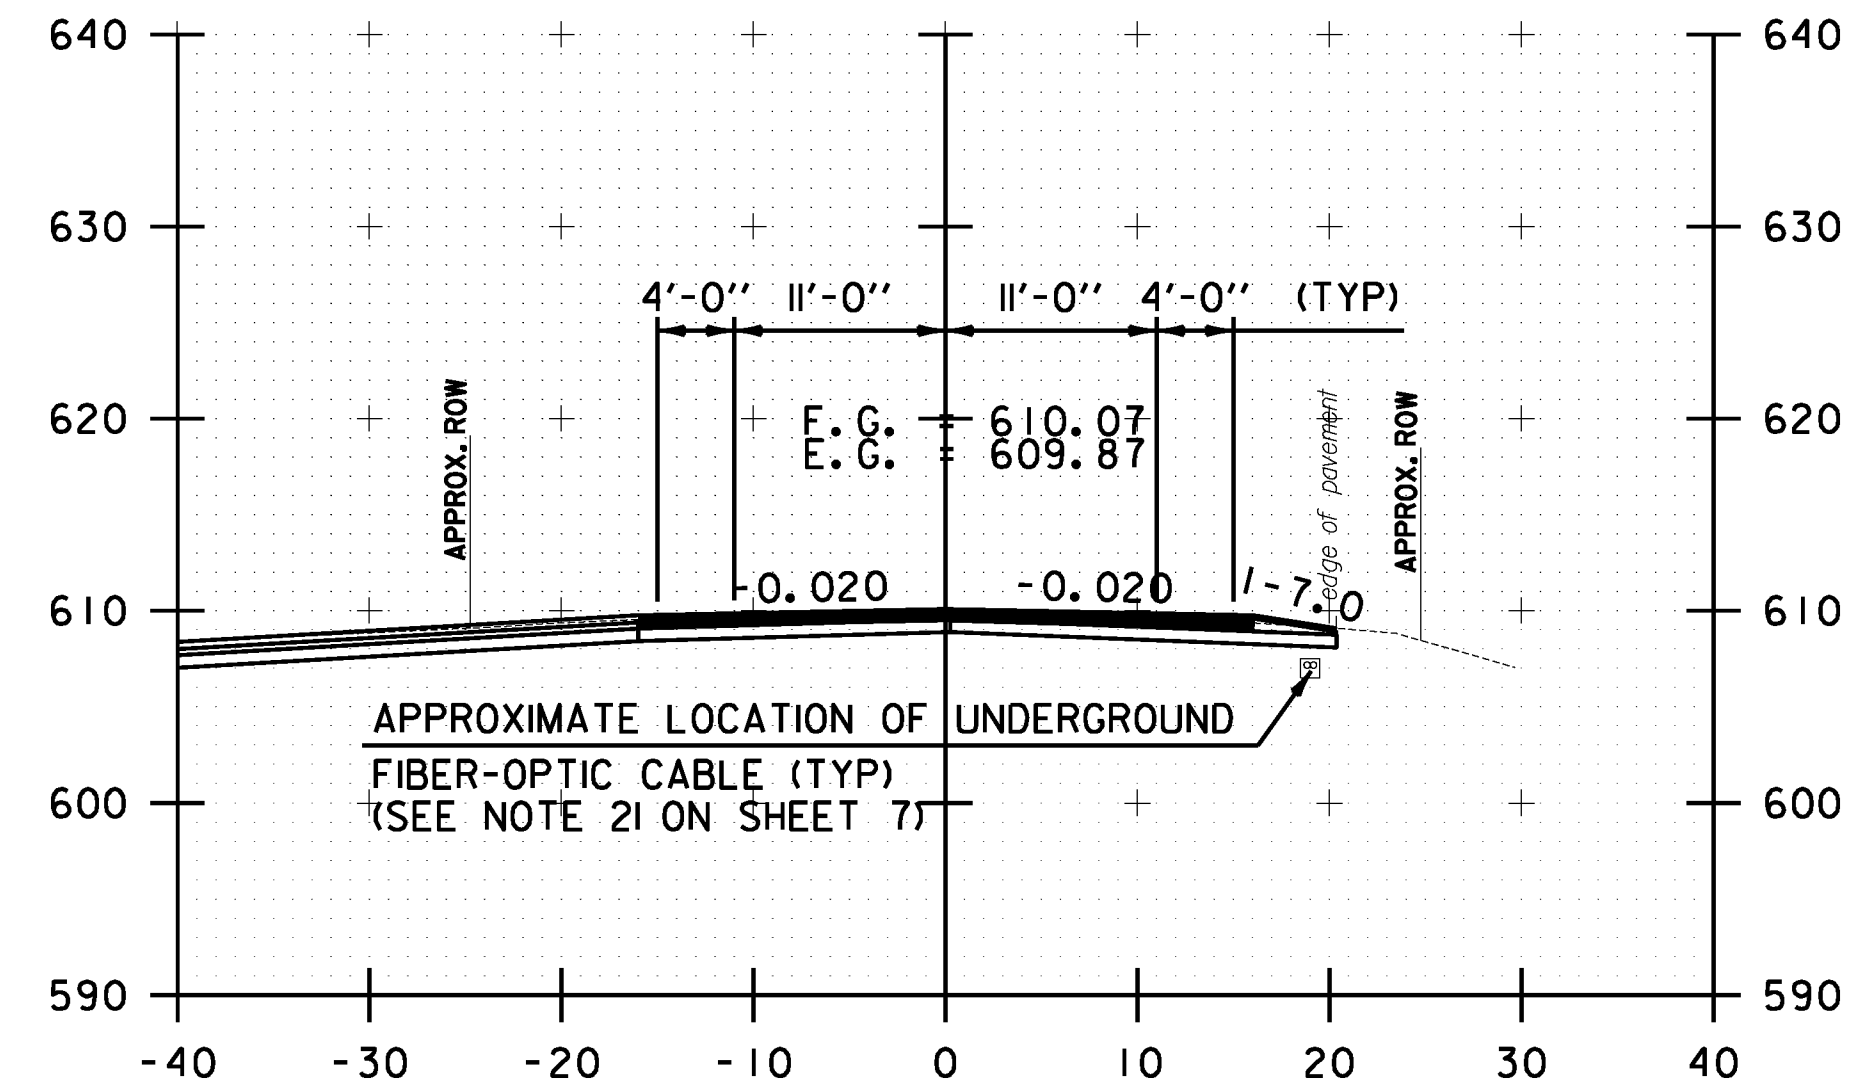


B 70+50.00

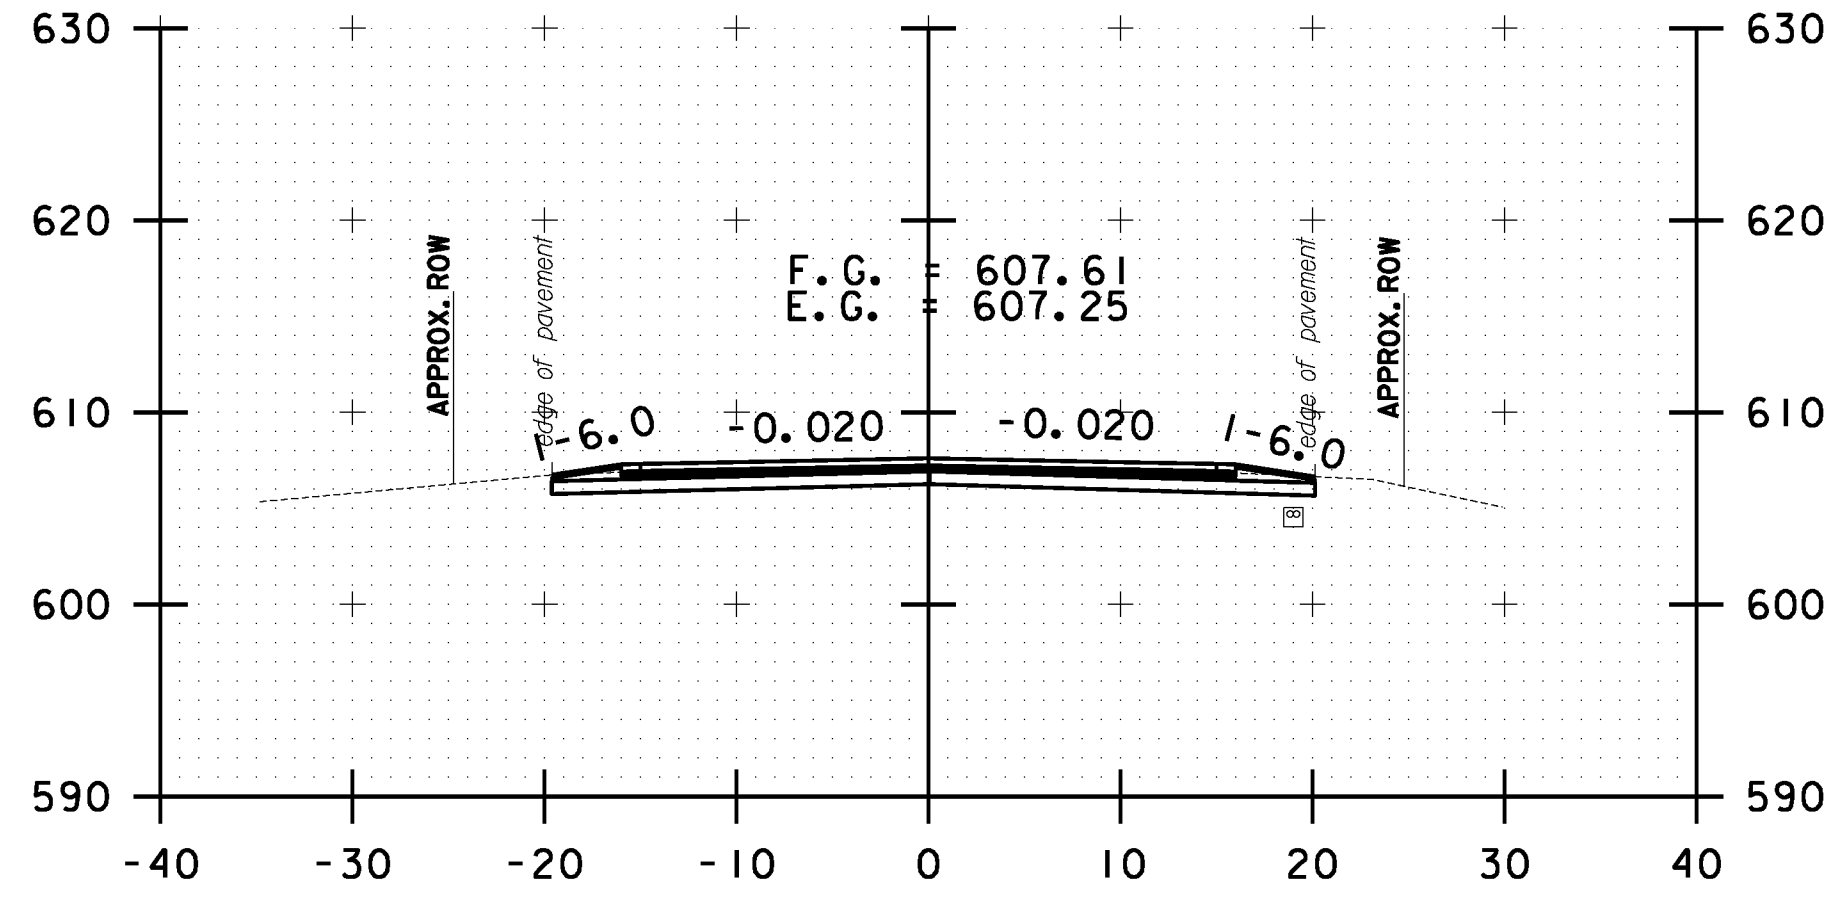


B 72+50.00

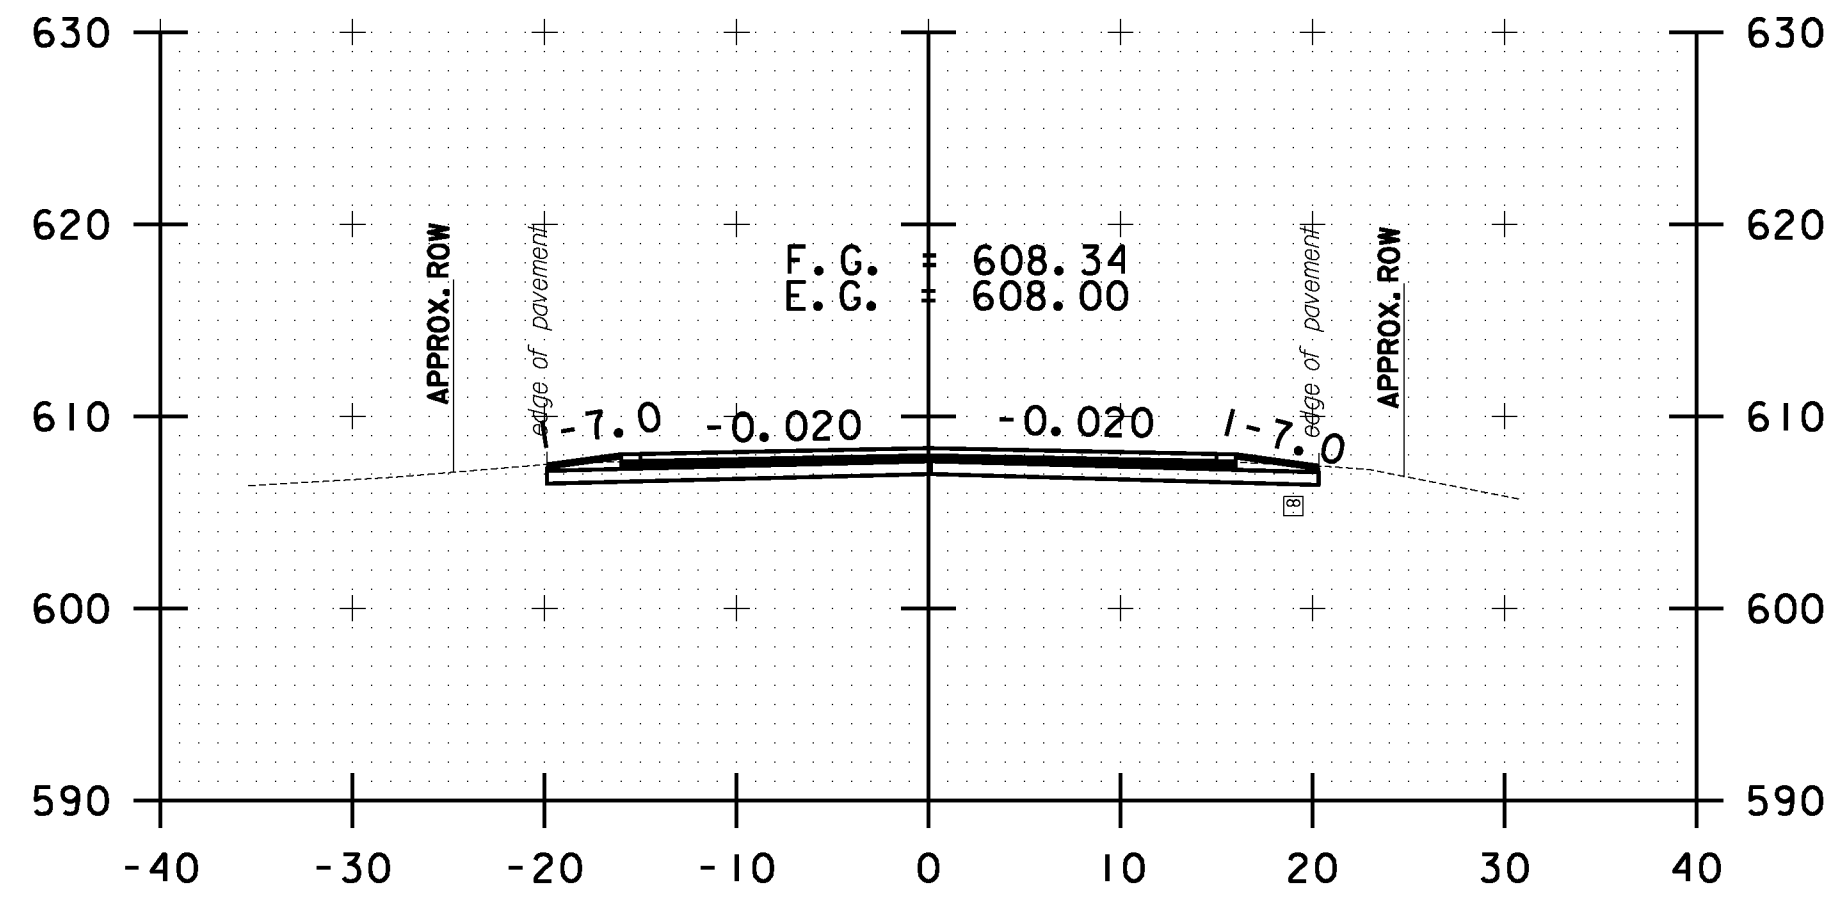


B 72+00.00

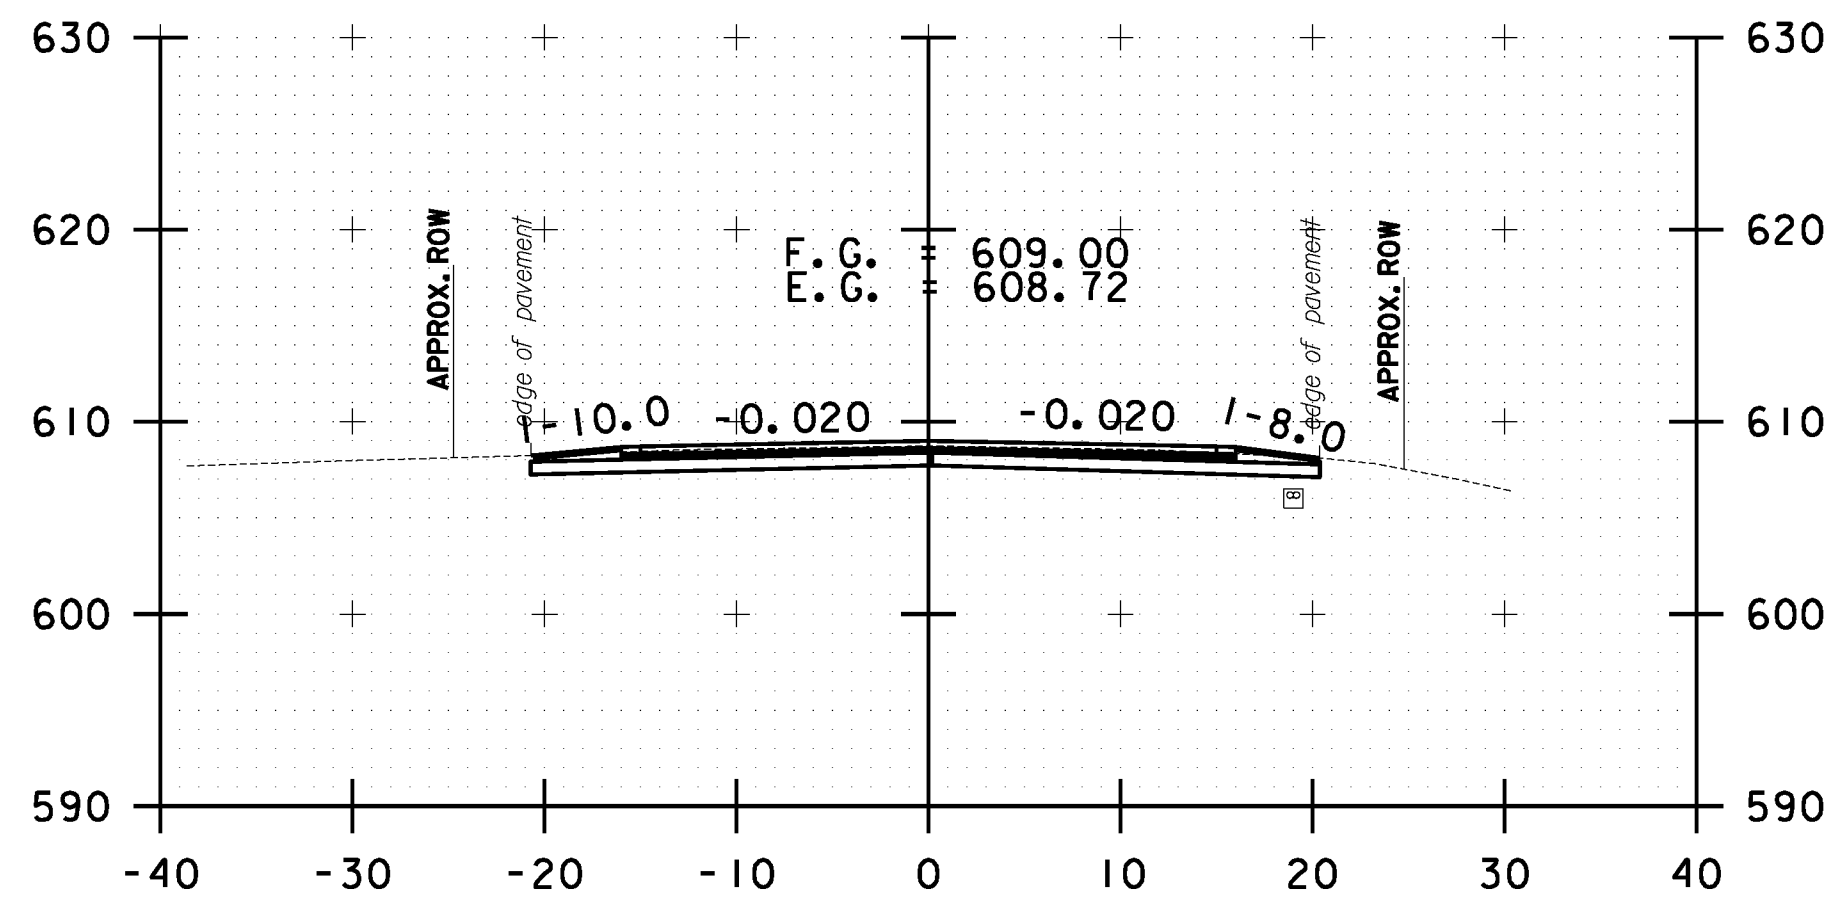


B 71+50.00

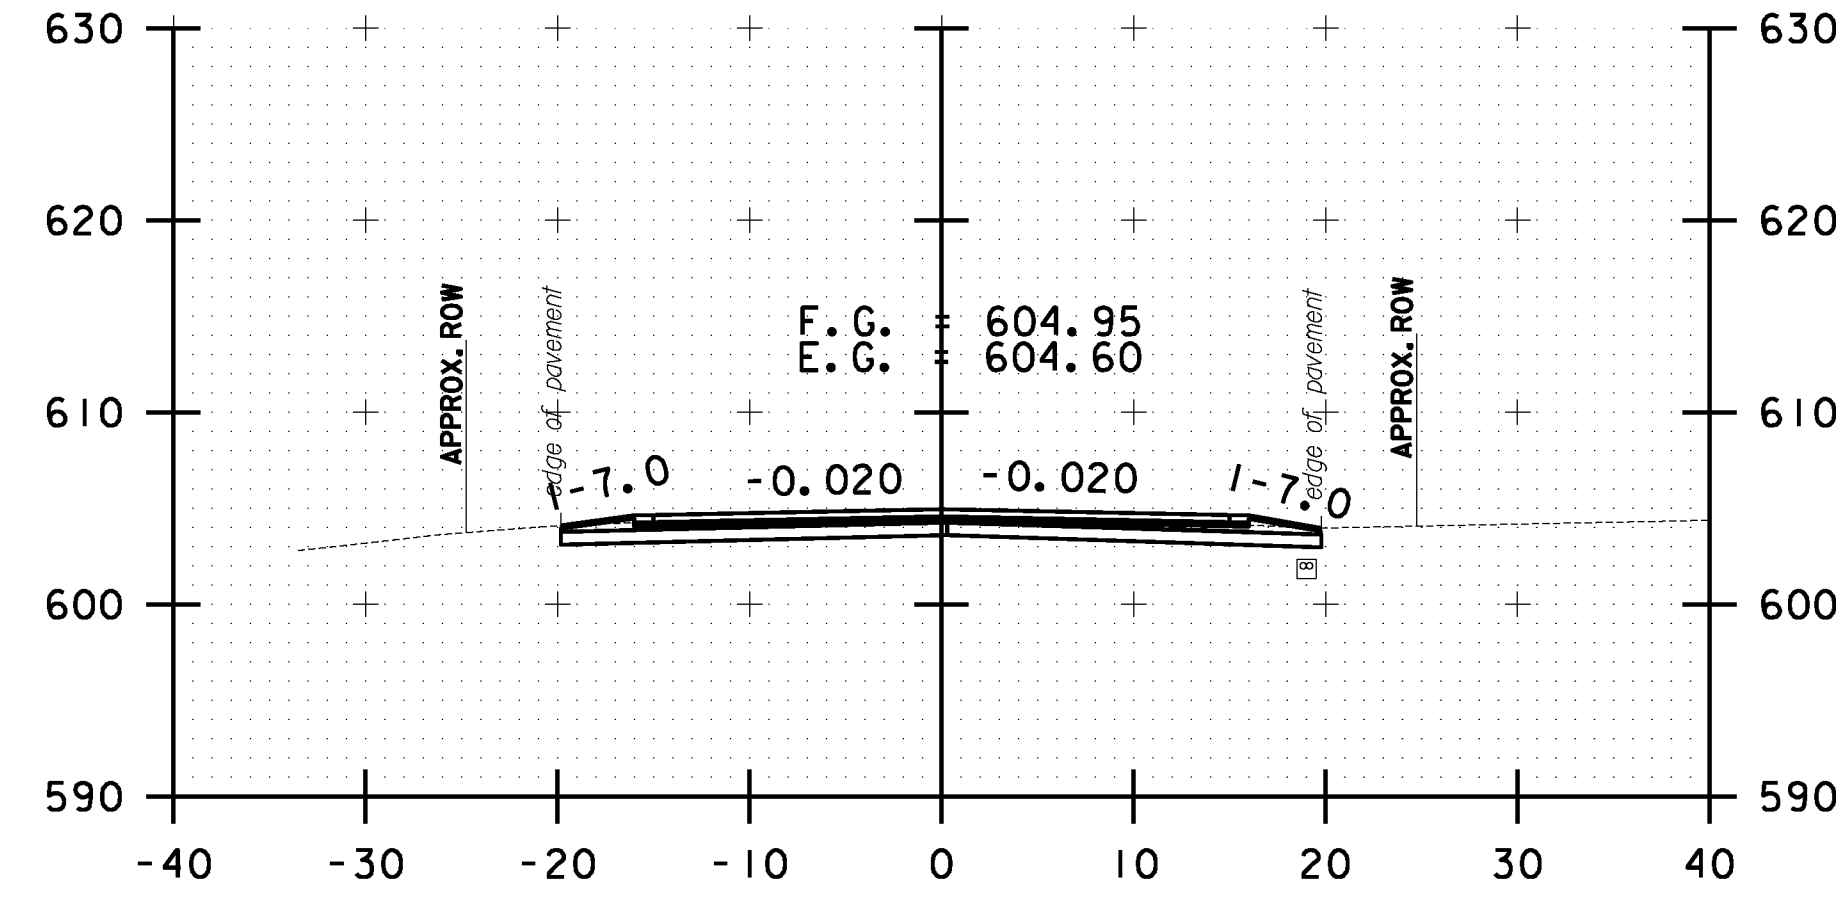

B 74+00.00

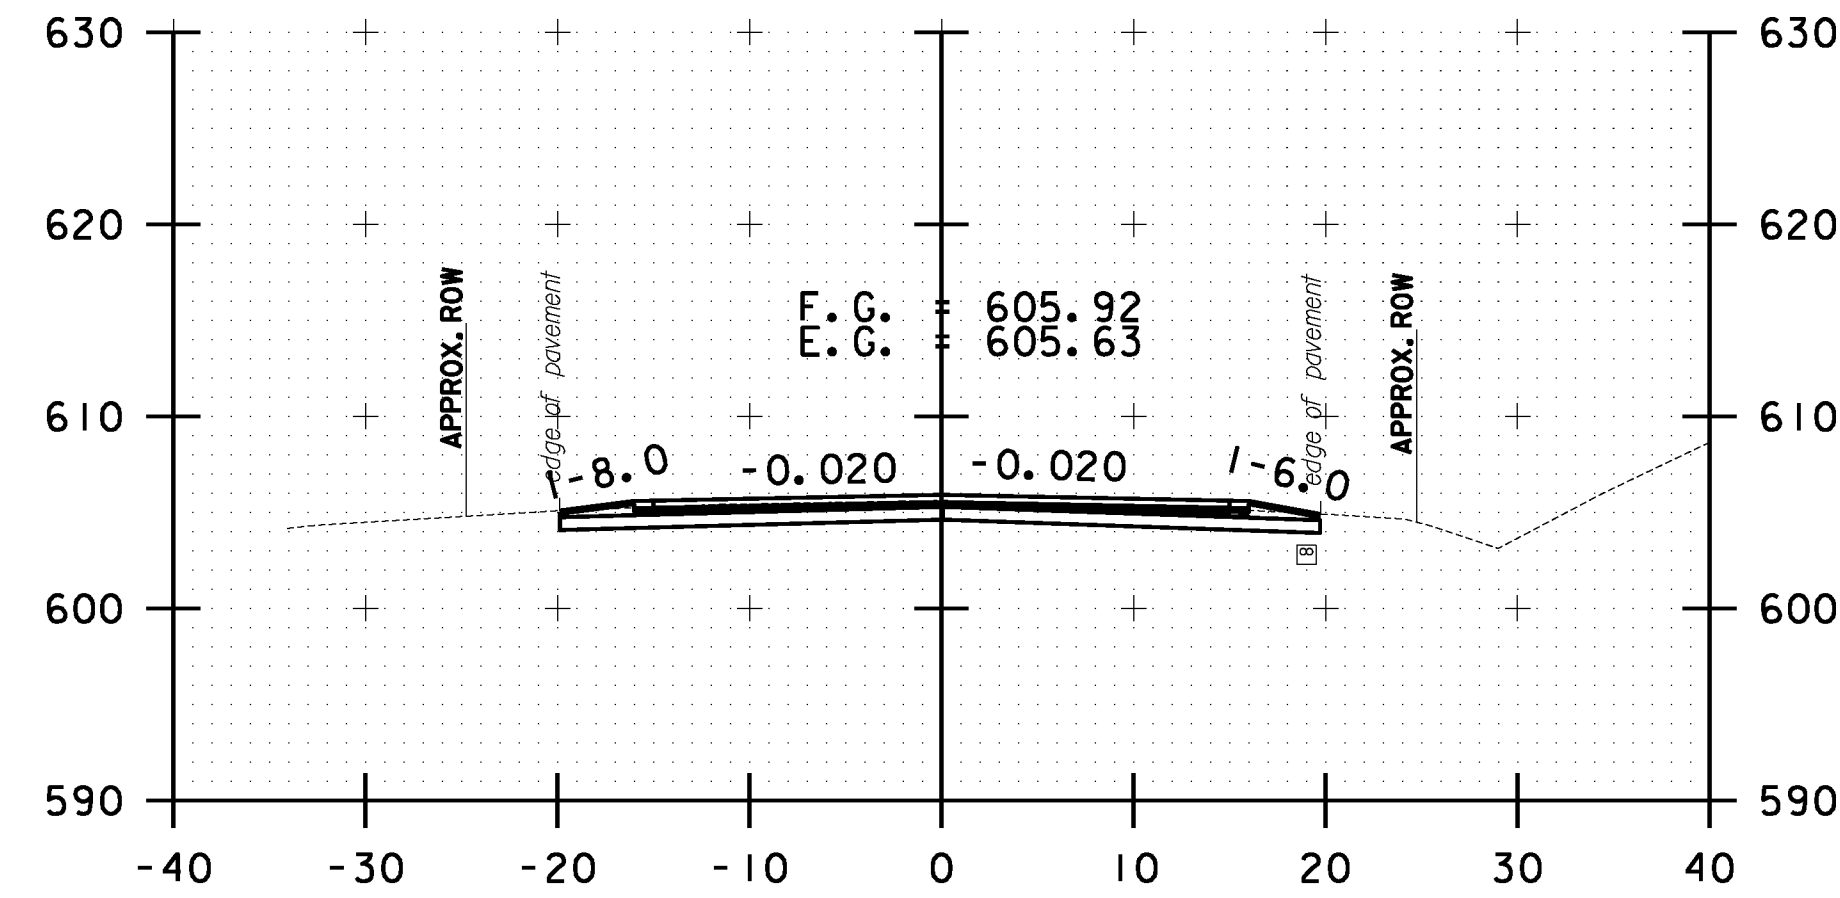

B 73+50.00

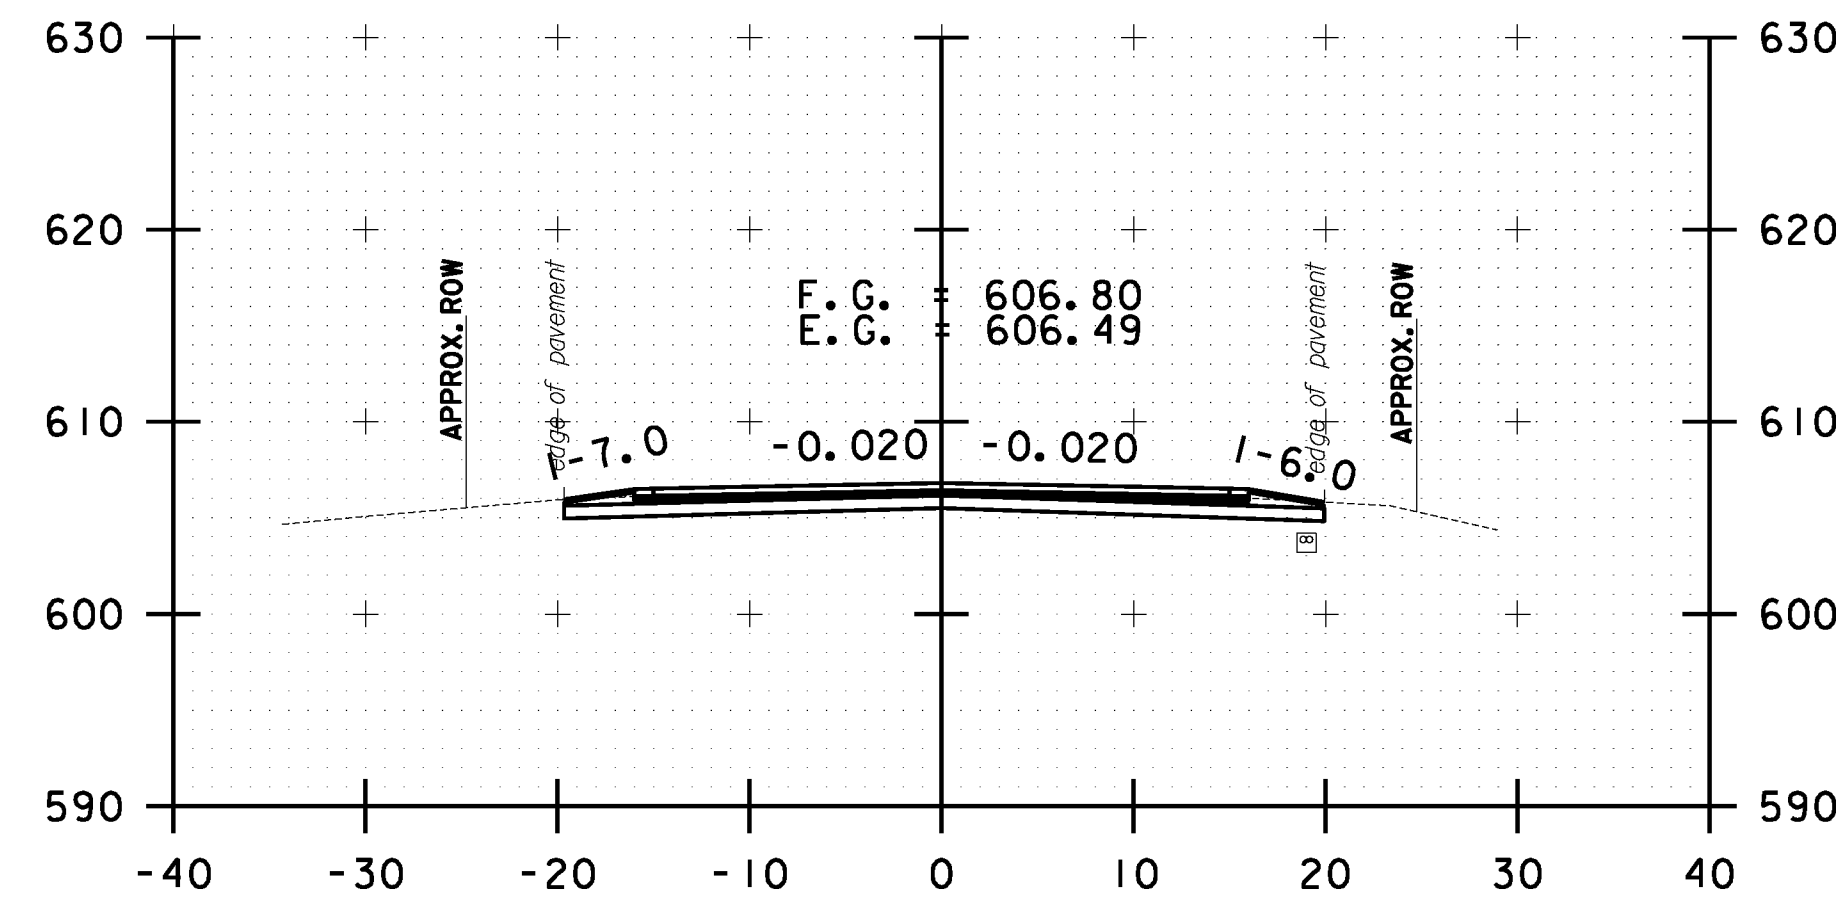

B 73+00.00



BETHEL CROSS SECTION SHEET #24	PROJECT NAME: STOCKBRIDGE-BETHEL
	PROJECT NUMBER: STP 2910(1)
	FILE NAME: z10b214.bethel.xc.dgn
	IPARM FILE: z10b214xs136.1
	PLOT DATE: 3/17/2014
	DRAWN BY: W.G.P.
	CHECKED BY: J.P.S.
	SHEET 349 OF 397