




FILE NAME = V:\P\c\res\any\k2\22425\CADD\MSTN\10b214.bethel.xc.dgn  
 DATE/TIME = 3/17/2014  
 USER = 4916

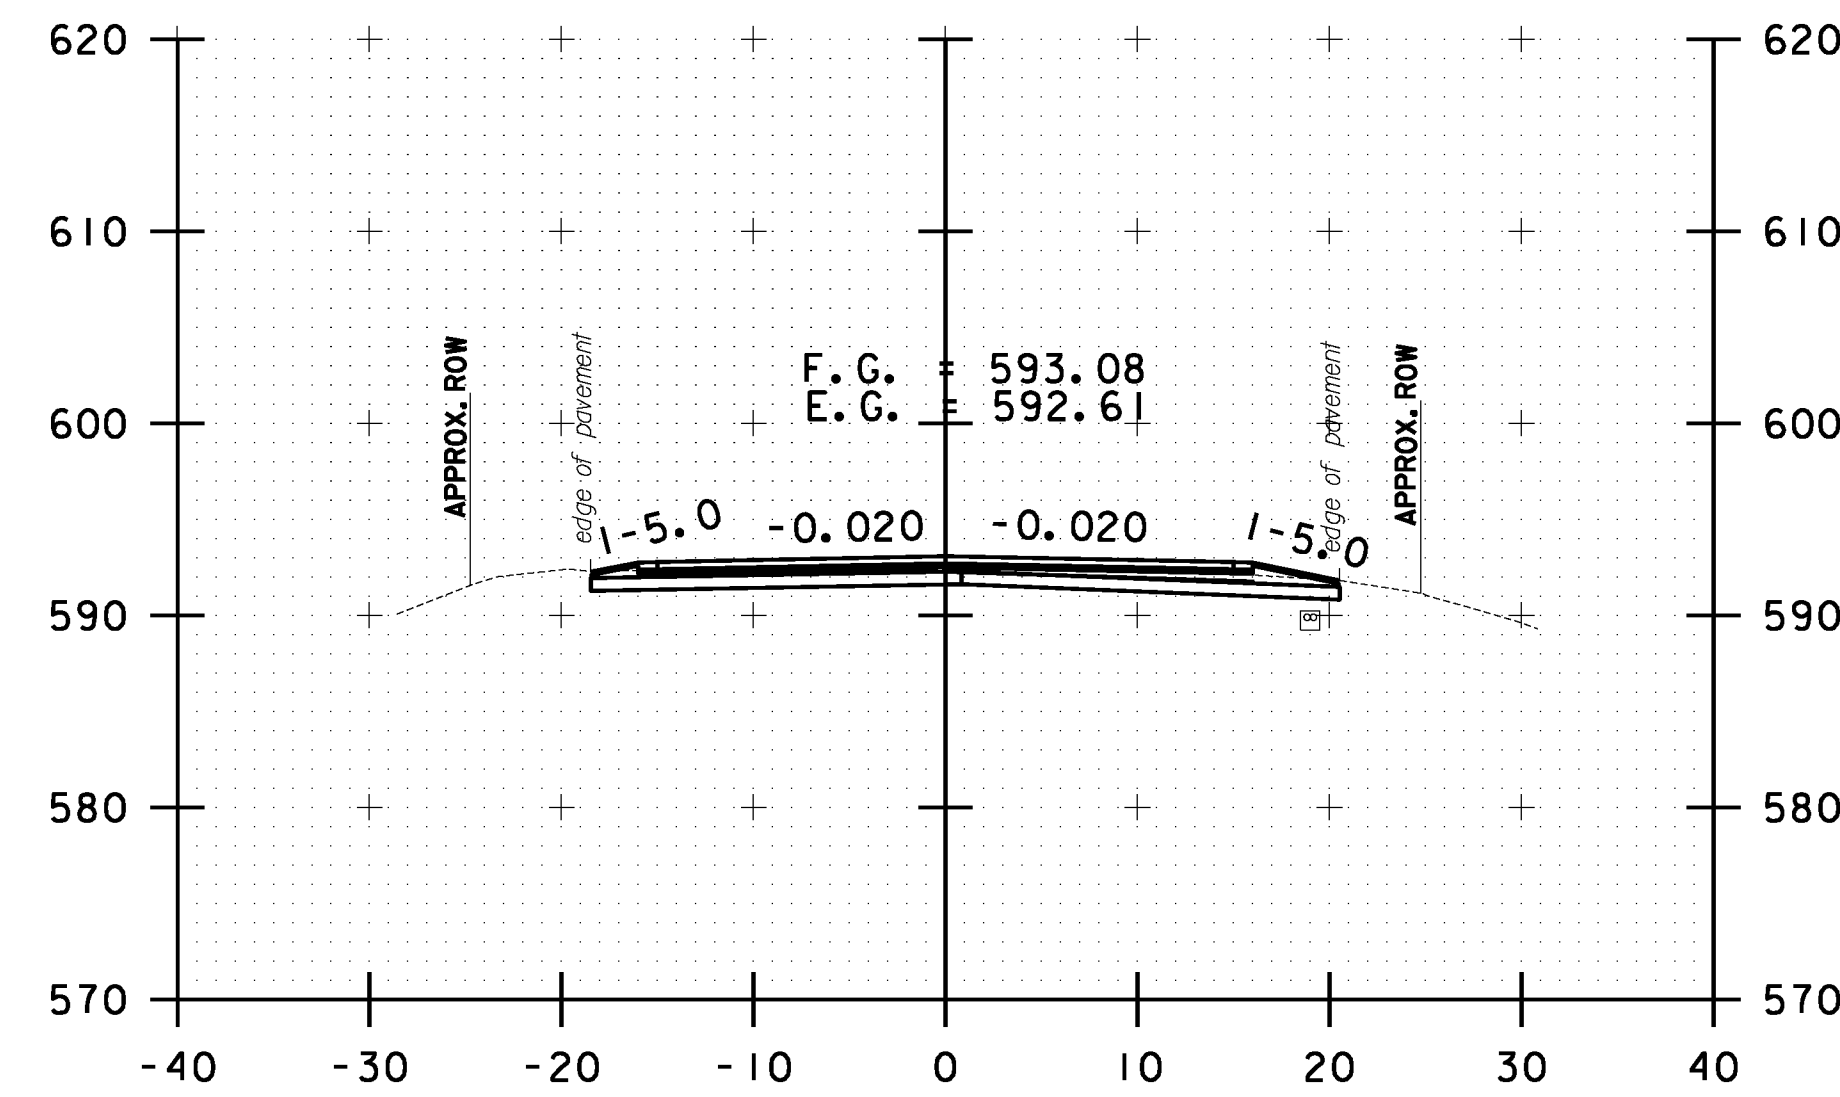


B 78+50.00

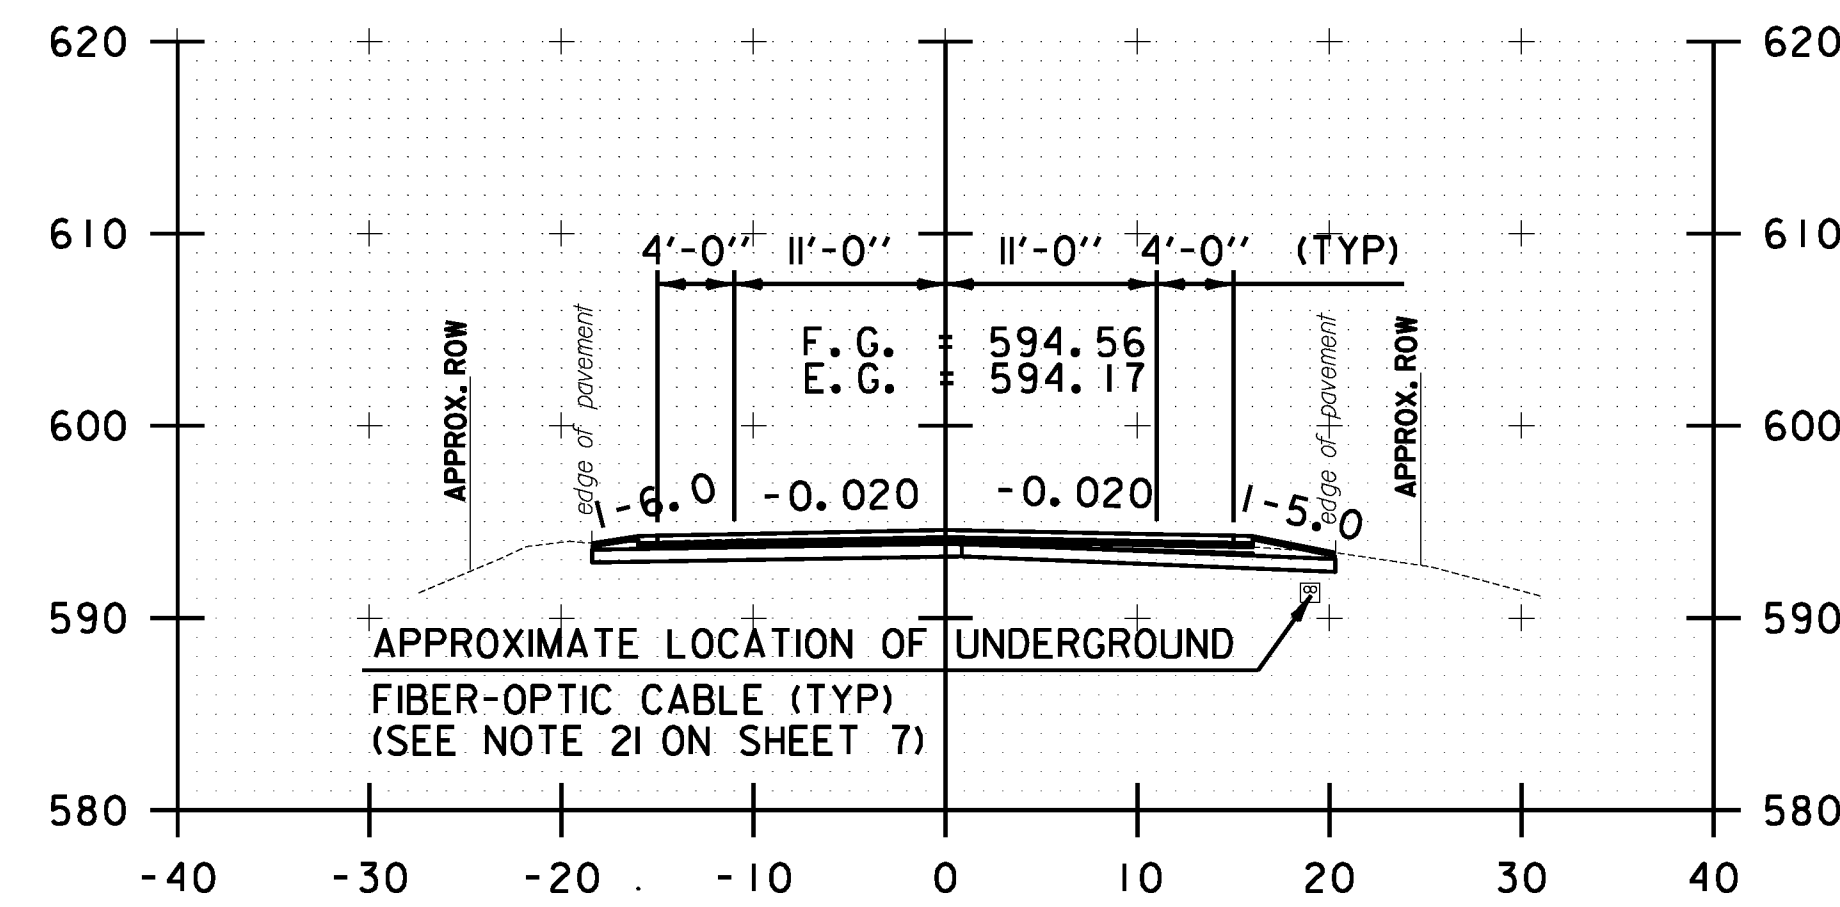


B 78+00.00

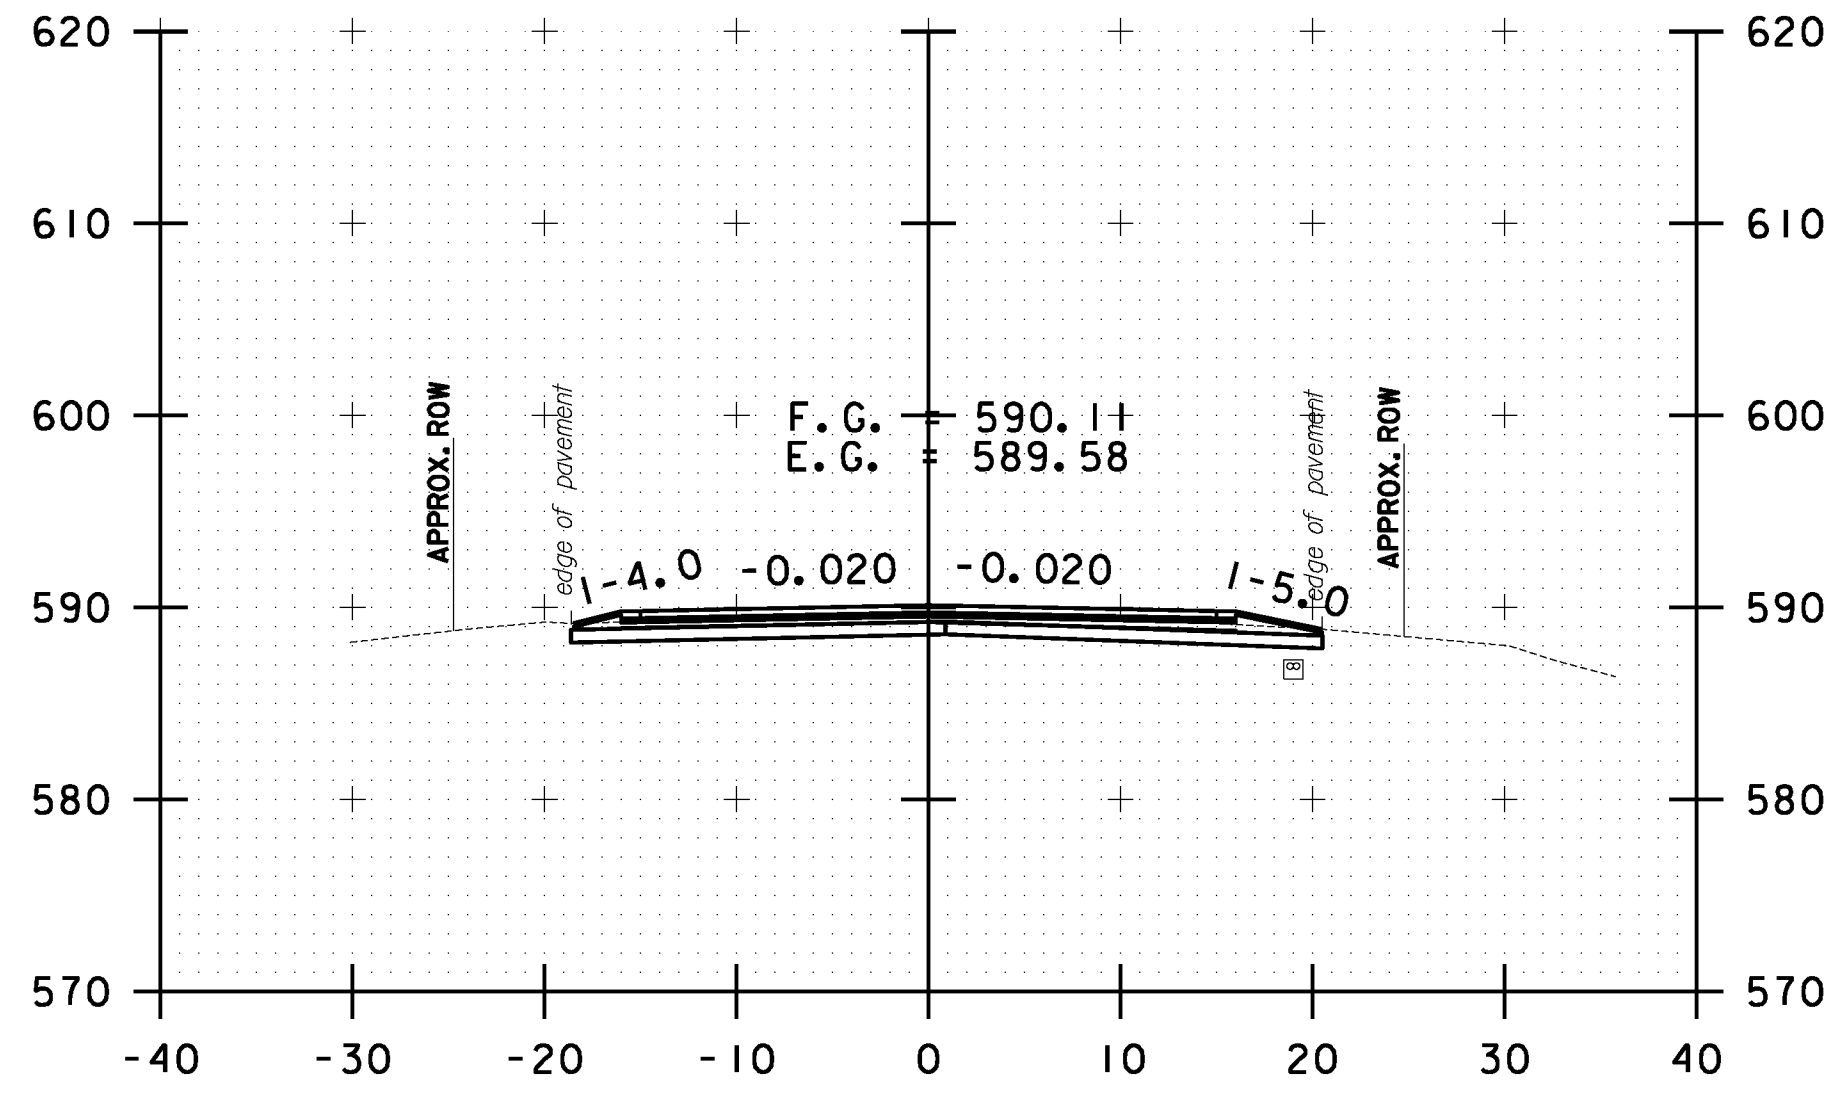


B 79+50.00

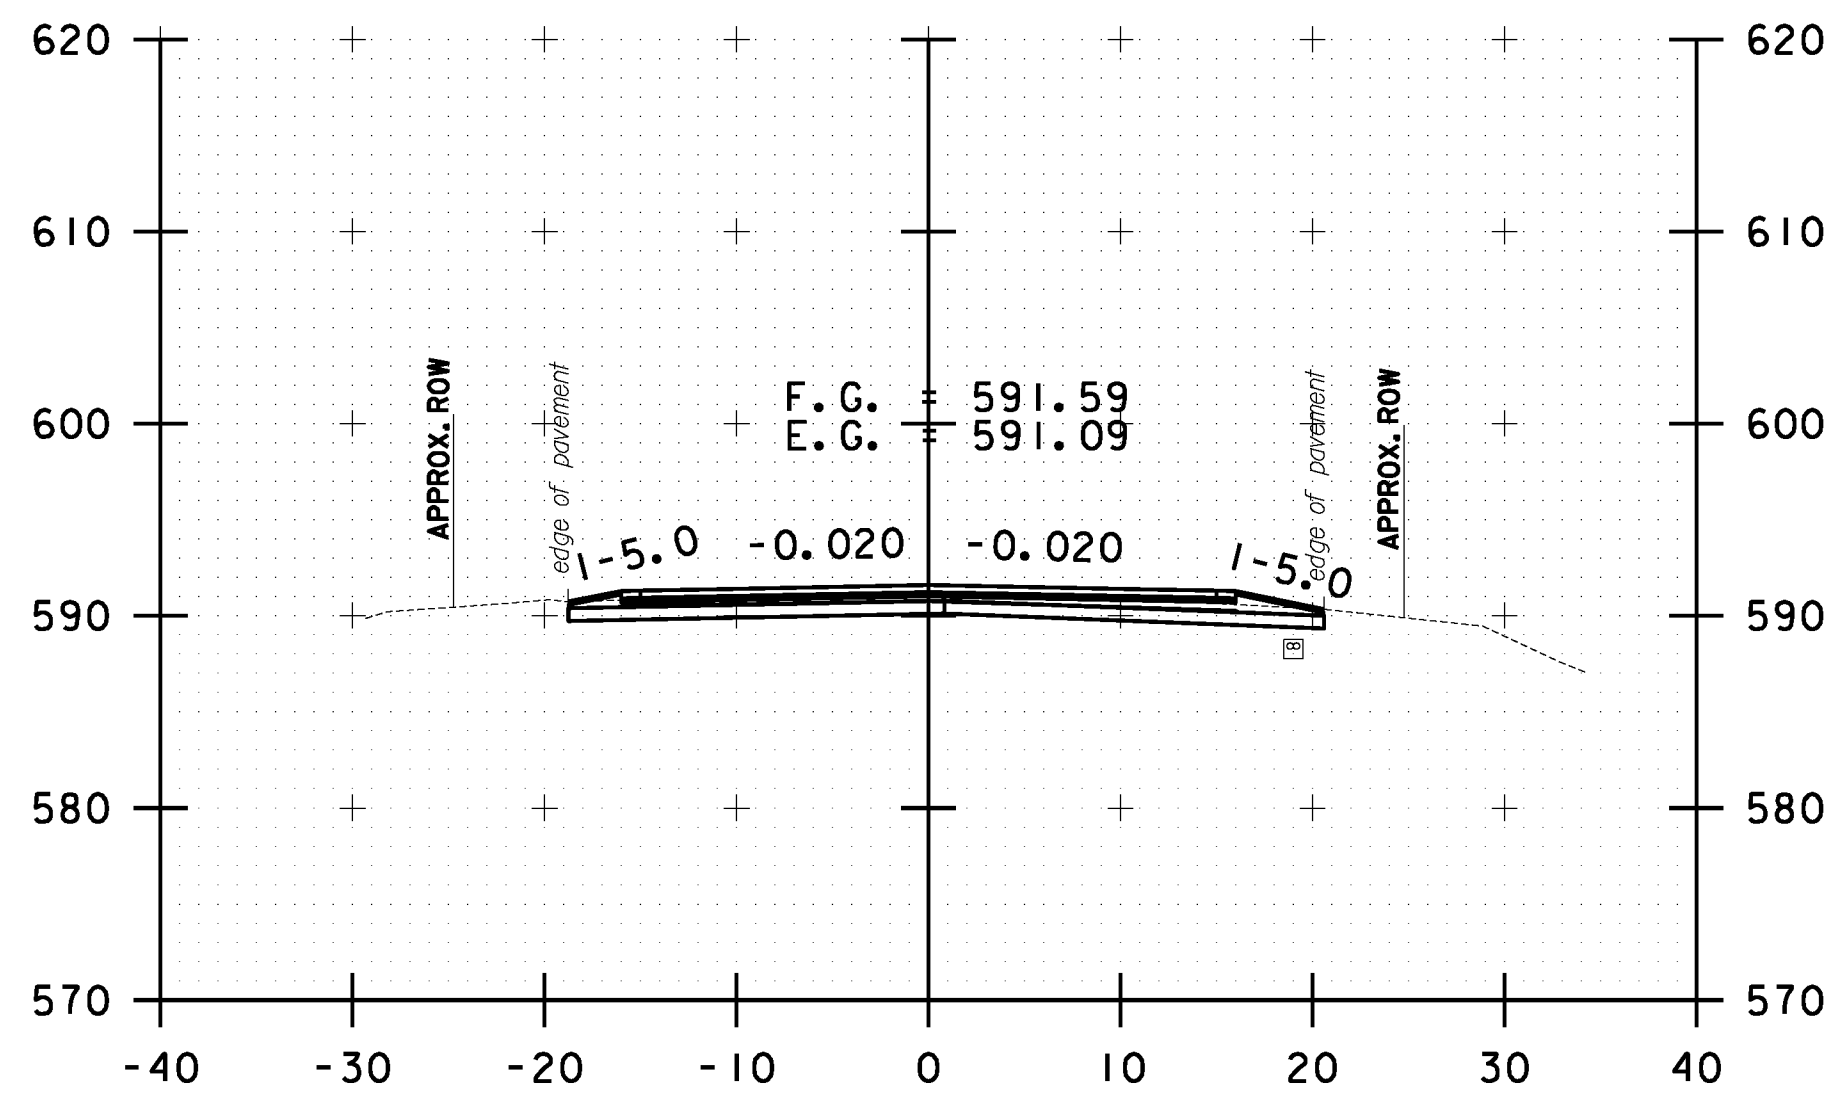


B 79+00.00

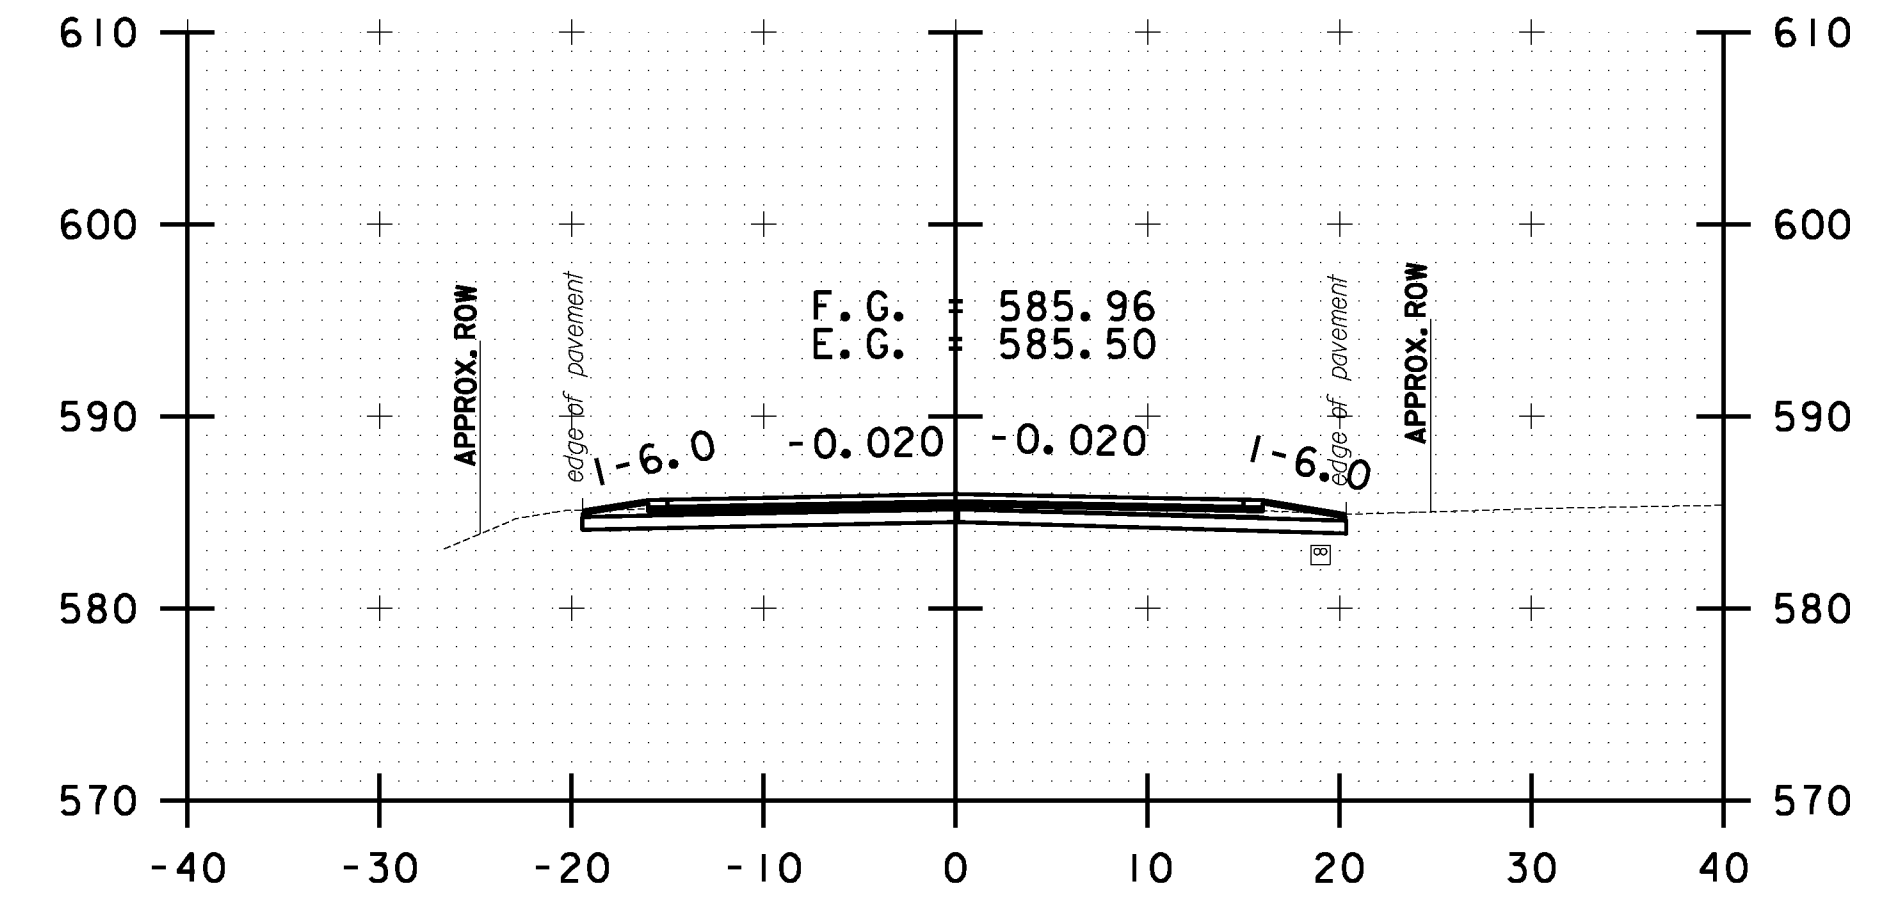


B 81+00.00

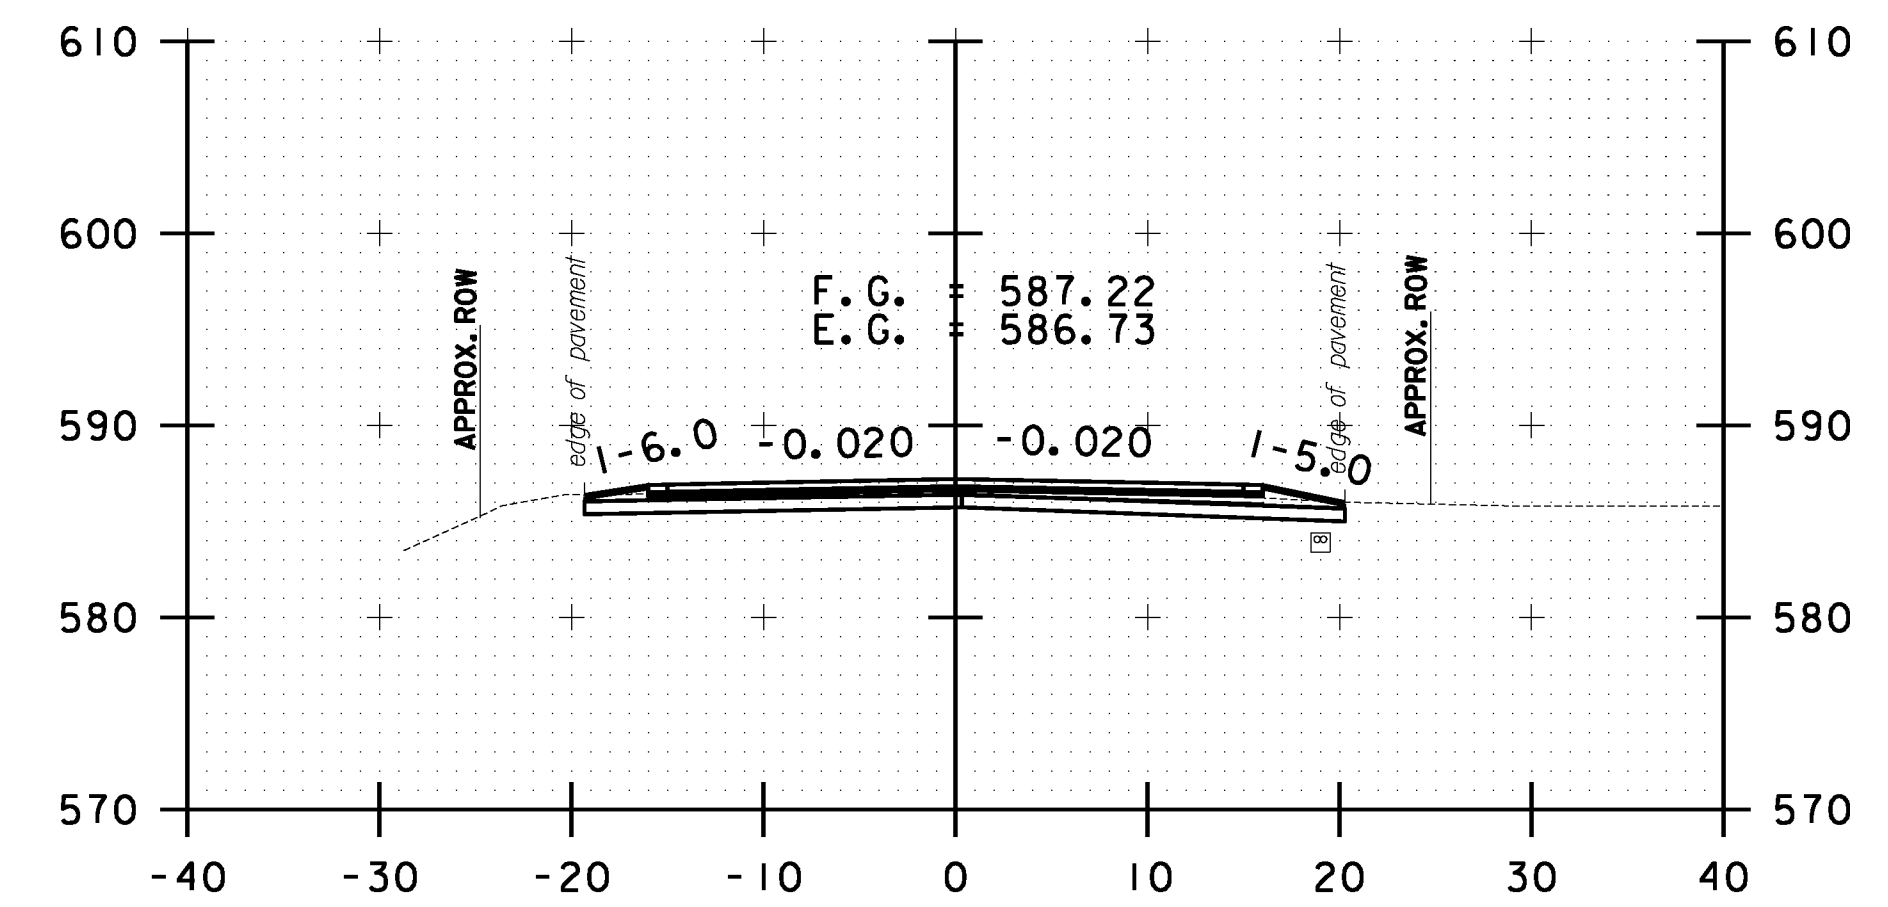

B 80+50.00

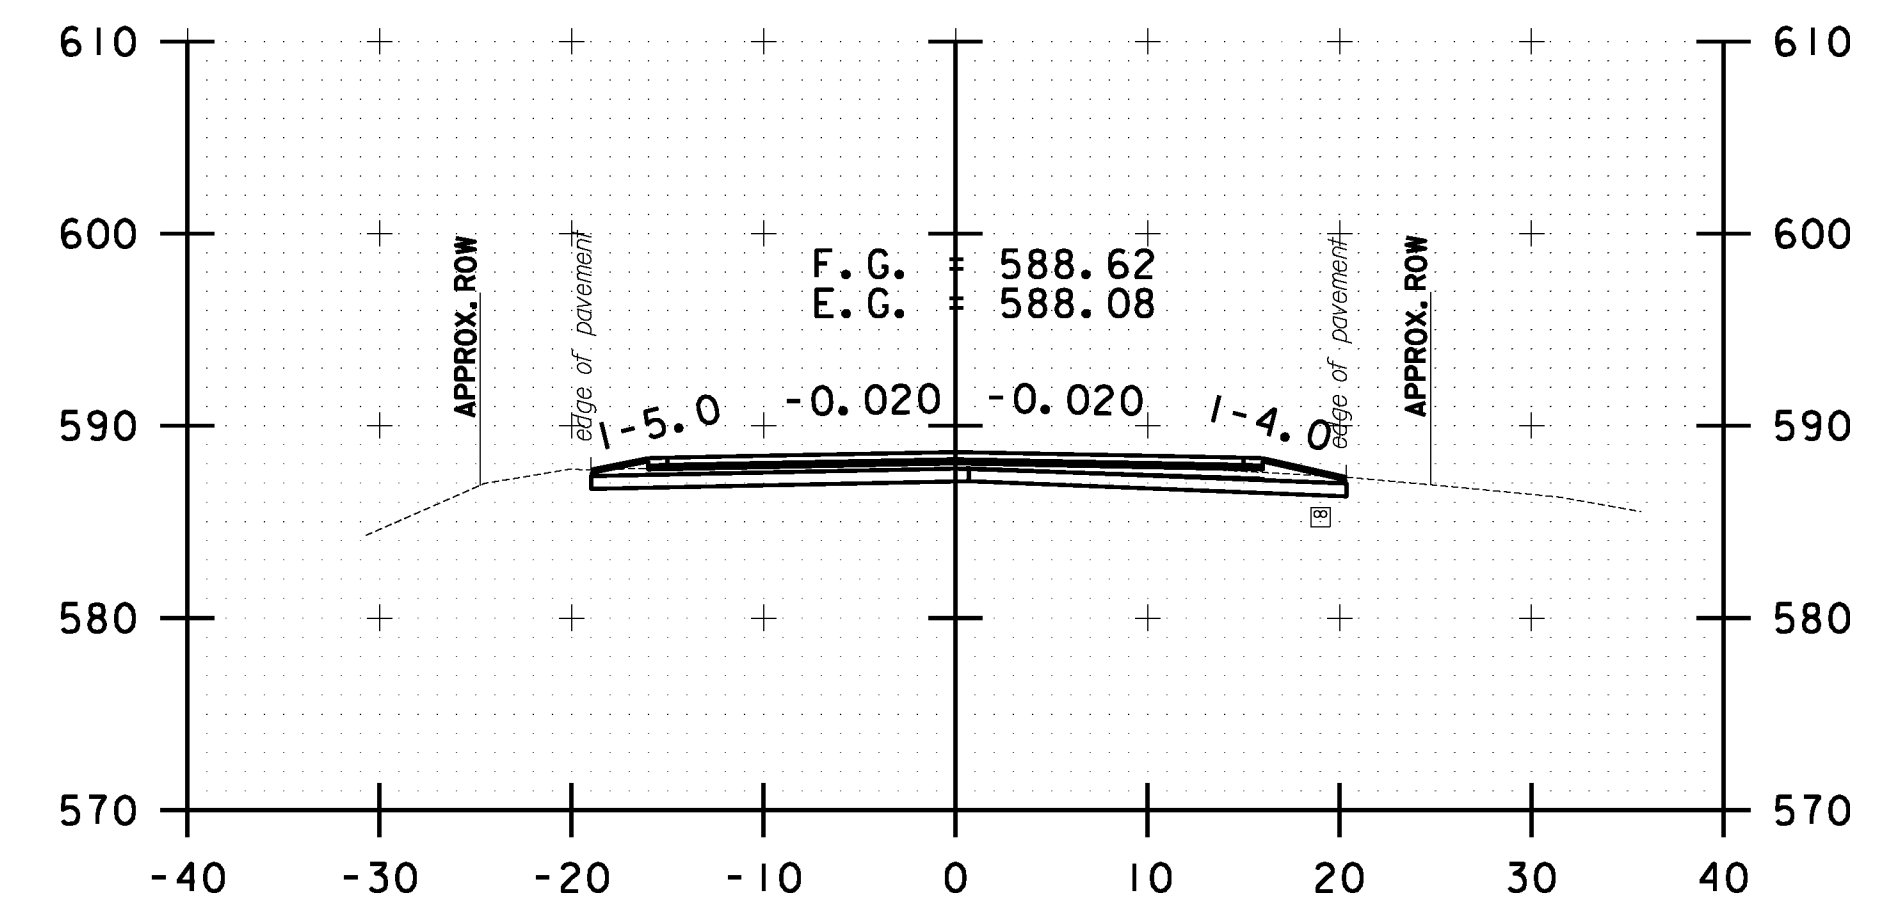

B 80+00.00

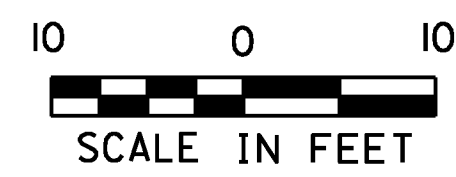

<b>BETHEL CROSS SECTION SHEET #26</b>	PROJECT NAME: STOCKBRIDGE-BETHEL
	PROJECT NUMBER: STP 2910(1)
	FILE NAME: z10b214.bethel.xc.dgn
	IPARM FILE: z10b214xs138.1
	PLOT DATE: 3/17/2014
	DRAWN BY: W.G.P.
	DESIGNED BY: L.M.B.
	CHECKED BY: J.P.S.
	SHEET 351 OF 397