




FILE NAME = Y:\P\c\areas\ANY\K2\22425\CADD\MSTN\10b214.bethel.xc.dgn
 DATE/TIME = 3/17/2014
 USER = 4916

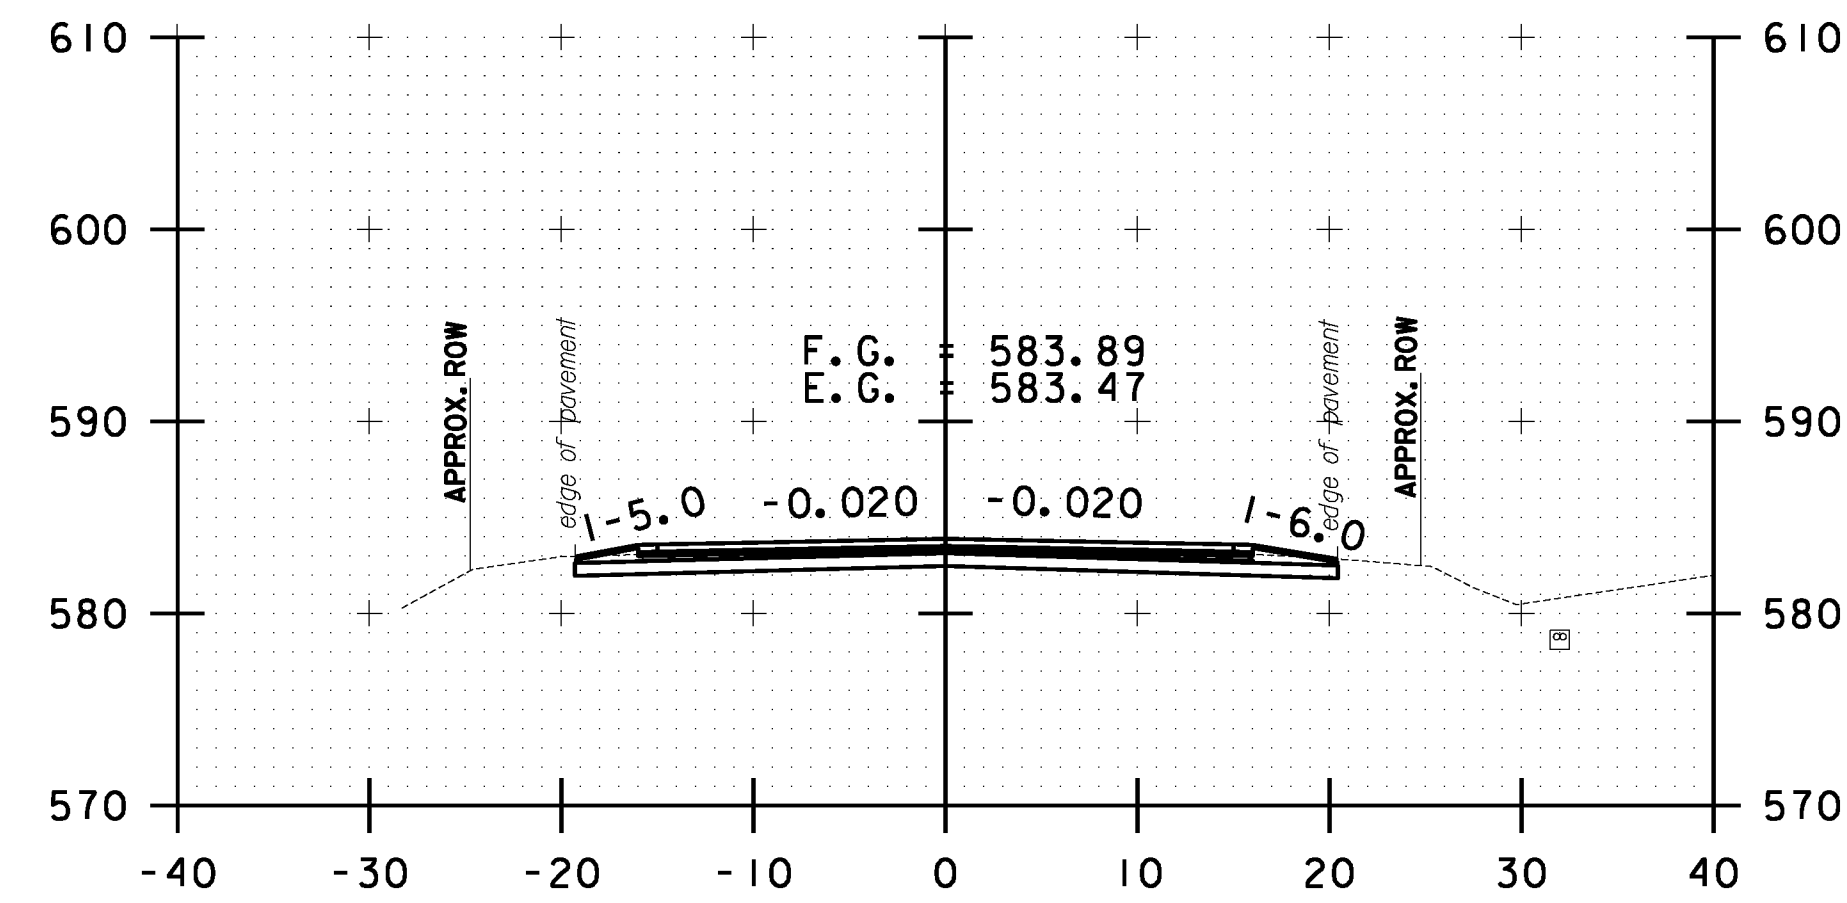


B 82+00.00

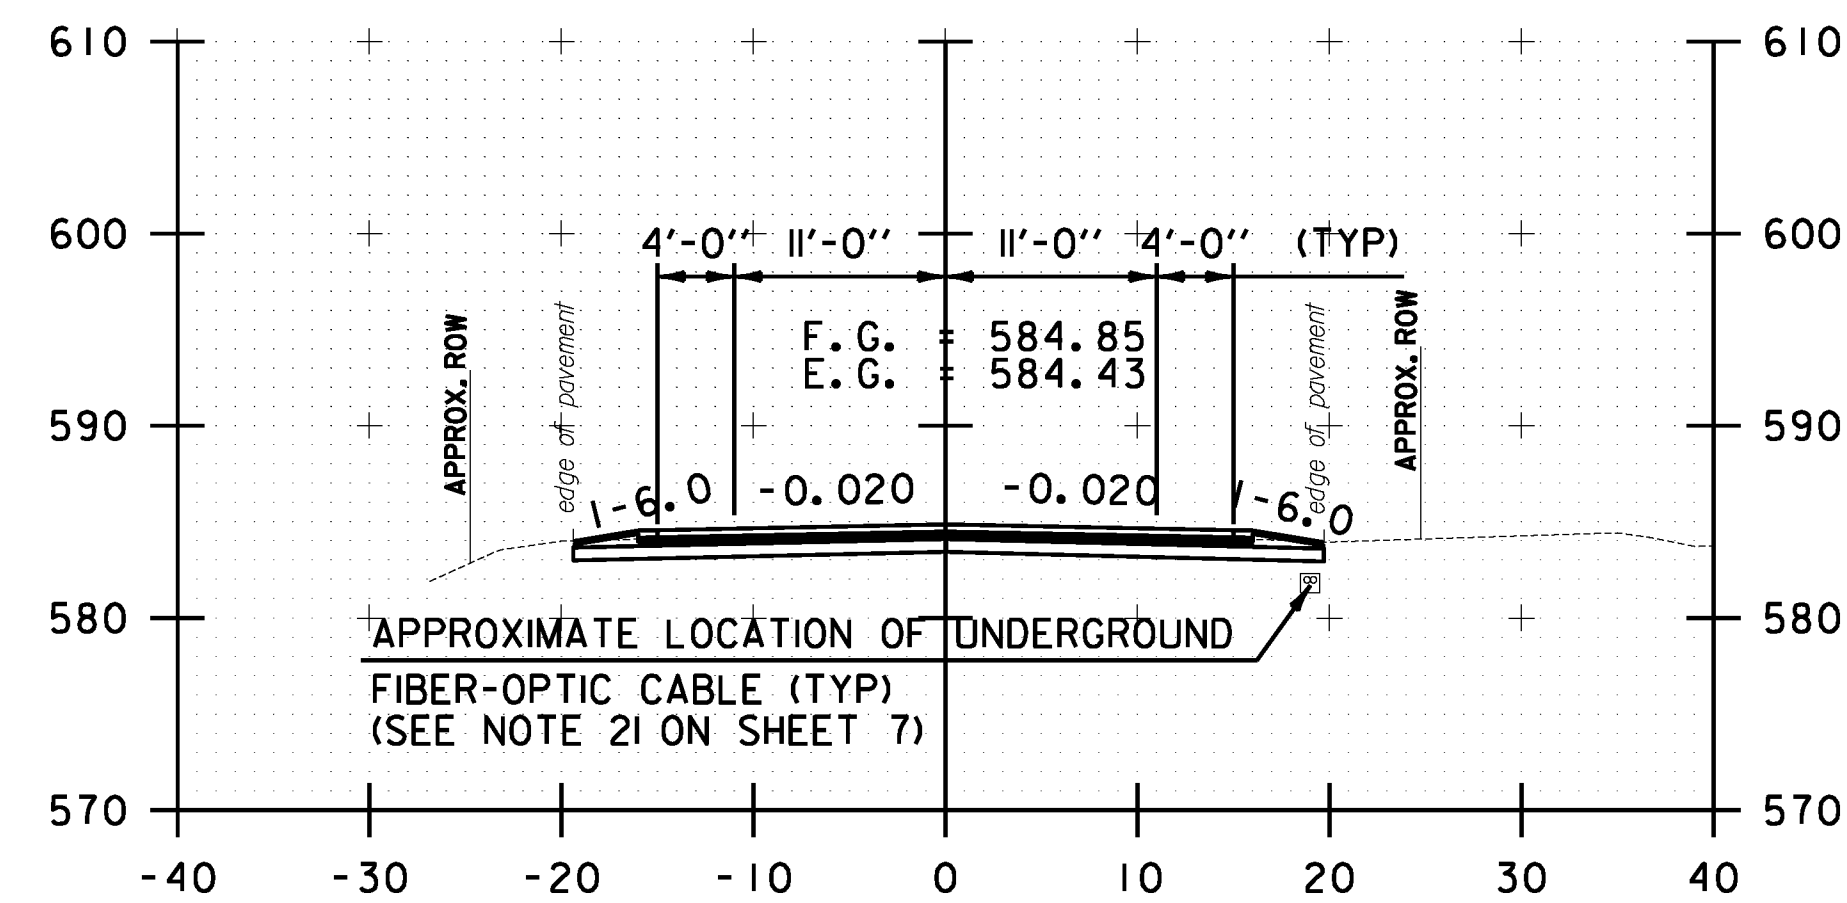


B 81+50.00

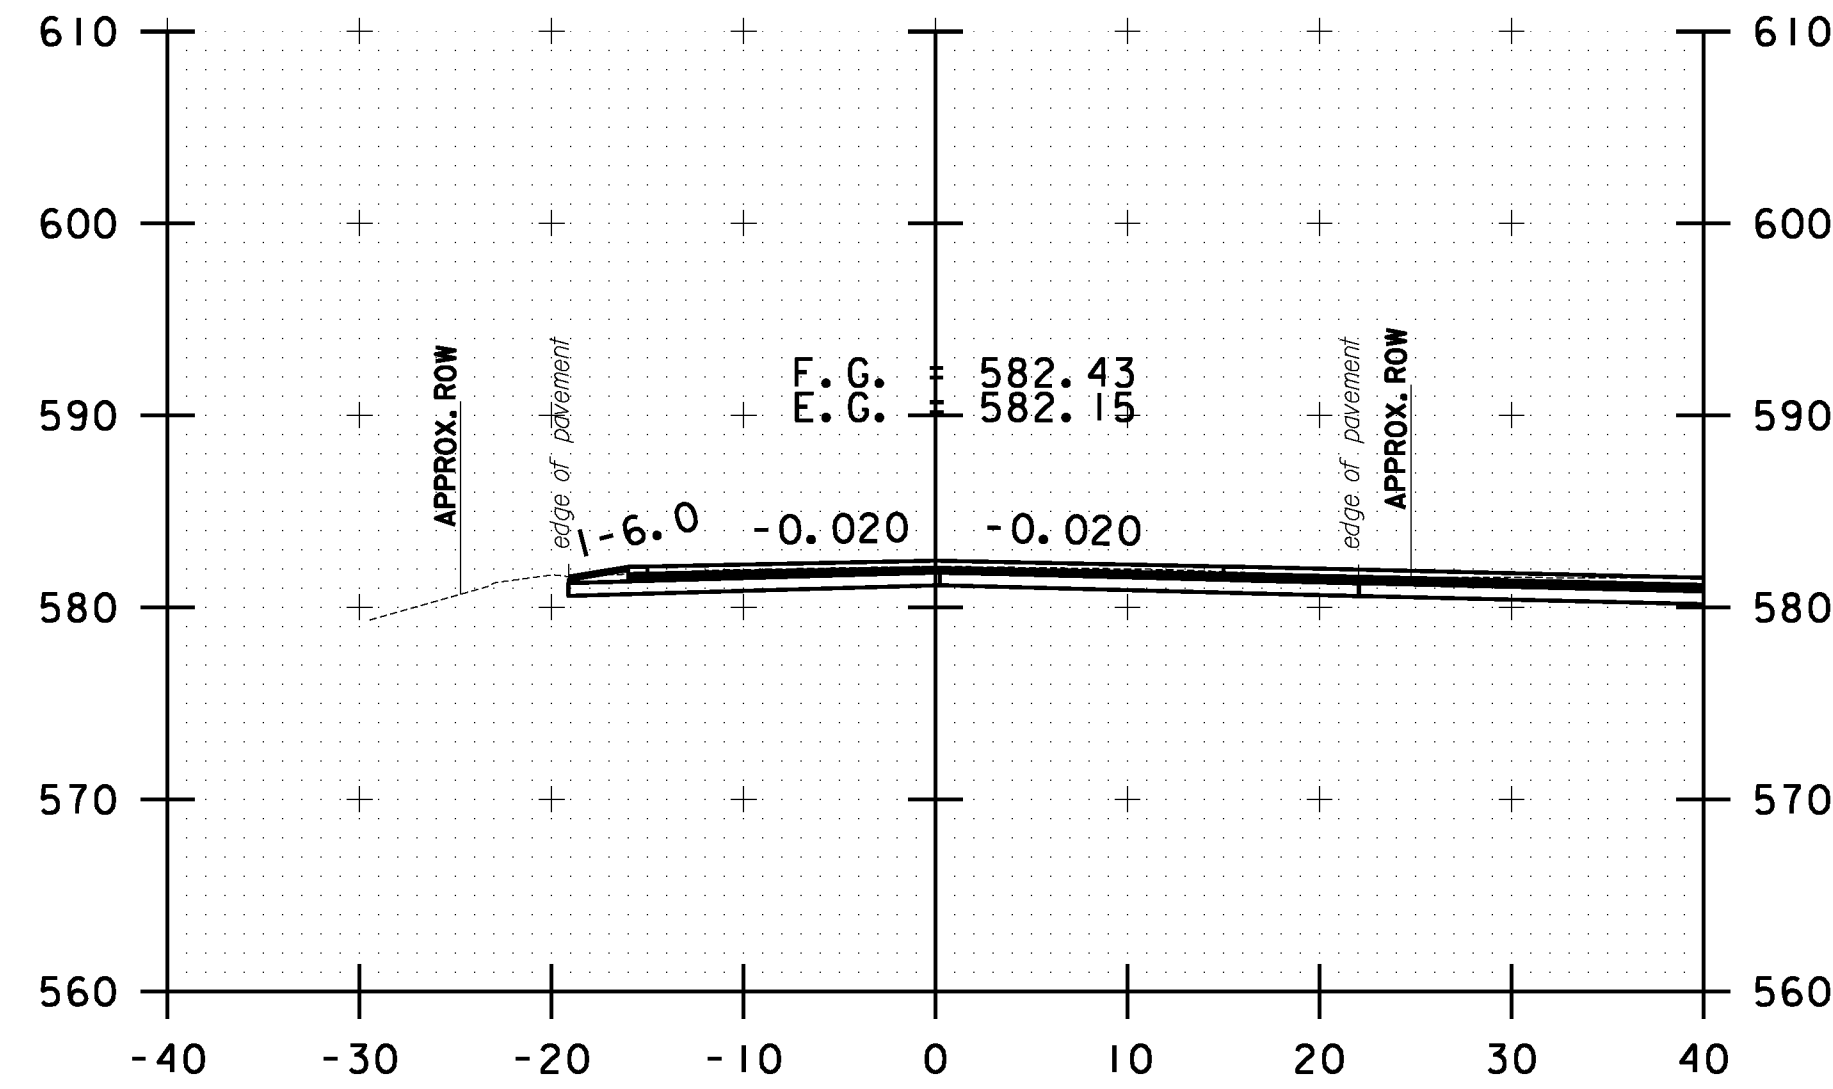


B 83+00.00

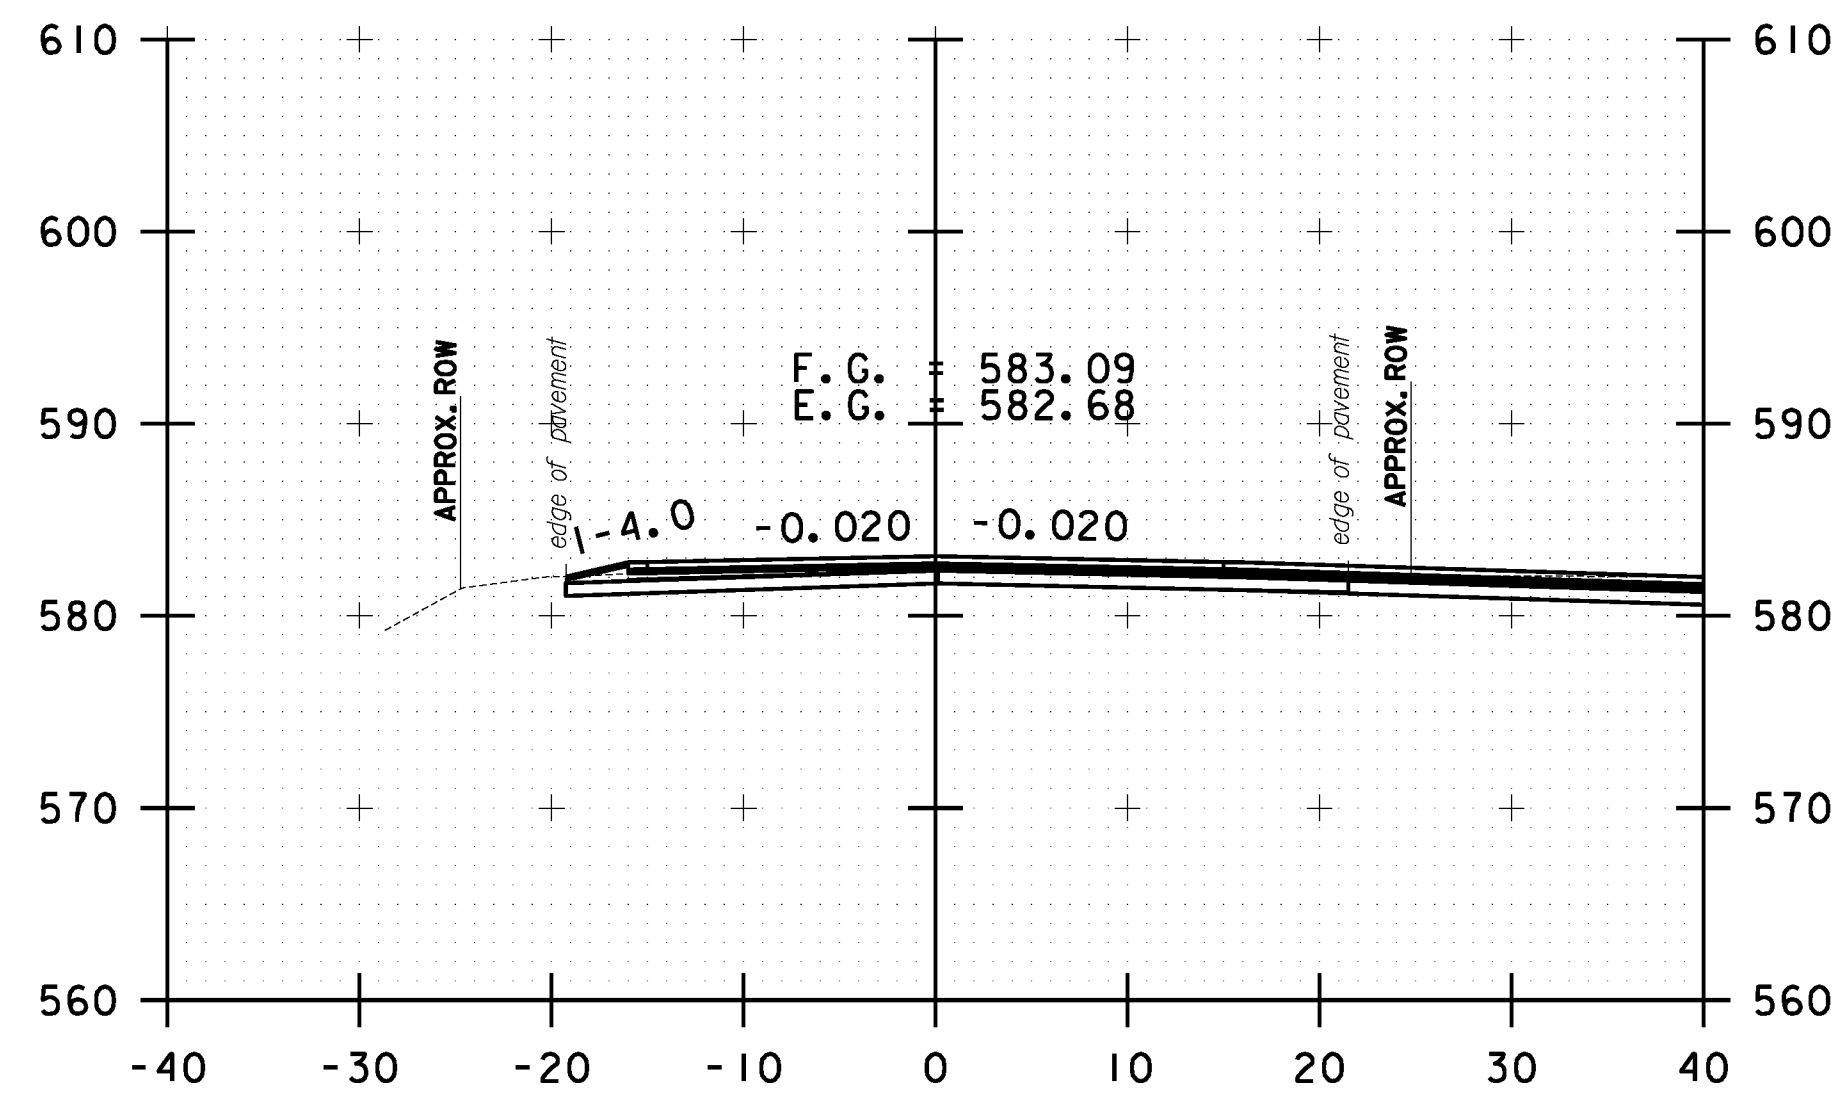

B 82+50.00

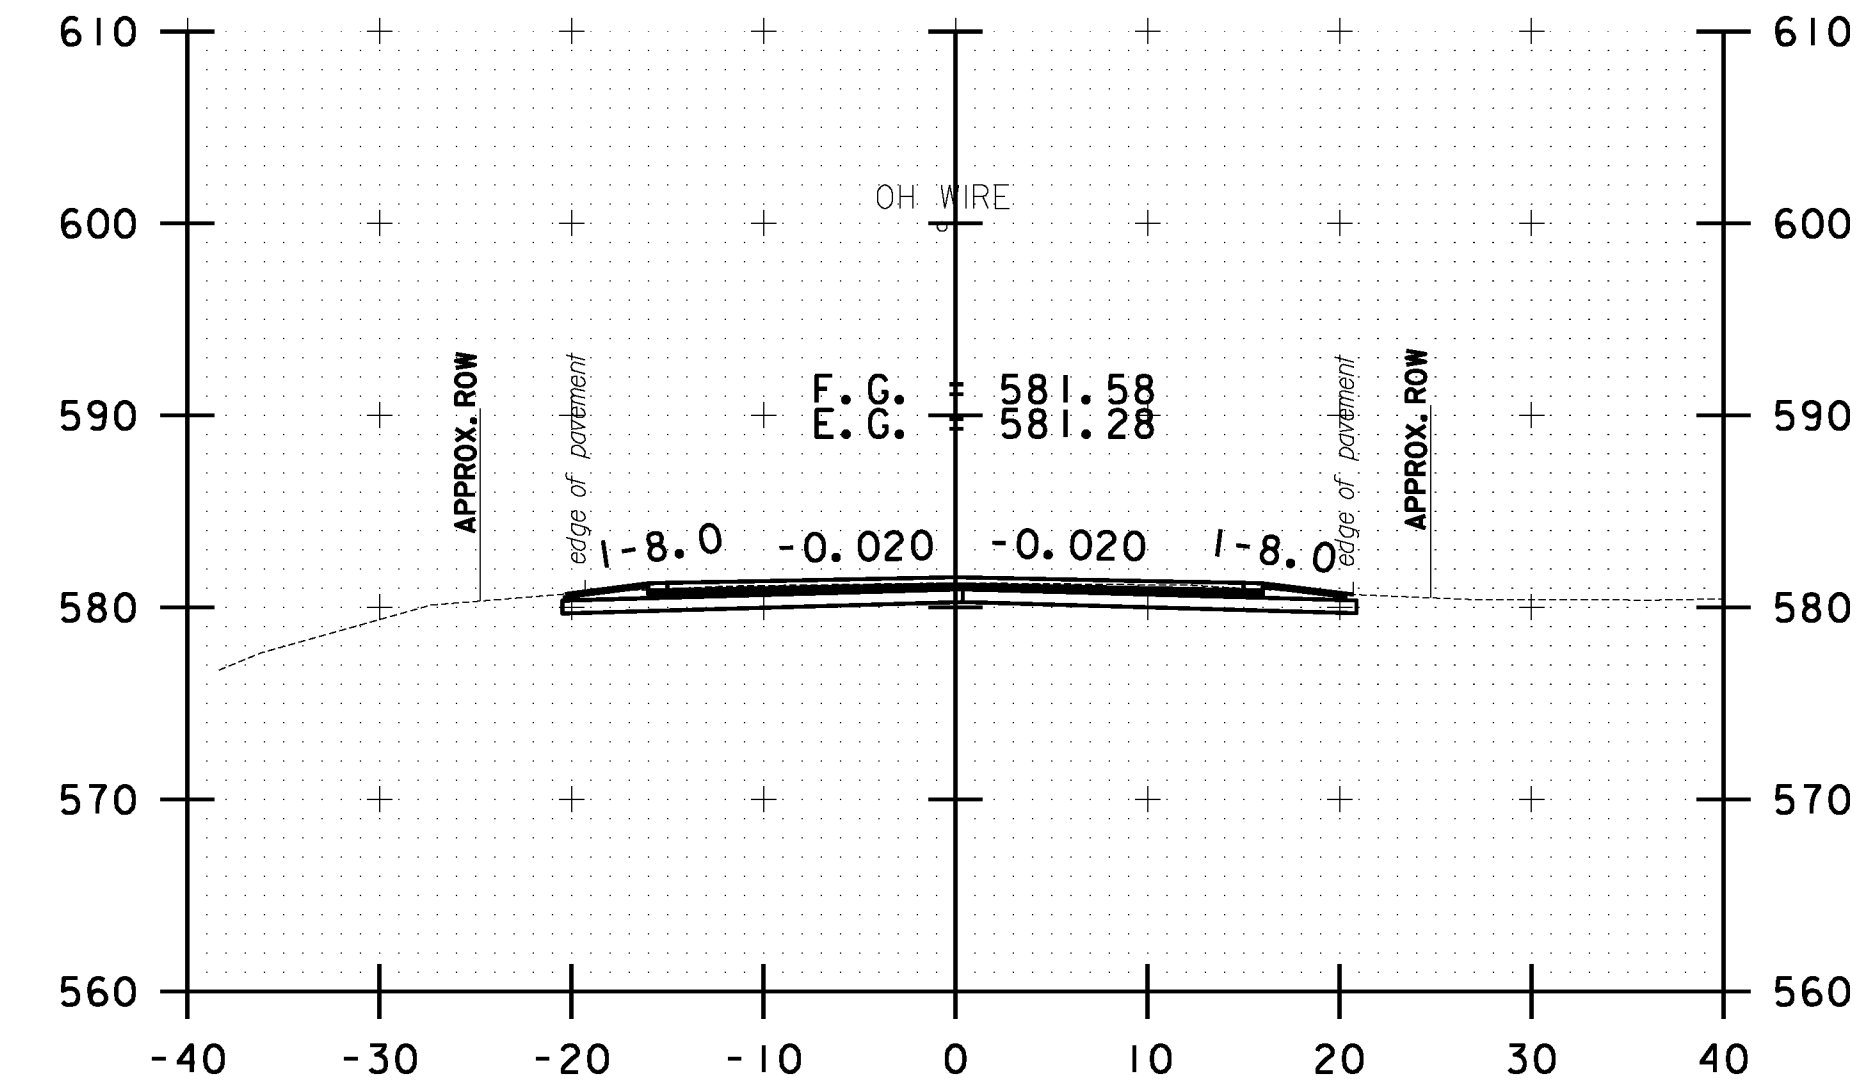

B 84+00.00

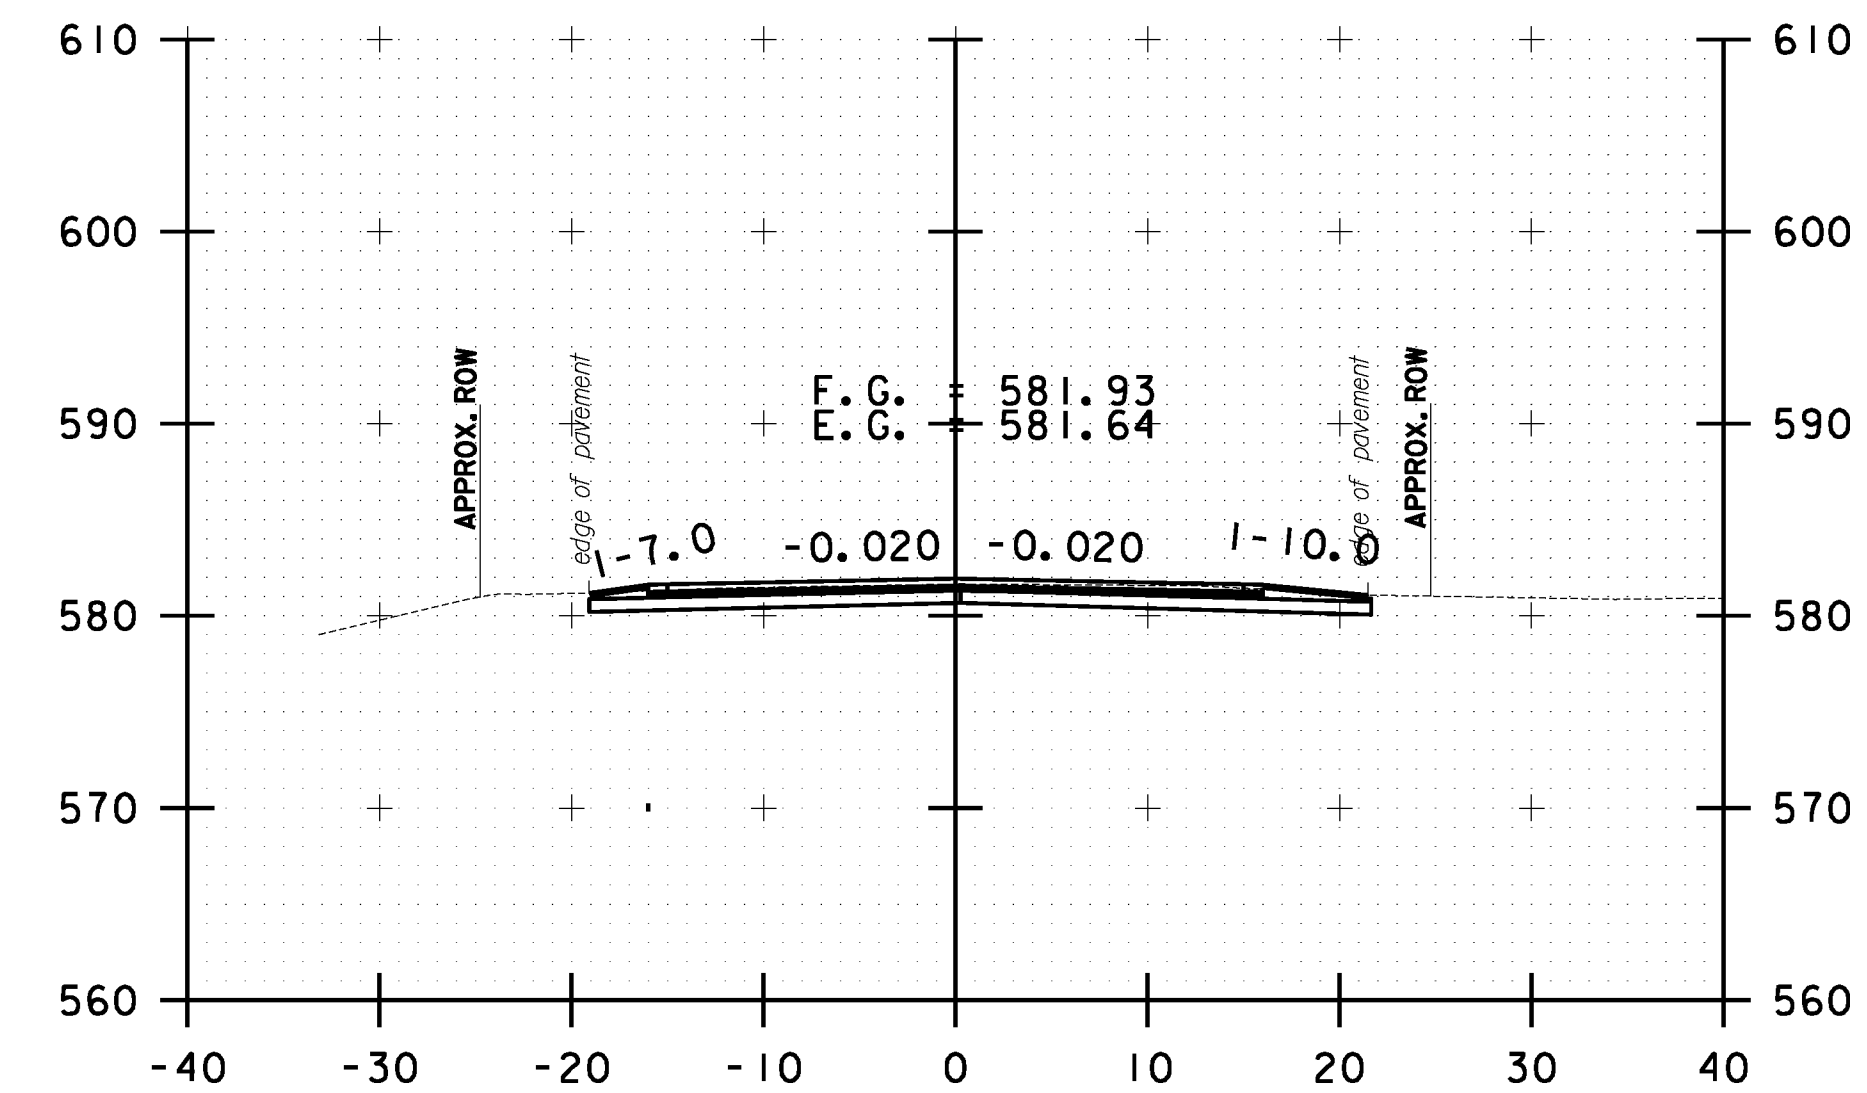

B 83+50.00



BETHEL CROSS SECTION SHEET #27	PROJECT NAME: STOCKBRIDGE-BETHEL
	PROJECT NUMBER: STP 2910(1)
	FILE NAME: z10b214.bethel.xc.dgn
DESIGNED BY: L.M.B.	PLOT DATE: 3/17/2014
IPARM FILE: z10b214.xs139.i	DRAWN BY: W.G.P.
	CHECKED BY: J.P.S.
	SHEET 352 OF 397