




FILE NAME = Y:\P\c\g\ss\any\k2\22425\CA001\MSTN10b214.bethel.xc.dgn  
 DATE/TIME = 3/17/2014  
 USER = 4916

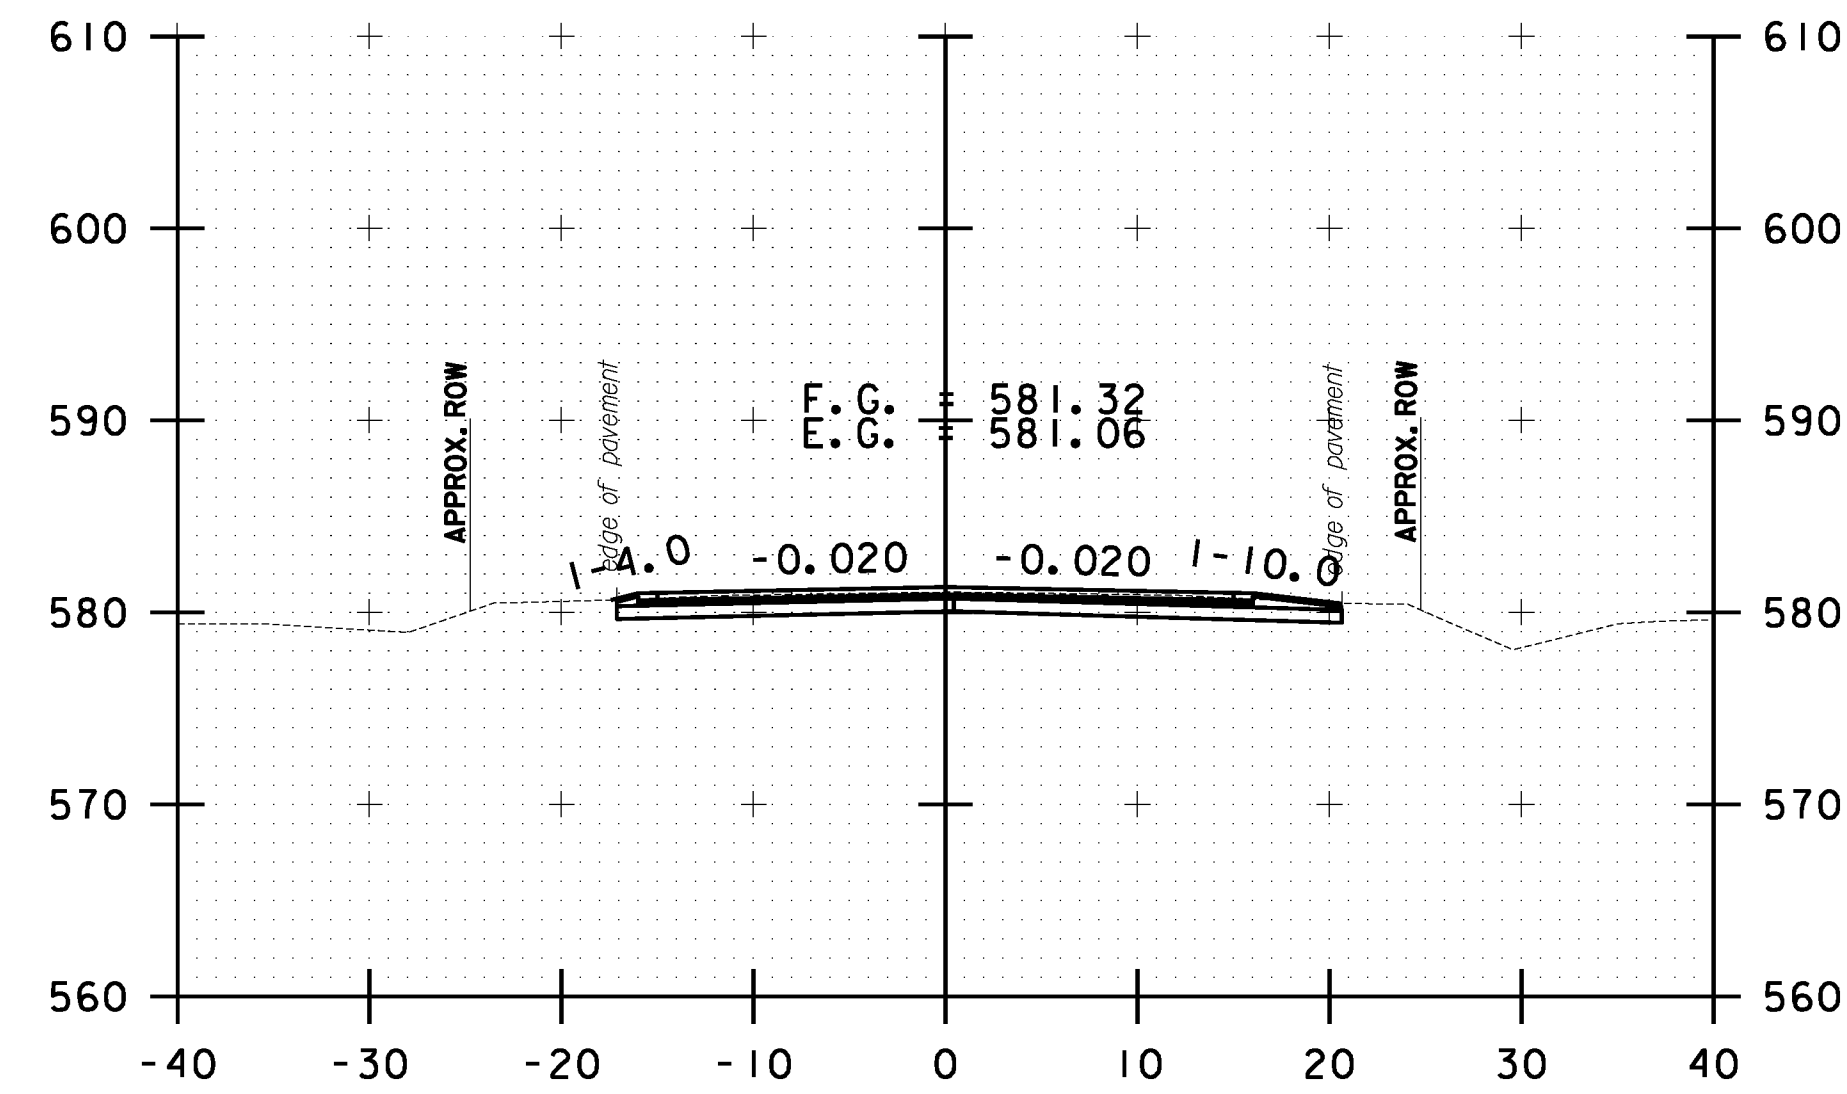


B 85+00.00

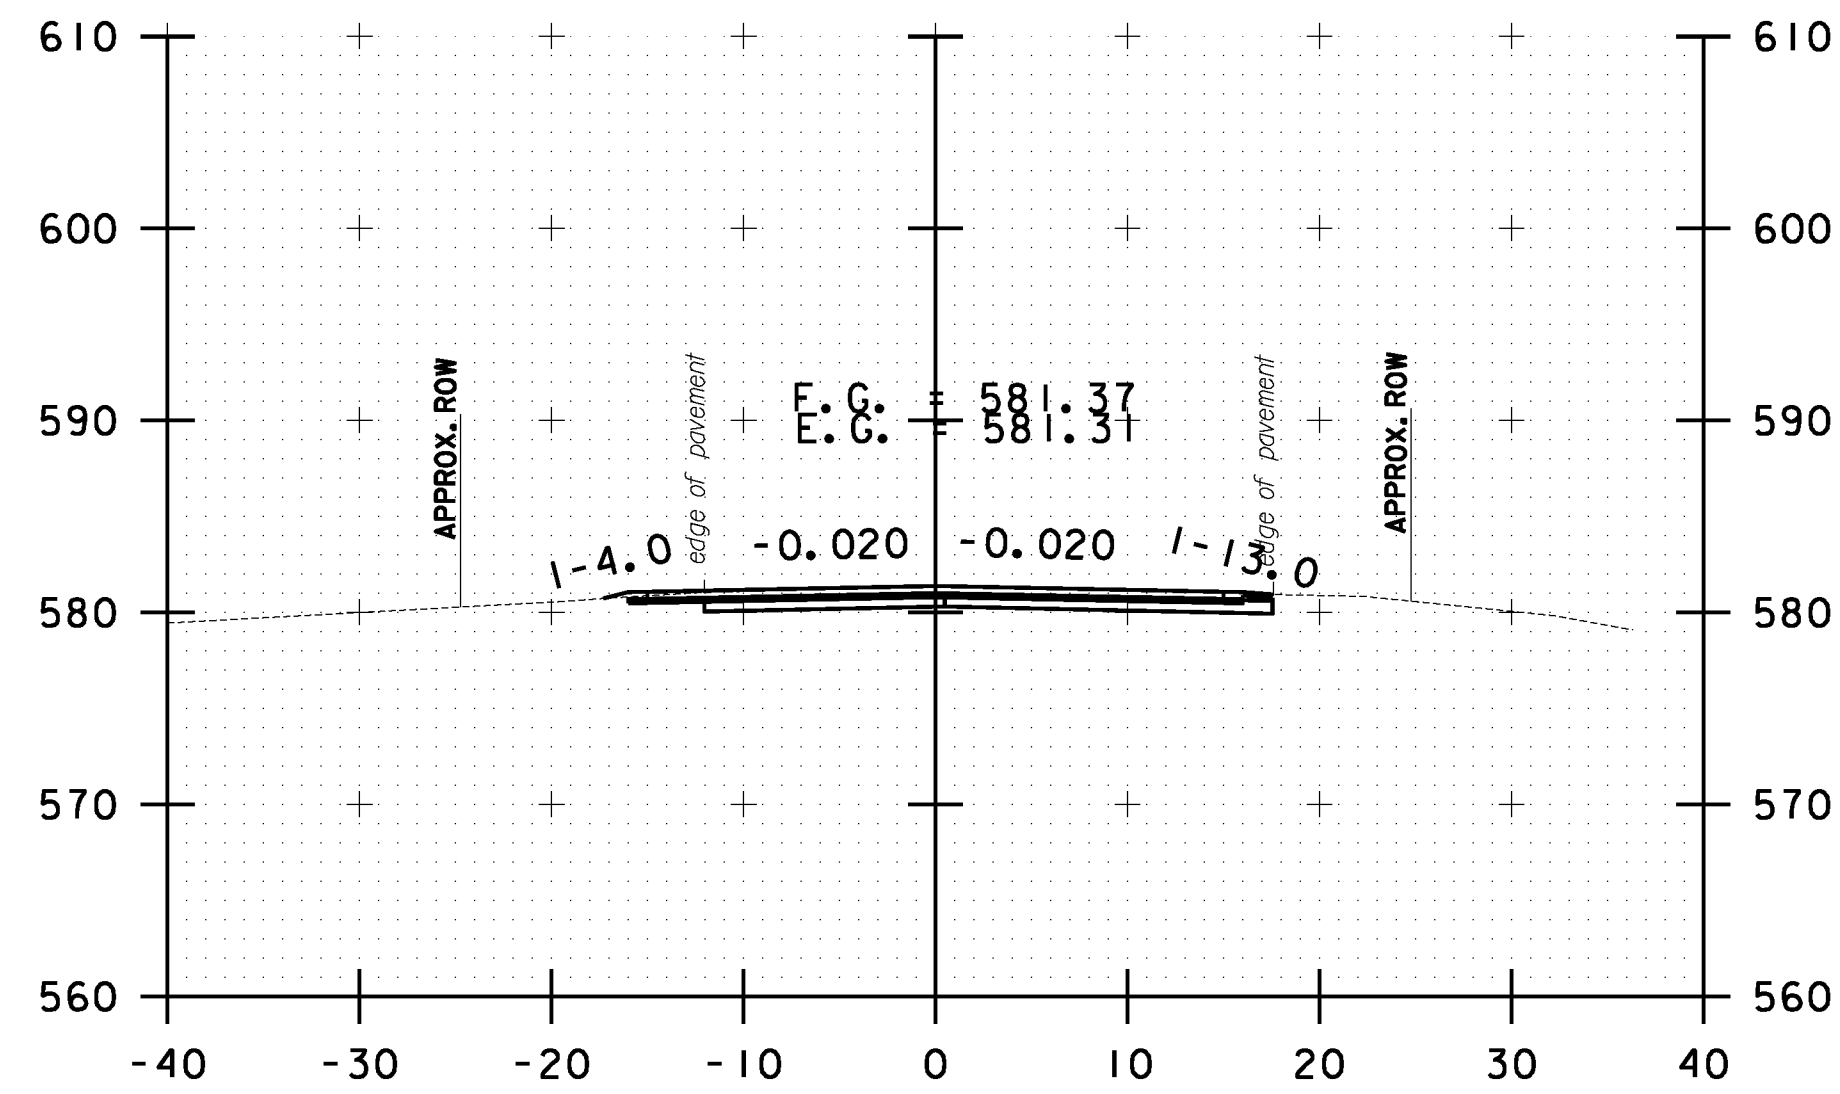


B 86+00.00

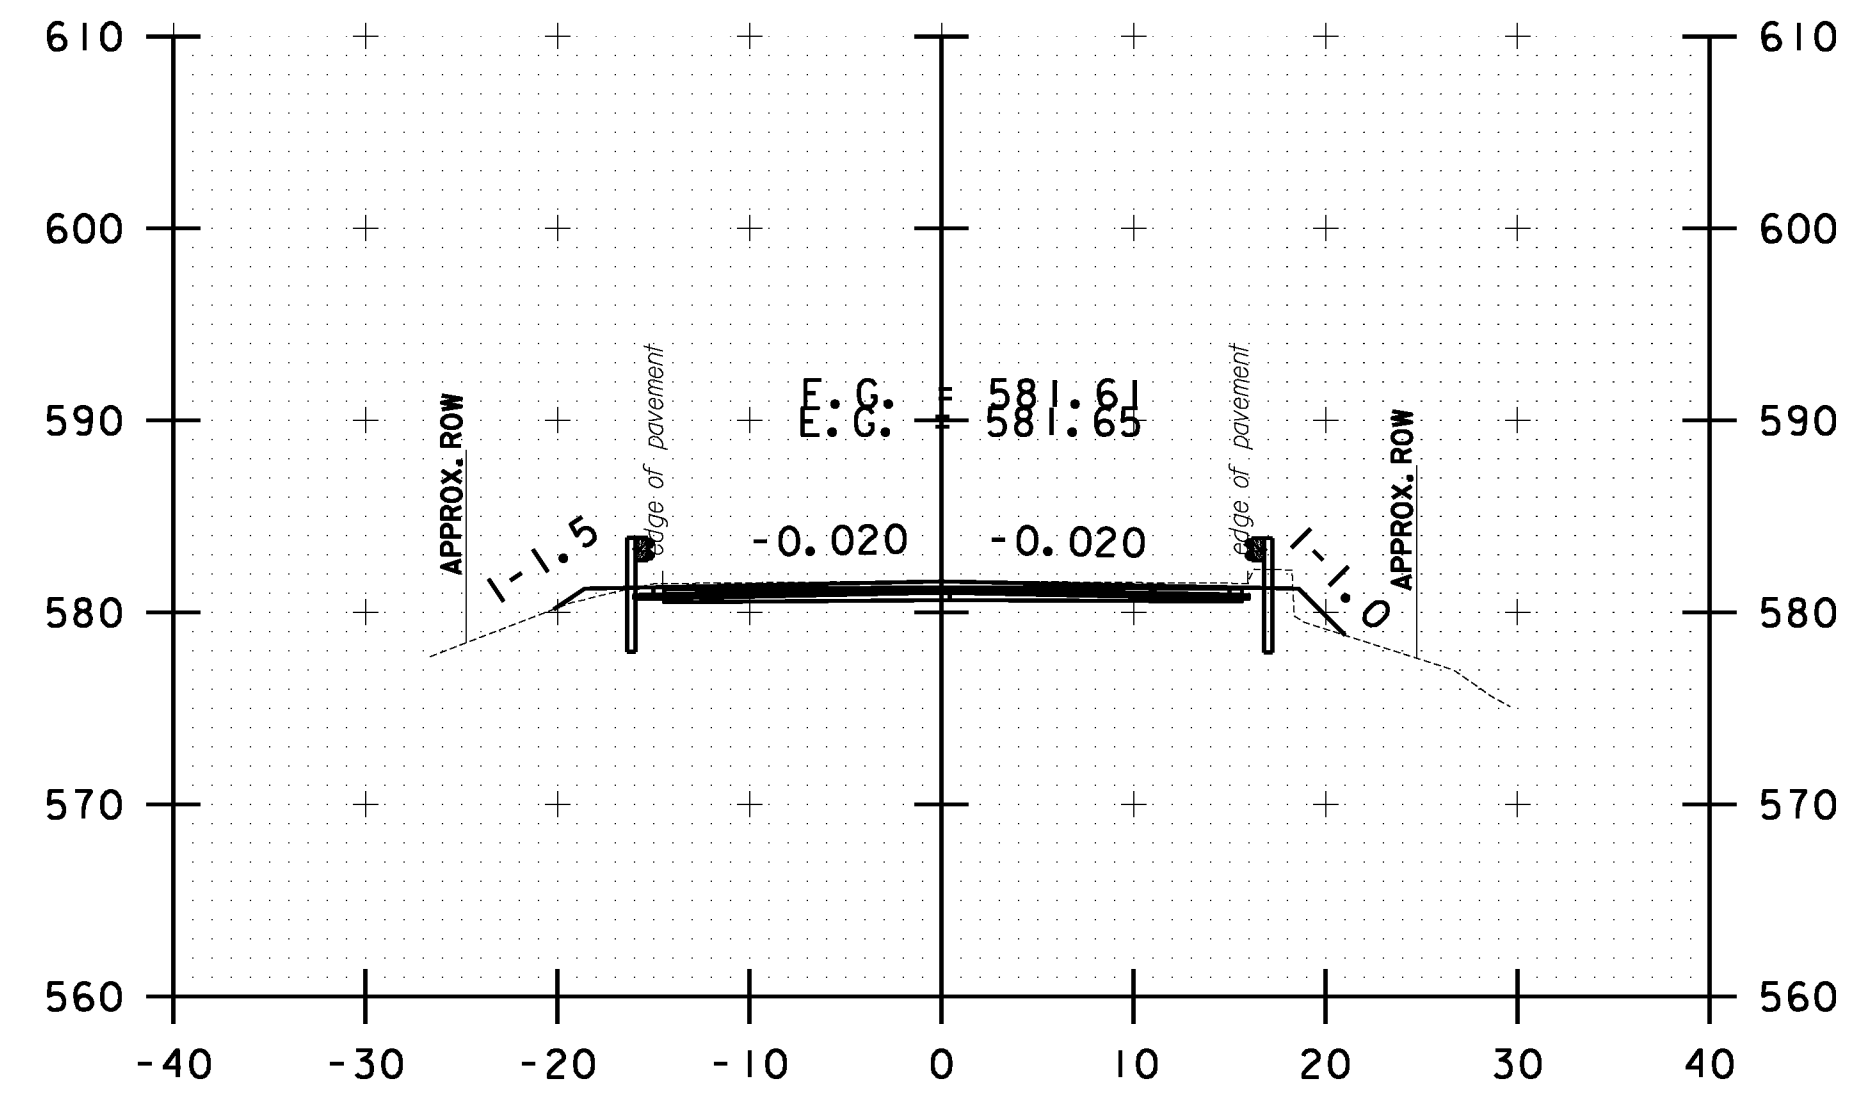


B 87+00.00

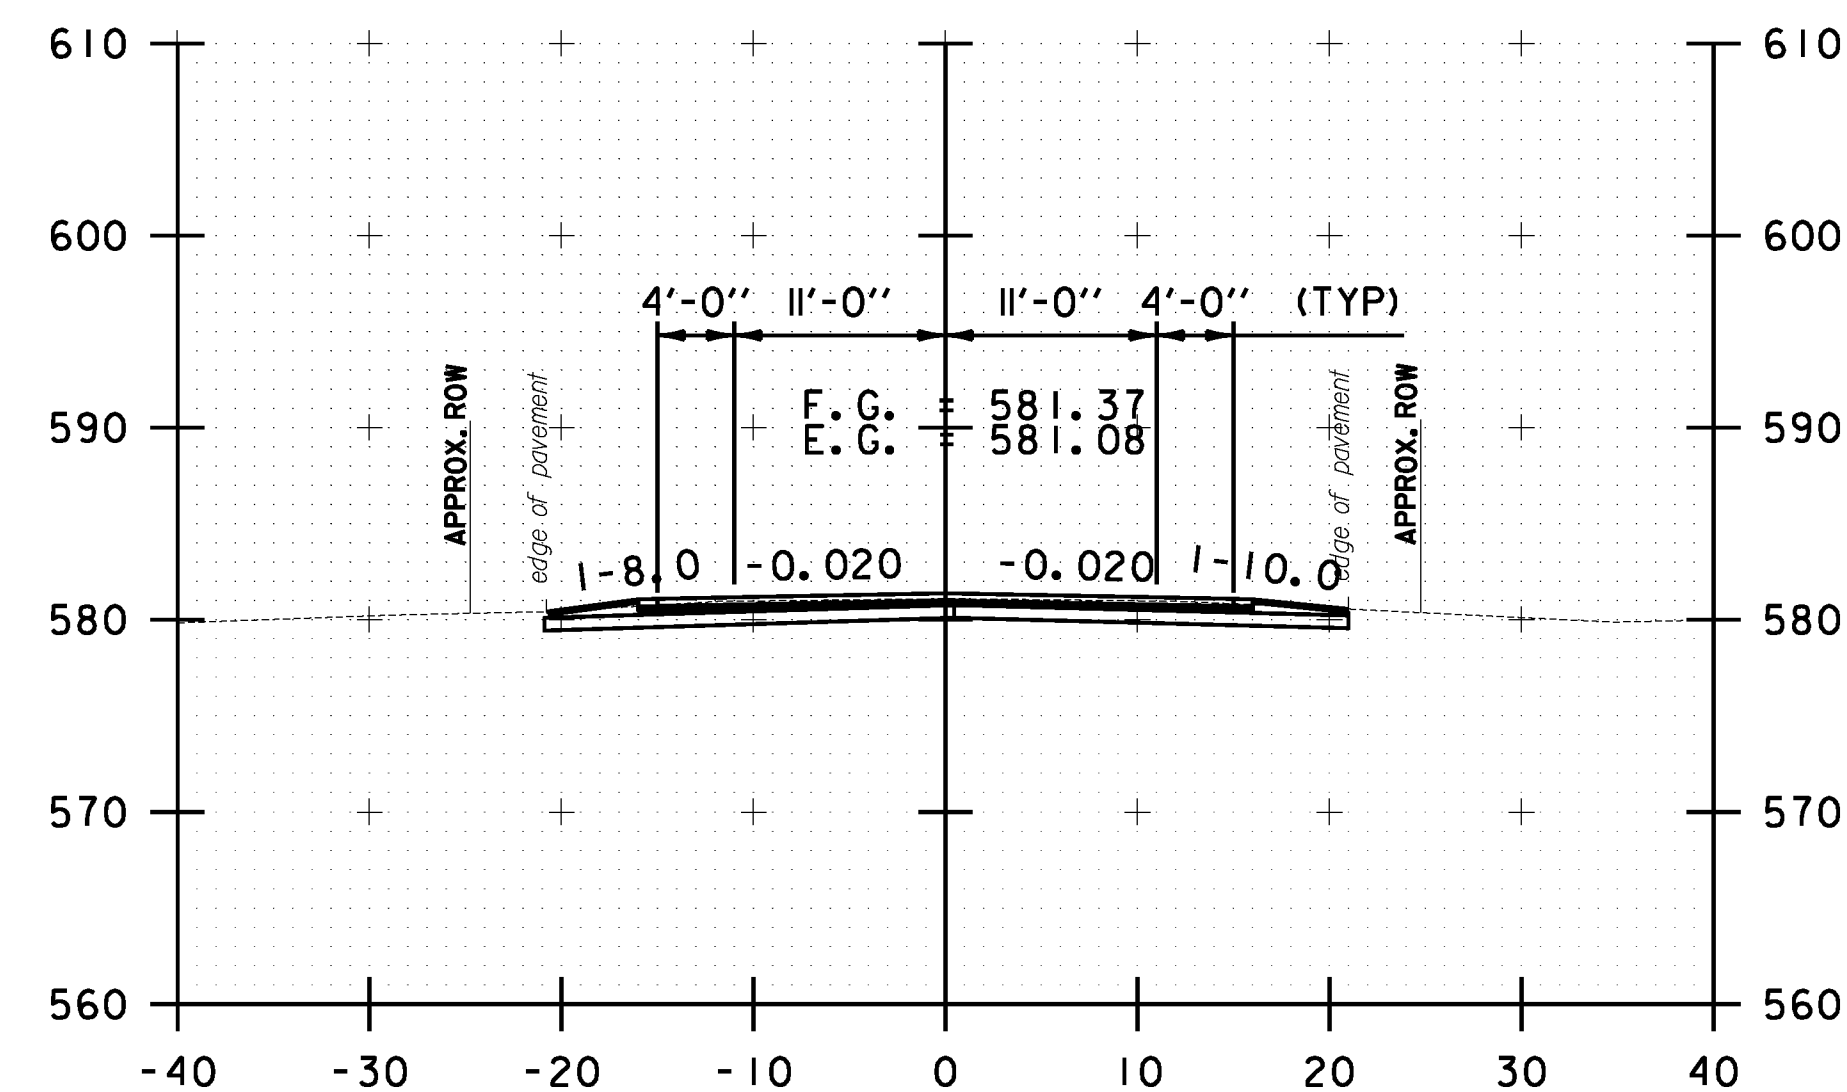

B 84+50.00

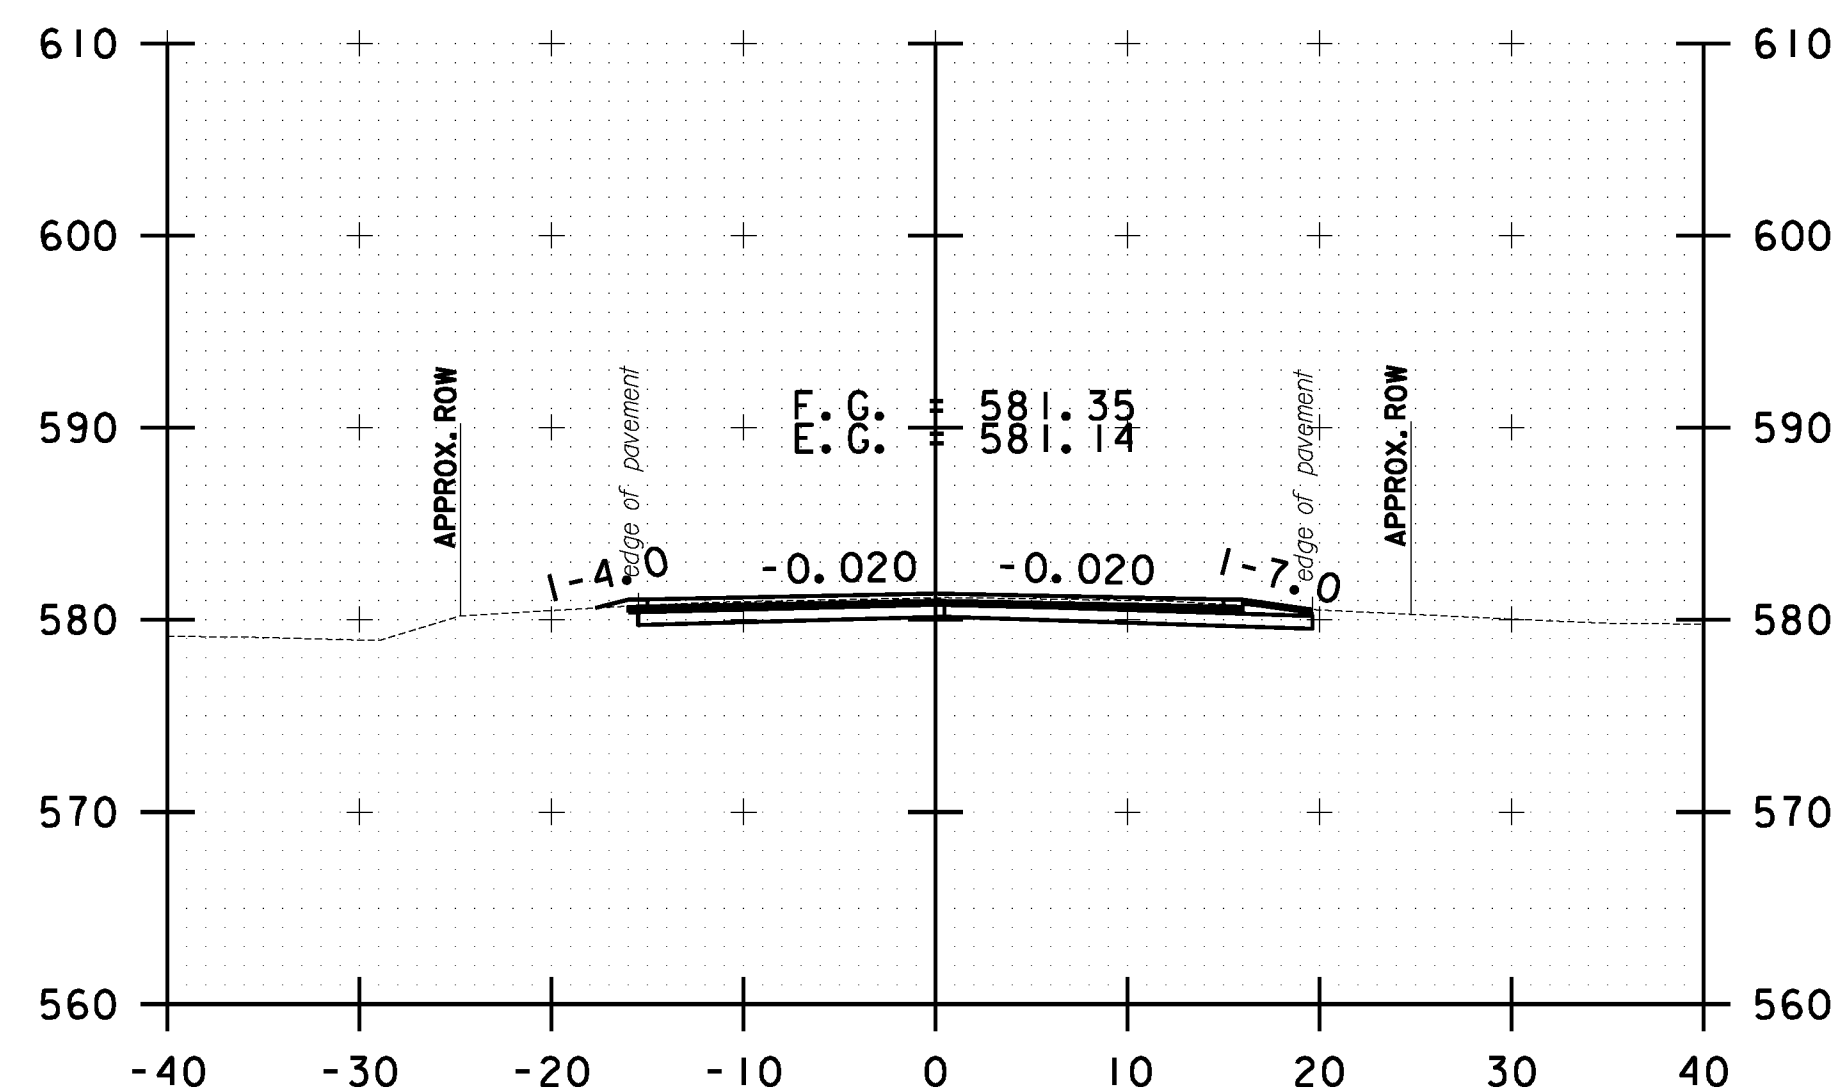

B 85+50.00

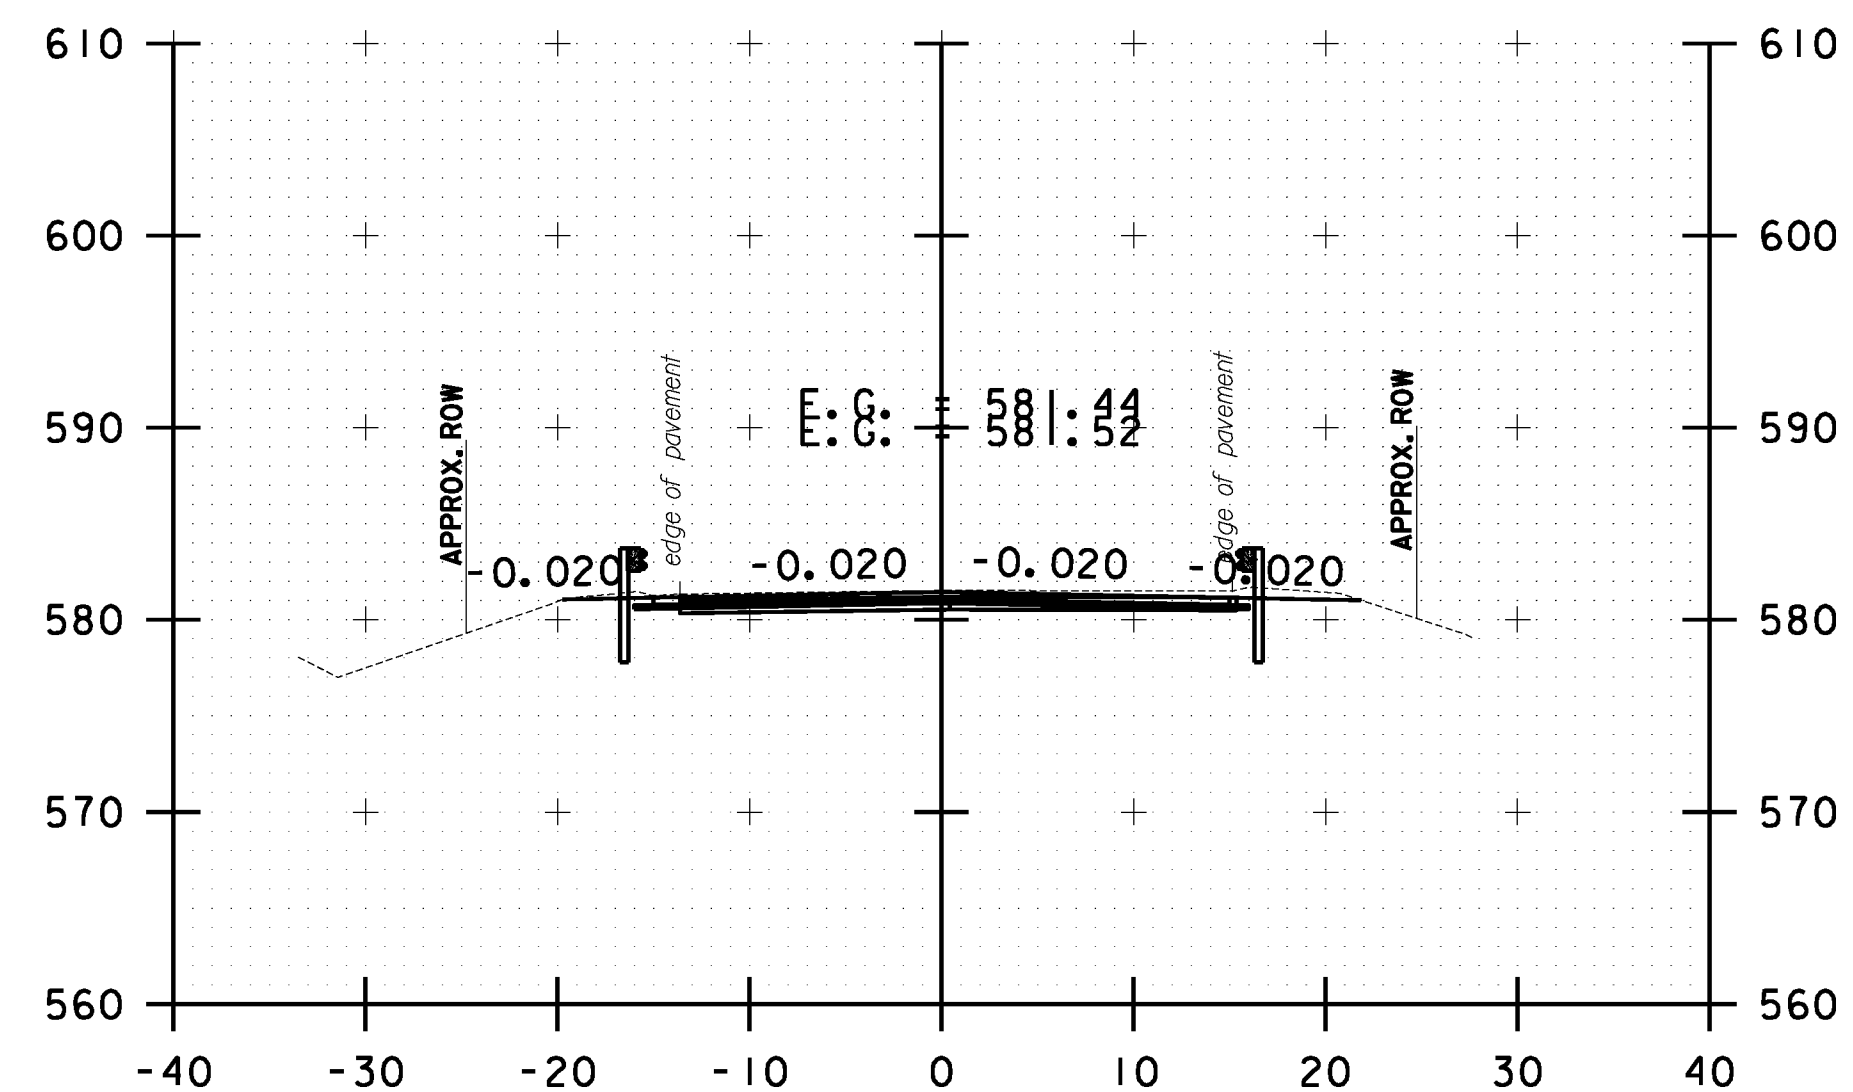

B 86+50.00



<b>BETHEL CROSS SECTION SHEET #28</b>	PROJECT NAME: STOCKBRIDGE-BETHEL
	PROJECT NUMBER: STP 2910(1)
	FILE NAME: z10b214.bethel.xc.dgn
DESIGNED BY: L.M.B.	PLOT DATE: 3/17/2014
IPARM FILE: z10b214xsl40.1	DRAWN BY: W.C.P.
	CHECKED BY: J.P.S.
	SHEET 353 OF 397