




FILE NAME = Y:\P\c\res\any\k2\22425\CA001\MSTN\10b214_bethel_xc.dgn
 DATE/TIME = 3/17/2014
 USER = 4916

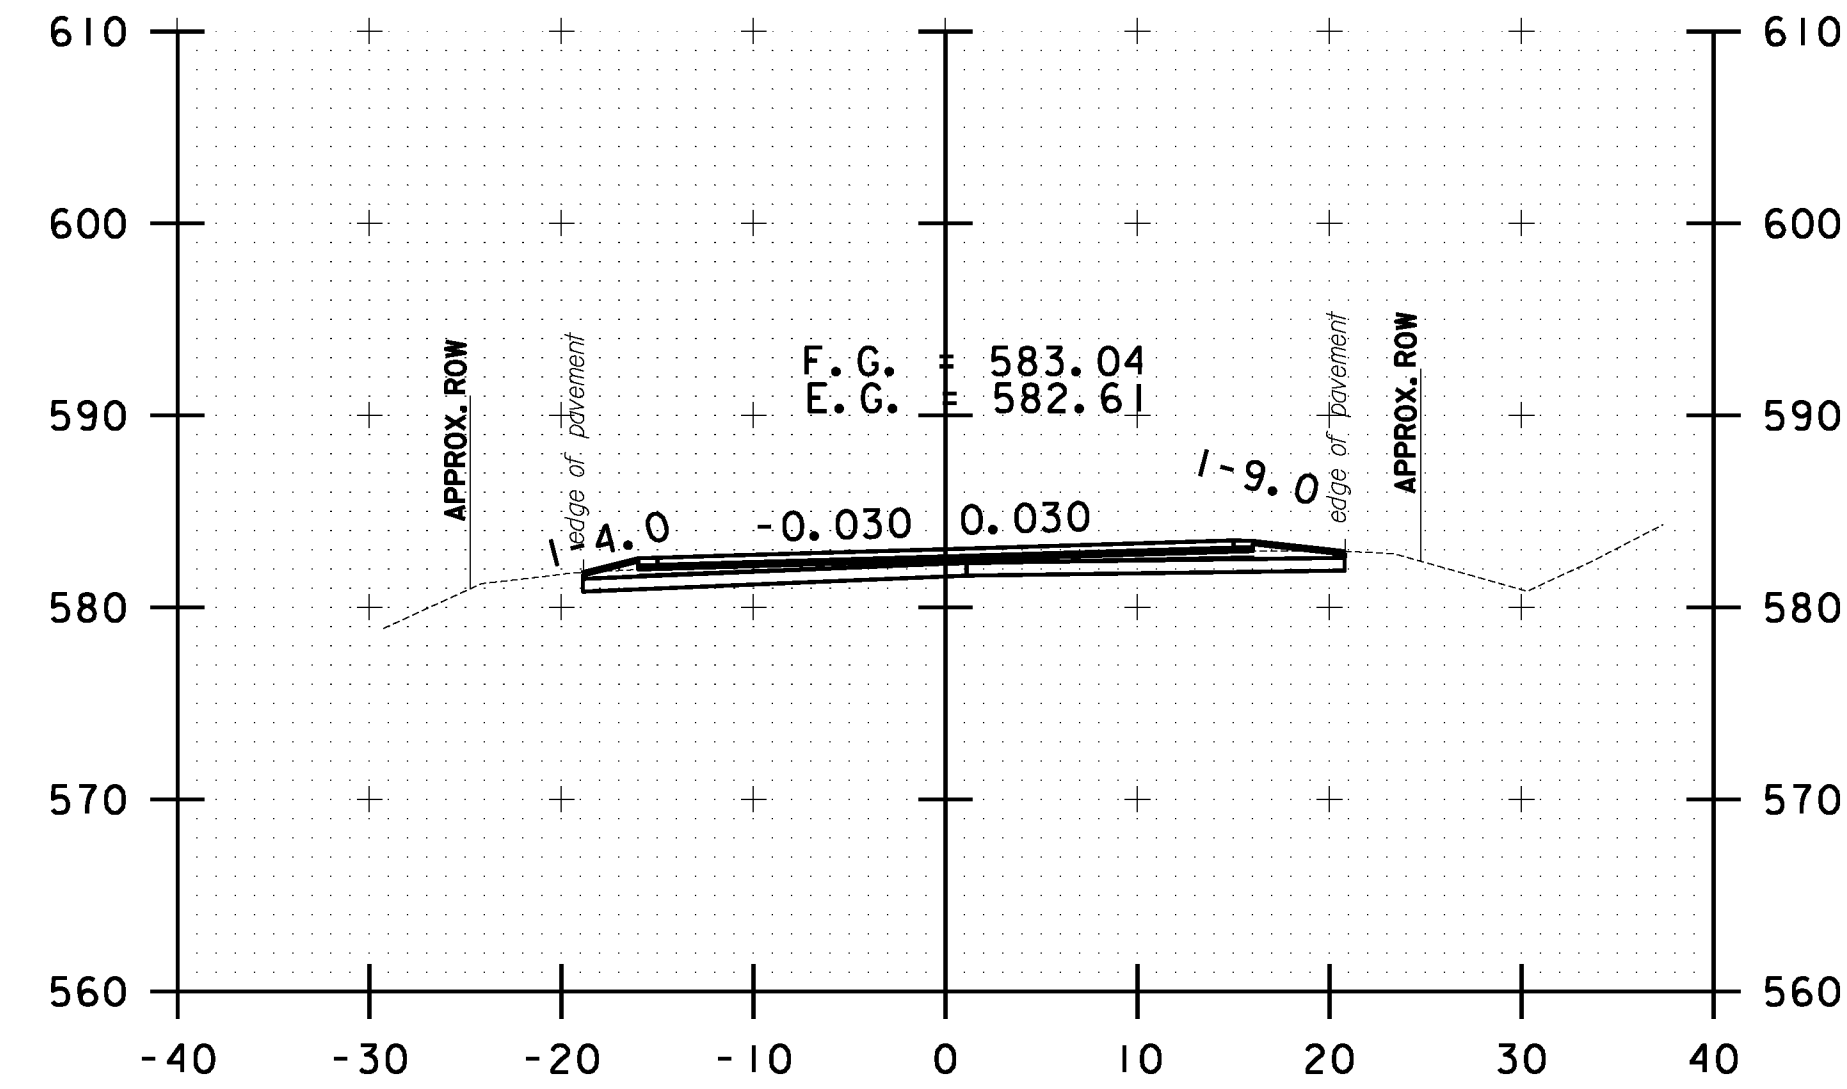


B 94+50.00

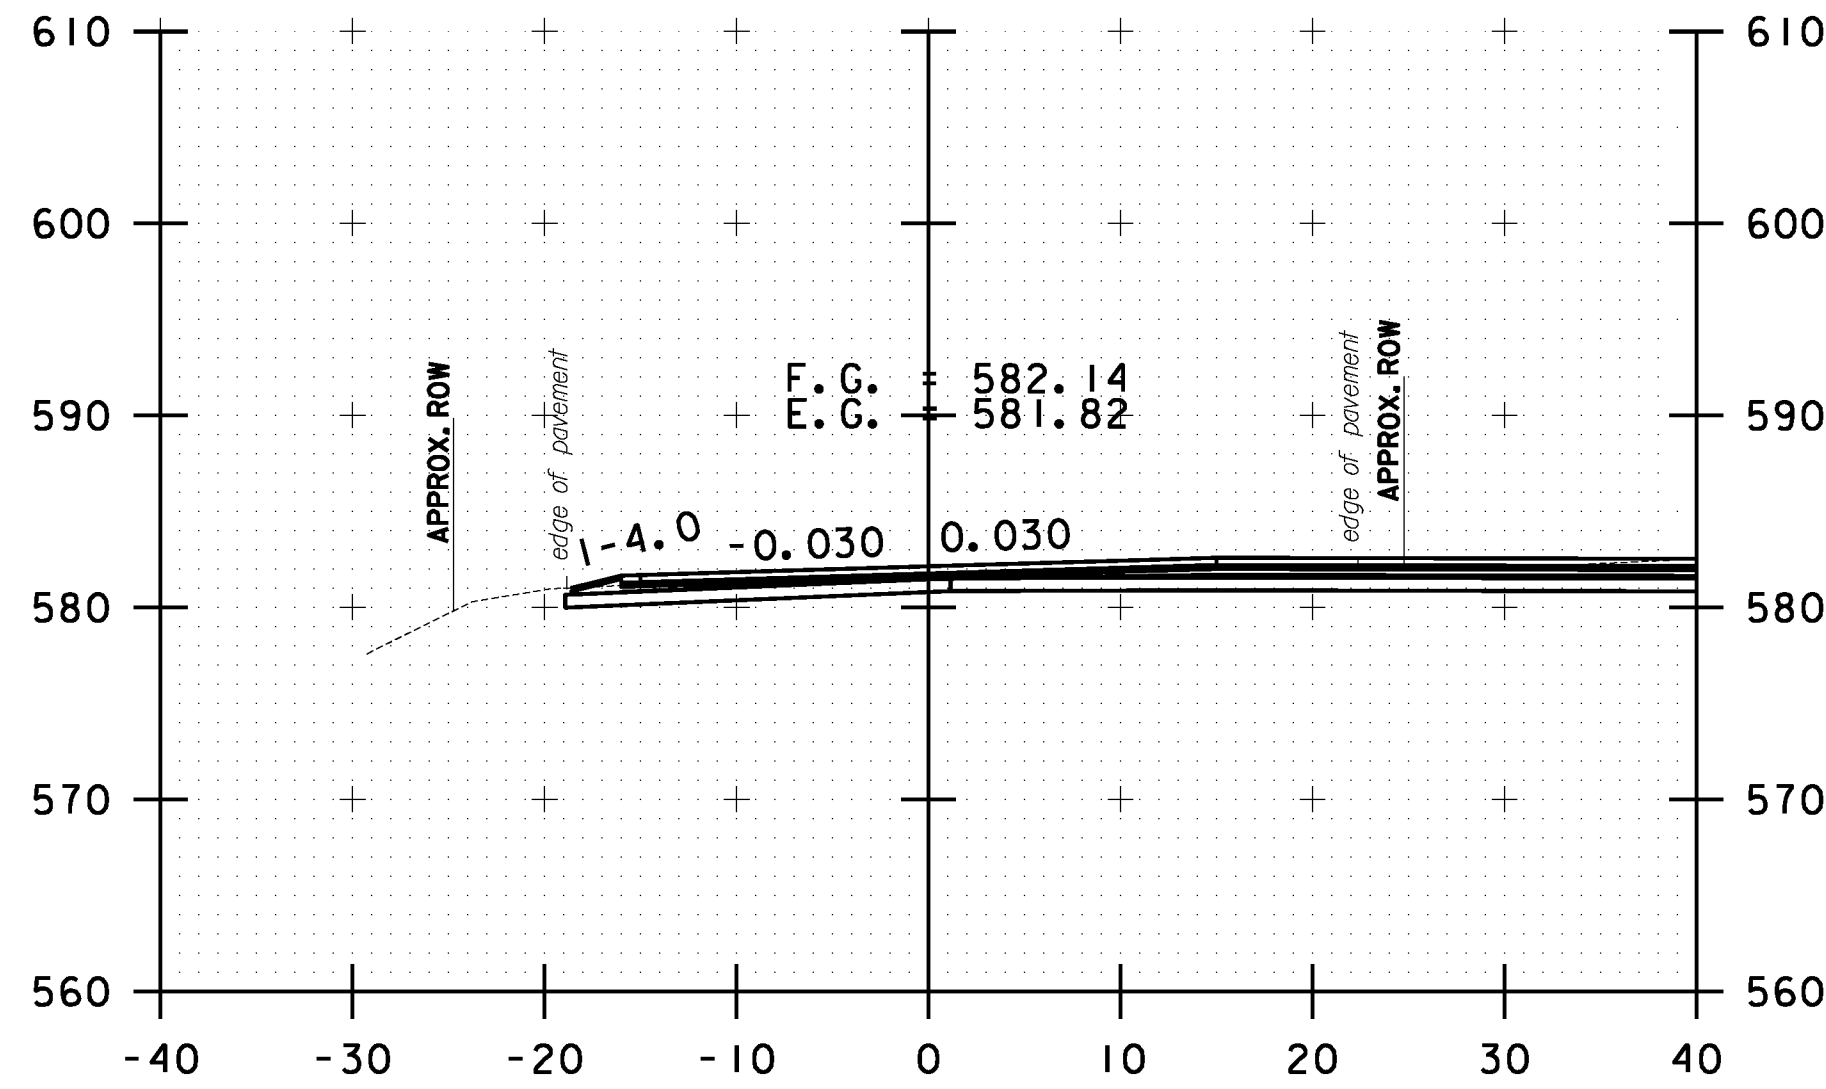


B 95+50.00

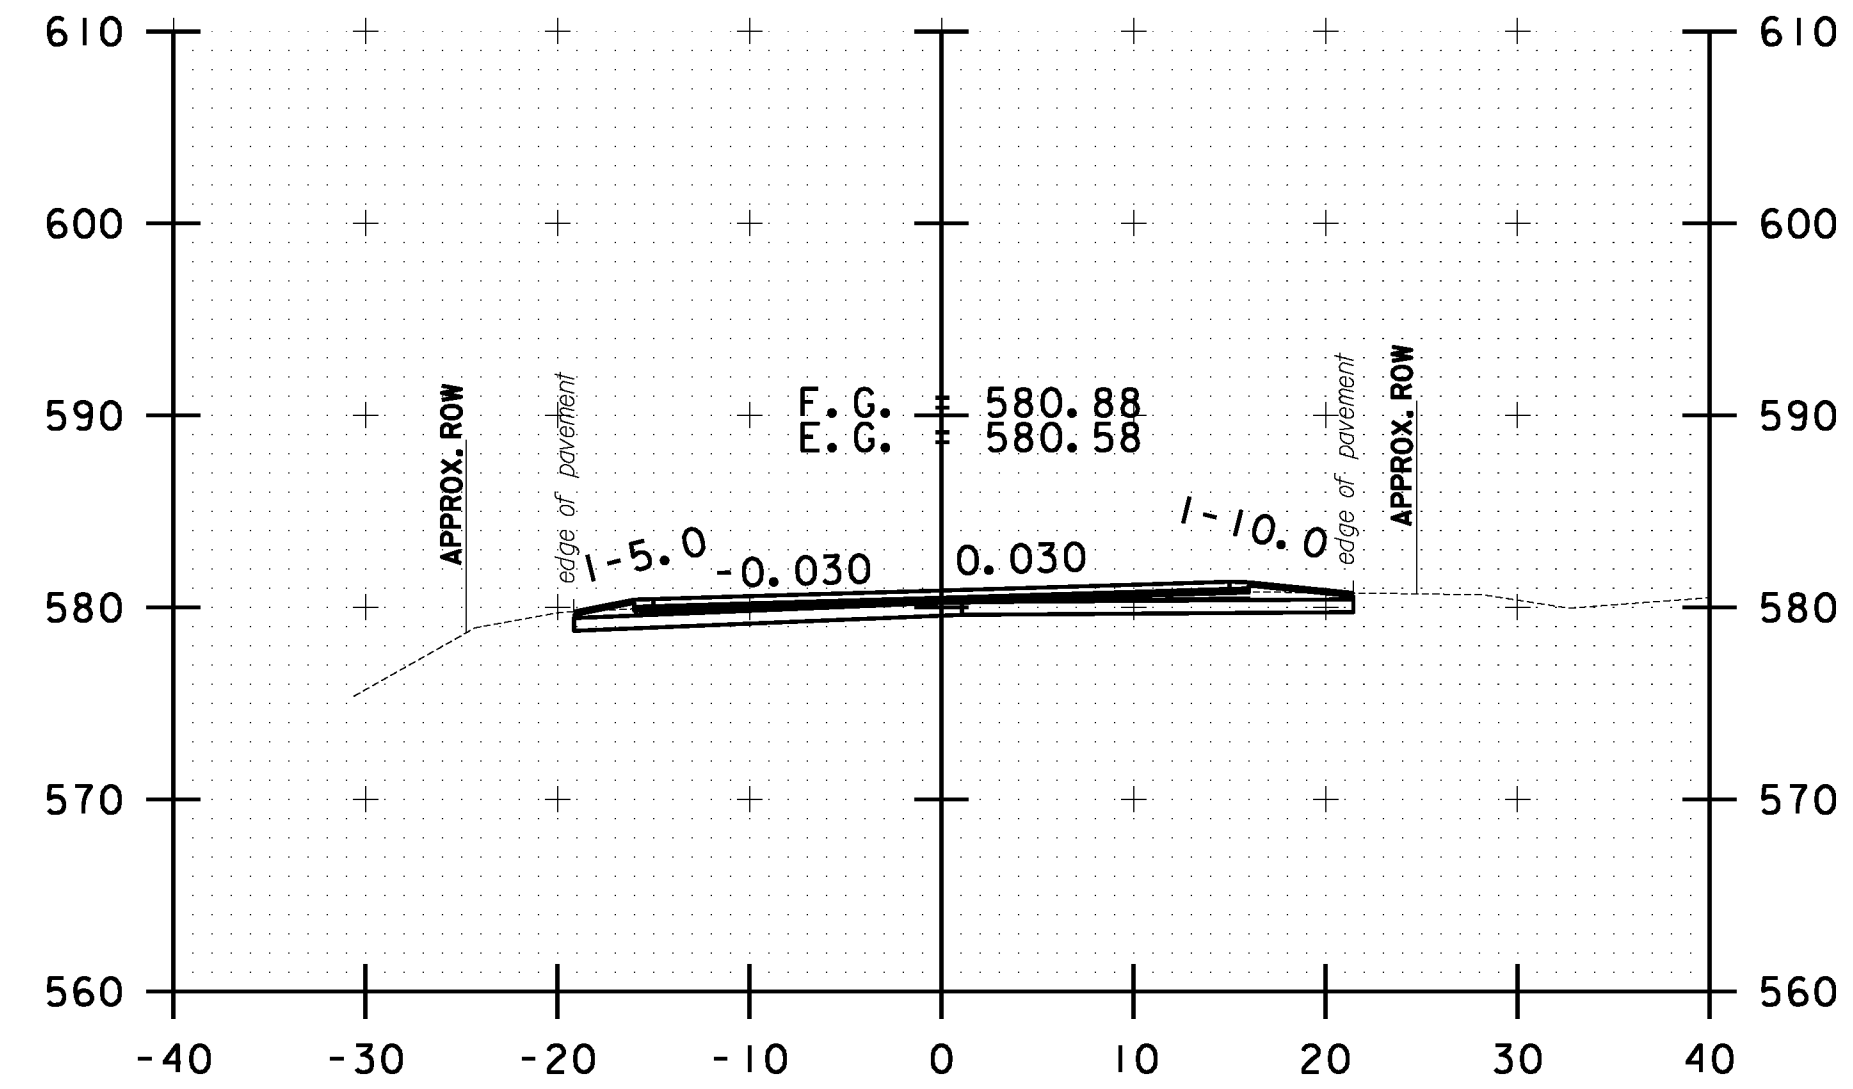


B 96+50.00

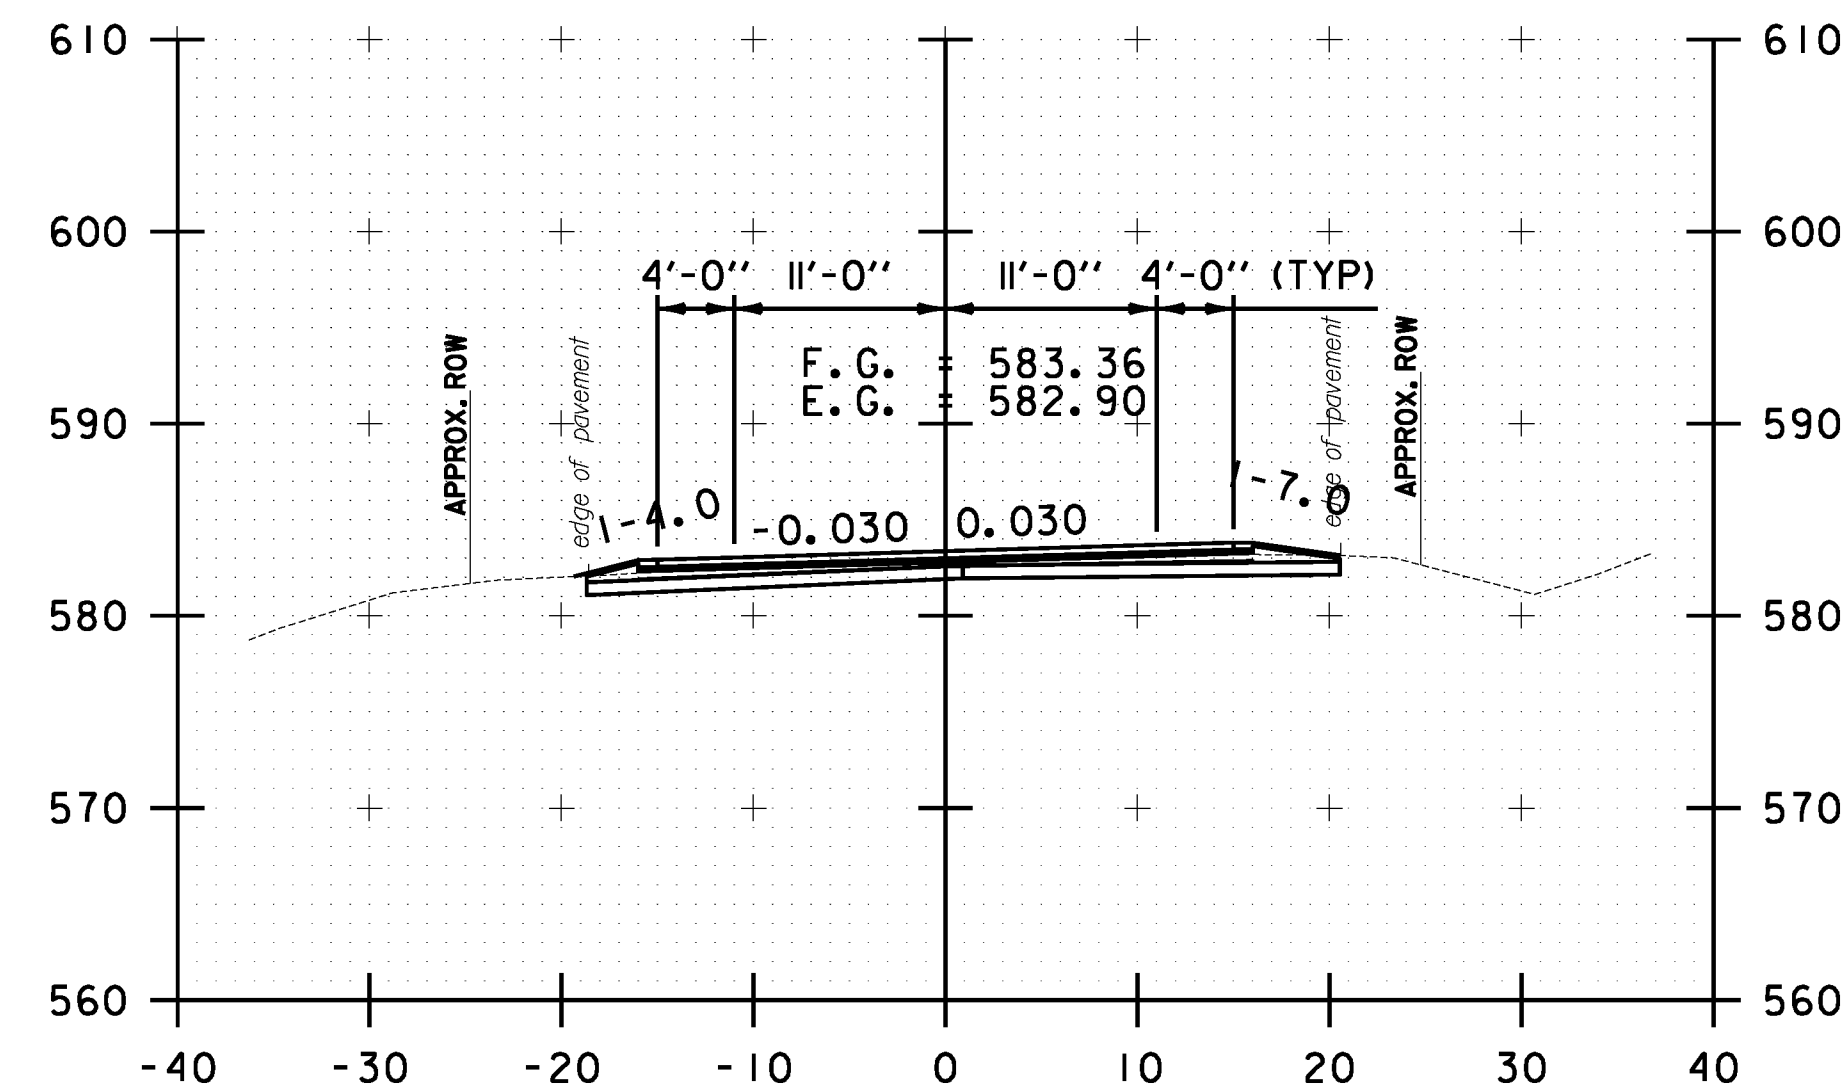

B 94+00.00

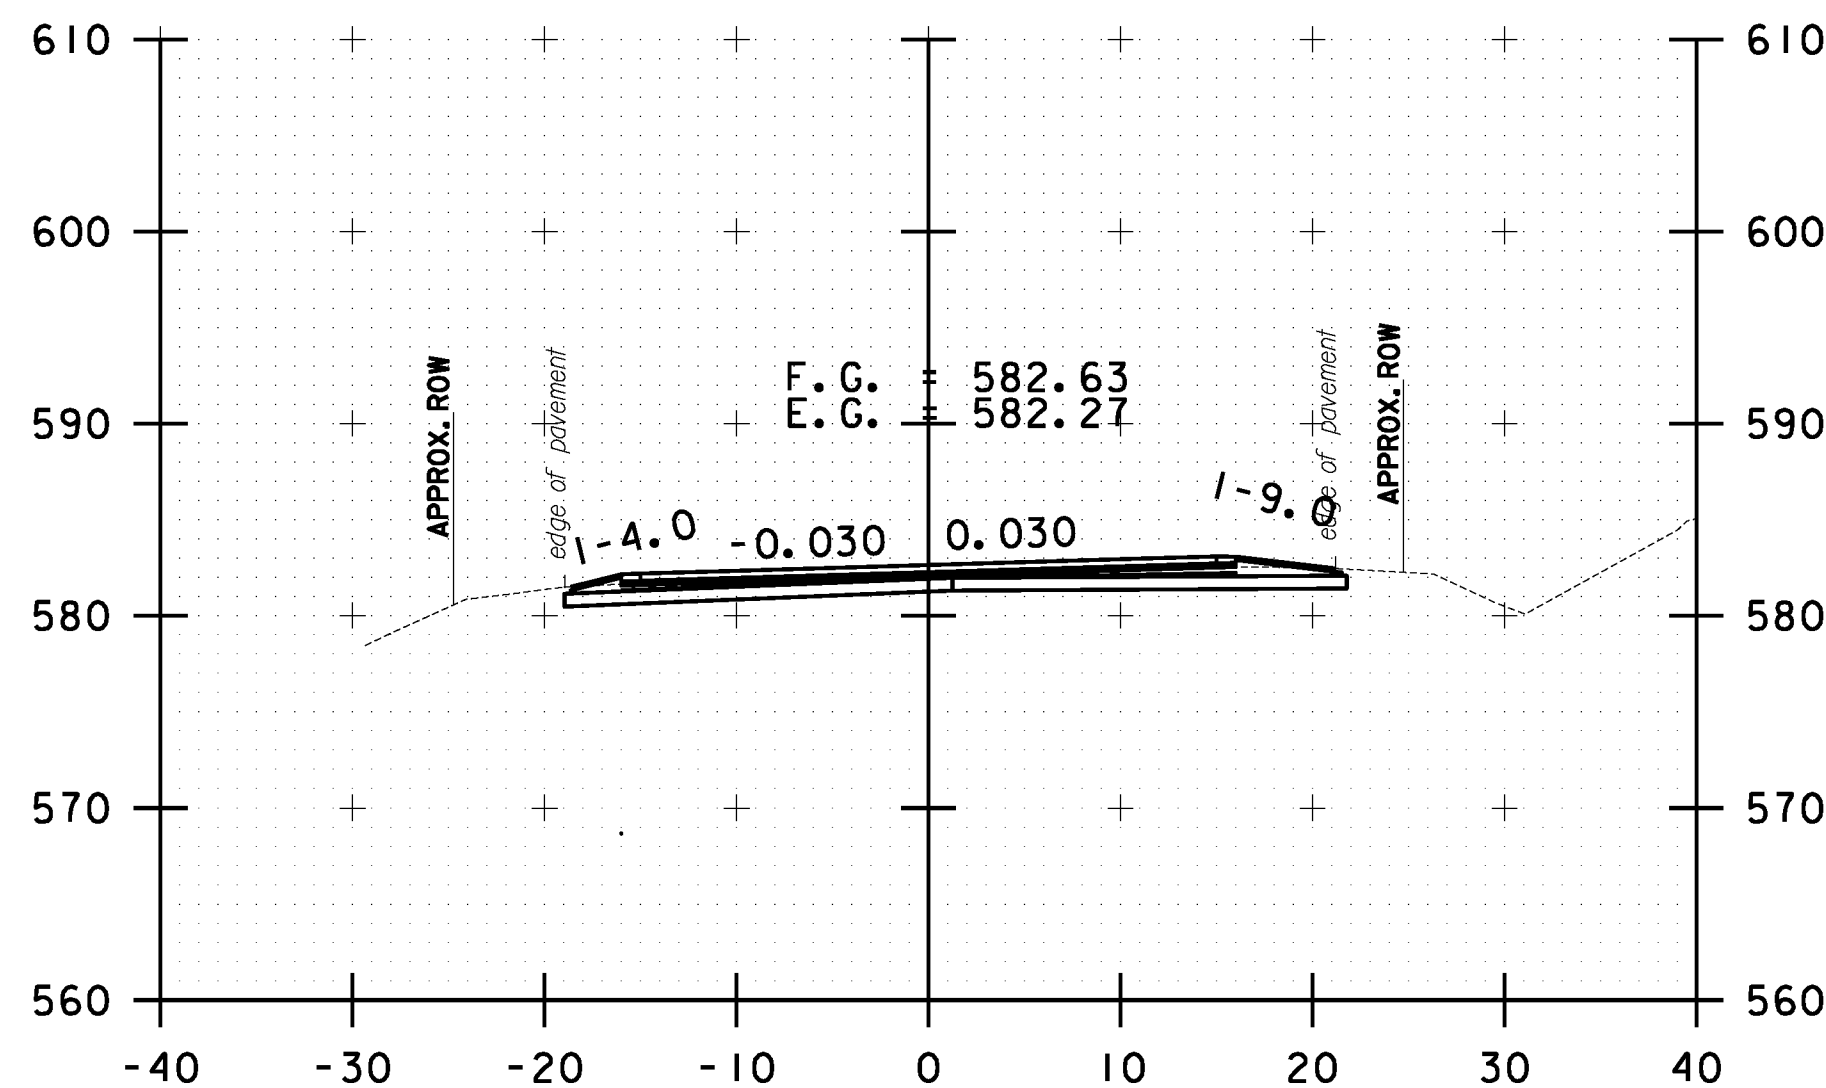

B 95+00.00

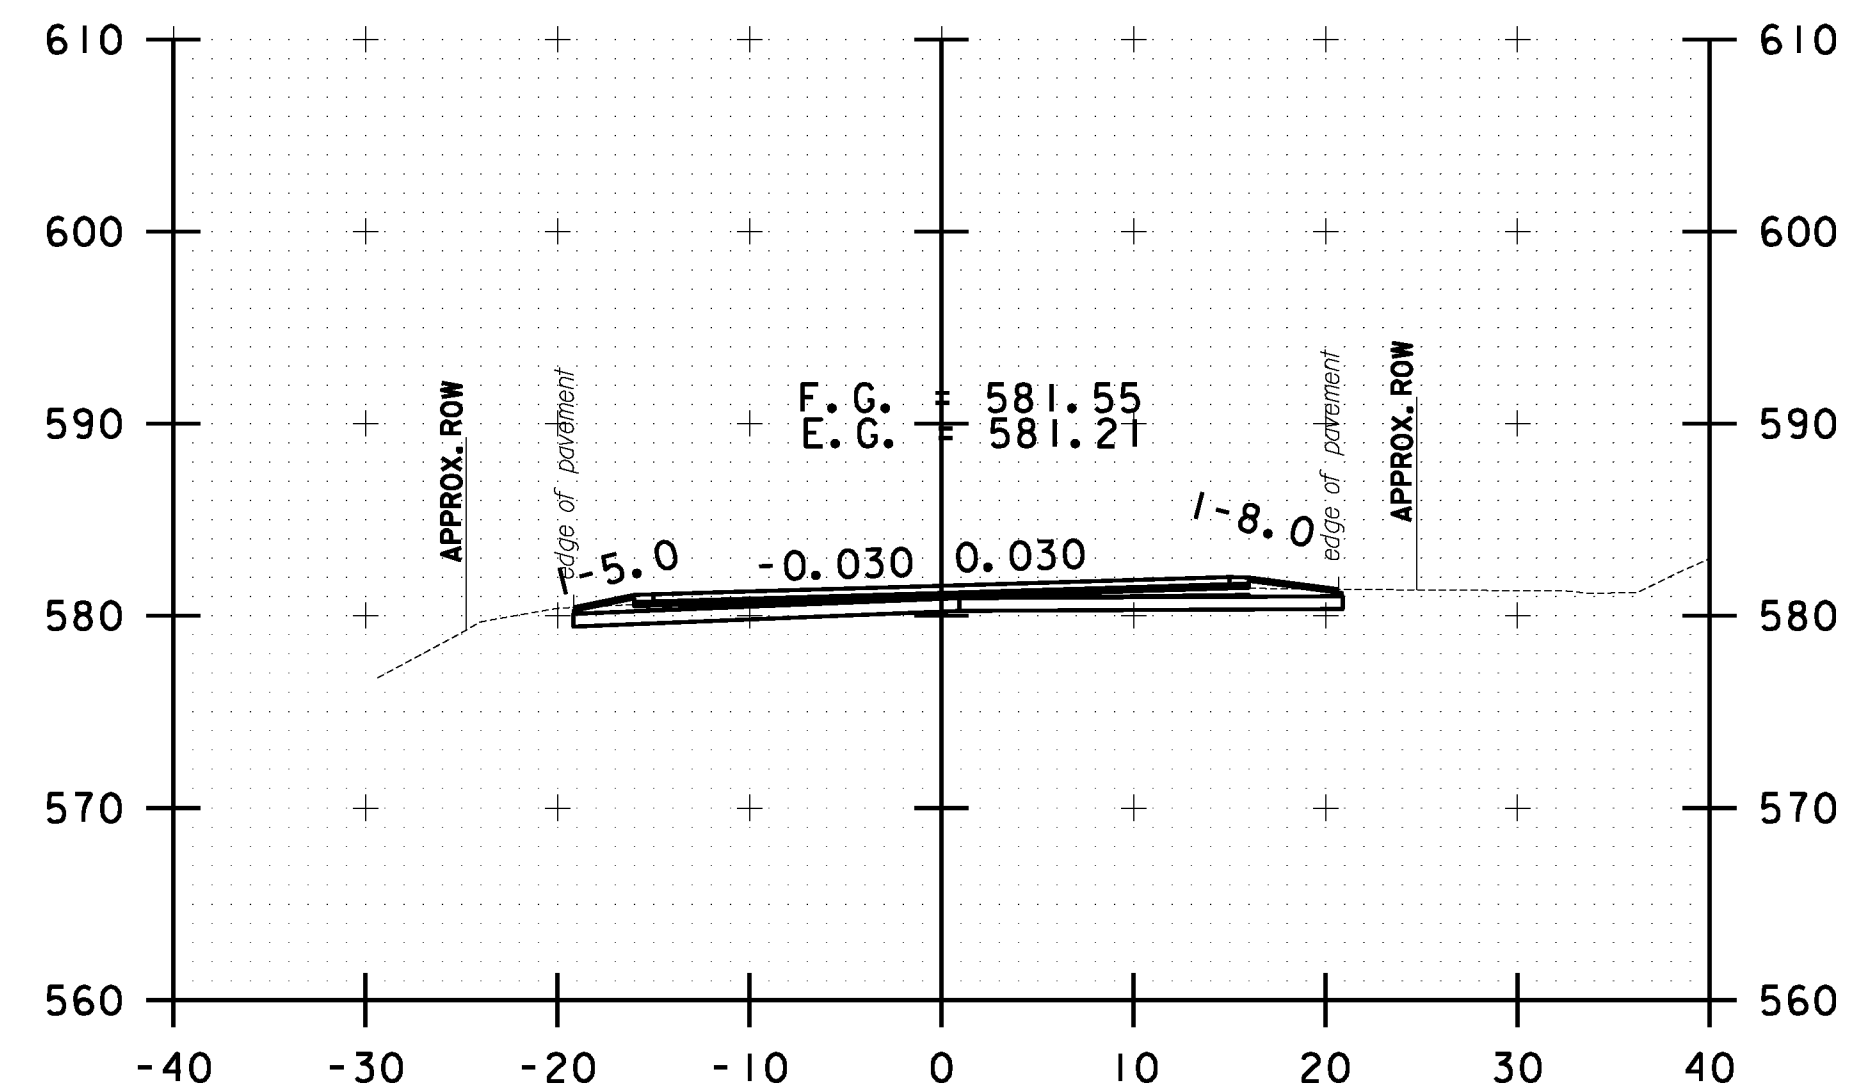

B 96+00.00



BETHEL CROSS SECTION SHEET #31	PROJECT NAME: STOCKBRIDGE-BETHEL
	PROJECT NUMBER: STP 2910(1)
	FILE NAME: z10b214_bethel_xc.dgn
DESIGNED BY: L.M.B.	PLOT DATE: 3/17/2014
IPARM FILE: z10b214xsl43.1	DRAWN BY: W.G.P.
	CHECKED BY: J.P.S.
	SHEET 356 OF 397