




FILE NAME = Y:\P\c\res\any\k2\22425\CADD\MSTN\10b214.bethel.xc.dgn
 DATE/TIME = 3/17/2014
 USER = 4916

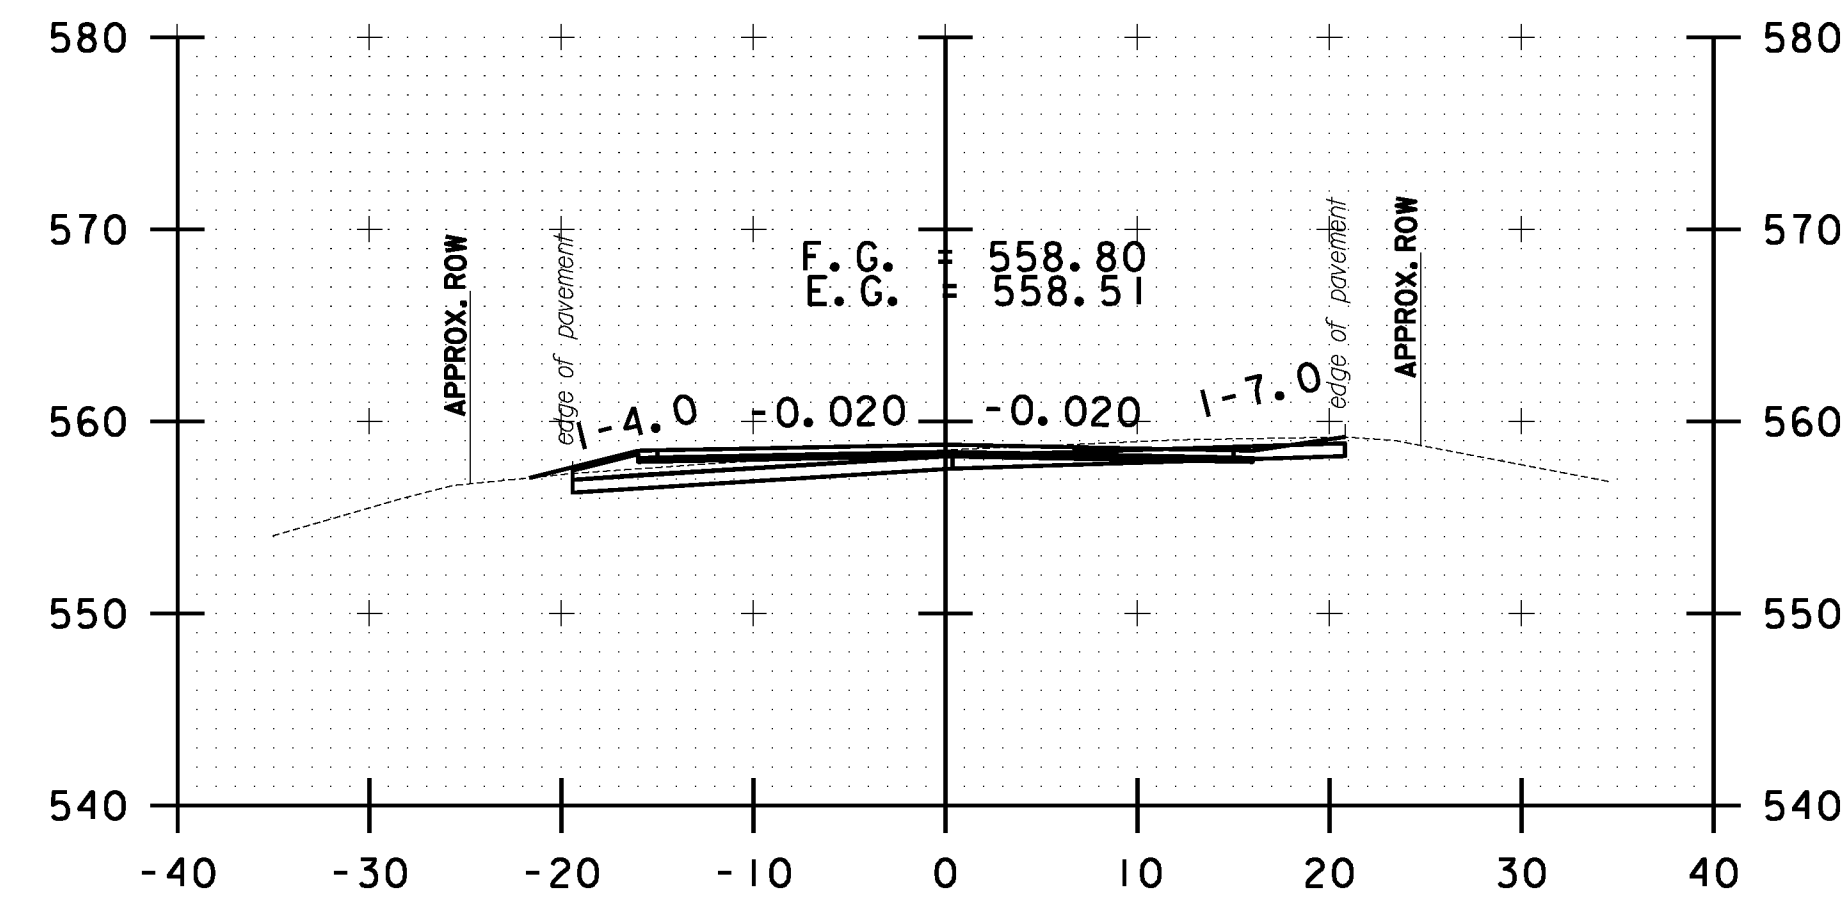


B 119+50.00

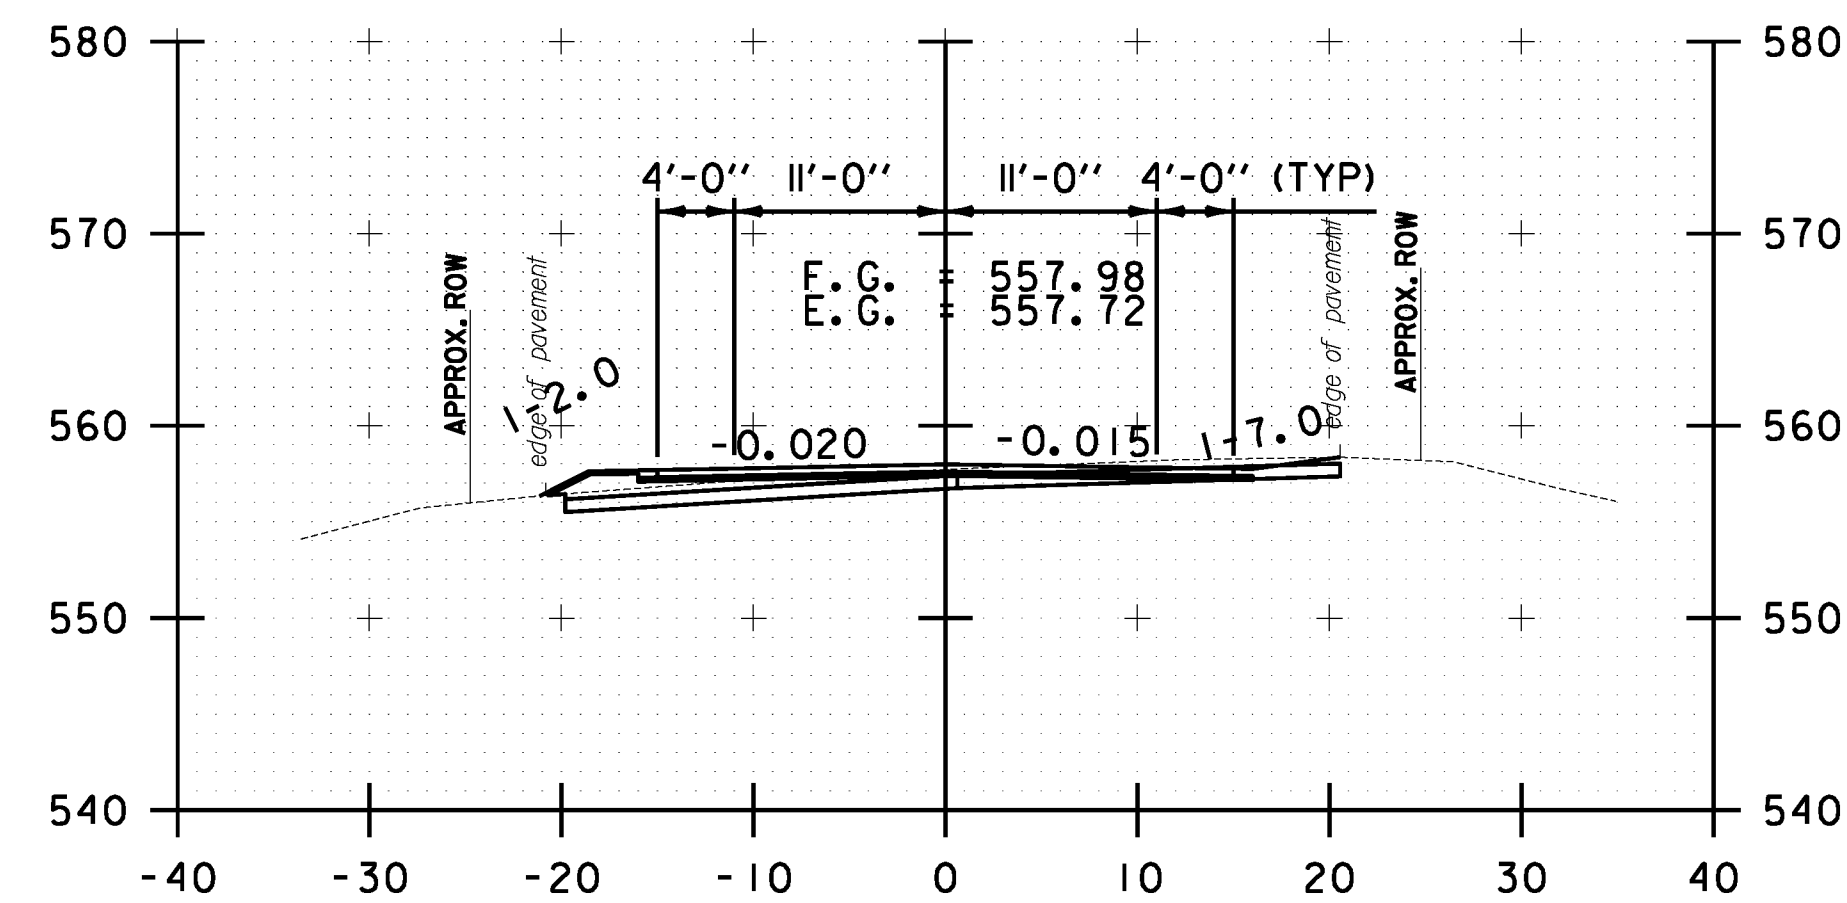


B 119+00.00

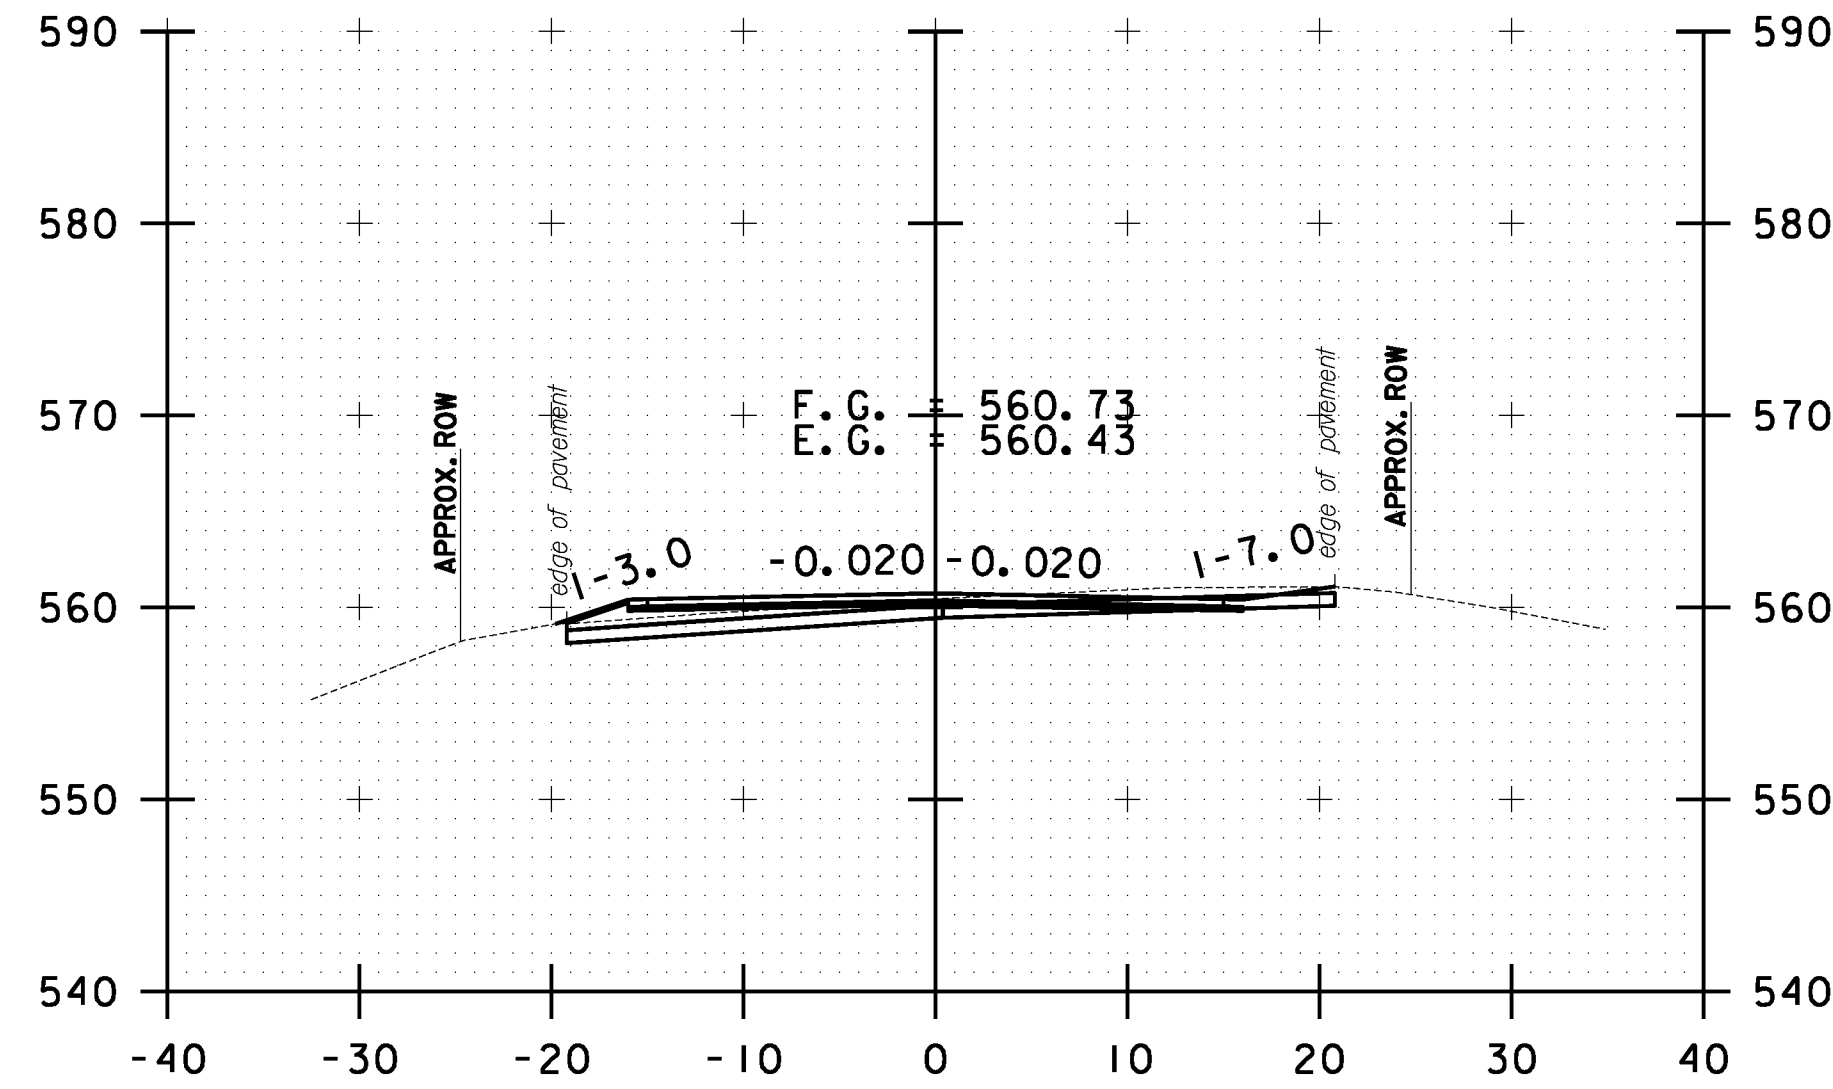


B 120+50.00

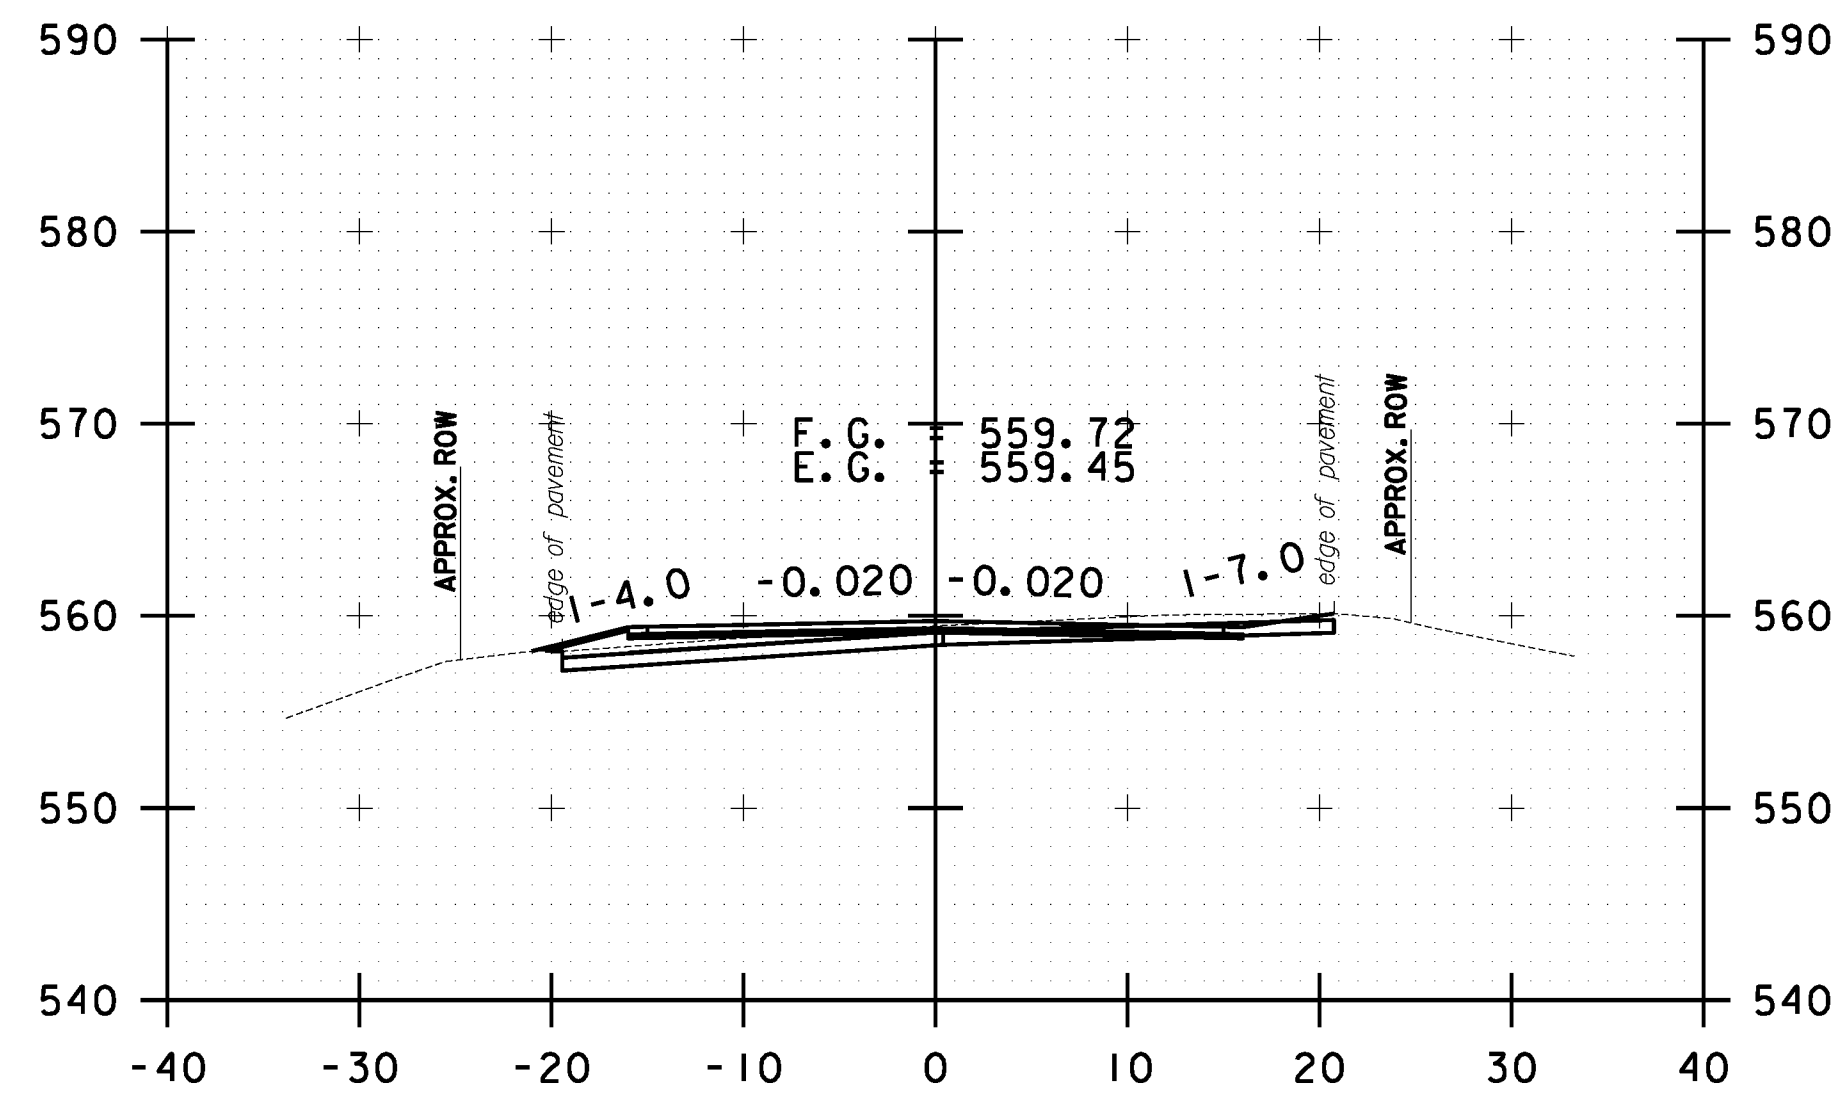

B 120+00.00

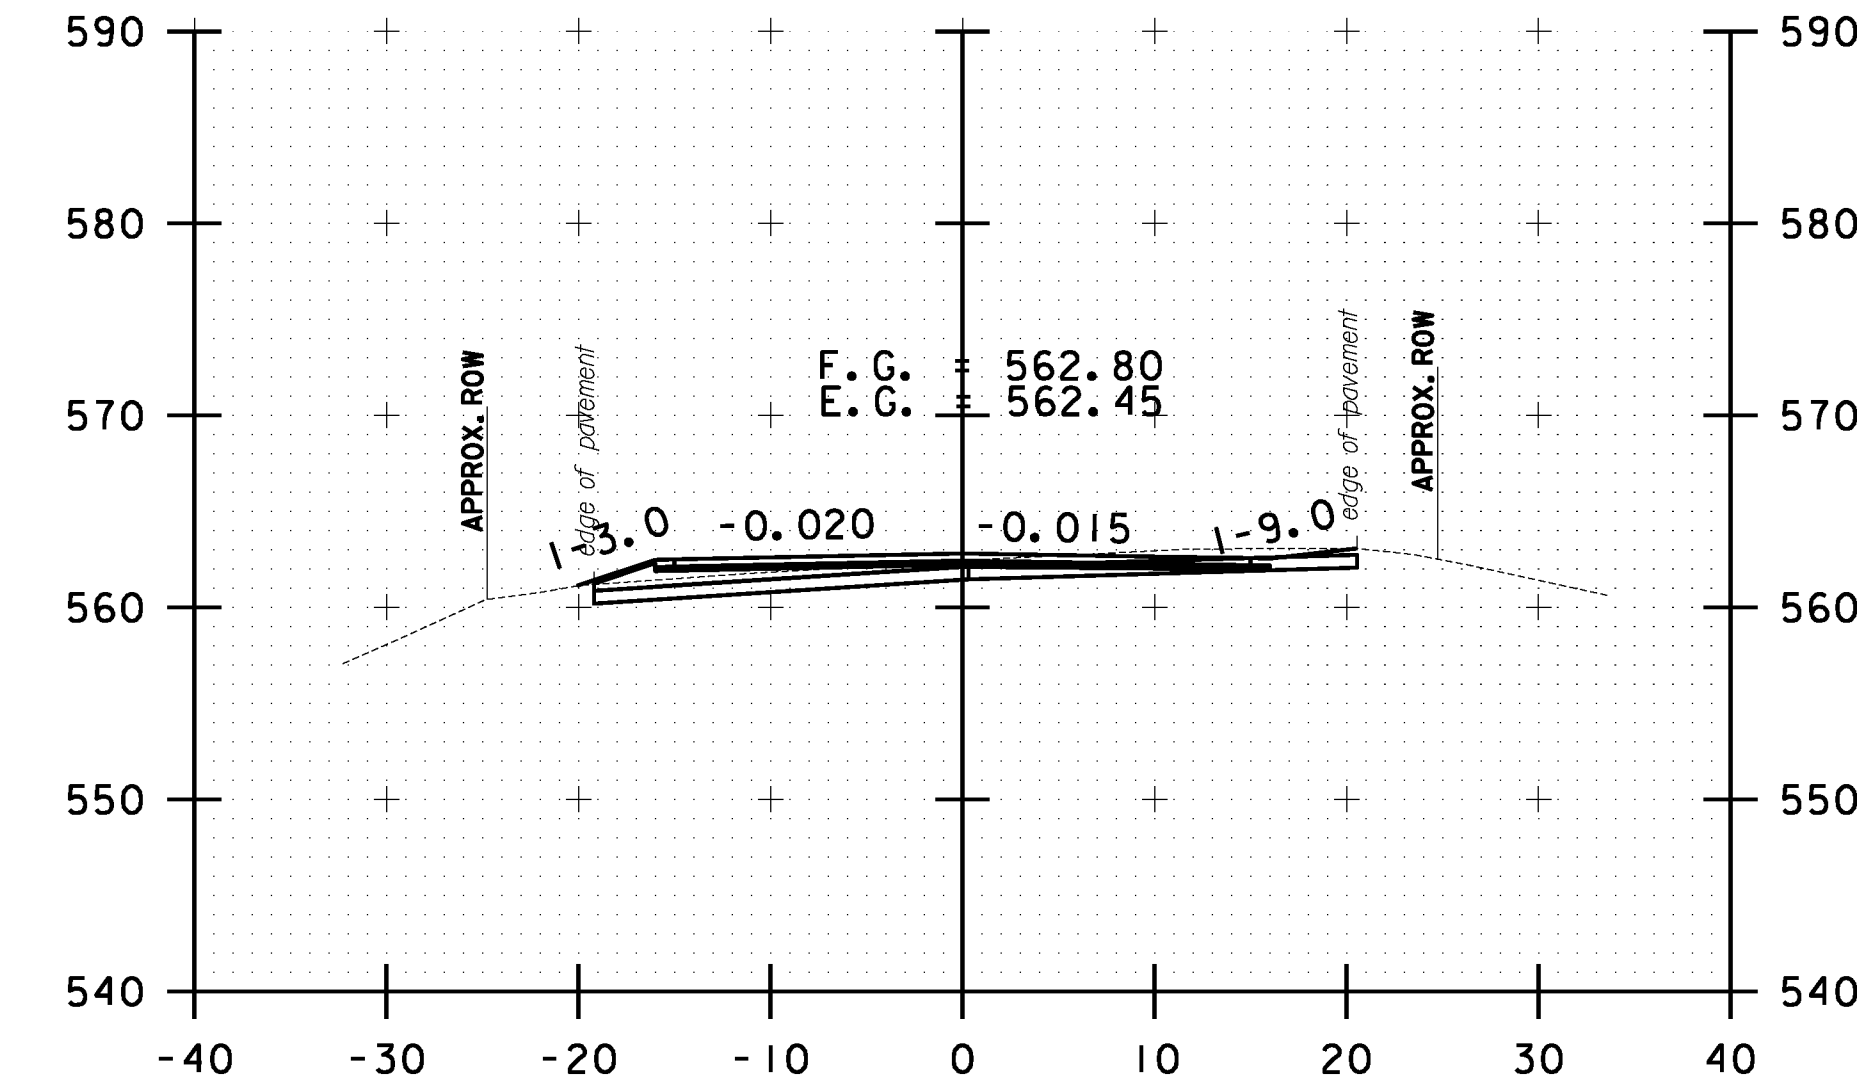

B 121+50.00

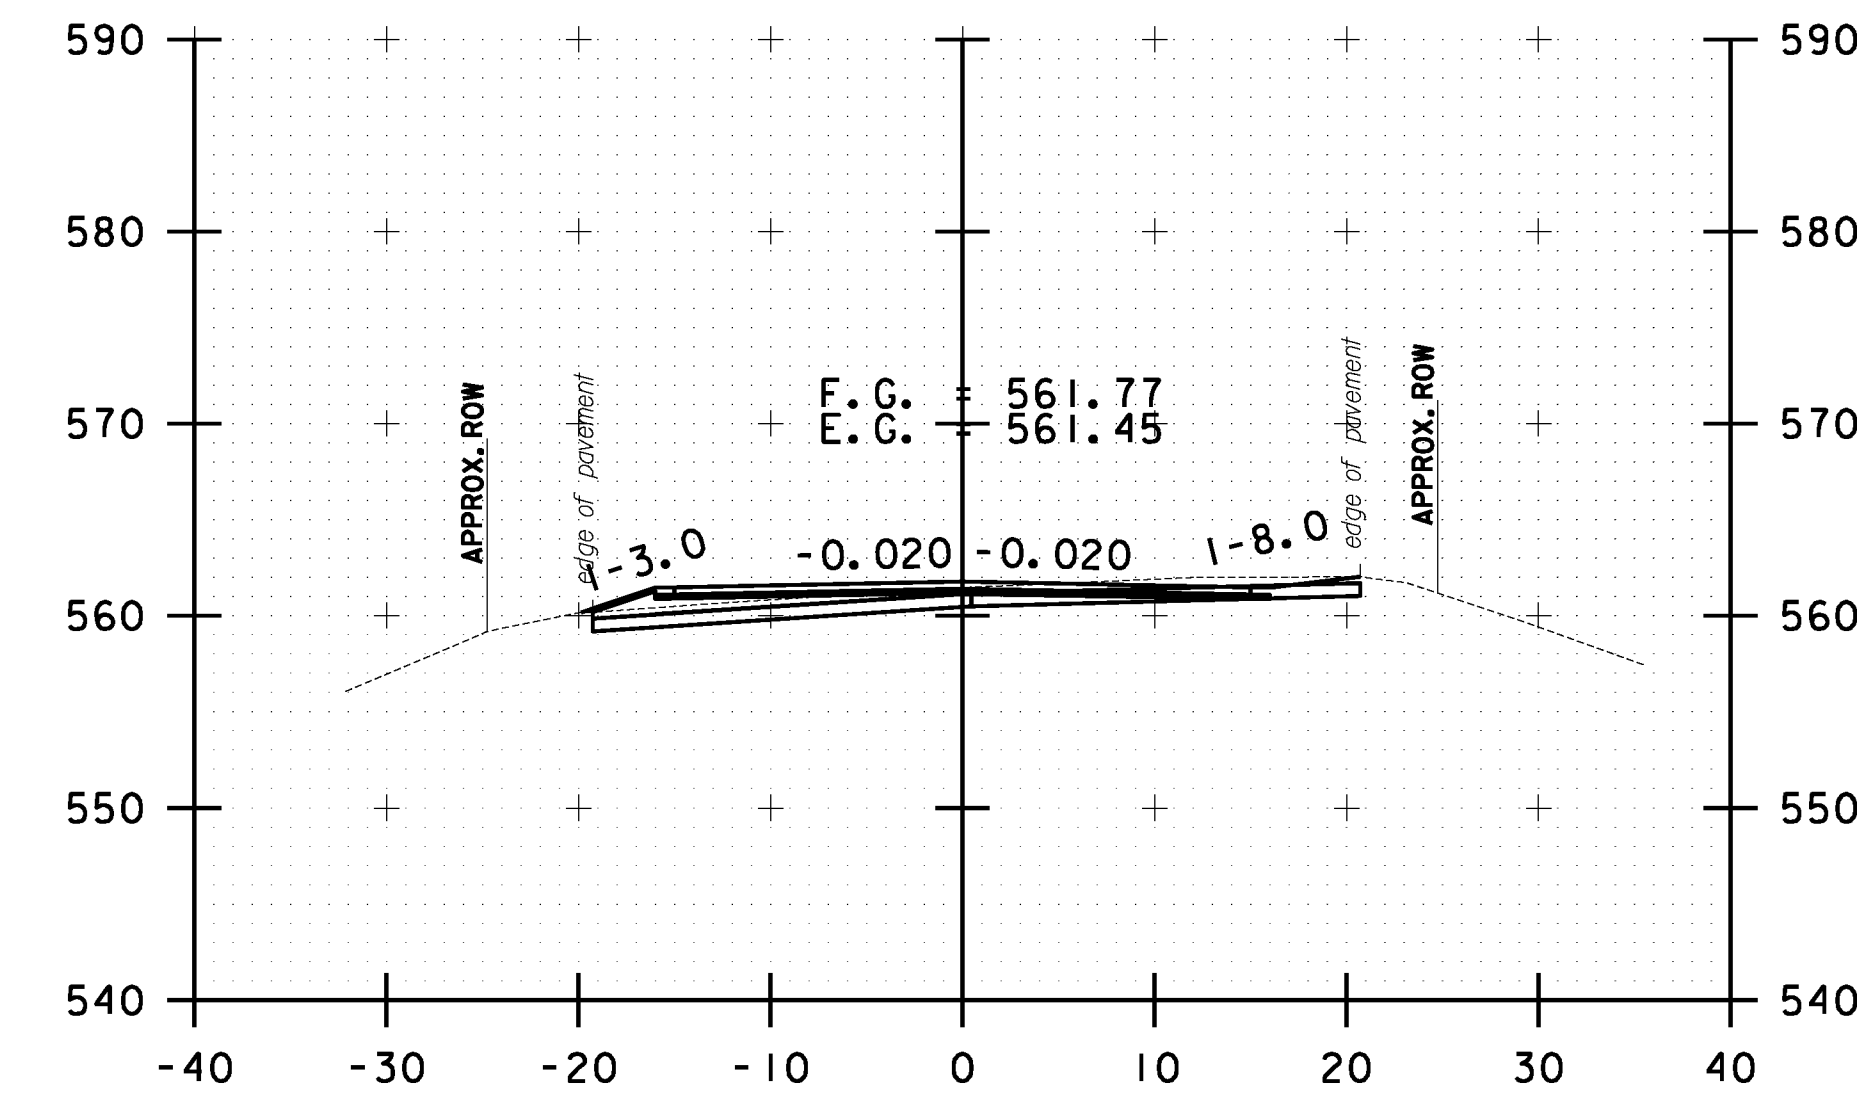

B 121+00.00



BETHEL CROSS SECTION SHEET #39	PROJECT NAME: STOCKBRIDGE-BETHEL
	PROJECT NUMBER: STP 2910(1)
	FILE NAME: z10b214.bethel.xc.dgn
	IPARM FILE: z10b214xsl1
	PLOT DATE: 3/17/2014
	DRAWN BY: W.G.P.
	CHECKED BY: J.P.S.
	SHEET 364 OF 397