




FILE NAME = Y:\P\c\8501\ANY\K2\22425\CADD\MSTN\10b214.bethel.xc.dgn
 DATE/TIME = 3/17/2014
 USER = 4916

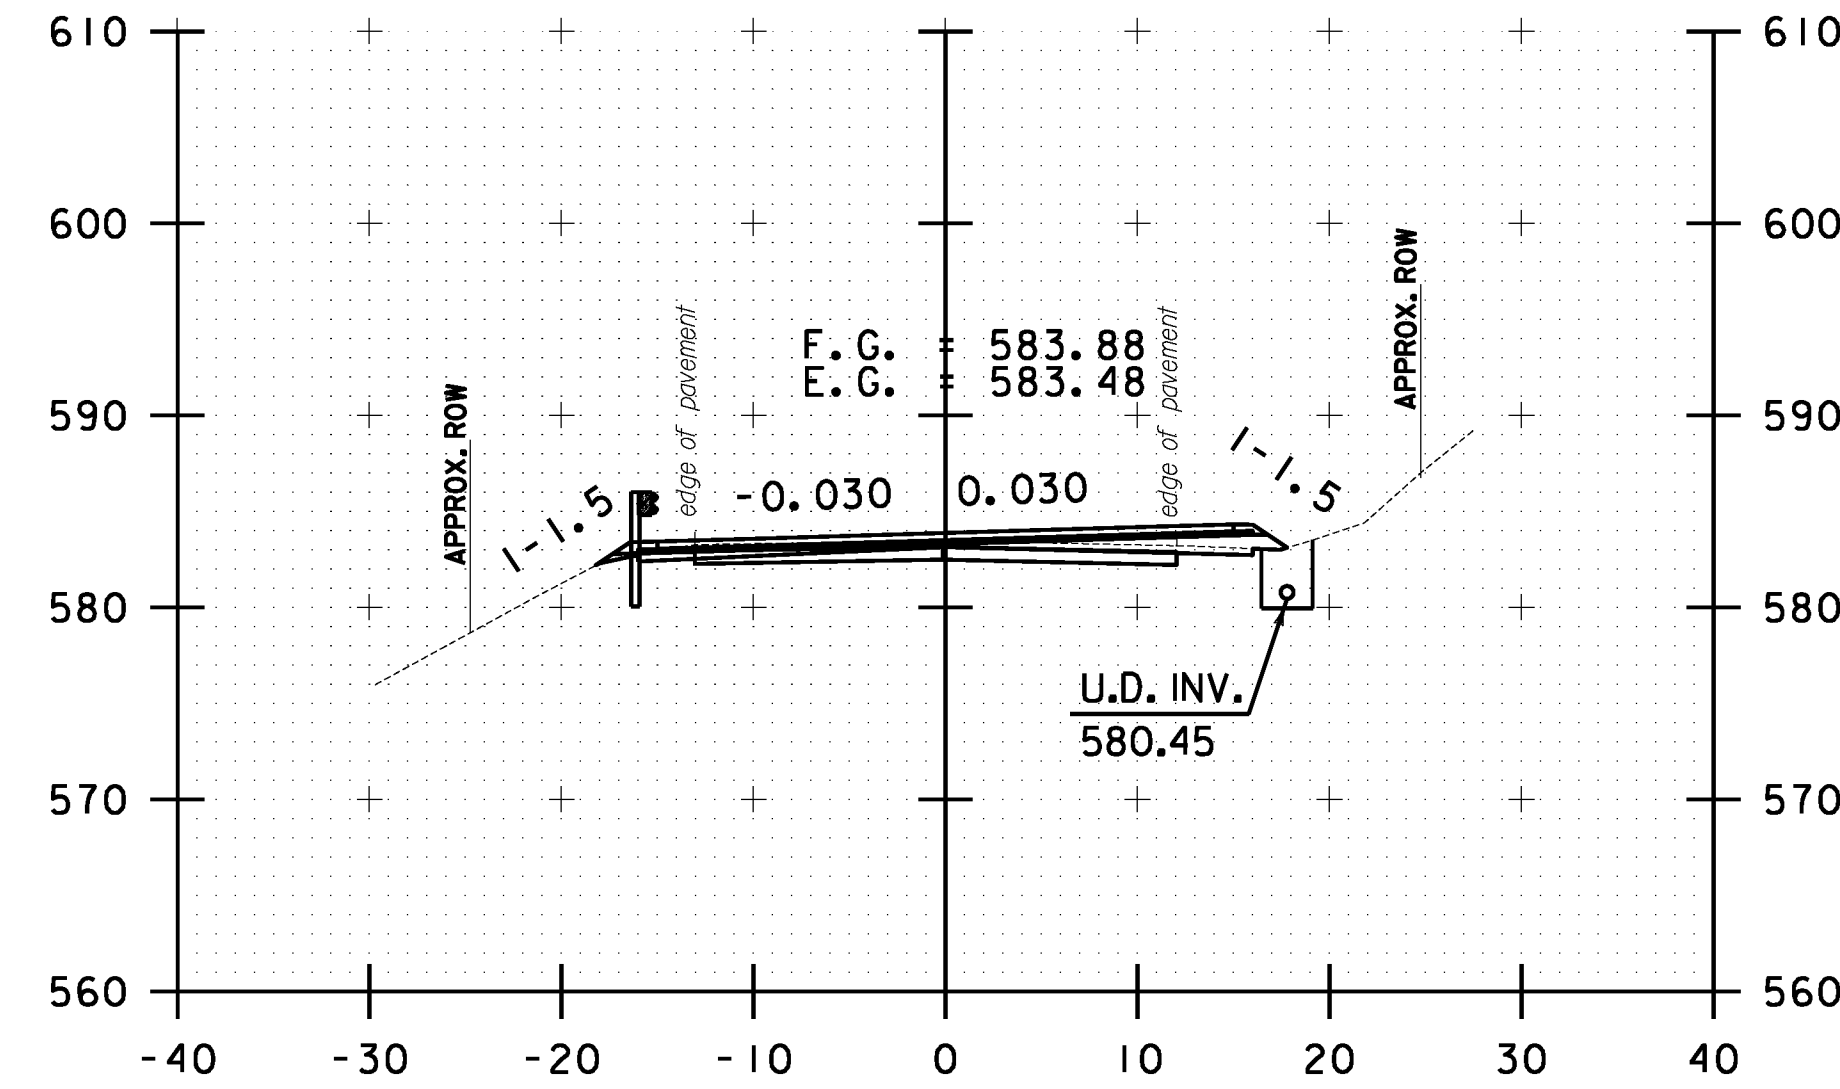


B 132+00.00

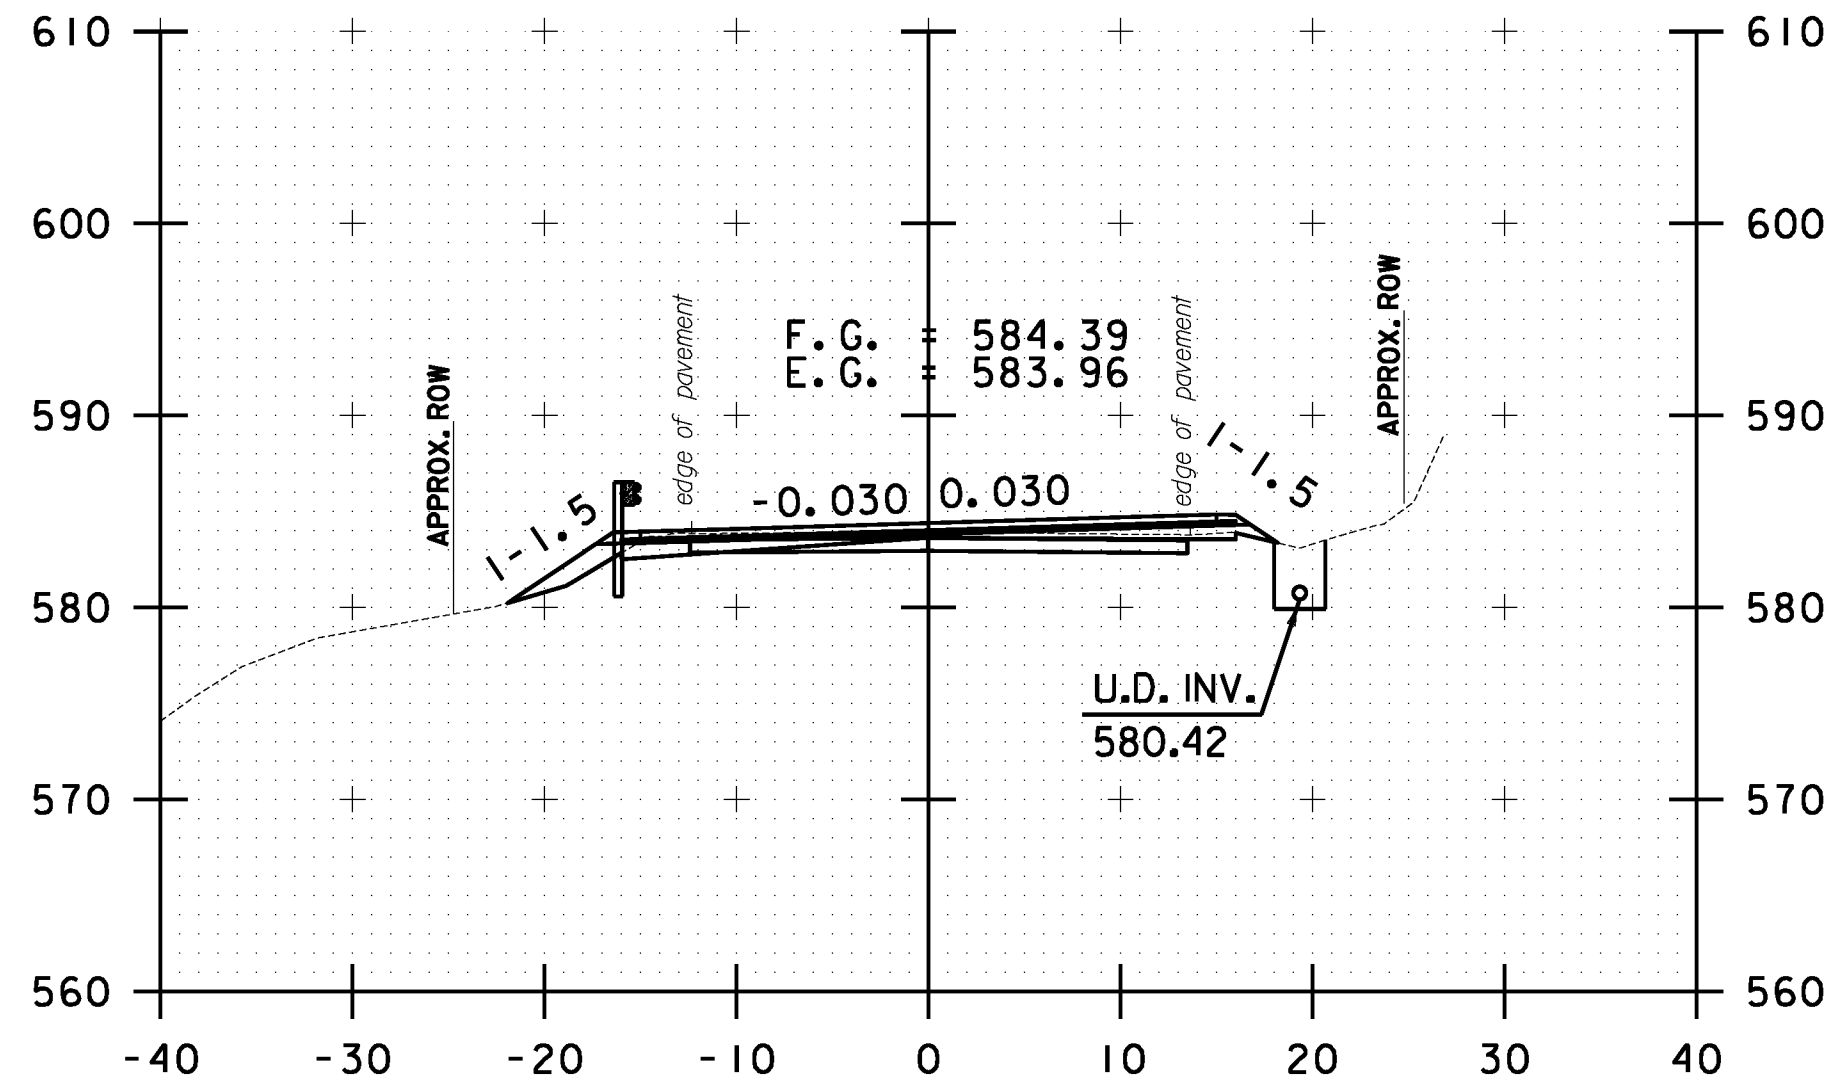


B 133+00.00

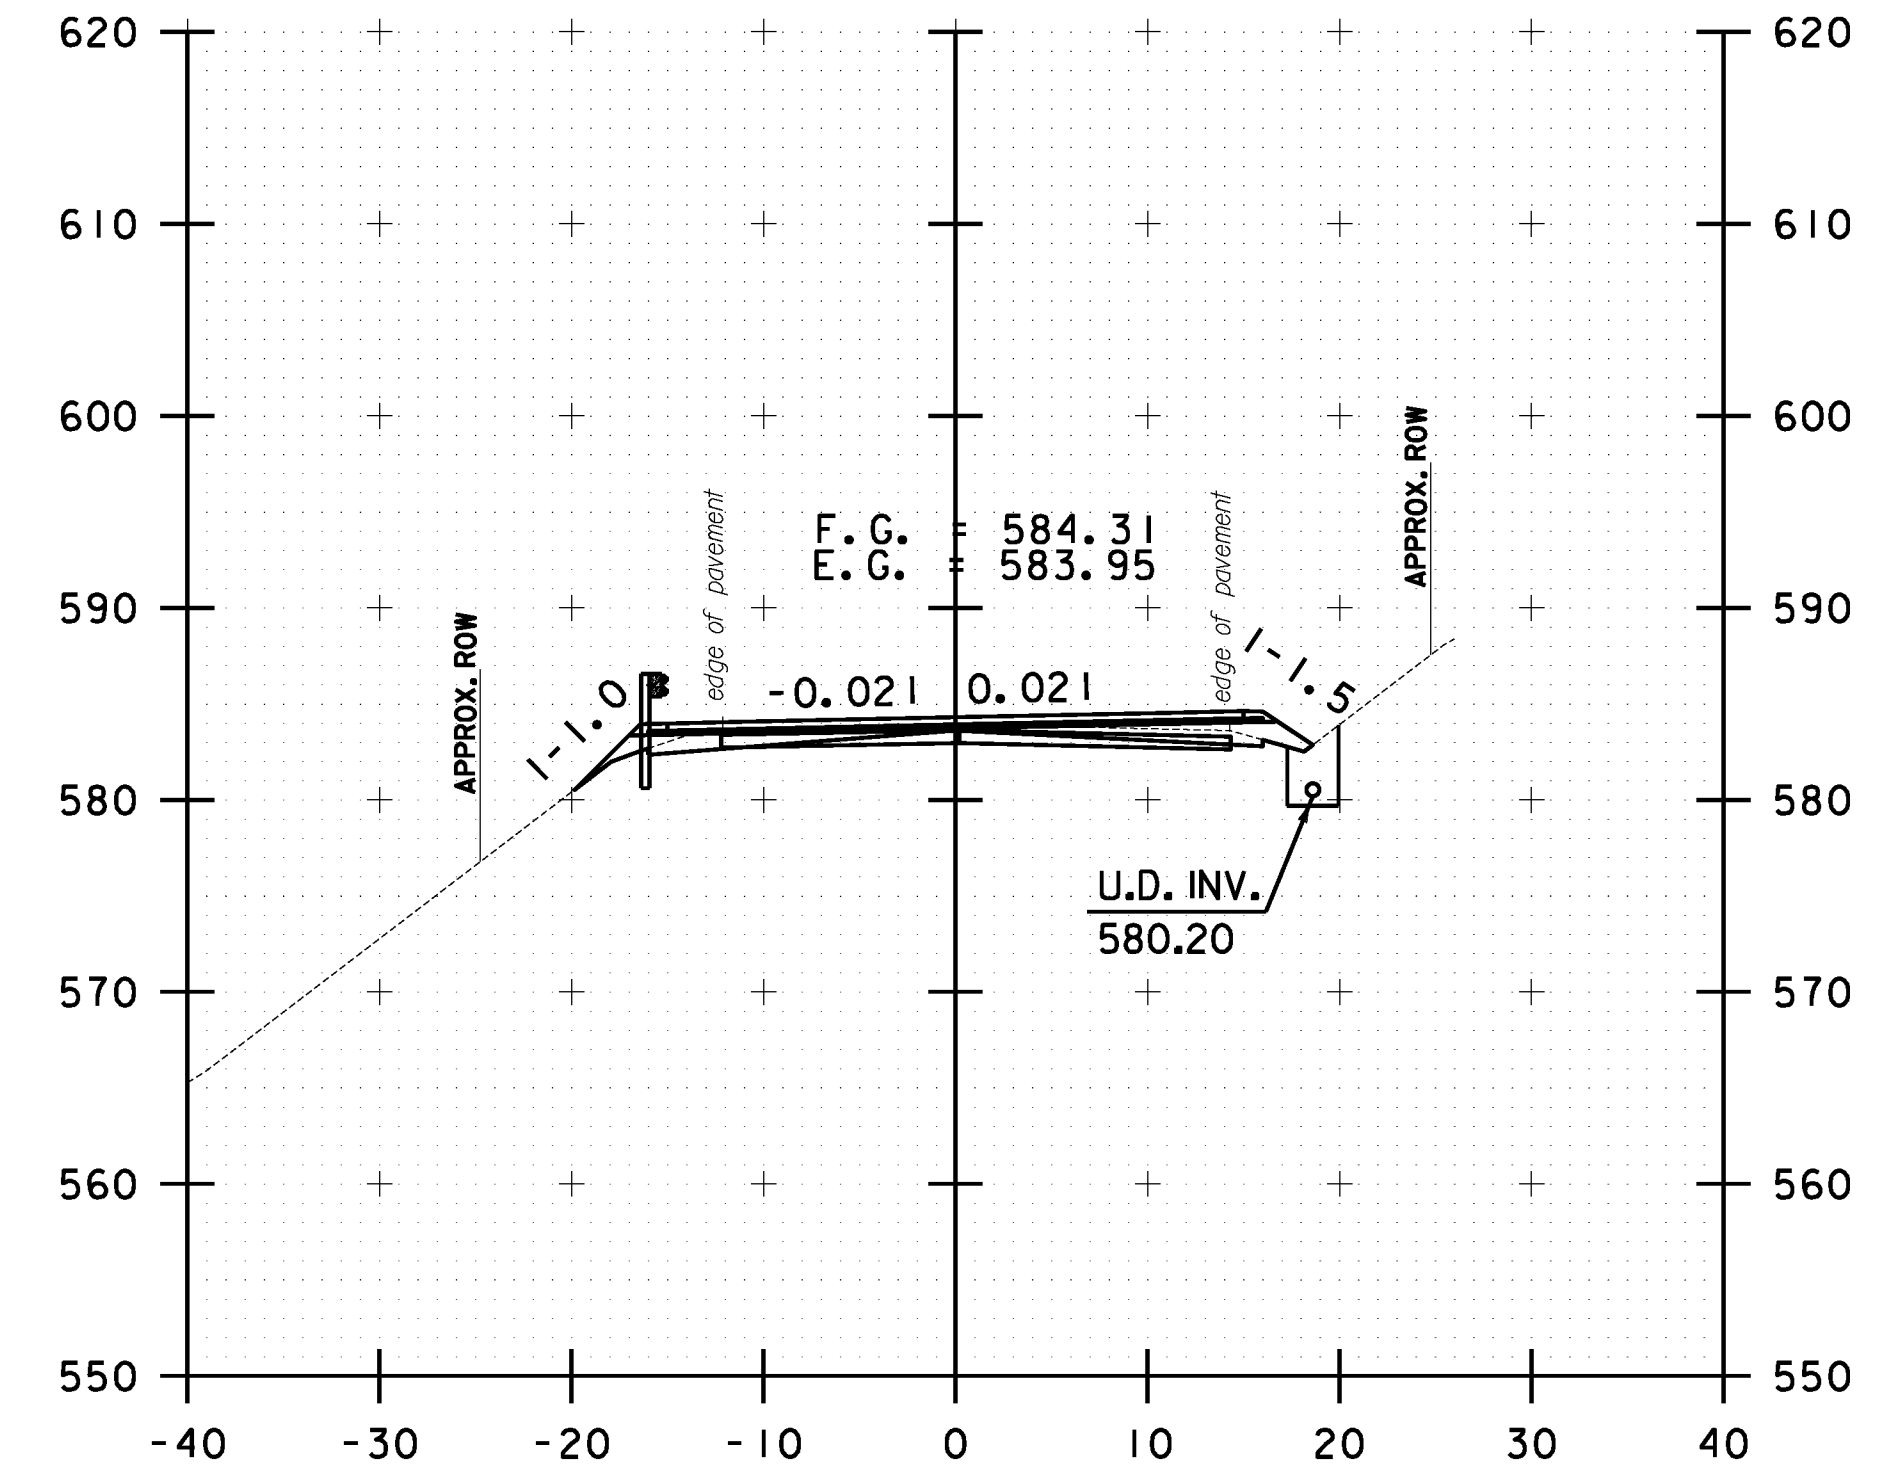


B 133+50.00

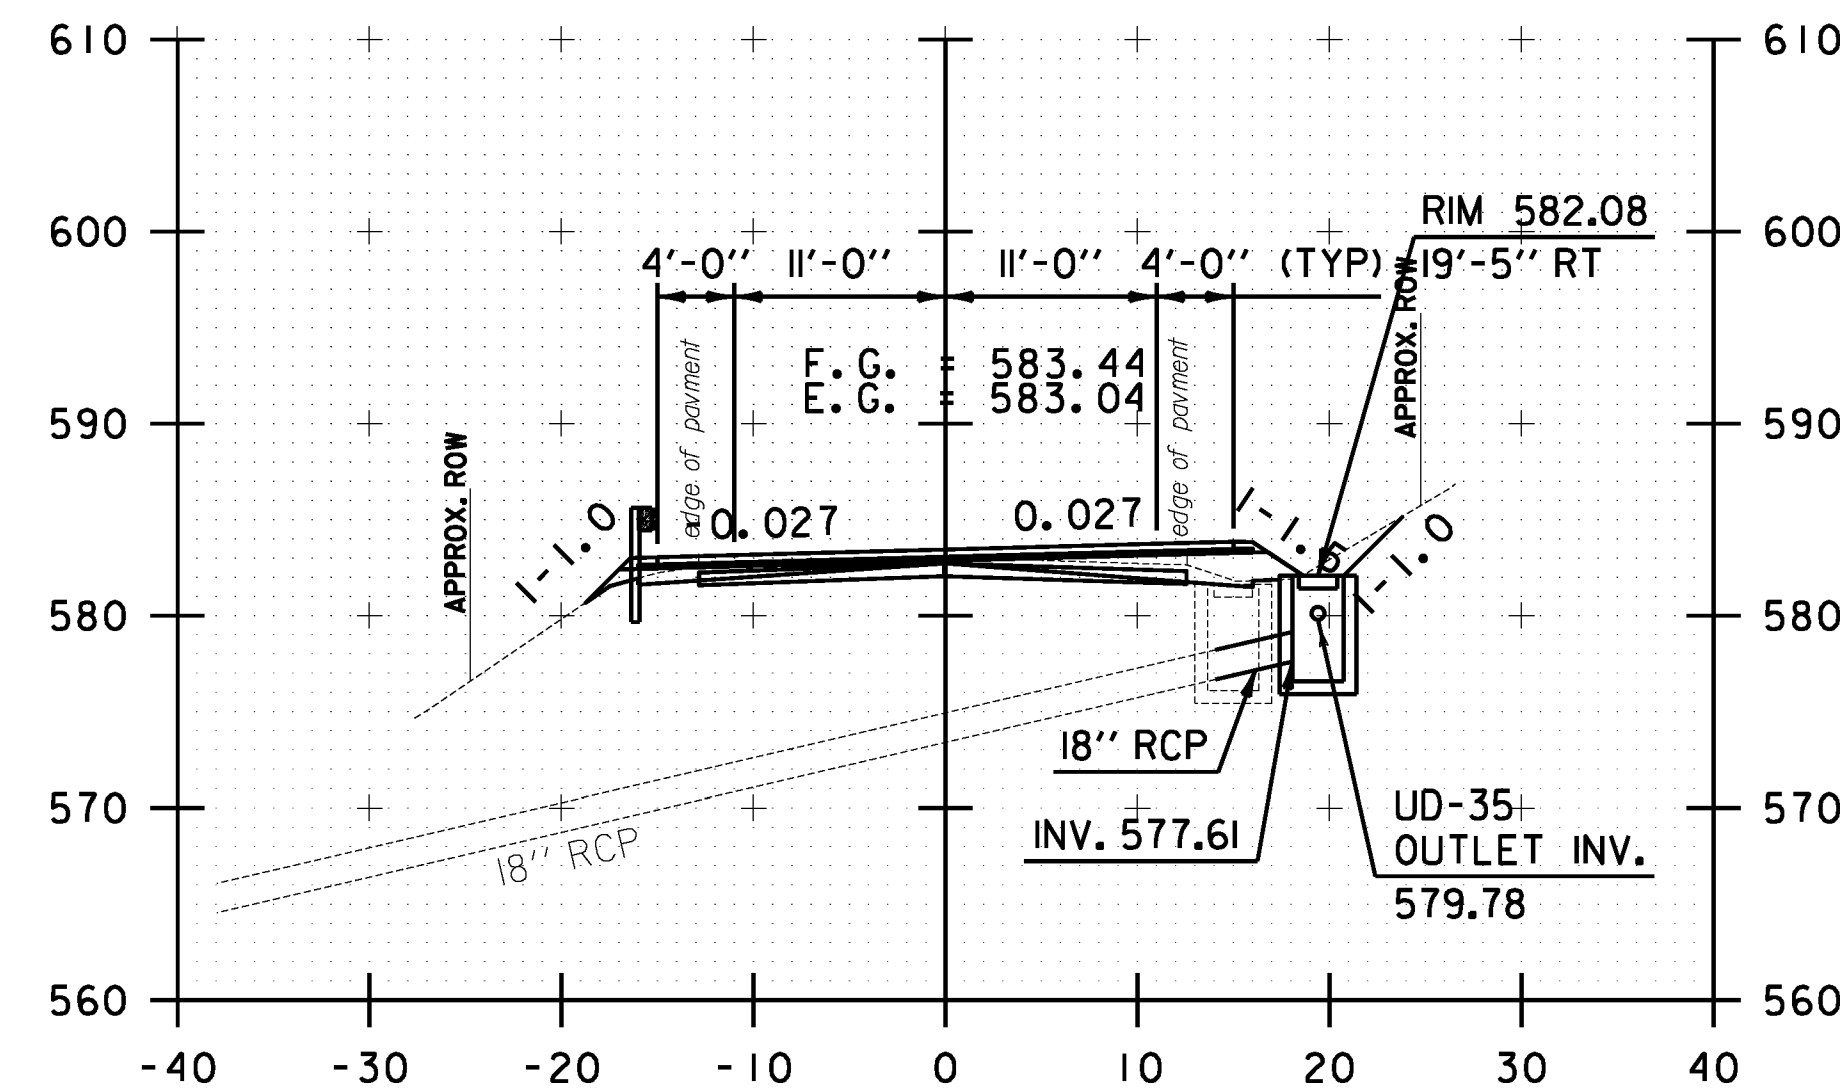

B 131+61.70

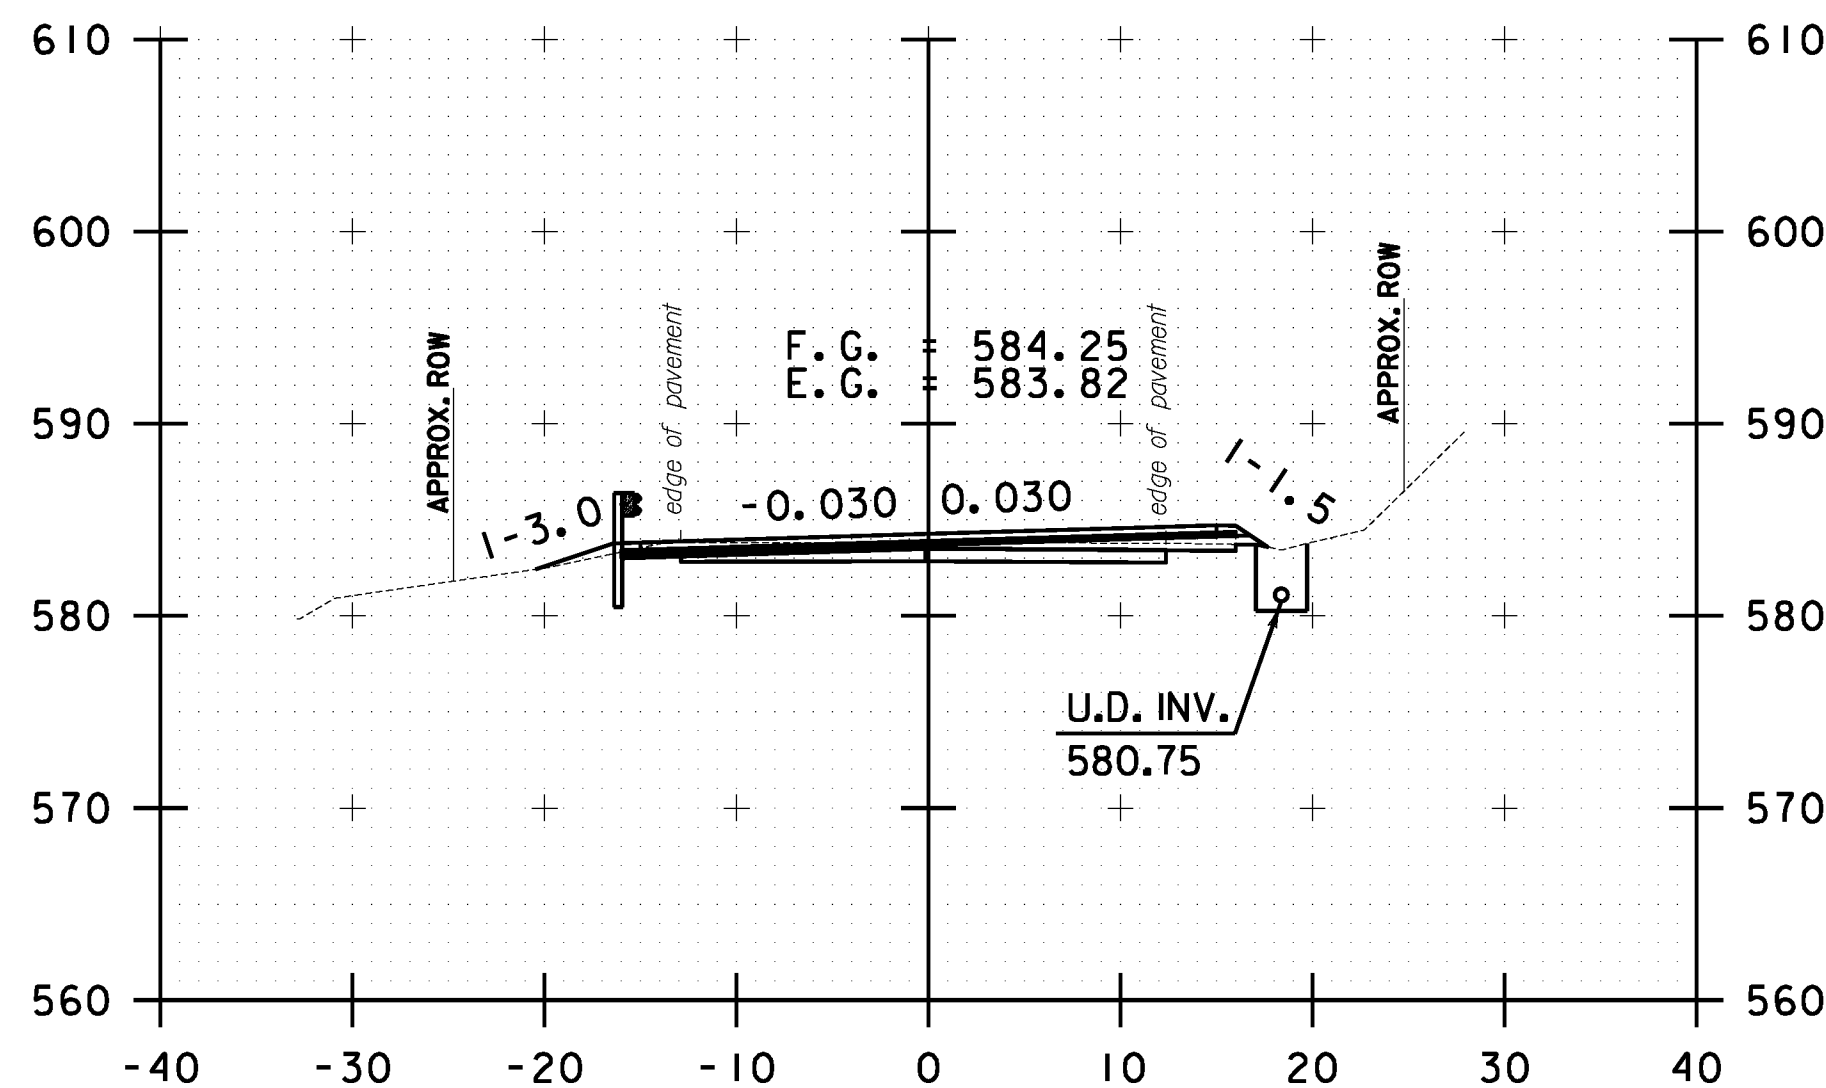

B 132+50.00

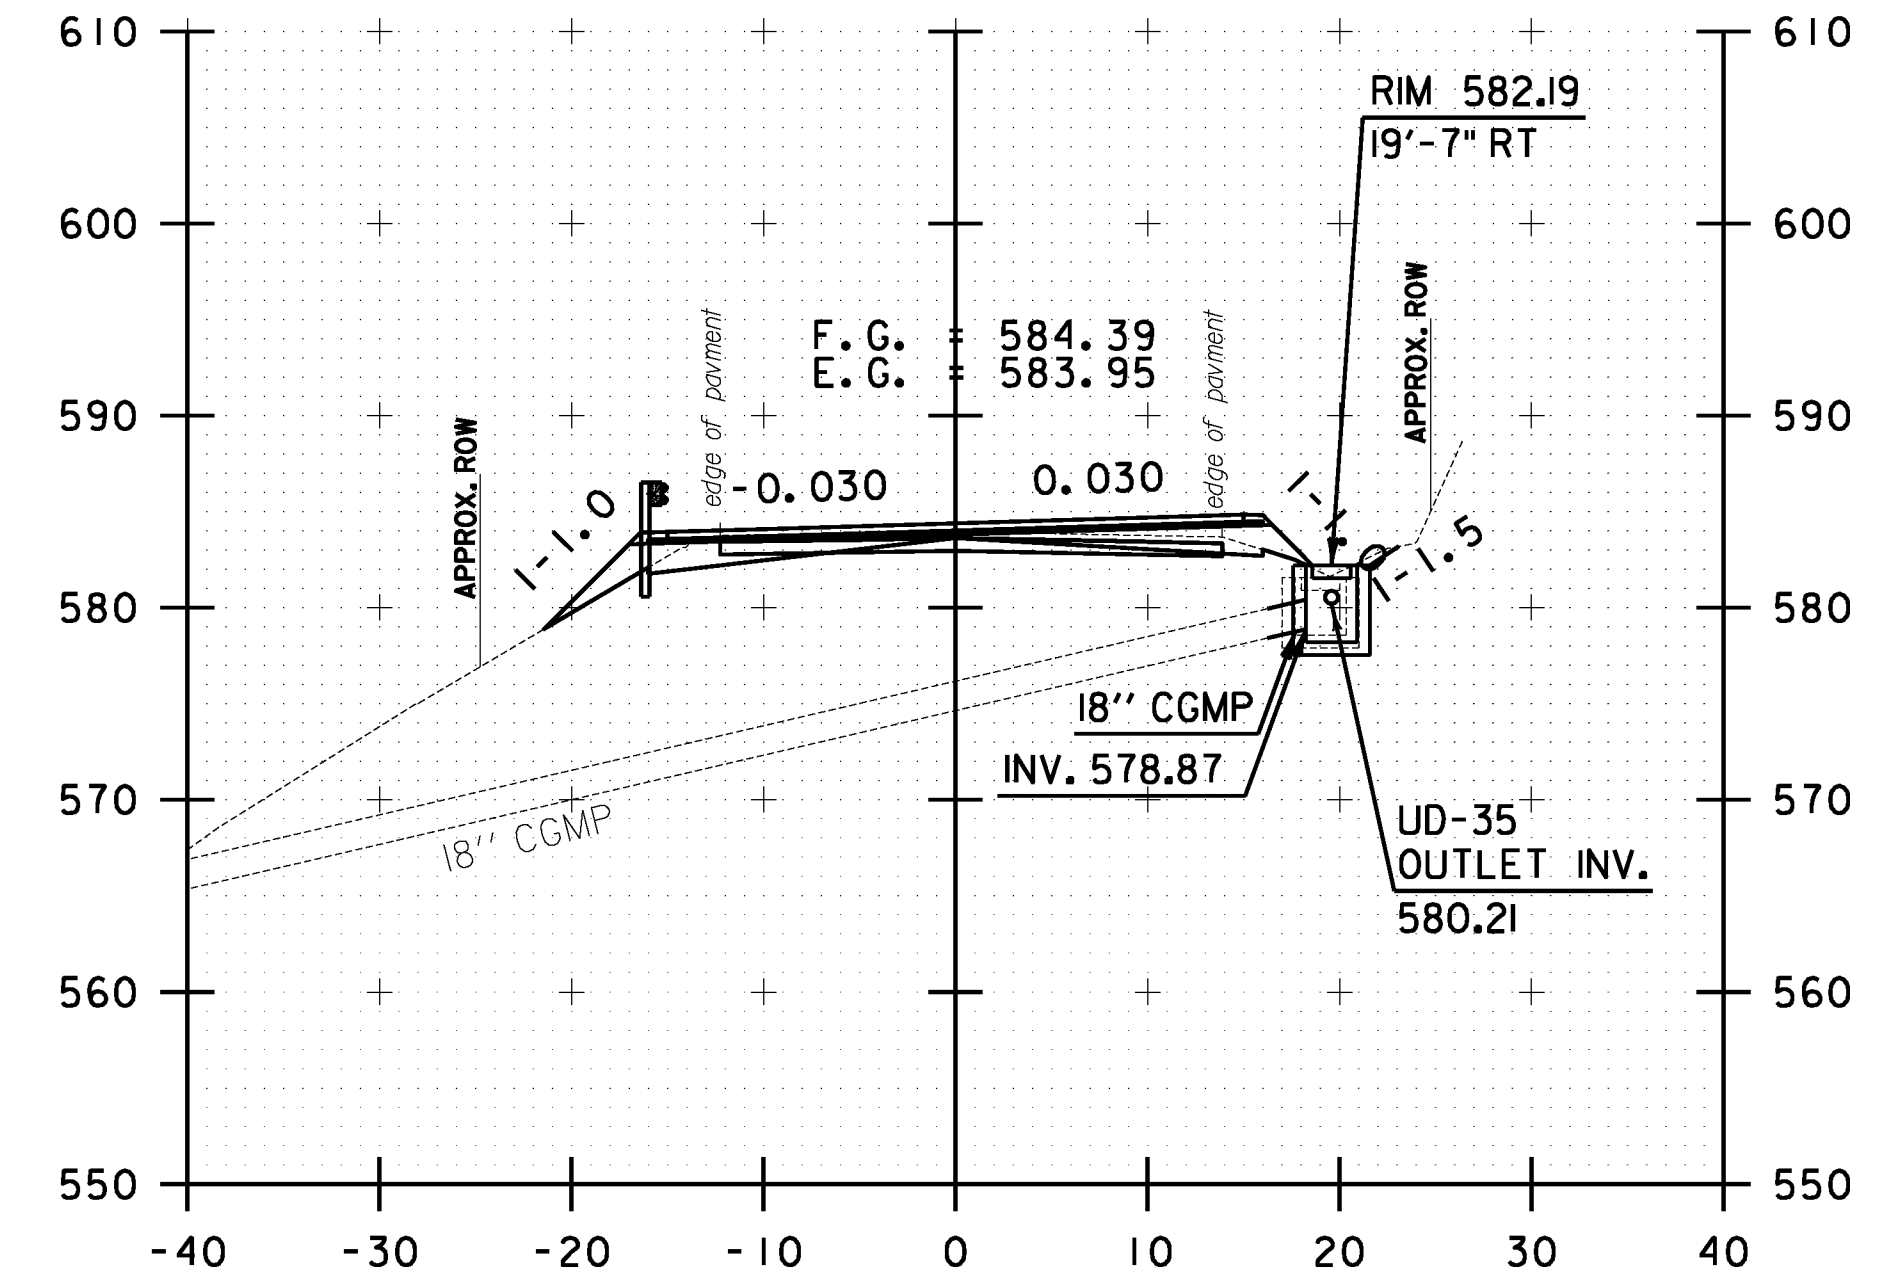

B 133+20.60



BETHEL CROSS SECTION SHEET #43	PROJECT NAME: STOCKBRIDGE-BETHEL
	PROJECT NUMBER: STP 2910(I)
	FILE NAME: z10b214.bethel.xc.dgn
	IPARM FILE: z10b214xs155.1
	PLOT DATE: 3/17/2014
	DRAWN BY: W.G.P.
	CHECKED BY: J.P.S.
	SHEET 368 OF 397