




FILE NAME = Y:\P\c\res\any\k2\22425\CADD\MSTN\10b214.bethel.xc.dgn
 DATE/TIME = 3/17/2014
 USER = 4916

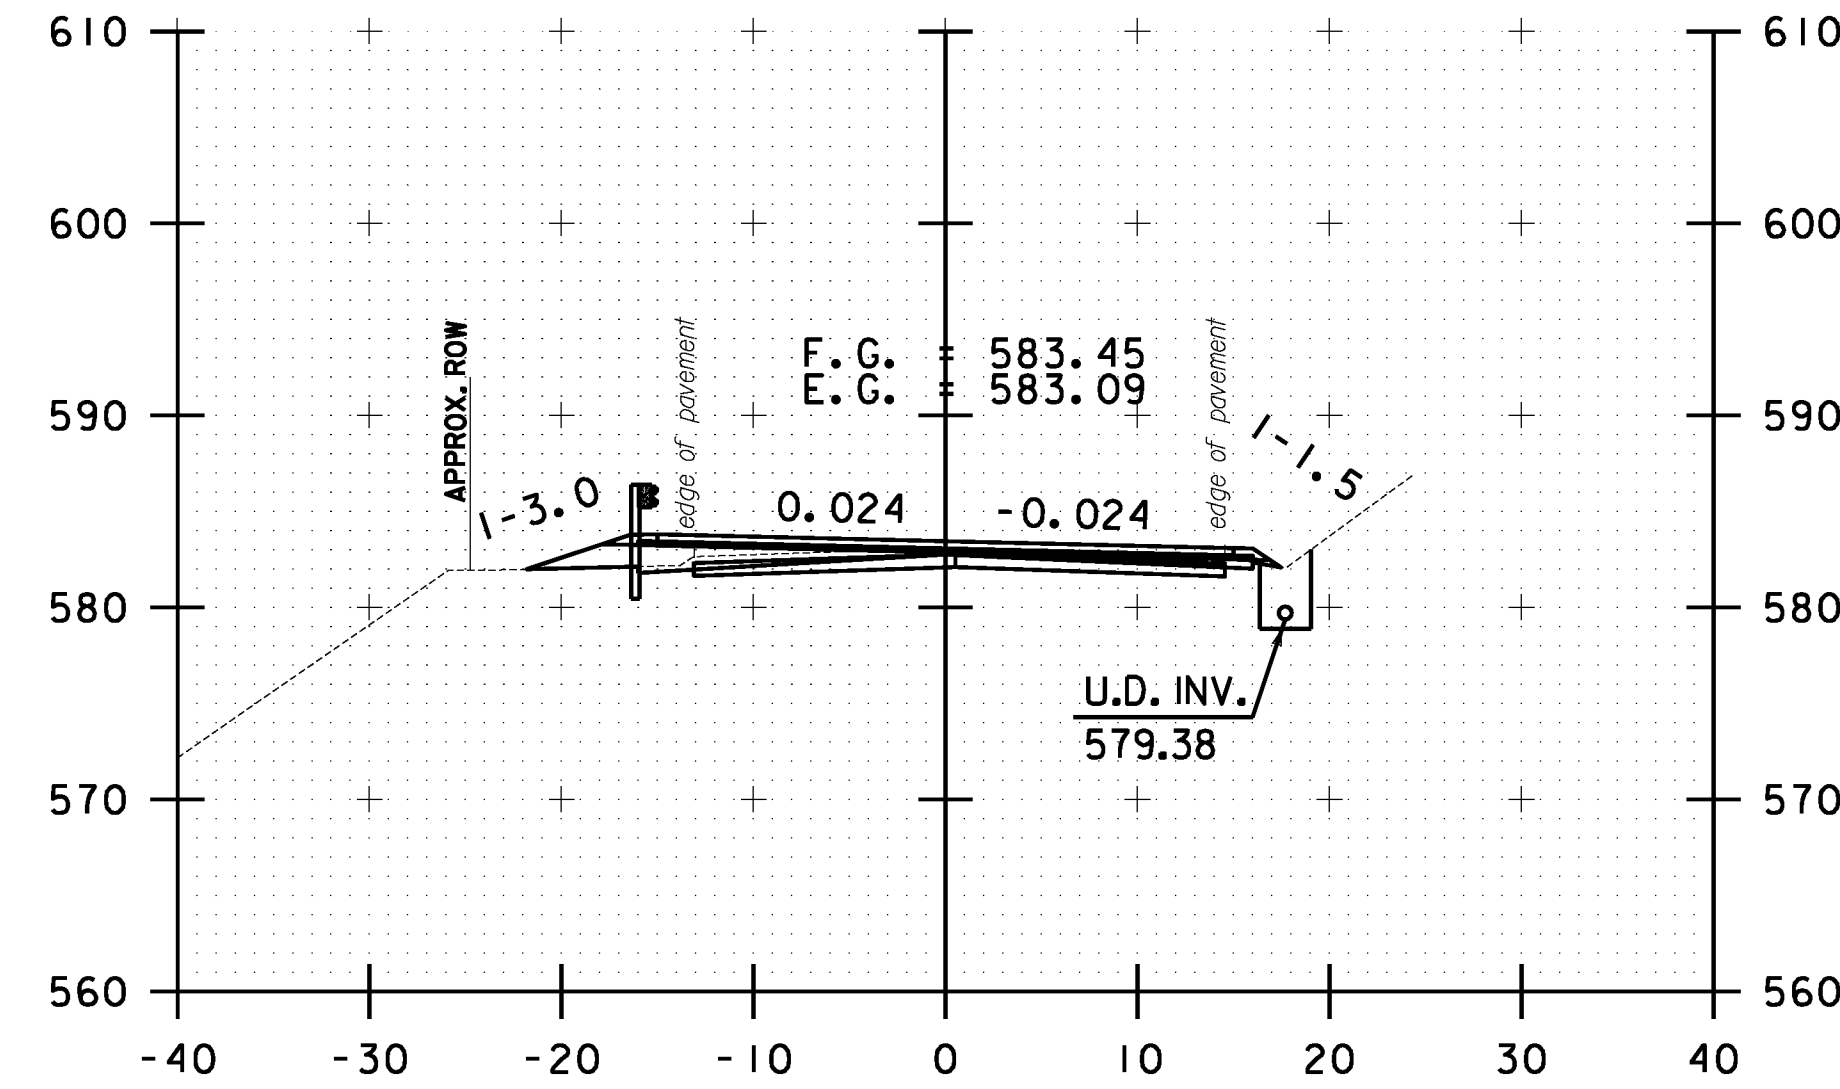


B 134+50.00

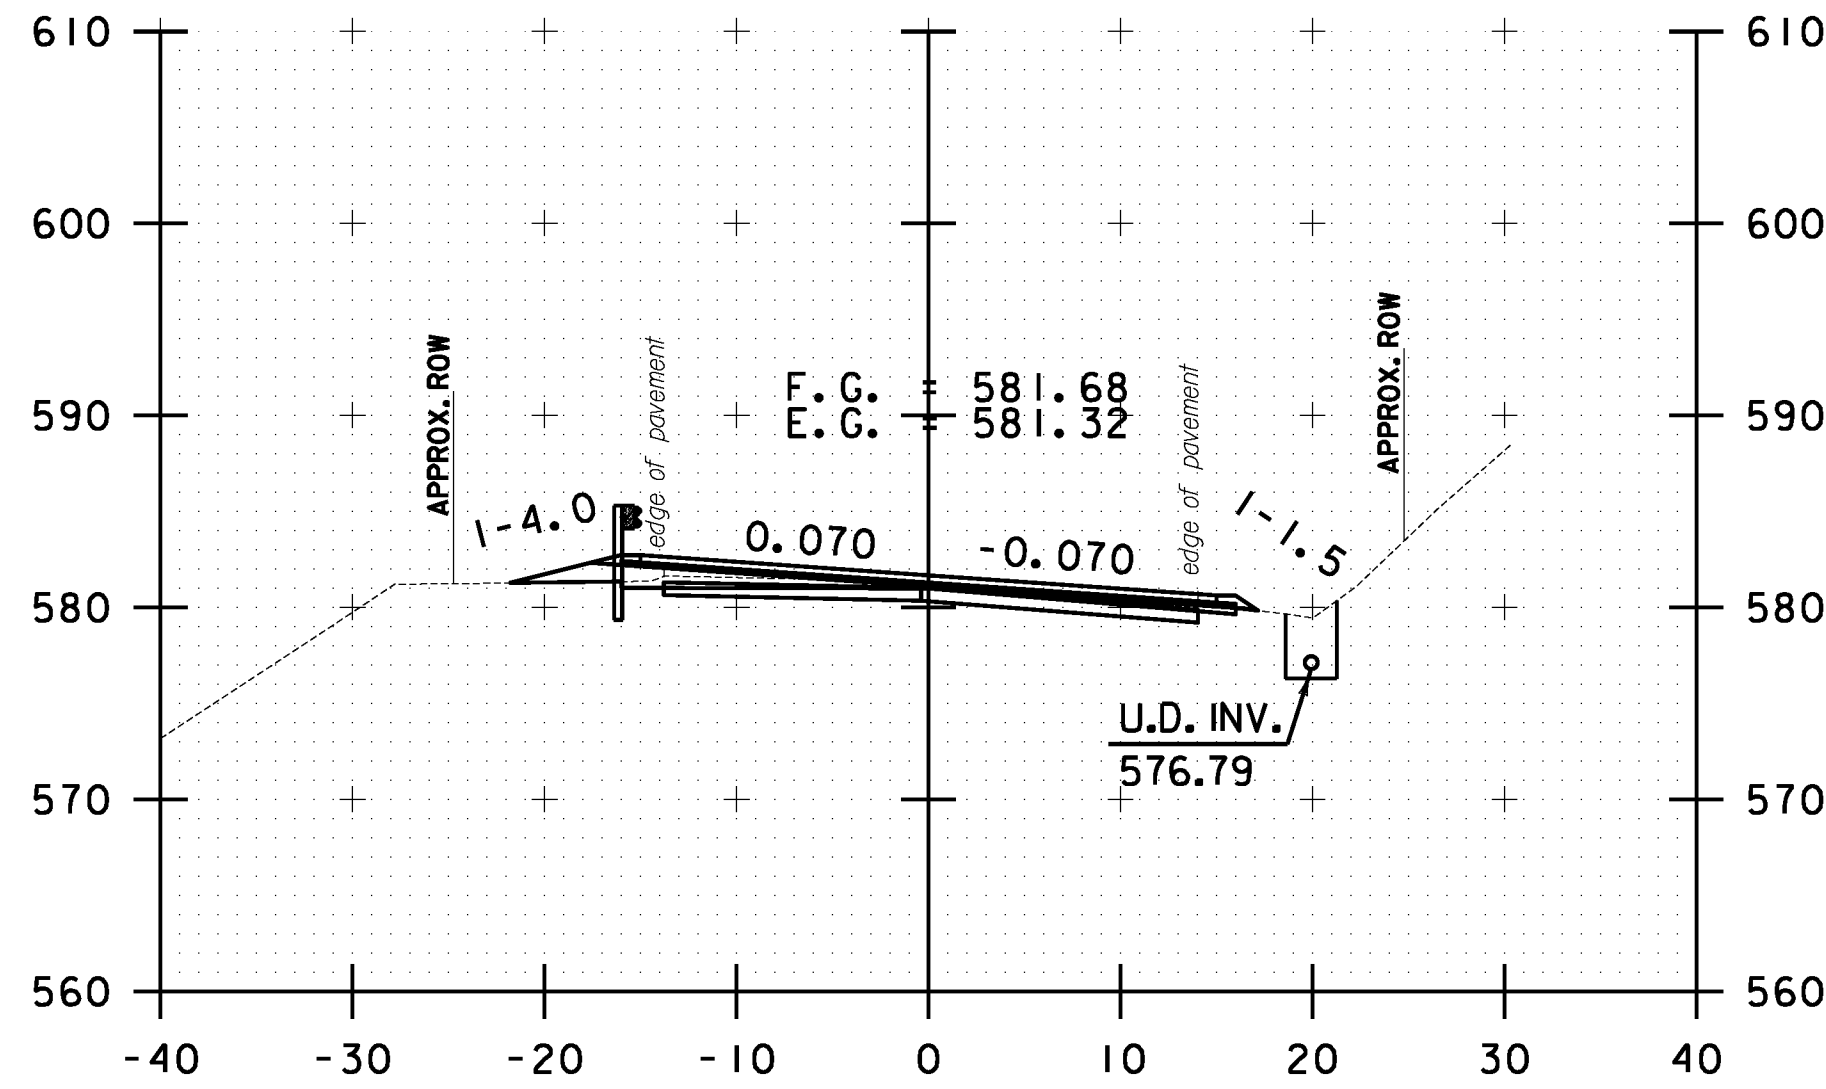


B 135+50.00

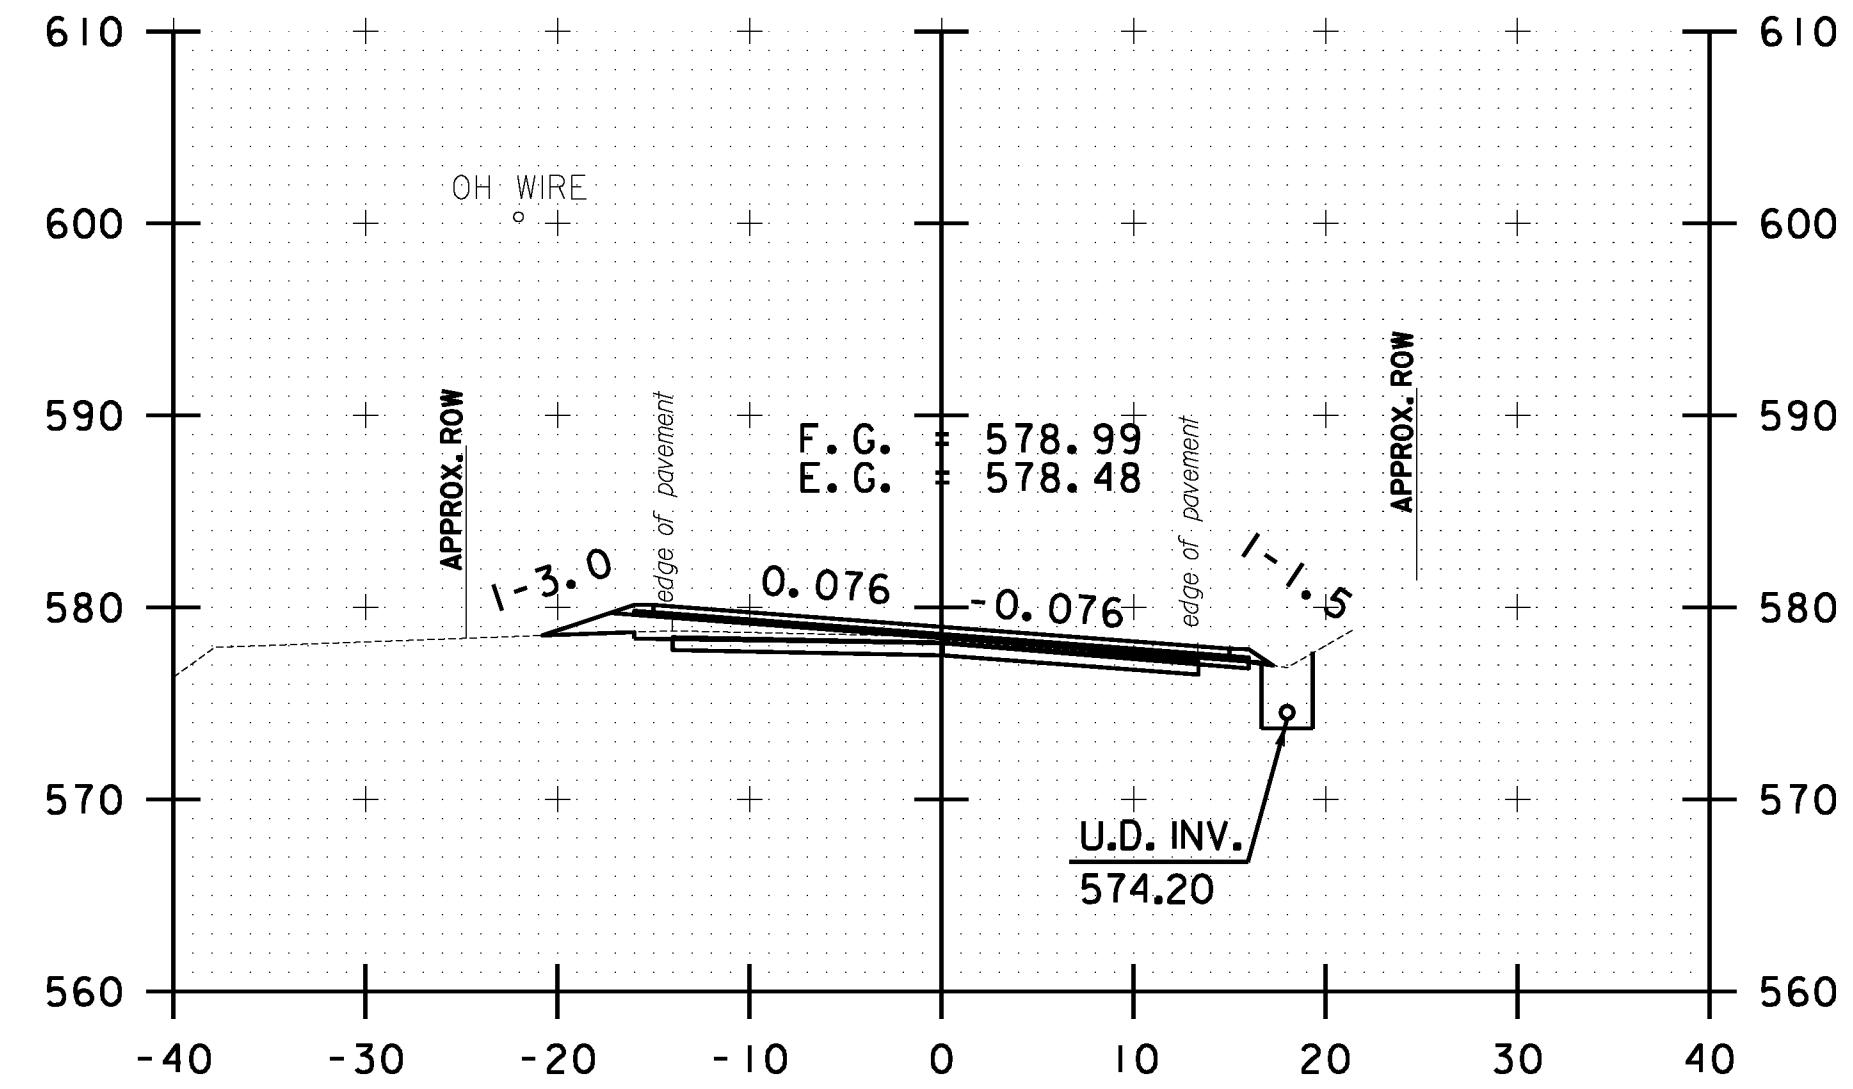


B 136+50.00

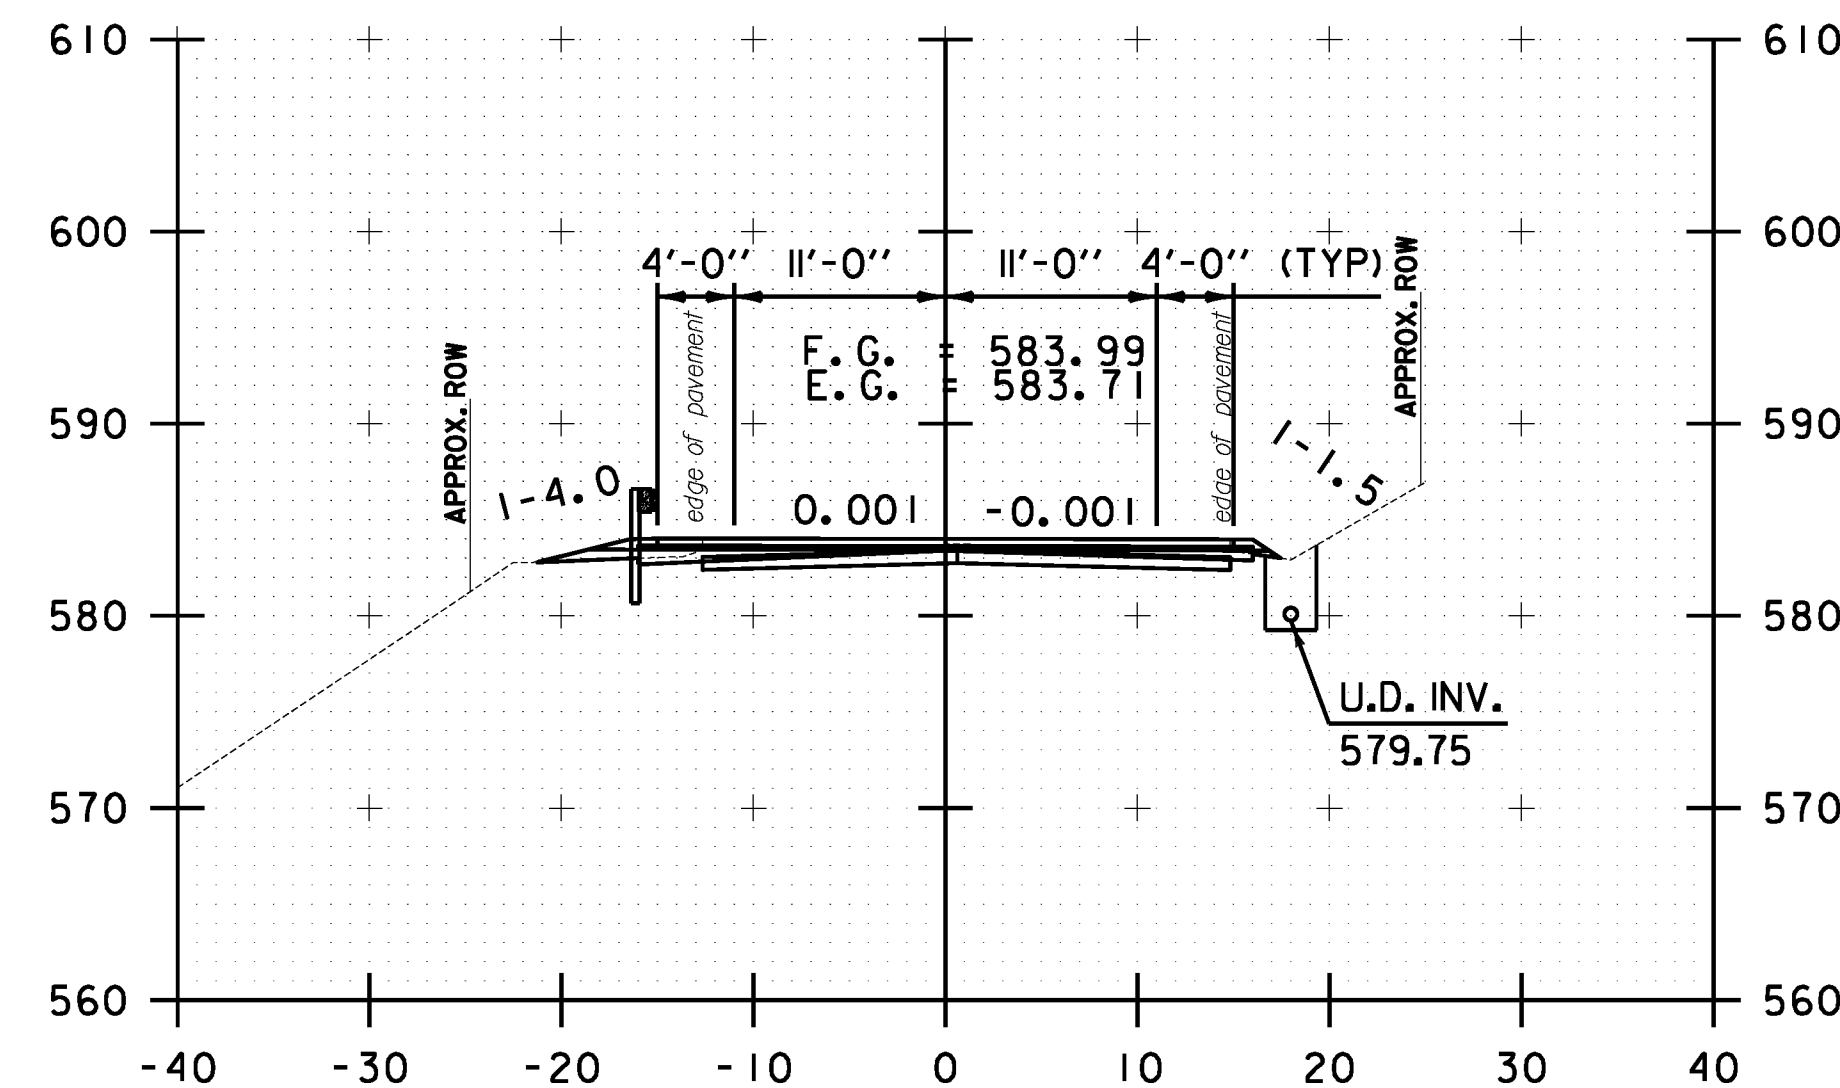

B 134+00.00

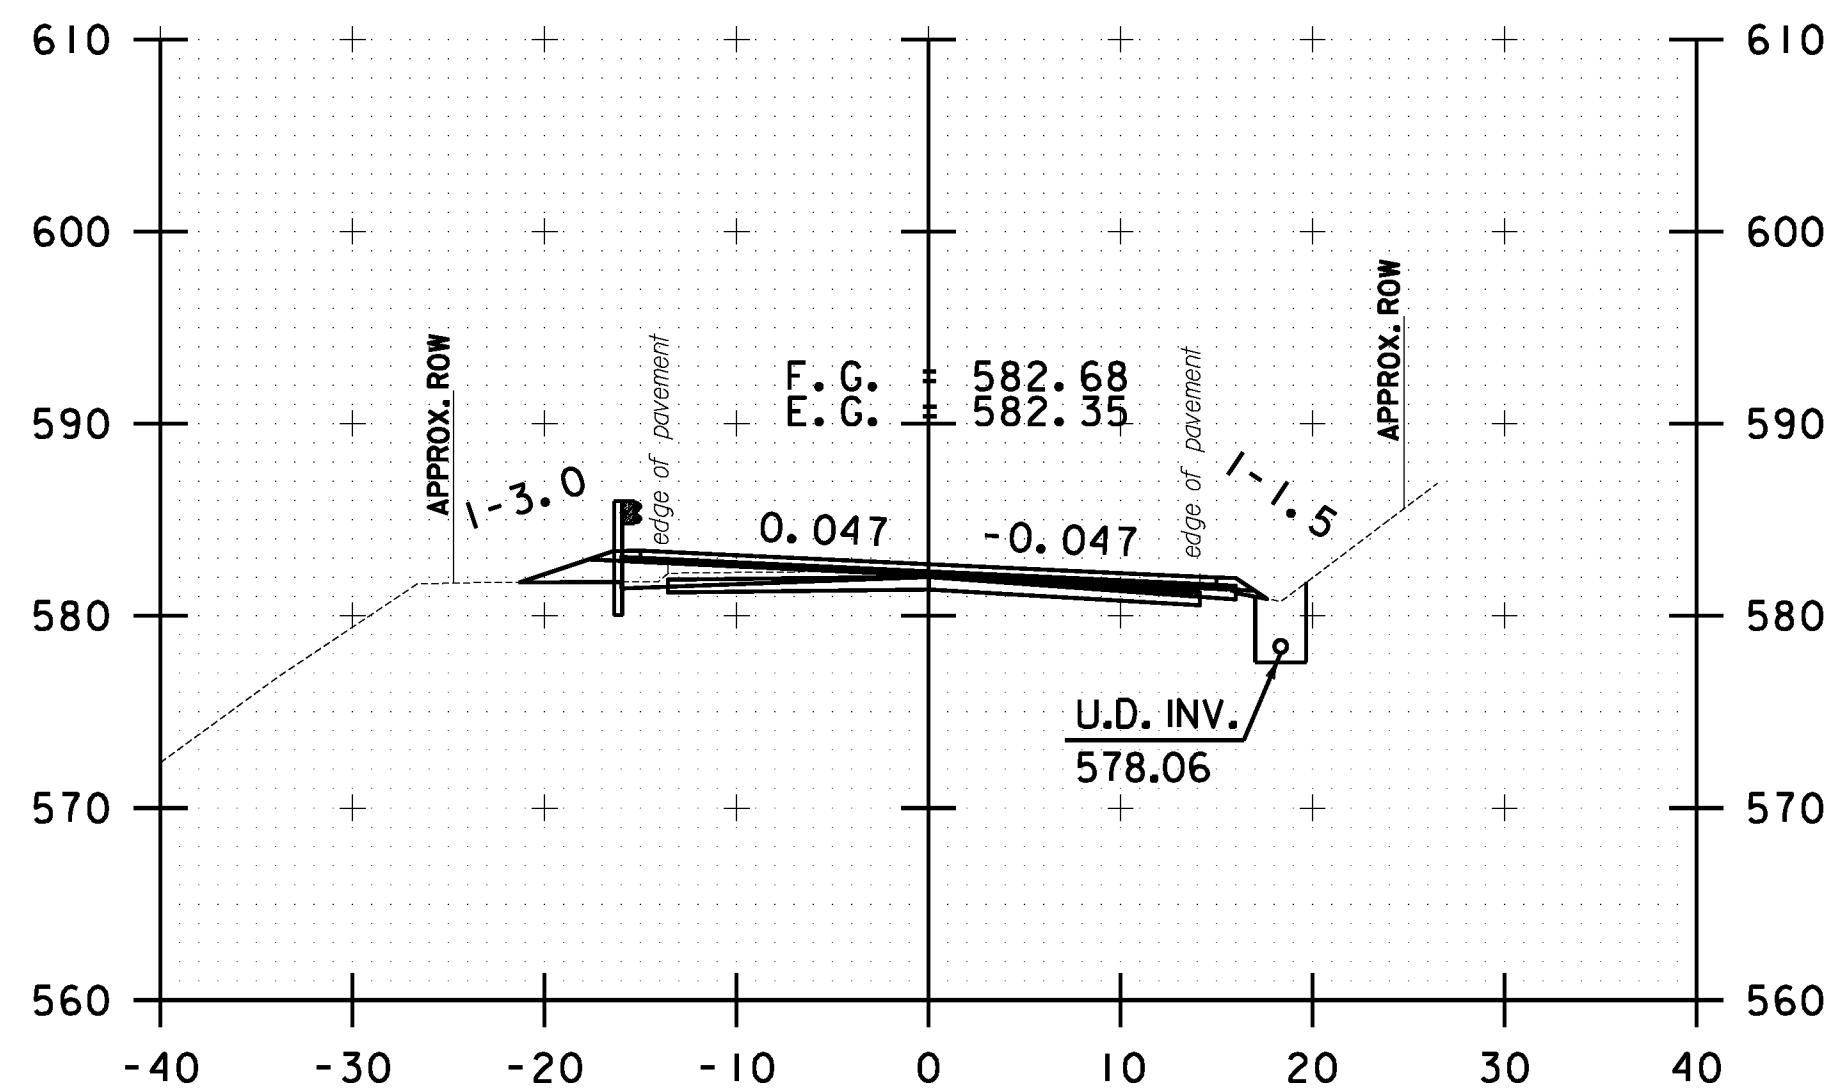

B 135+00.00

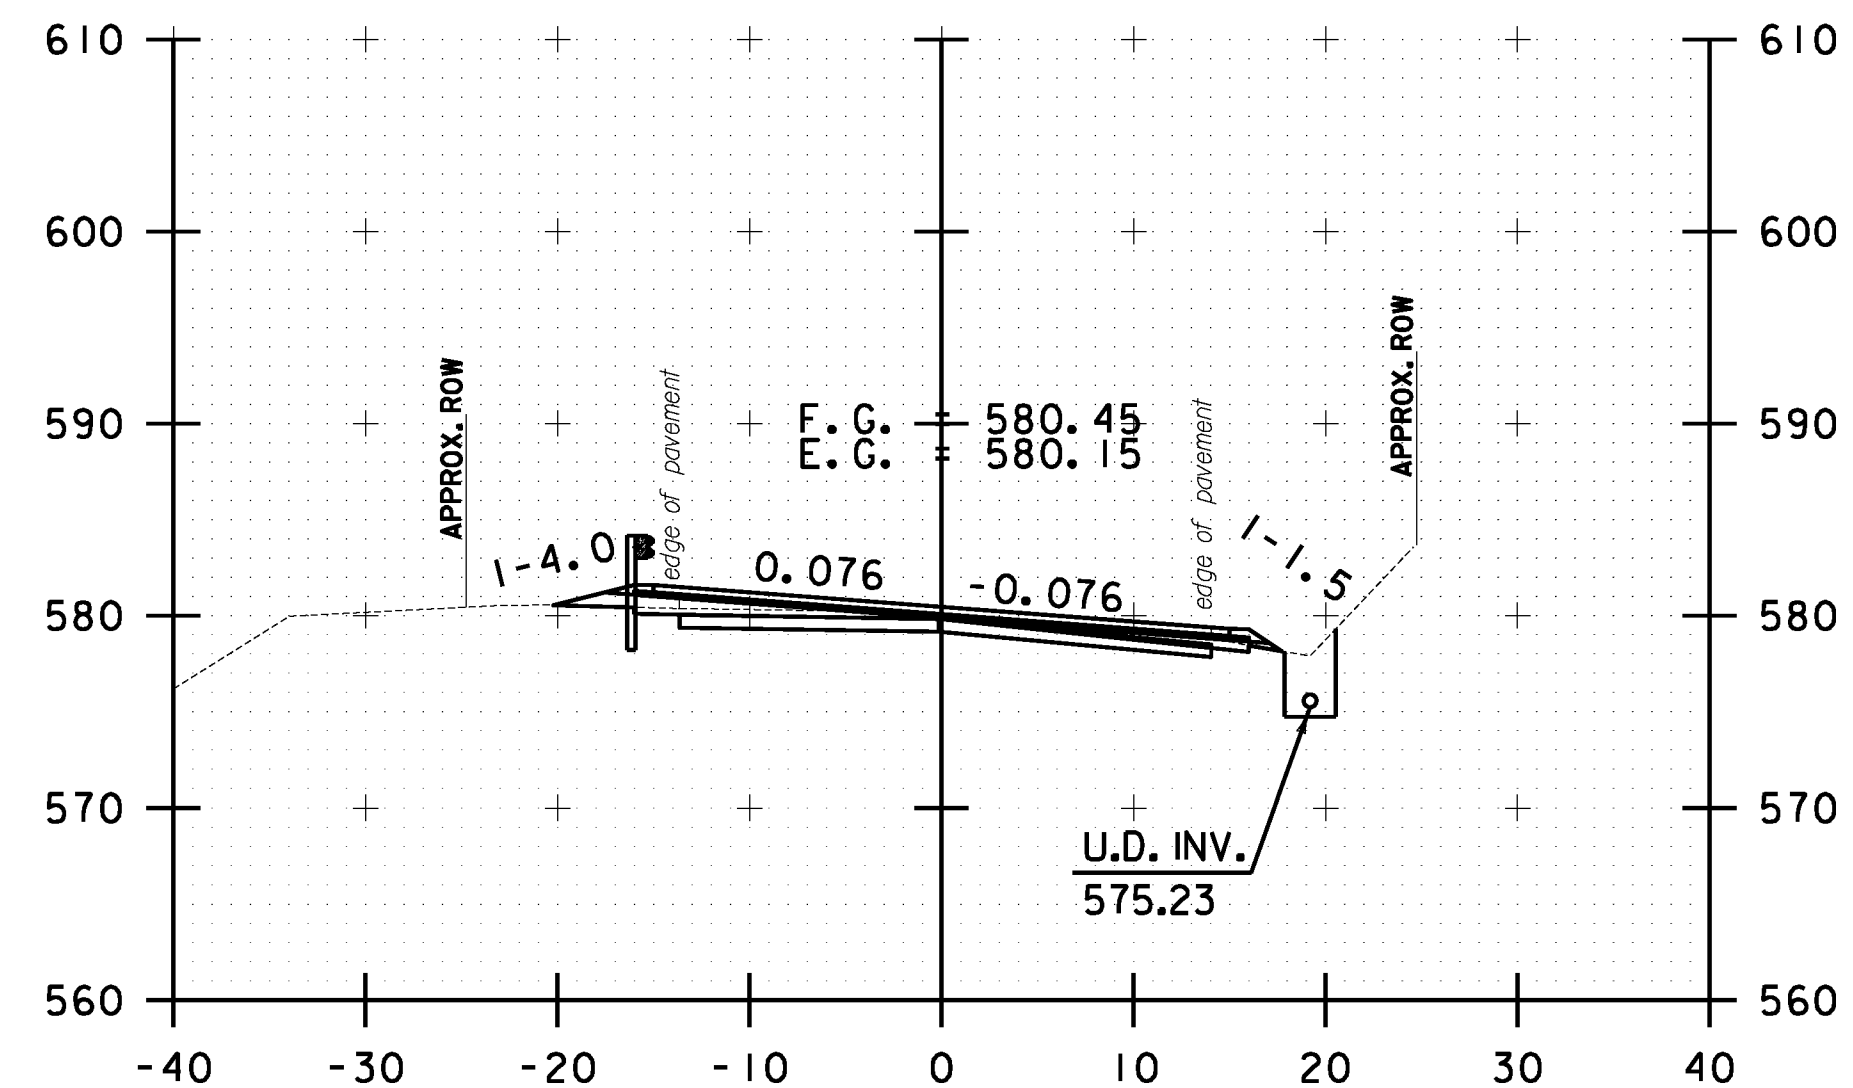

B 136+00.00



| | |
|---|----------------------------------|
| BETHEL CROSS SECTION SHEET #44 | PROJECT NAME: STOCKBRIDGE-BETHEL |
| | PROJECT NUMBER: STP 2910(1) |
| | FILE NAME: z10b214.bethel.xc.dgn |
| | IPARM FILE: z10b214.xs156.1 |
| | PLOT DATE: 3/17/2014 |
| | DRAWN BY: W.G.P. |
| | CHECKED BY: J.P.S. |
| | SHEET 369 OF 397 |