




FILE NAME = Y:\P\c\g\ss\ANY\K2\22425\CAOD\...MSTN\10b214\_bethel.xc.dgn  
 DATE/TIME = 3/17/2014  
 USER = 4916

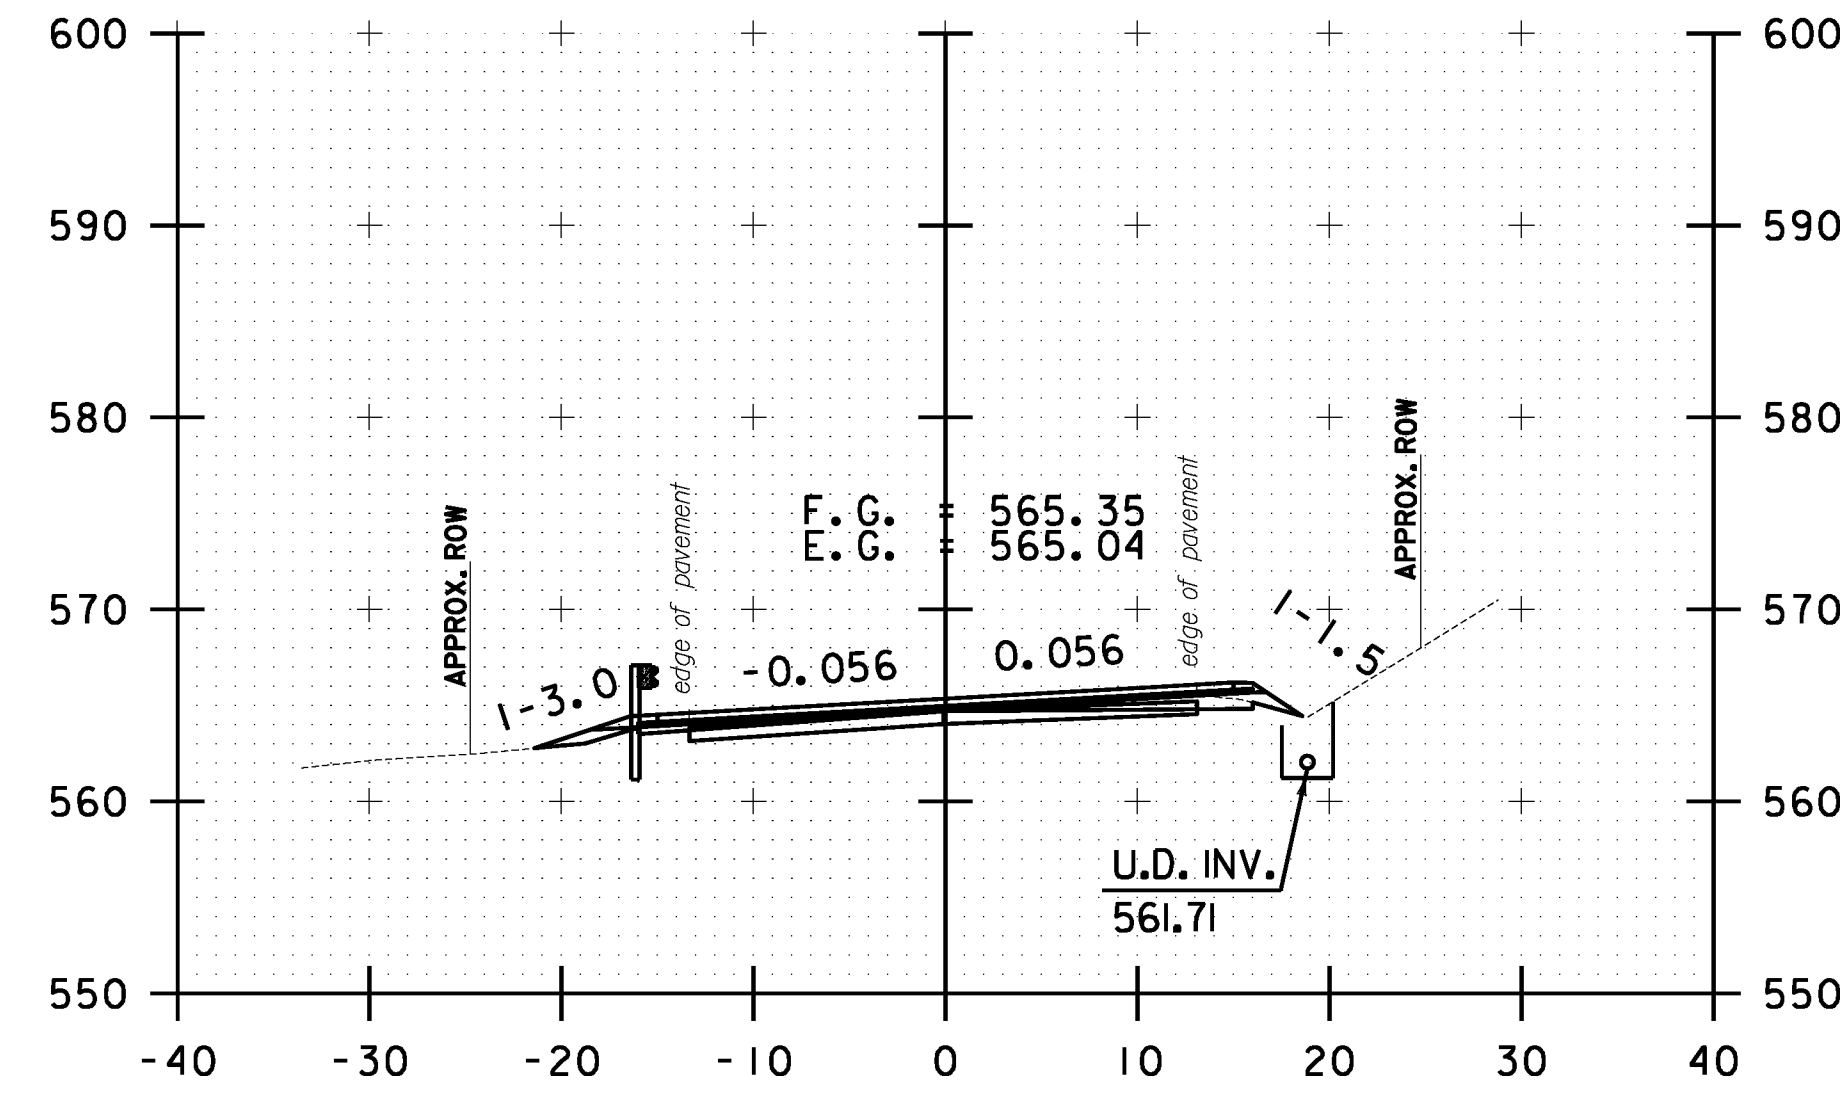


B 140+50.00

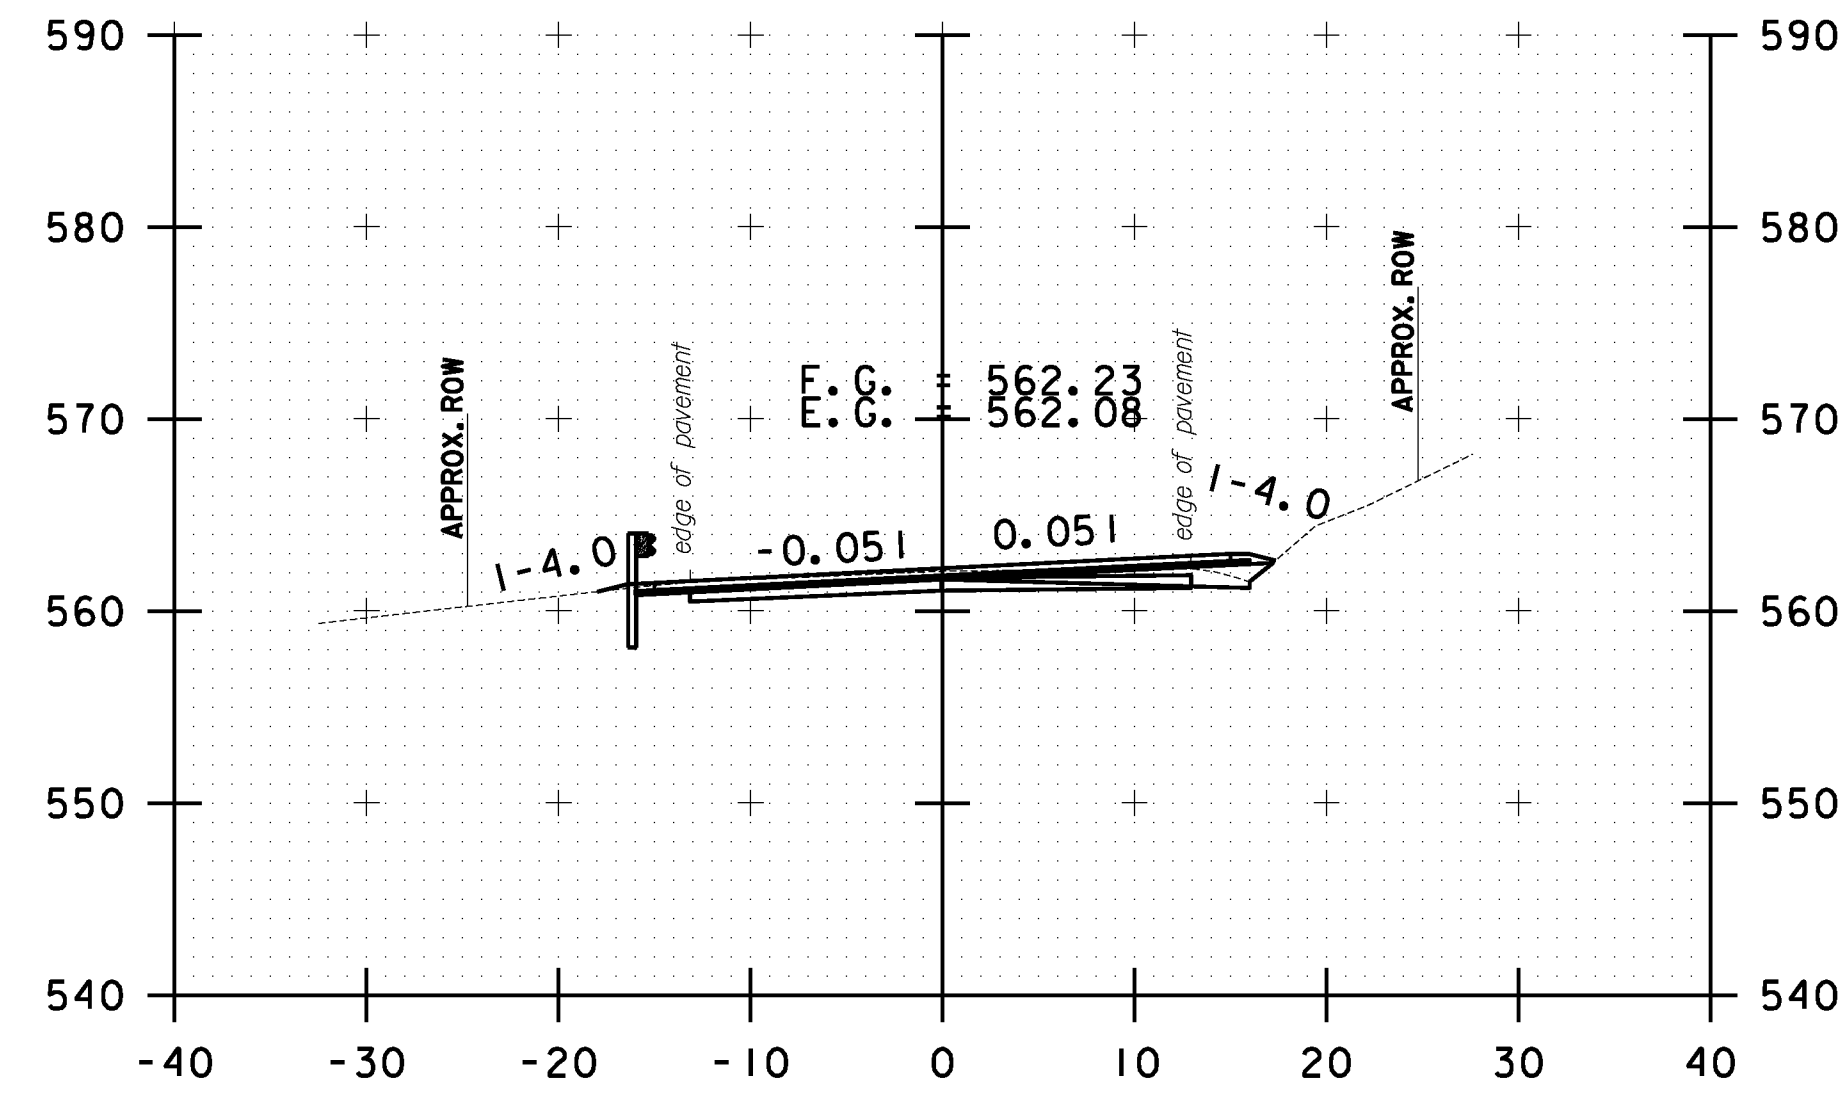


B 141+50.00

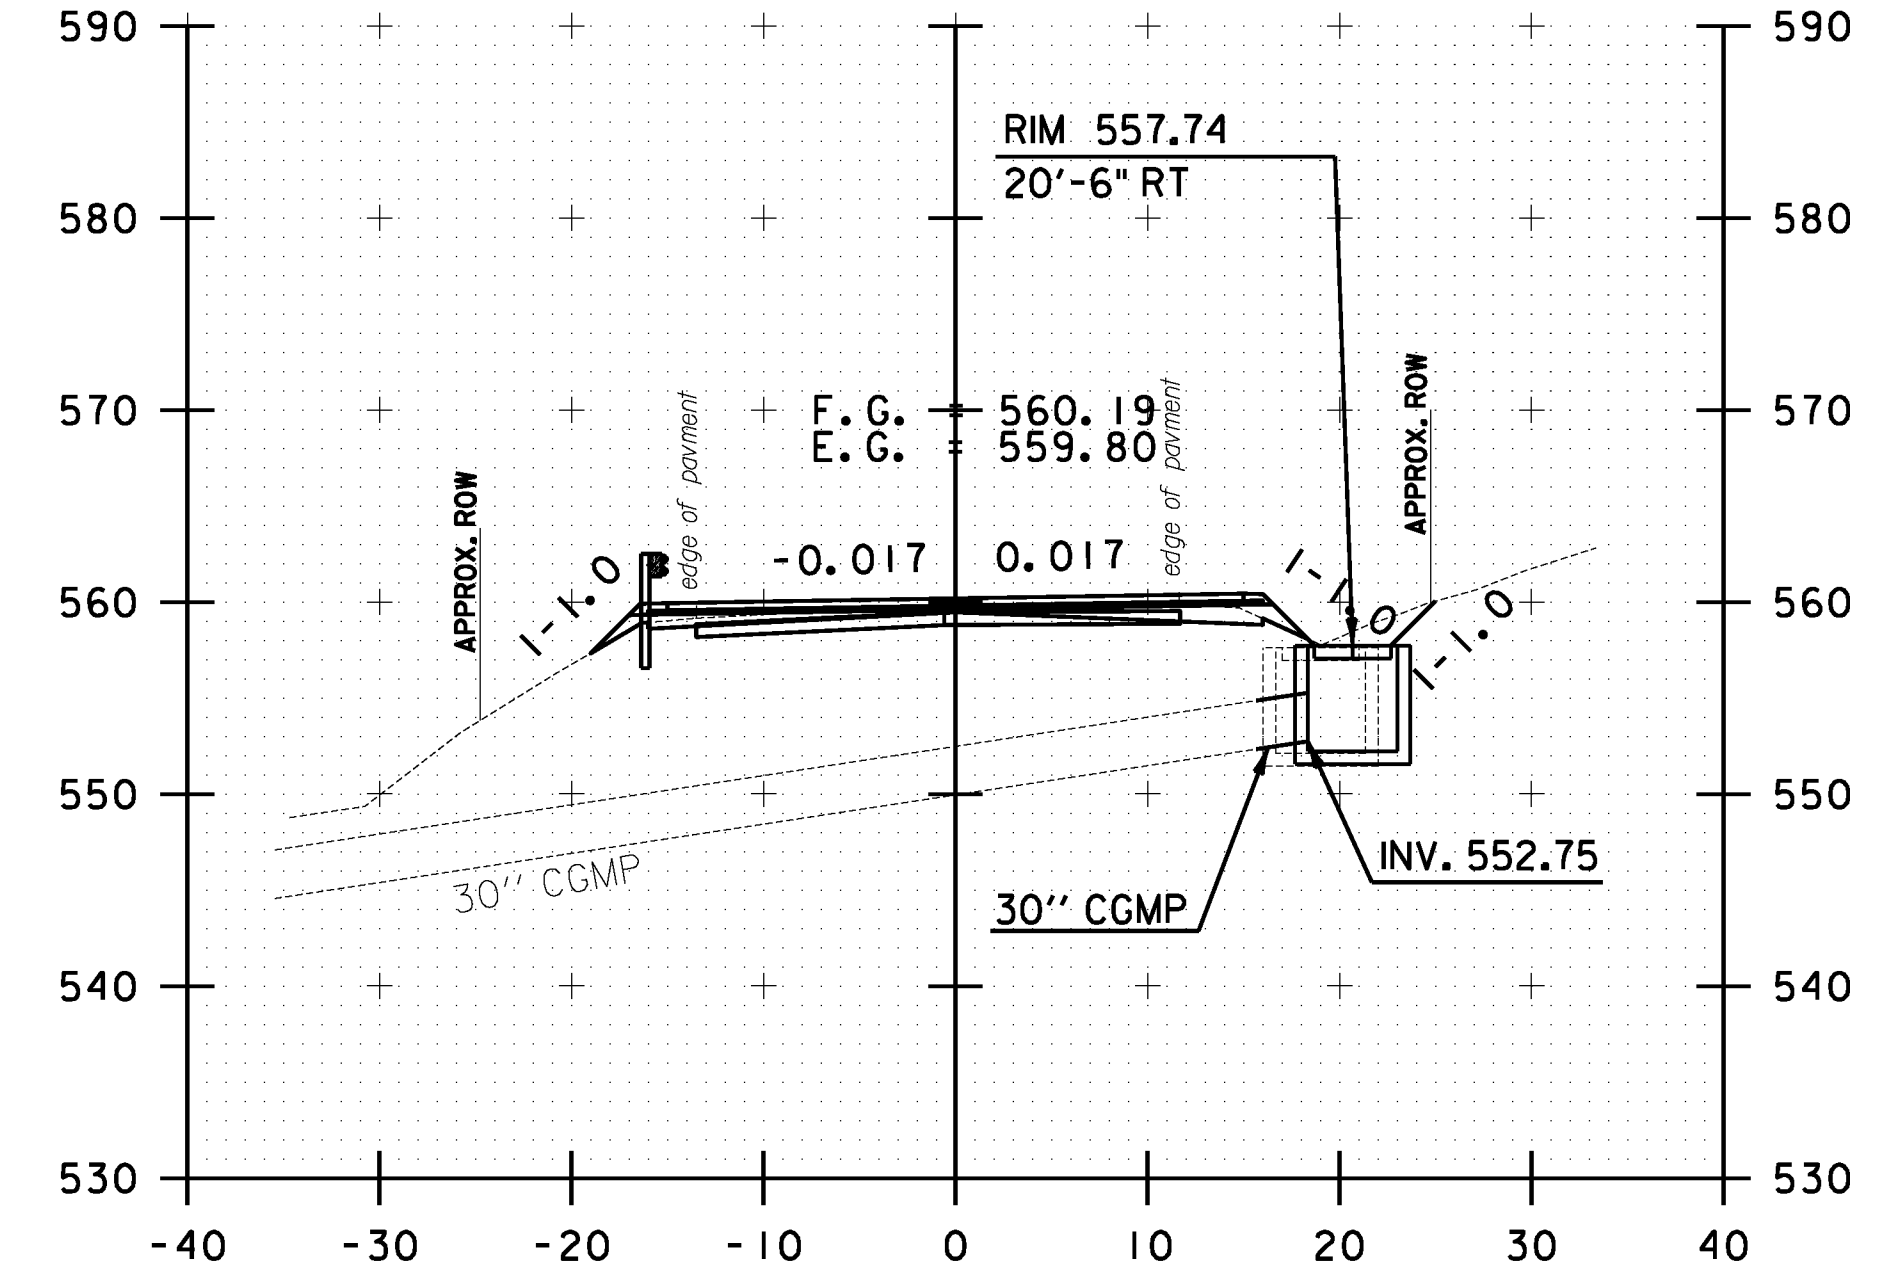


B 142+25.00

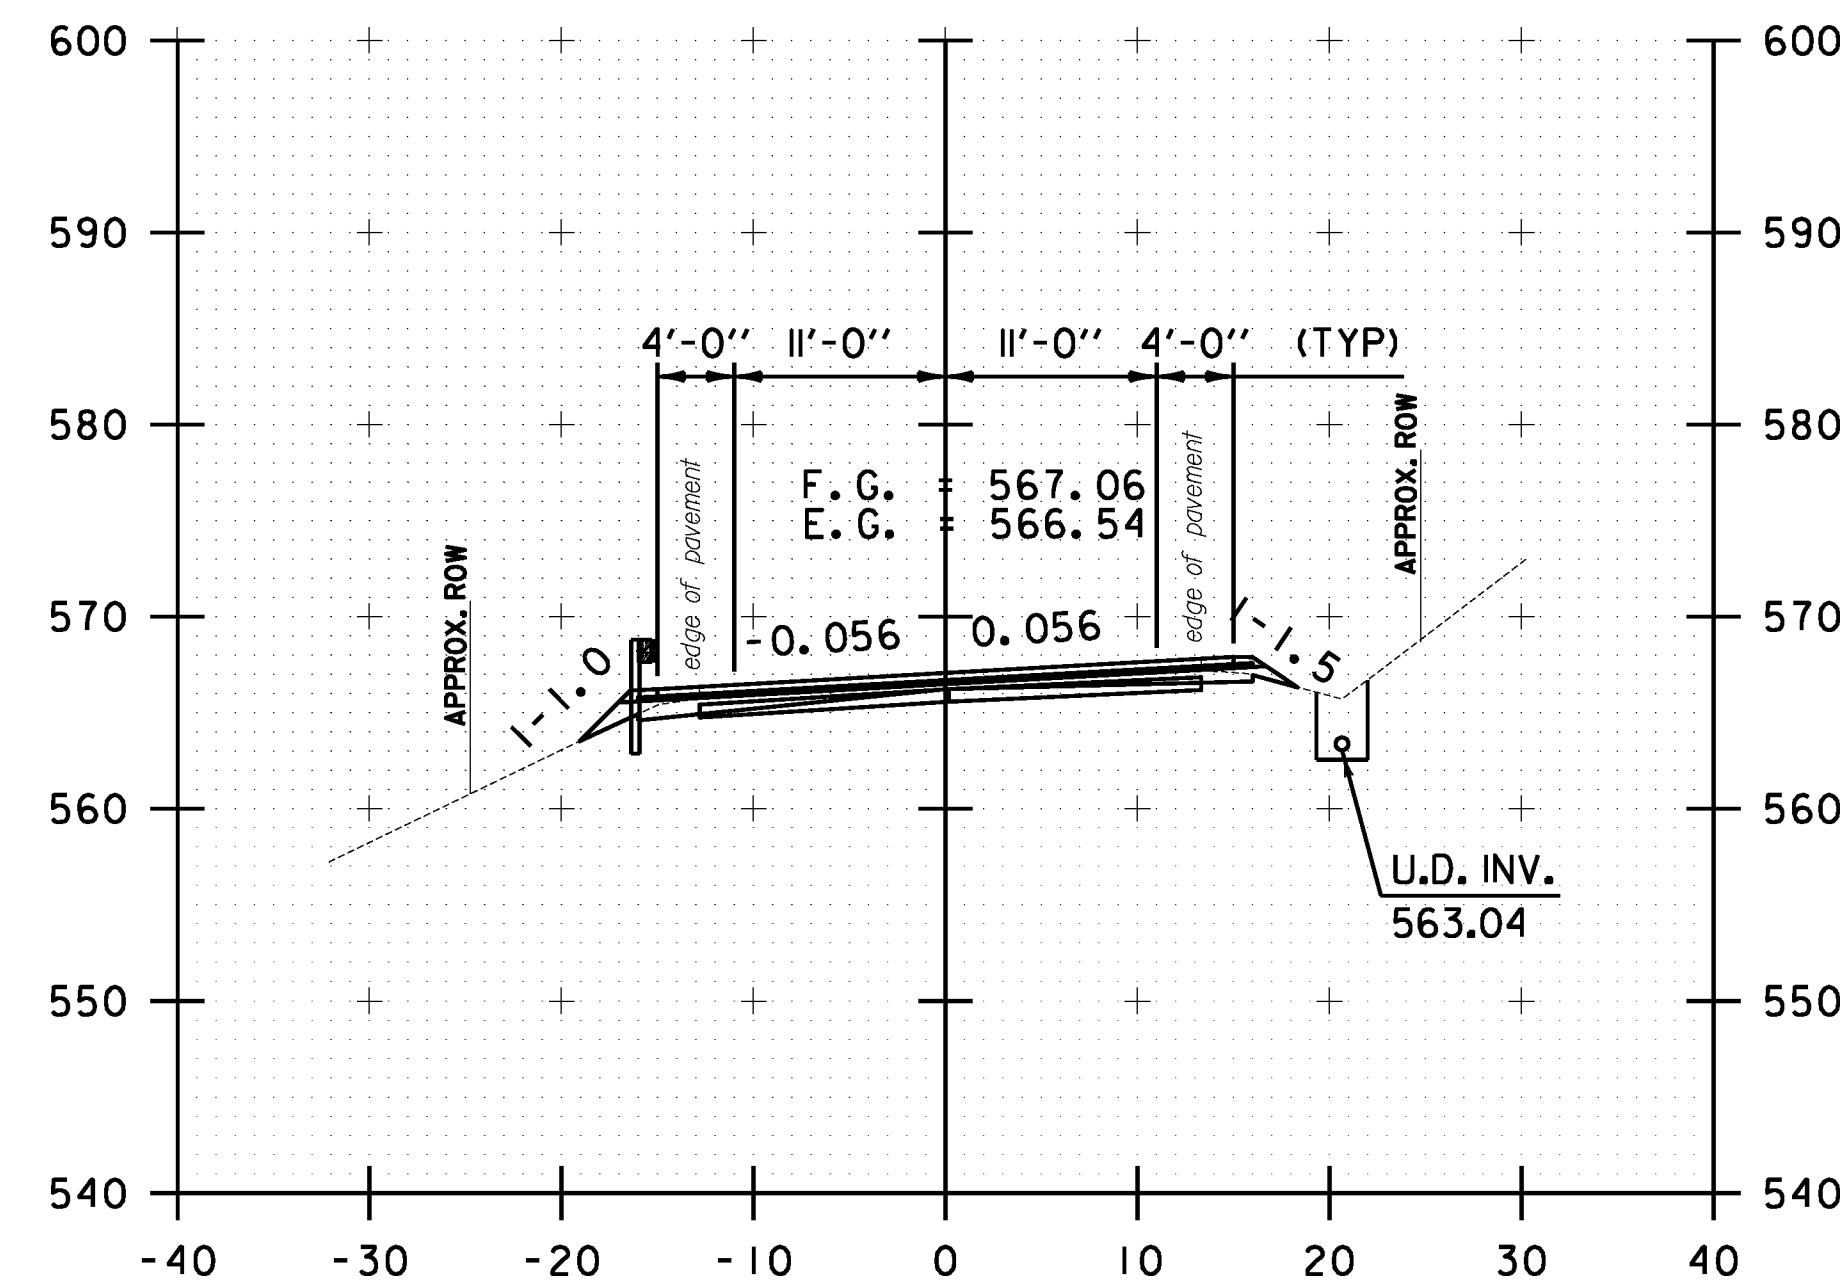

B 140+00.00

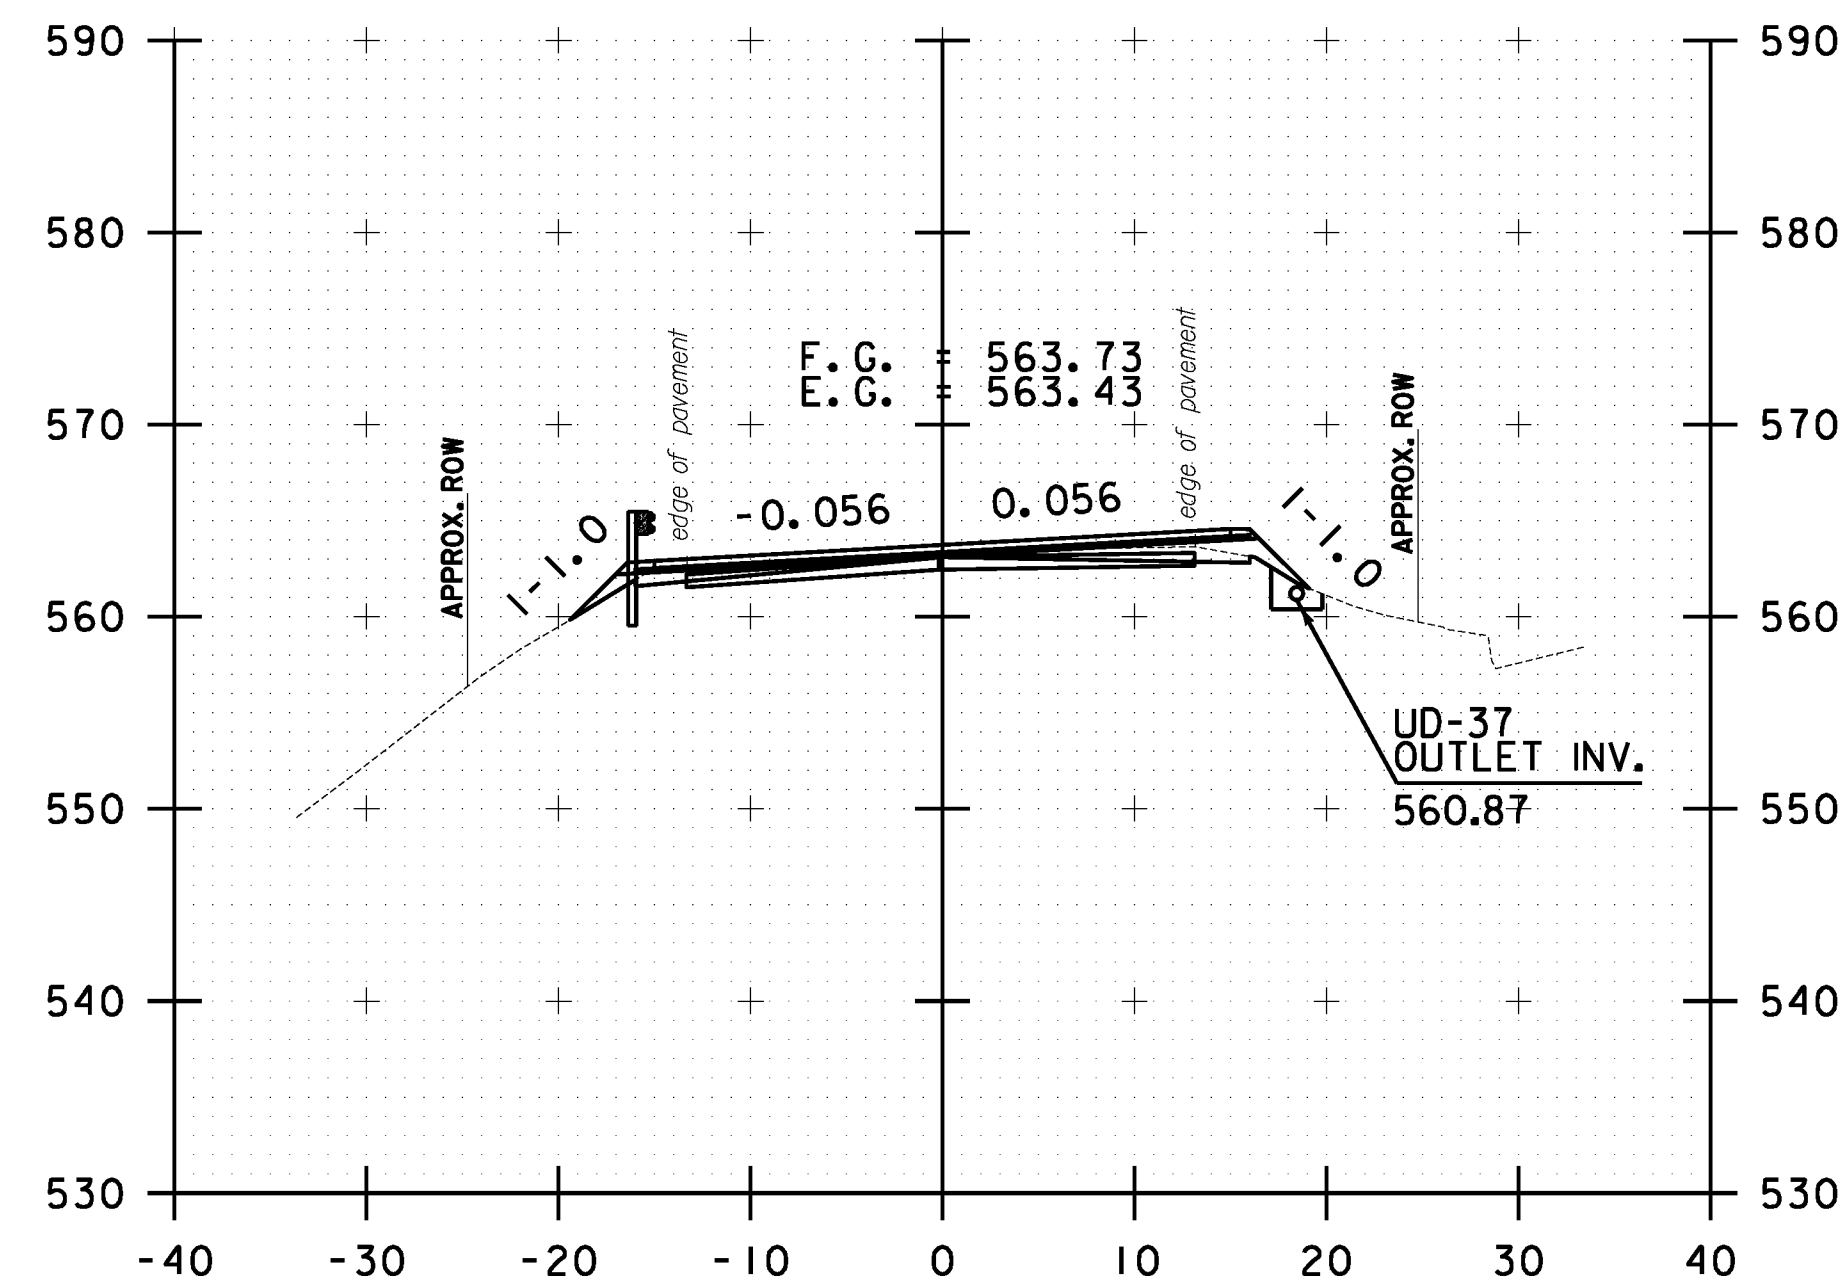

B 141+00.00

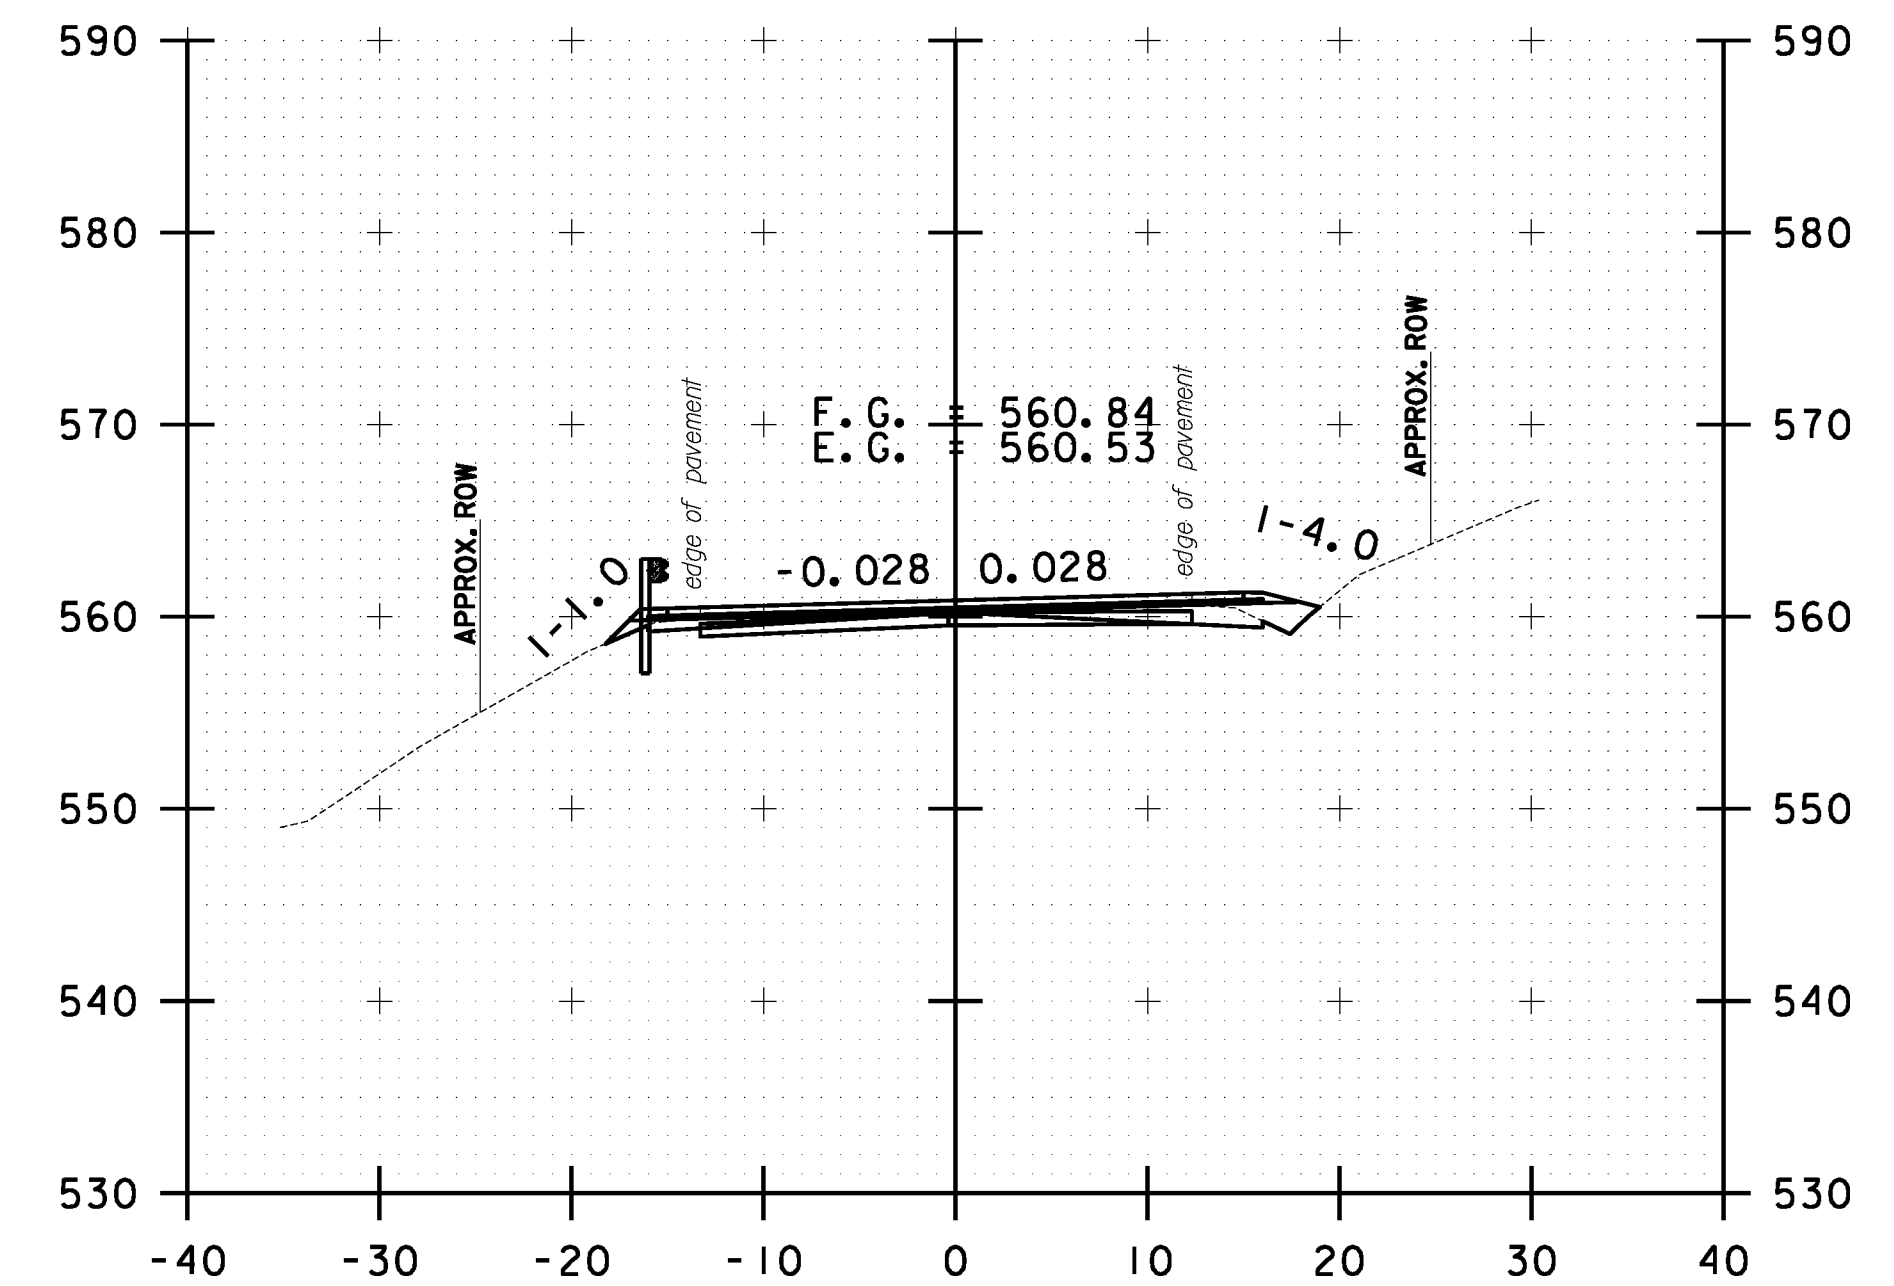

B 142+00.00



<b>BETHEL CROSS SECTION SHEET #46</b>	PROJECT NAME: STOCKBRIDGE-BETHEL
	PROJECT NUMBER: STP 2910(1)
	FILE NAME: z10b214.bethel.xc.dgn
	IPARM FILE: z10b214.xs158.1
	PLOT DATE: 3/17/2014
	DRAWN BY: W.G.P.
	CHECKED BY: J.P.S.
	SHEET 371 OF 397