




FILE NAME = Y:\P\c\gas\any\k2\22425\CADD\MSTN\10b214.bethel.xc.dgn
 DATE/TIME = 3/17/2014
 USER = 4916

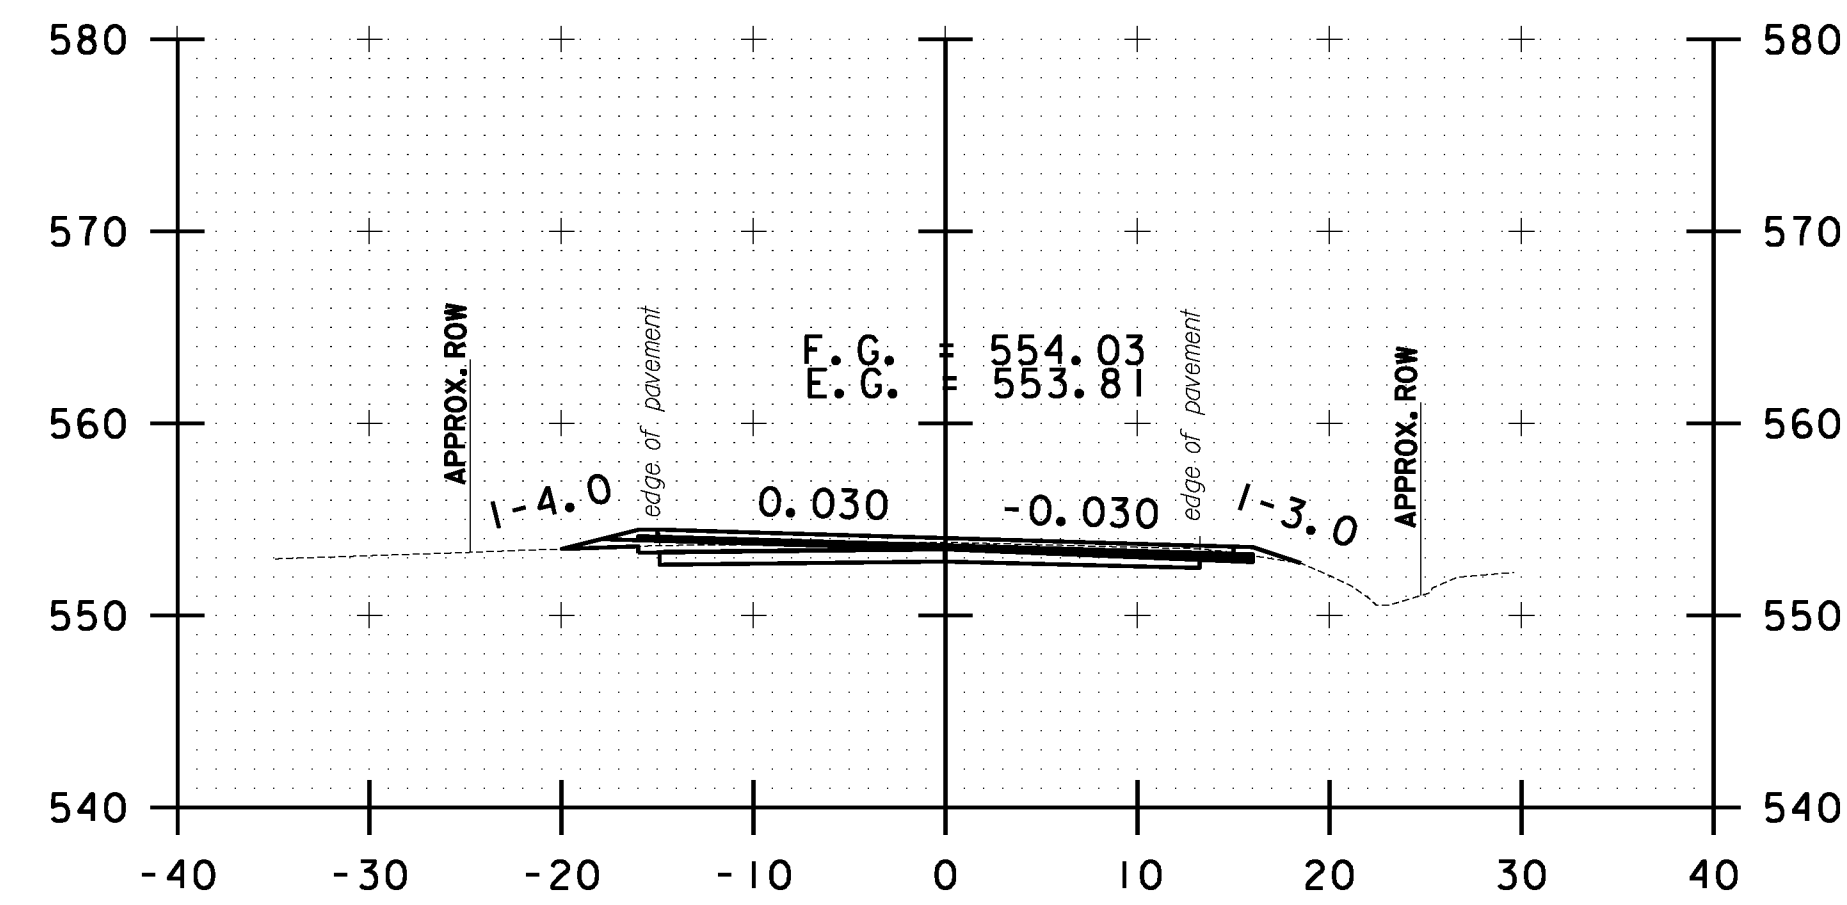


B 146+00.00

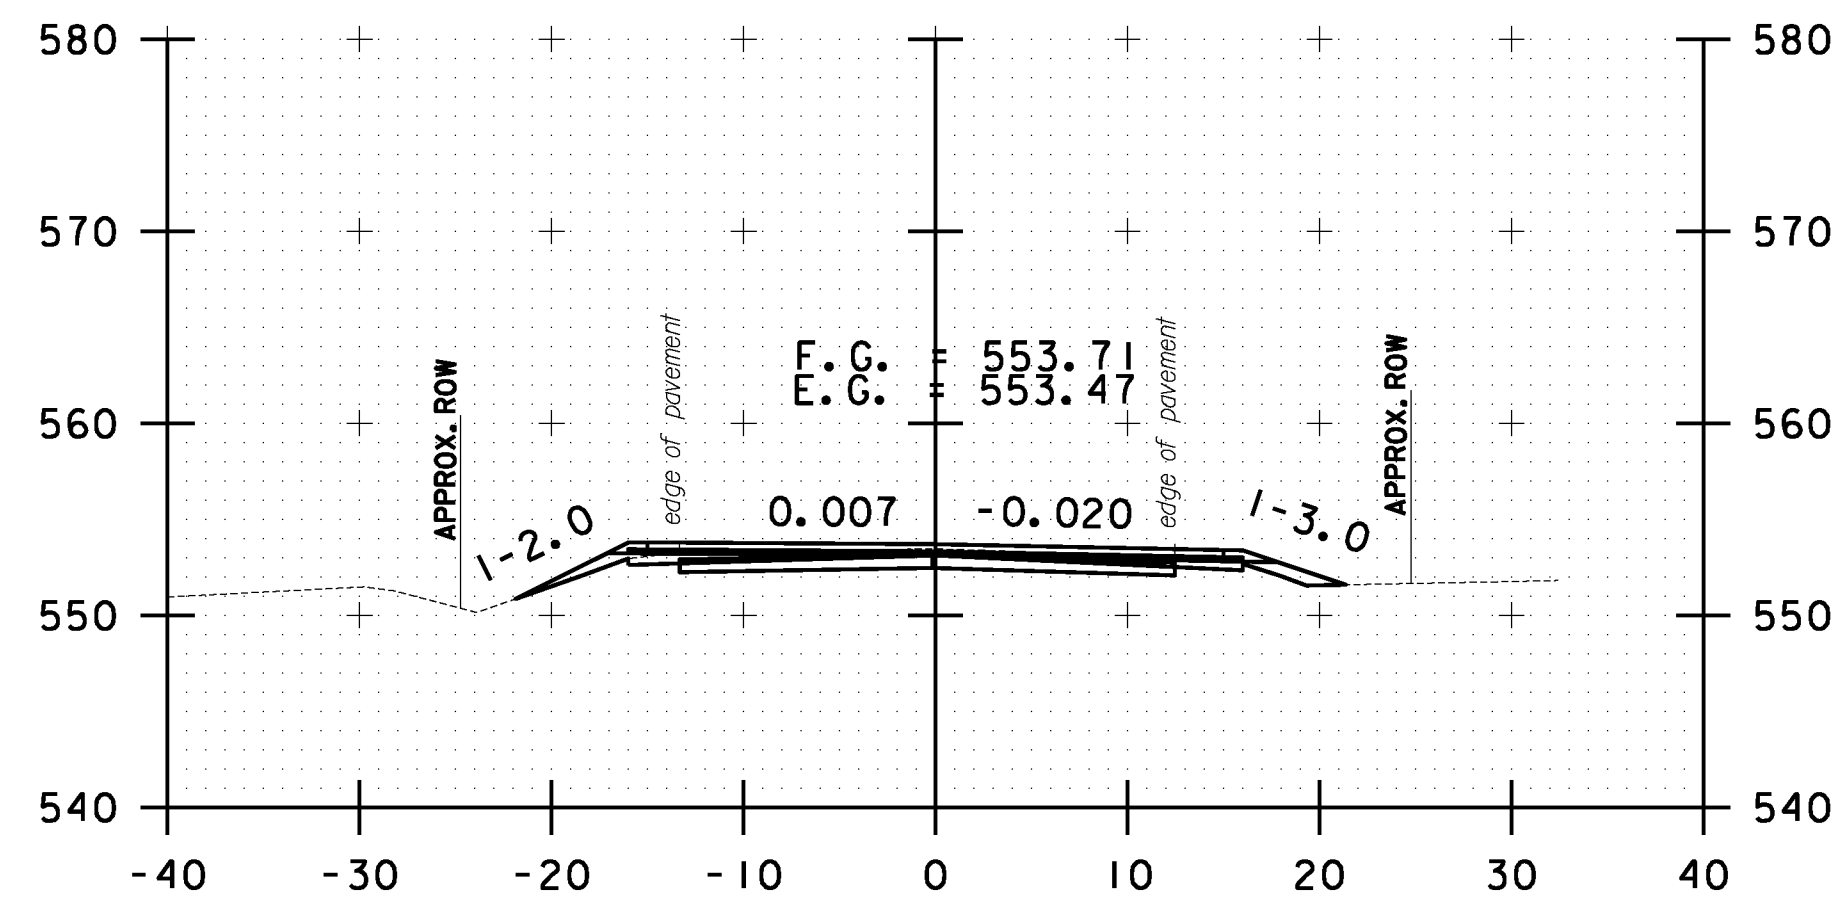


B 146+50.00

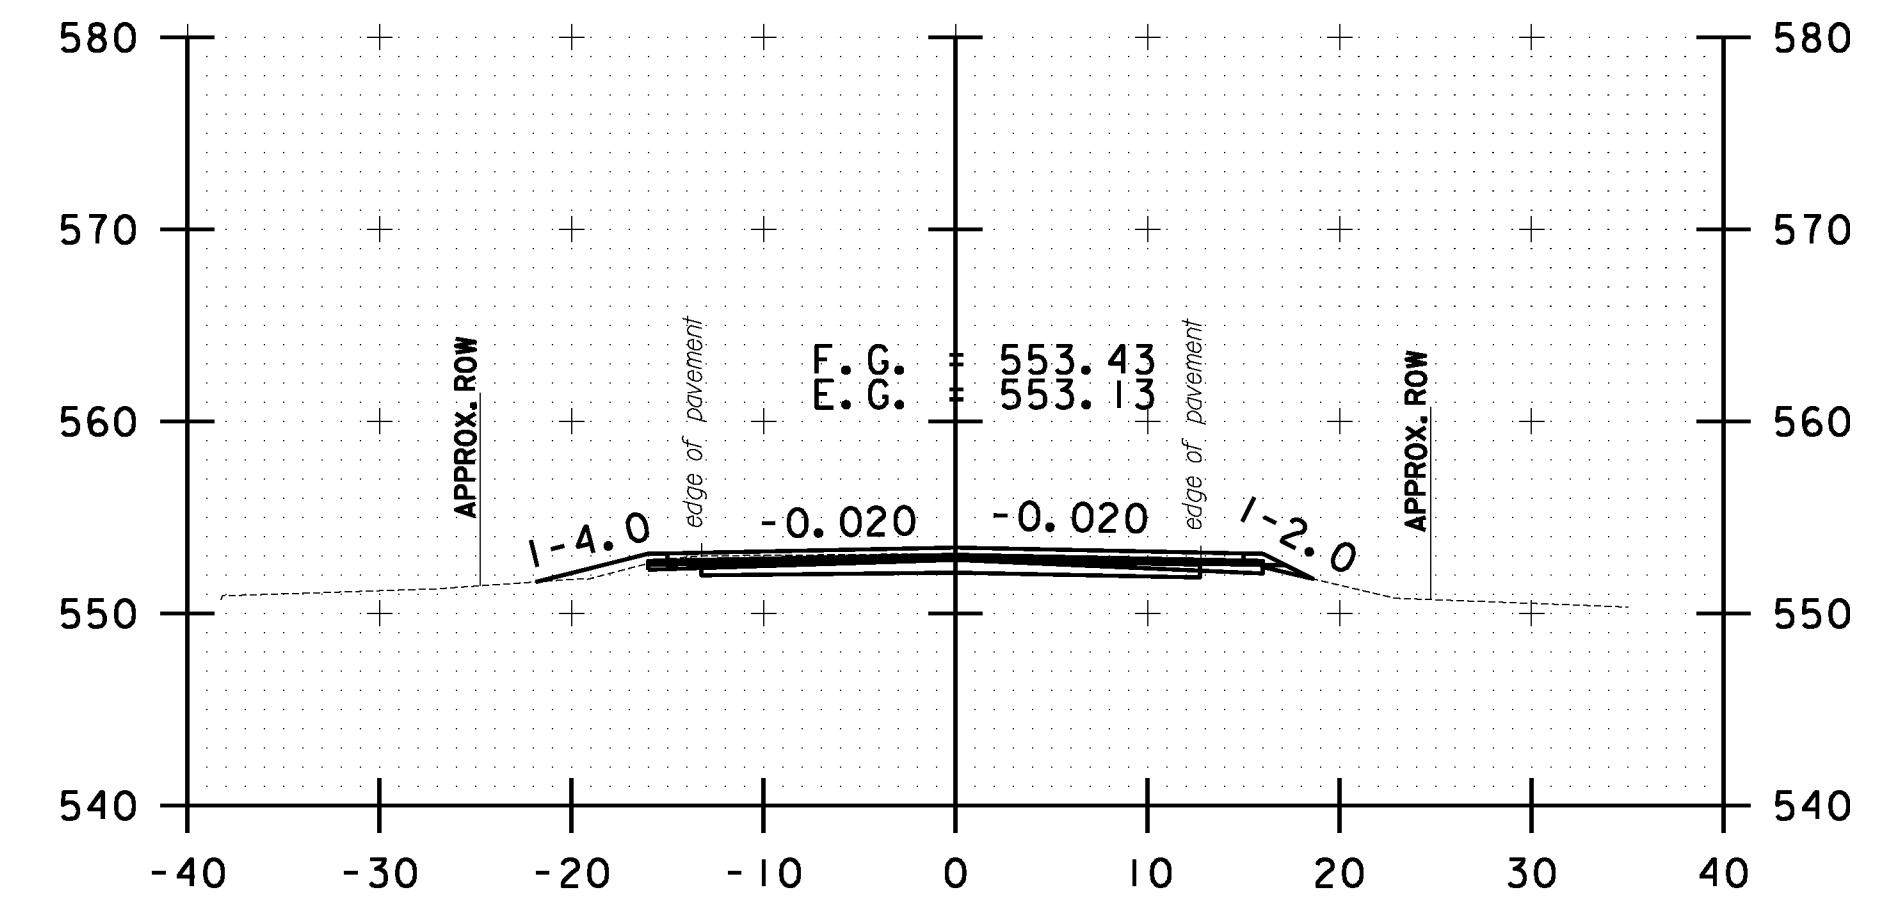


B 147+50.00

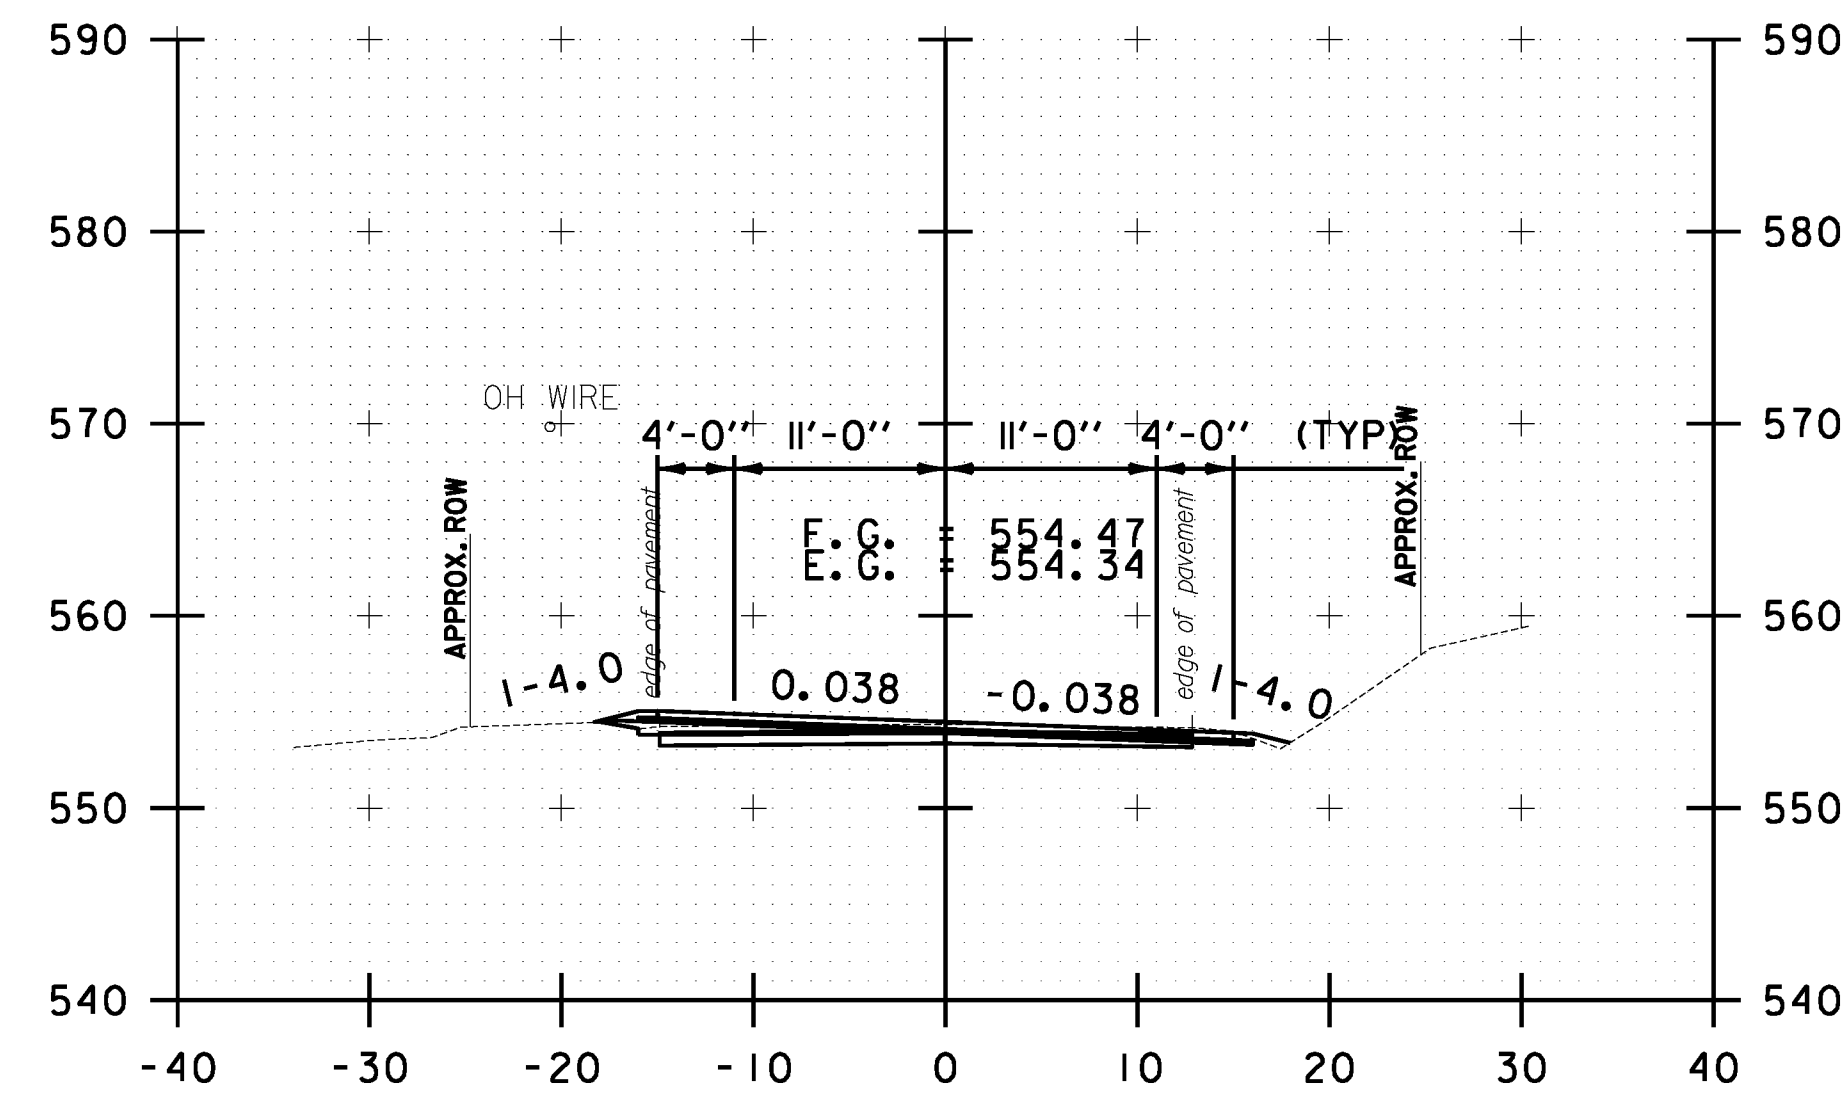

B 145+50.00

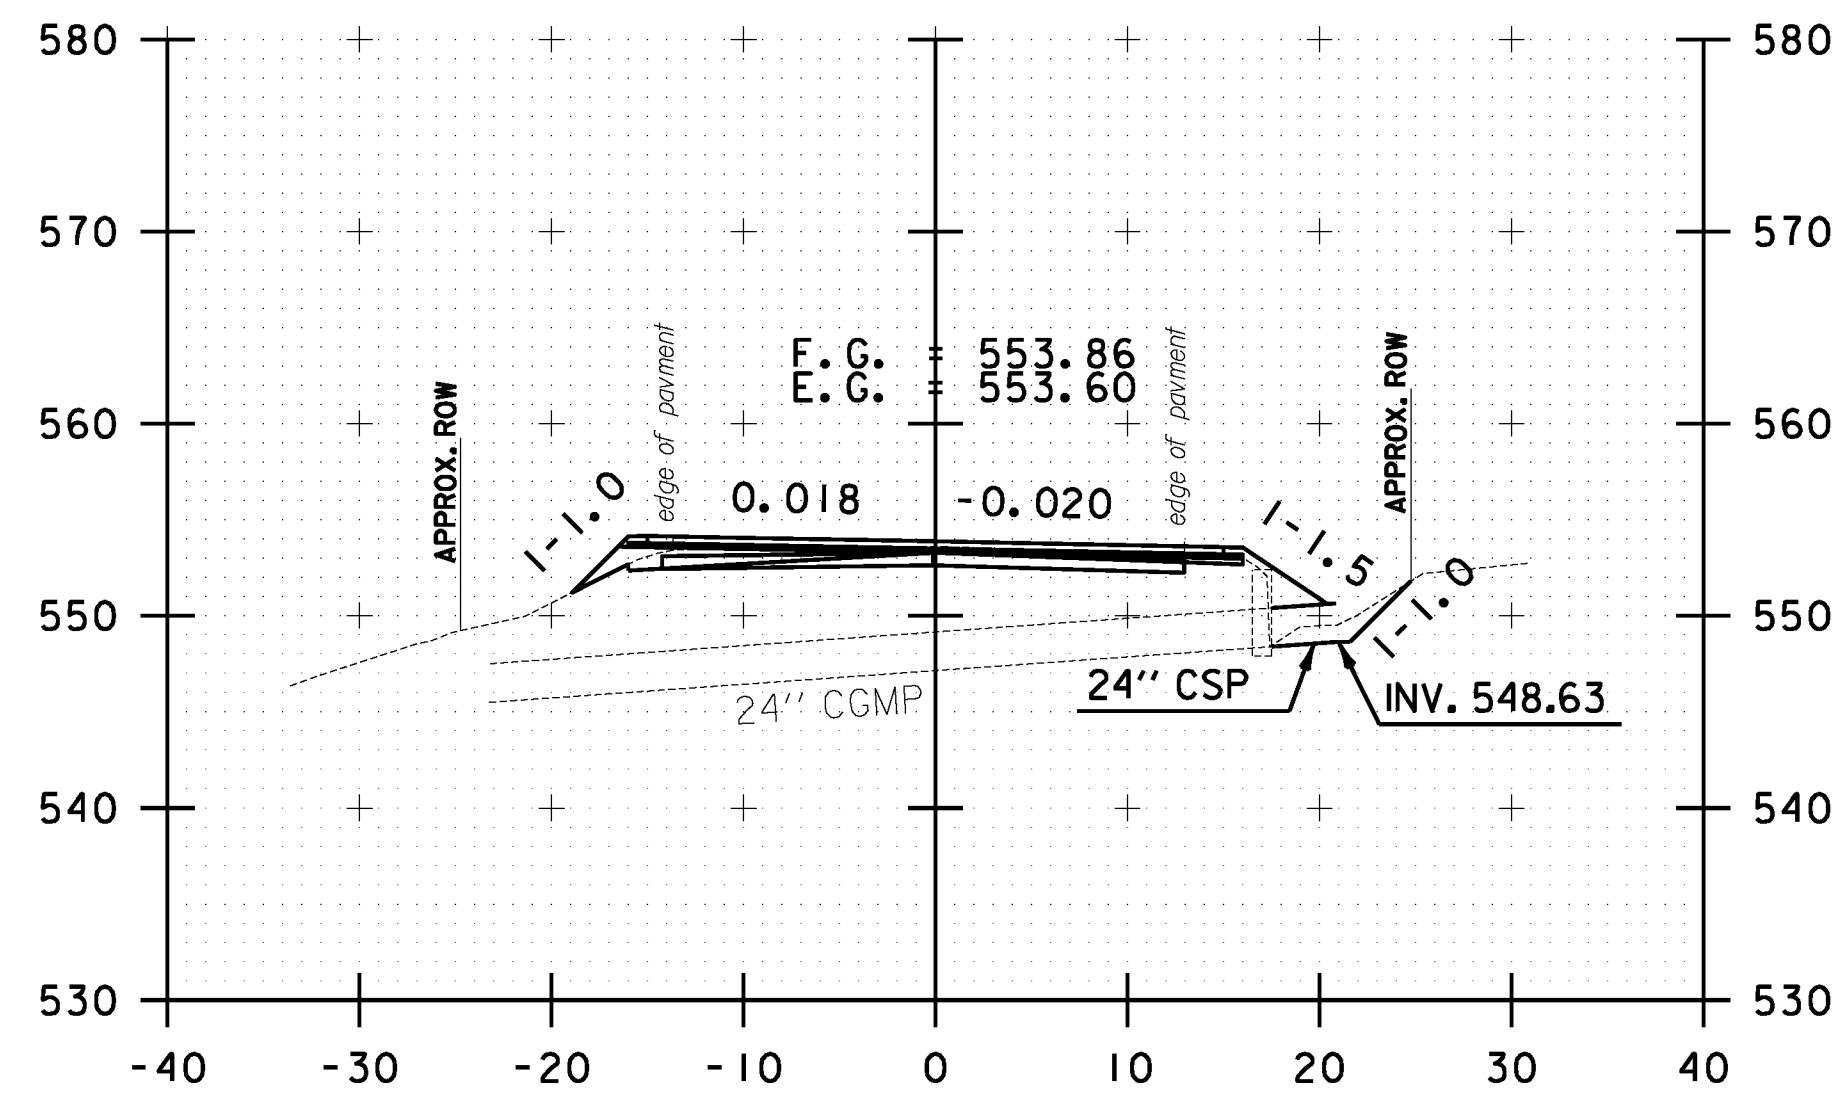

B 146+24.00

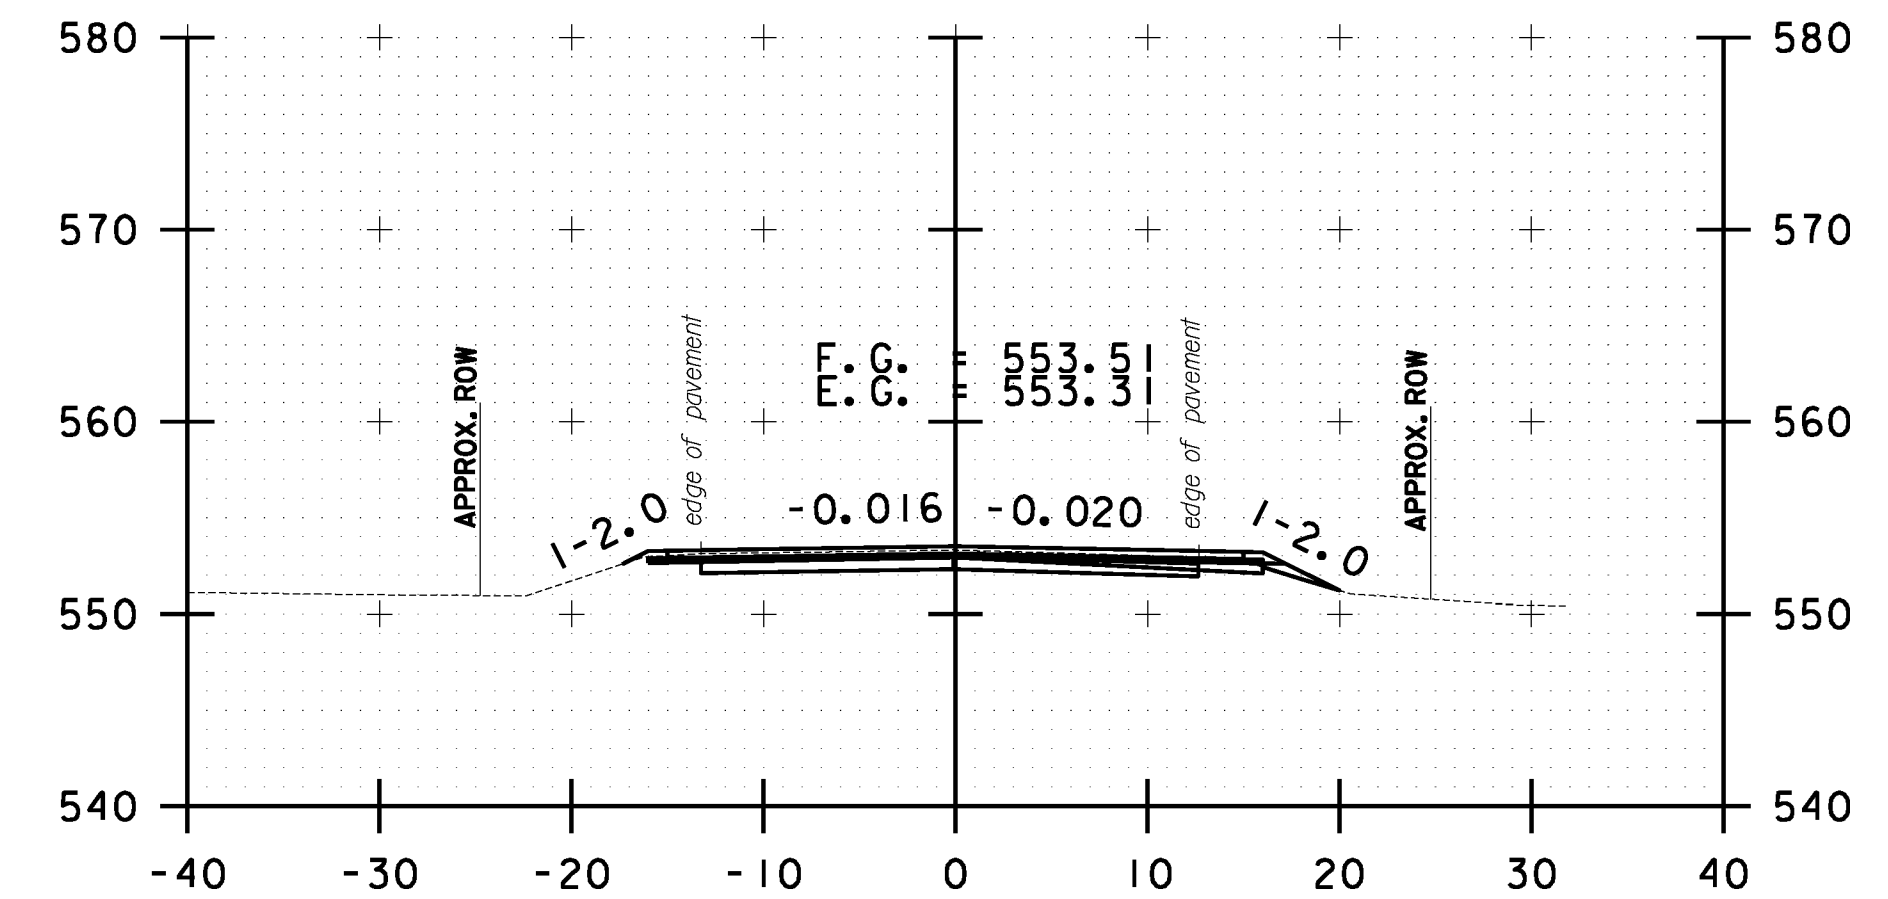

B 147+00.00



BETHEL CROSS SECTION SHEET #48	PROJECT NAME: STOCKBRIDGE-BETHEL
	PROJECT NUMBER: STP 2910(1)
	FILE NAME: z10b214.bethel.xc.dgn
DESIGNED BY: L.M.B.	PLOT DATE: 3/17/2014
IPARM FILE: z10b214xs160.1	DRAWN BY: W.G.P.
	CHECKED BY: J.P.S.
	SHEET 373 OF 397