

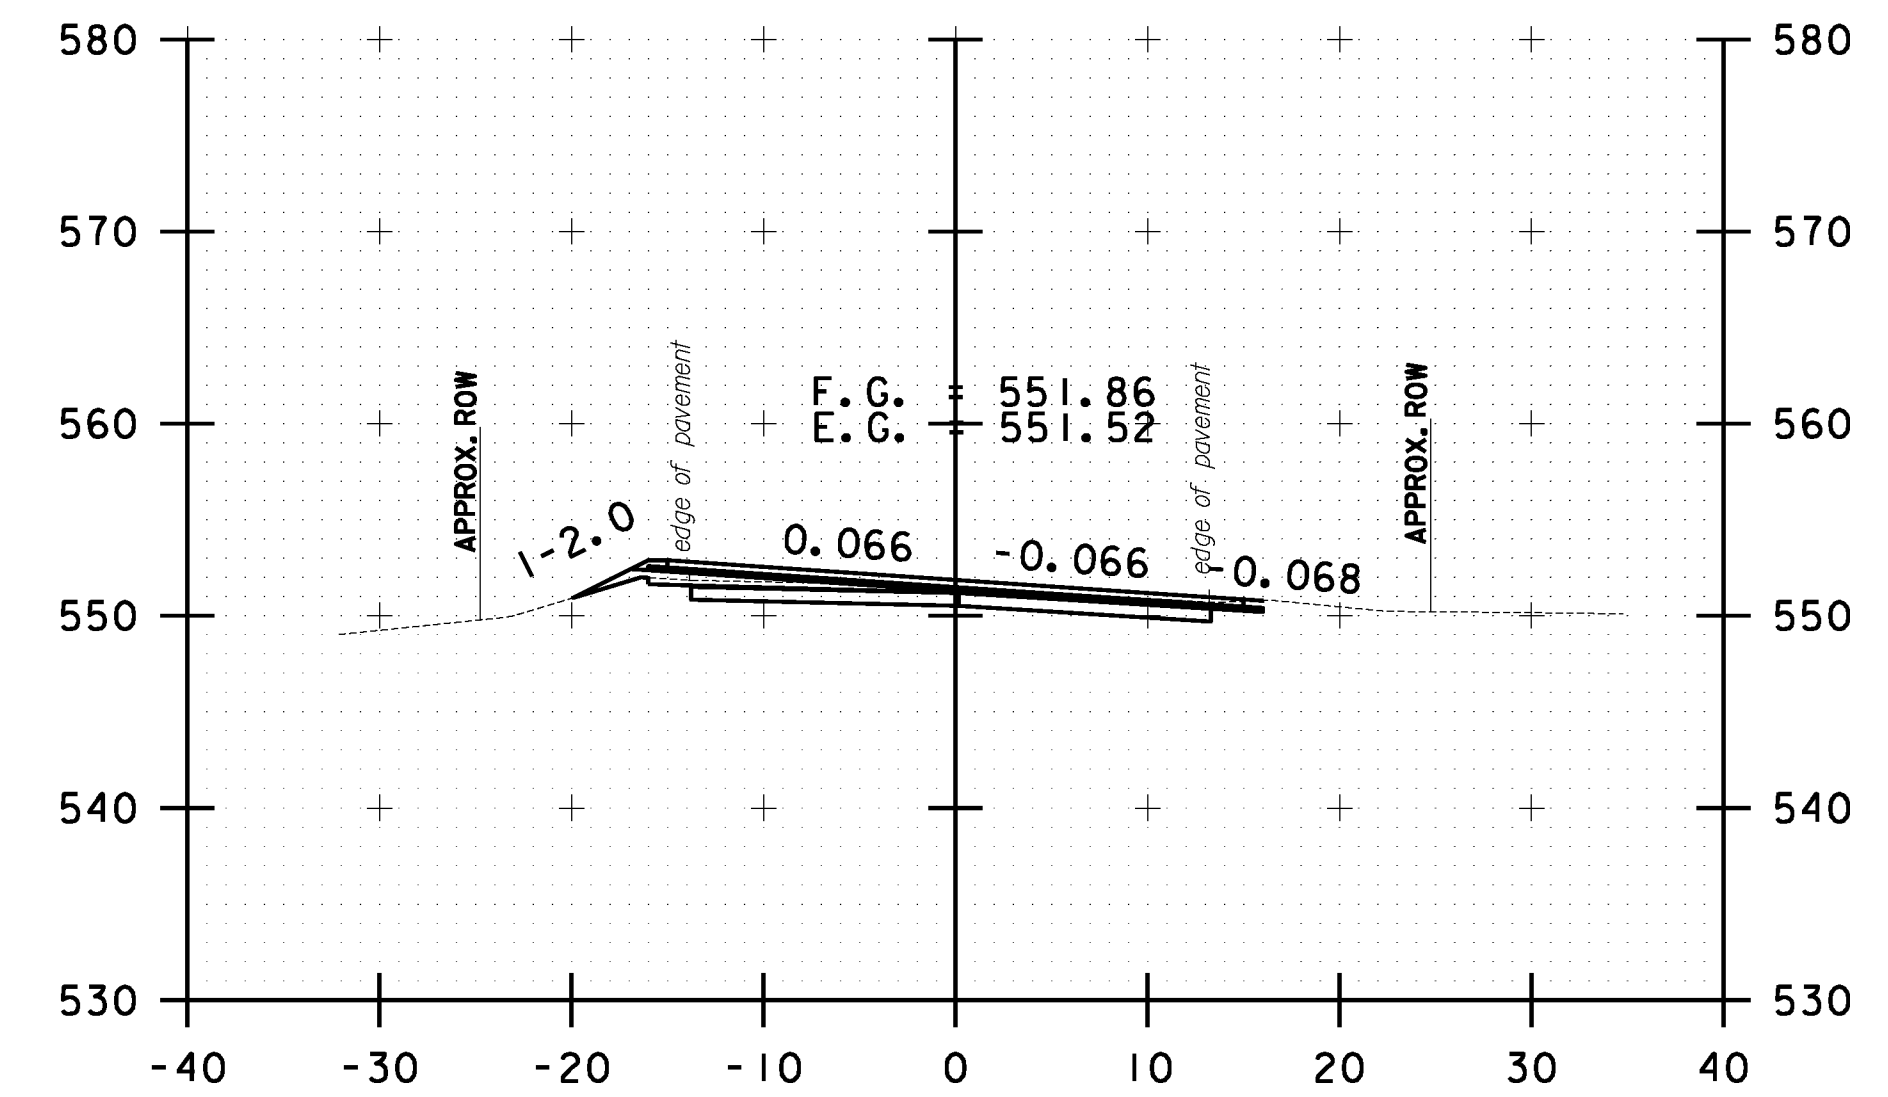
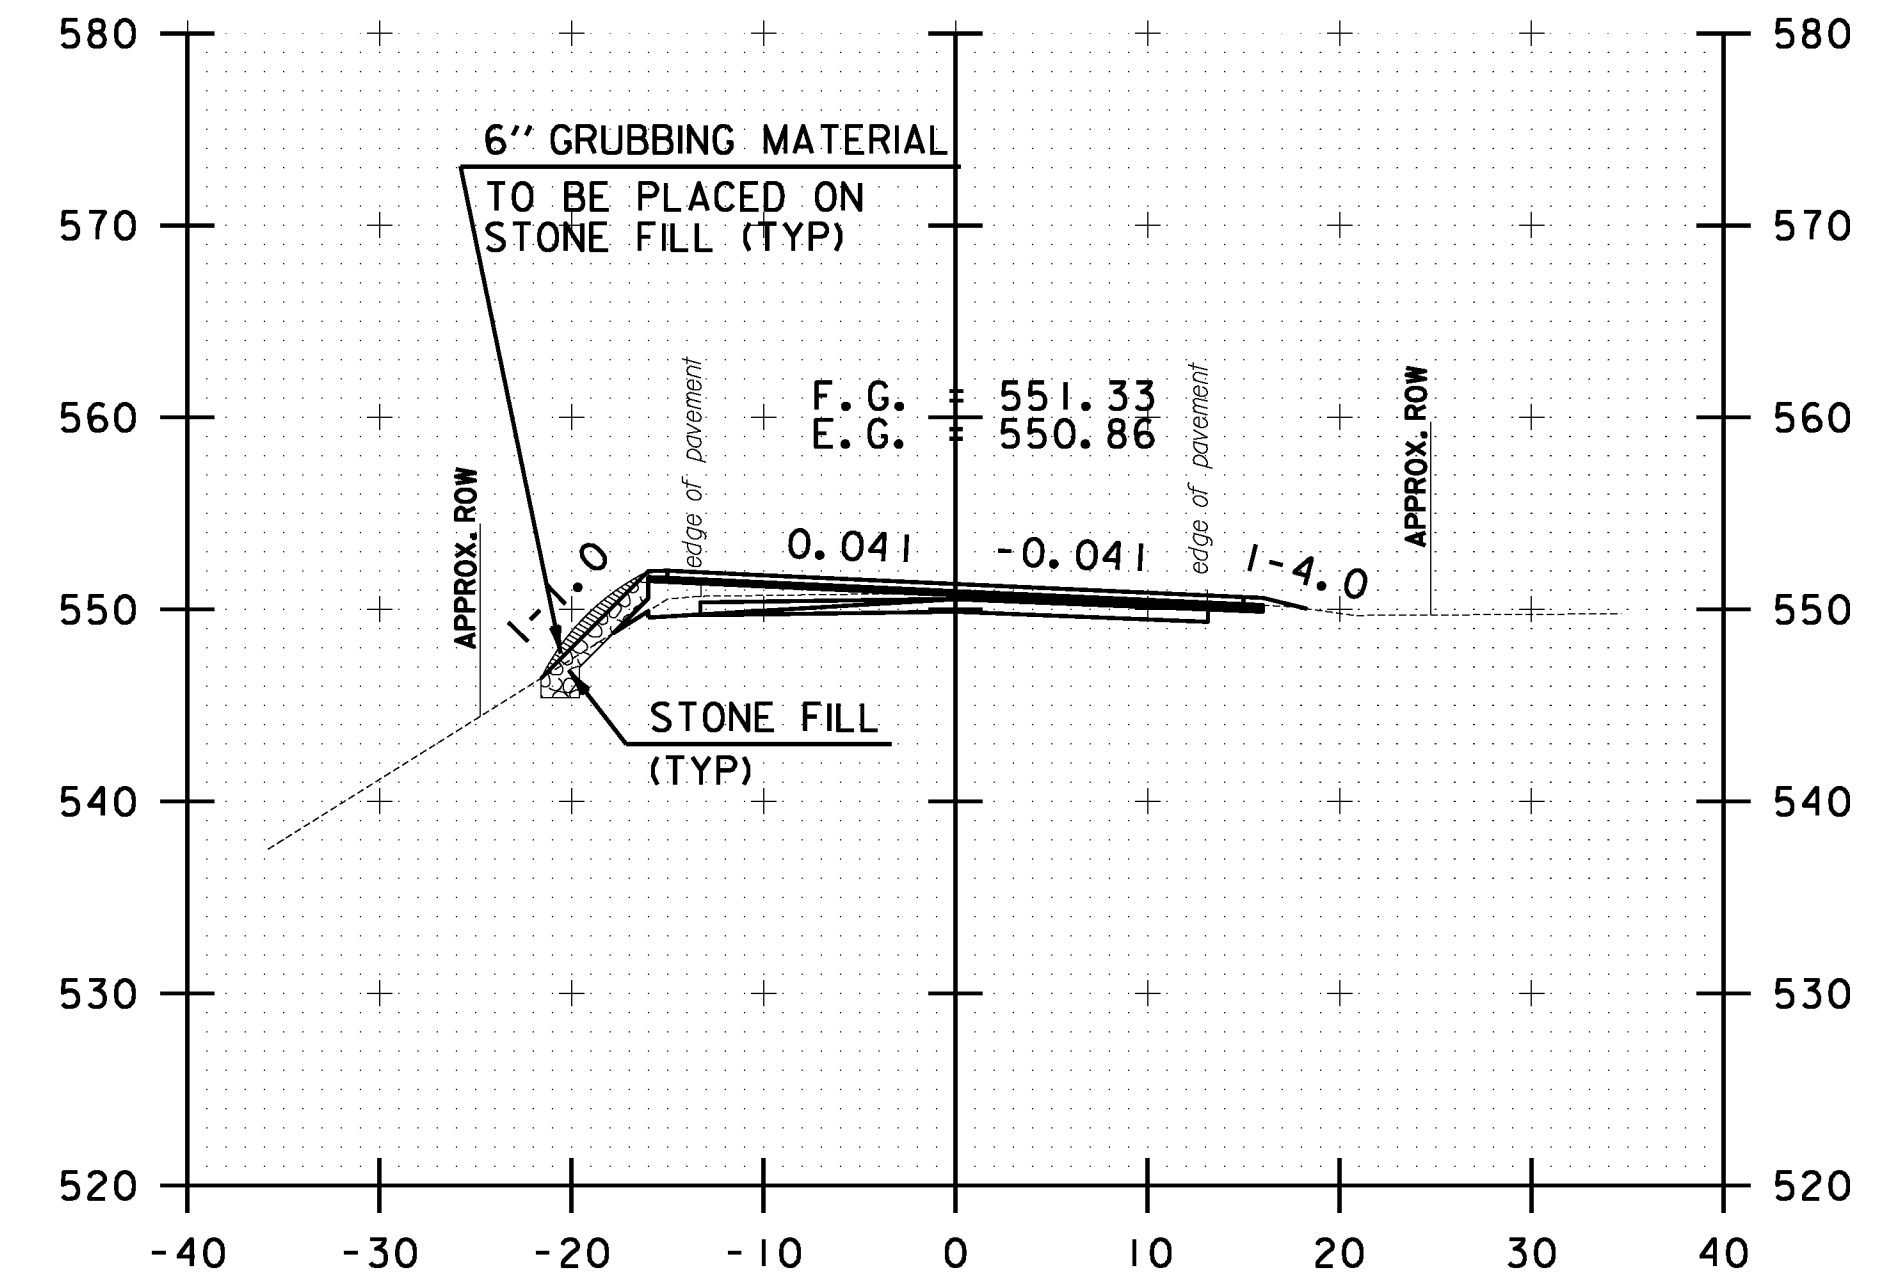
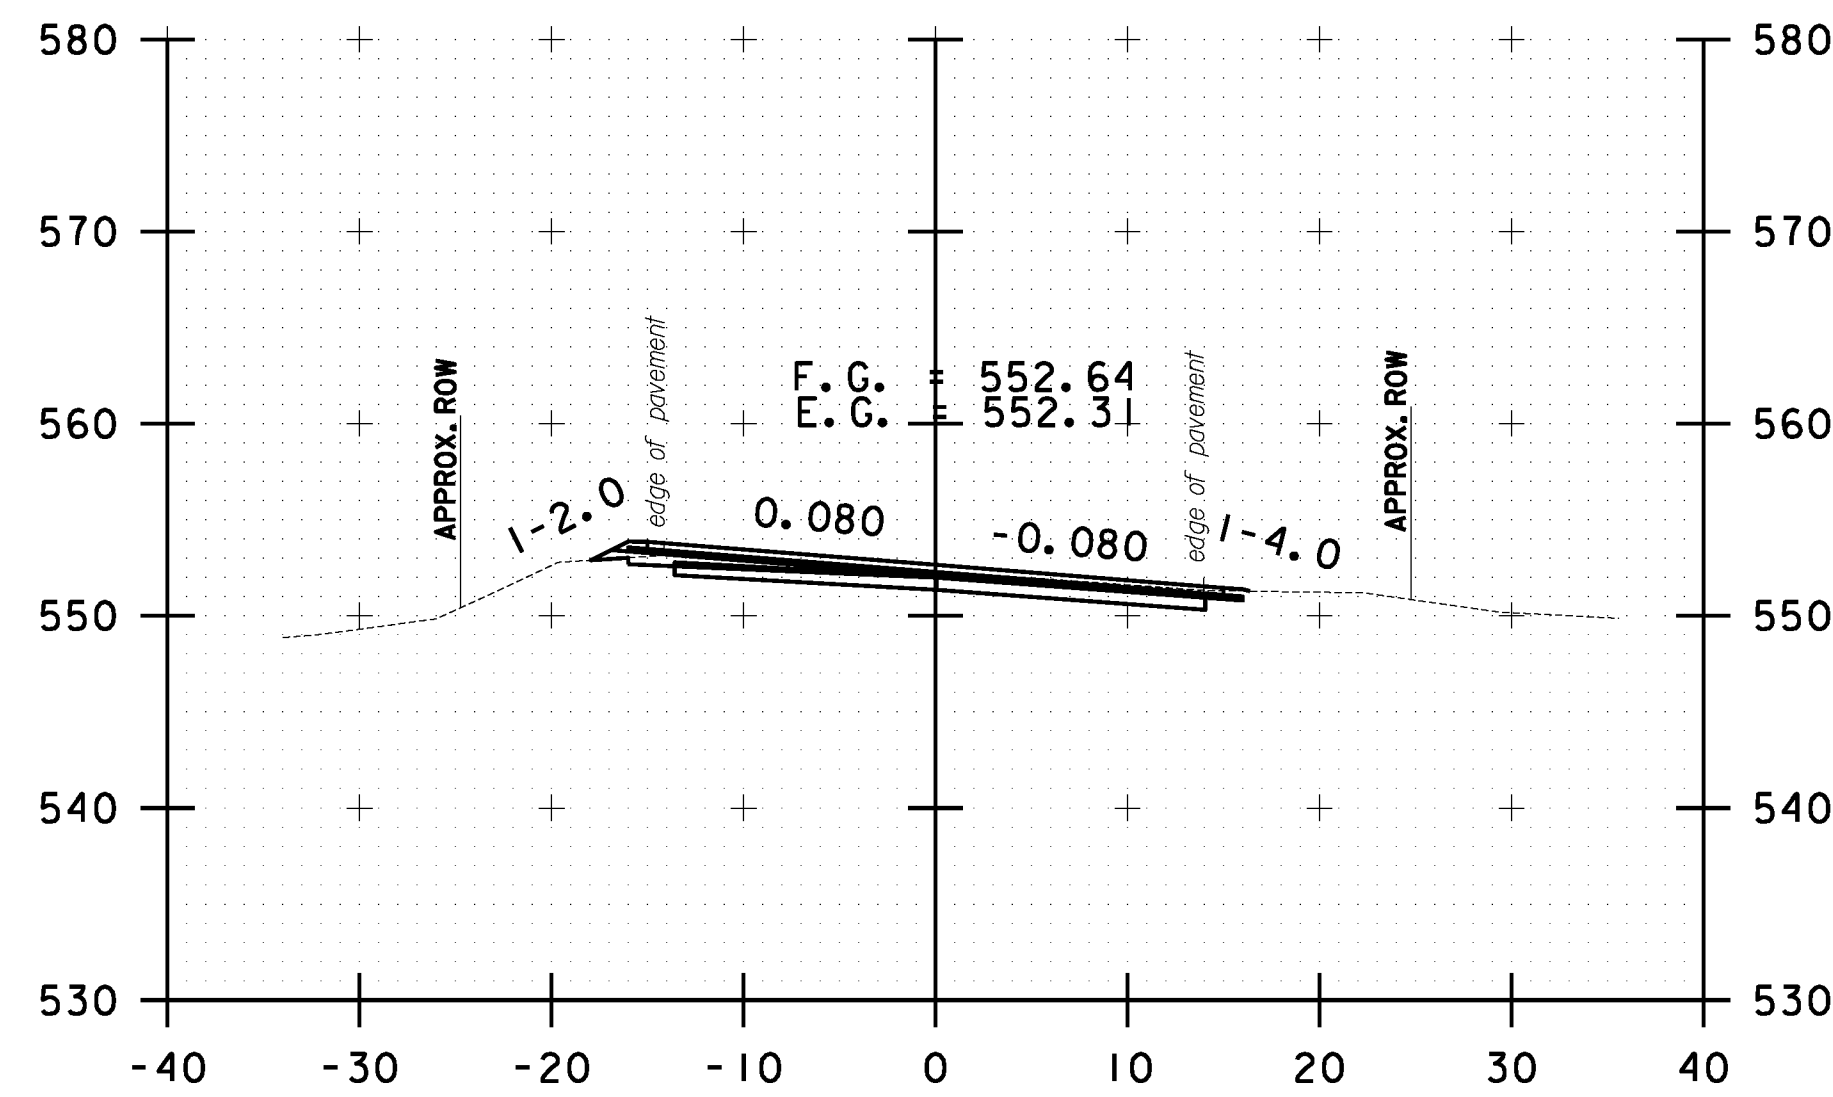
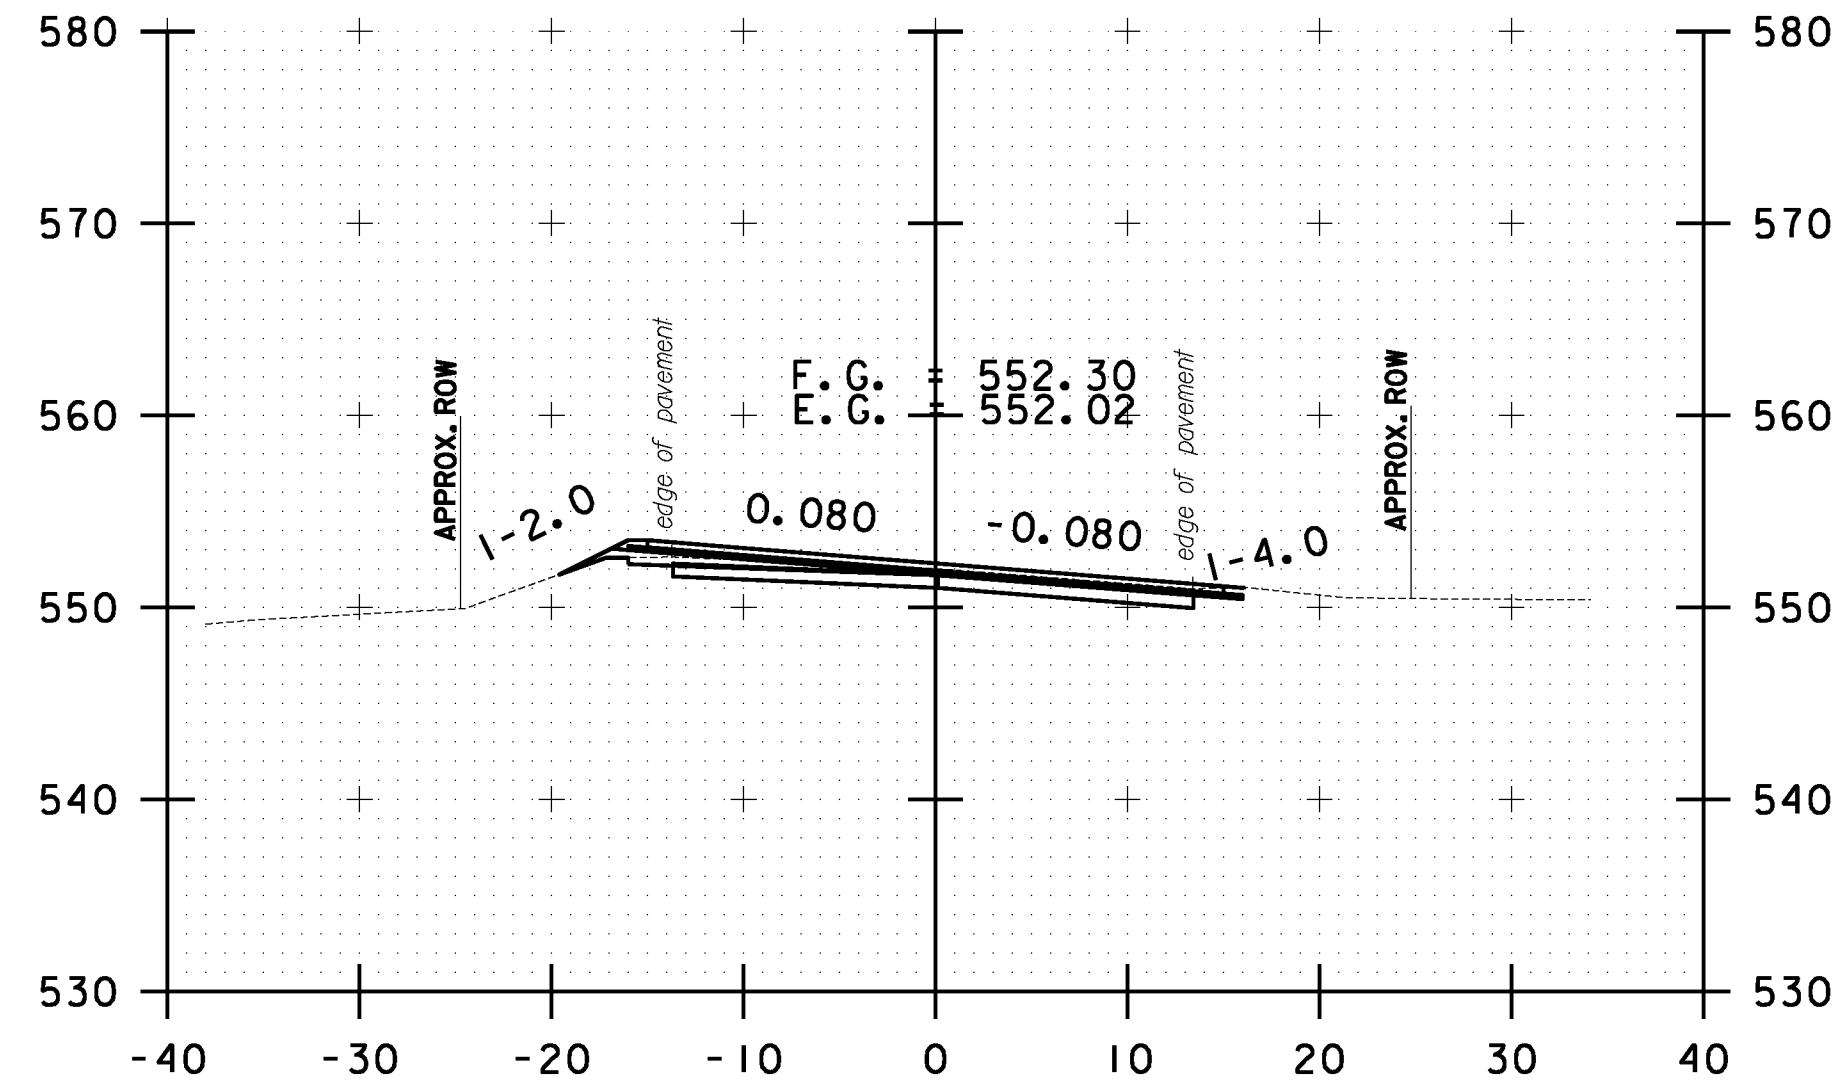


FILE NAME = Y:\P\c\res\any\k2\22425\CADD\MSTN\10b214.bethel.xc.dgn
 DATE/TIME = 3/17/2014
 USER = 4916

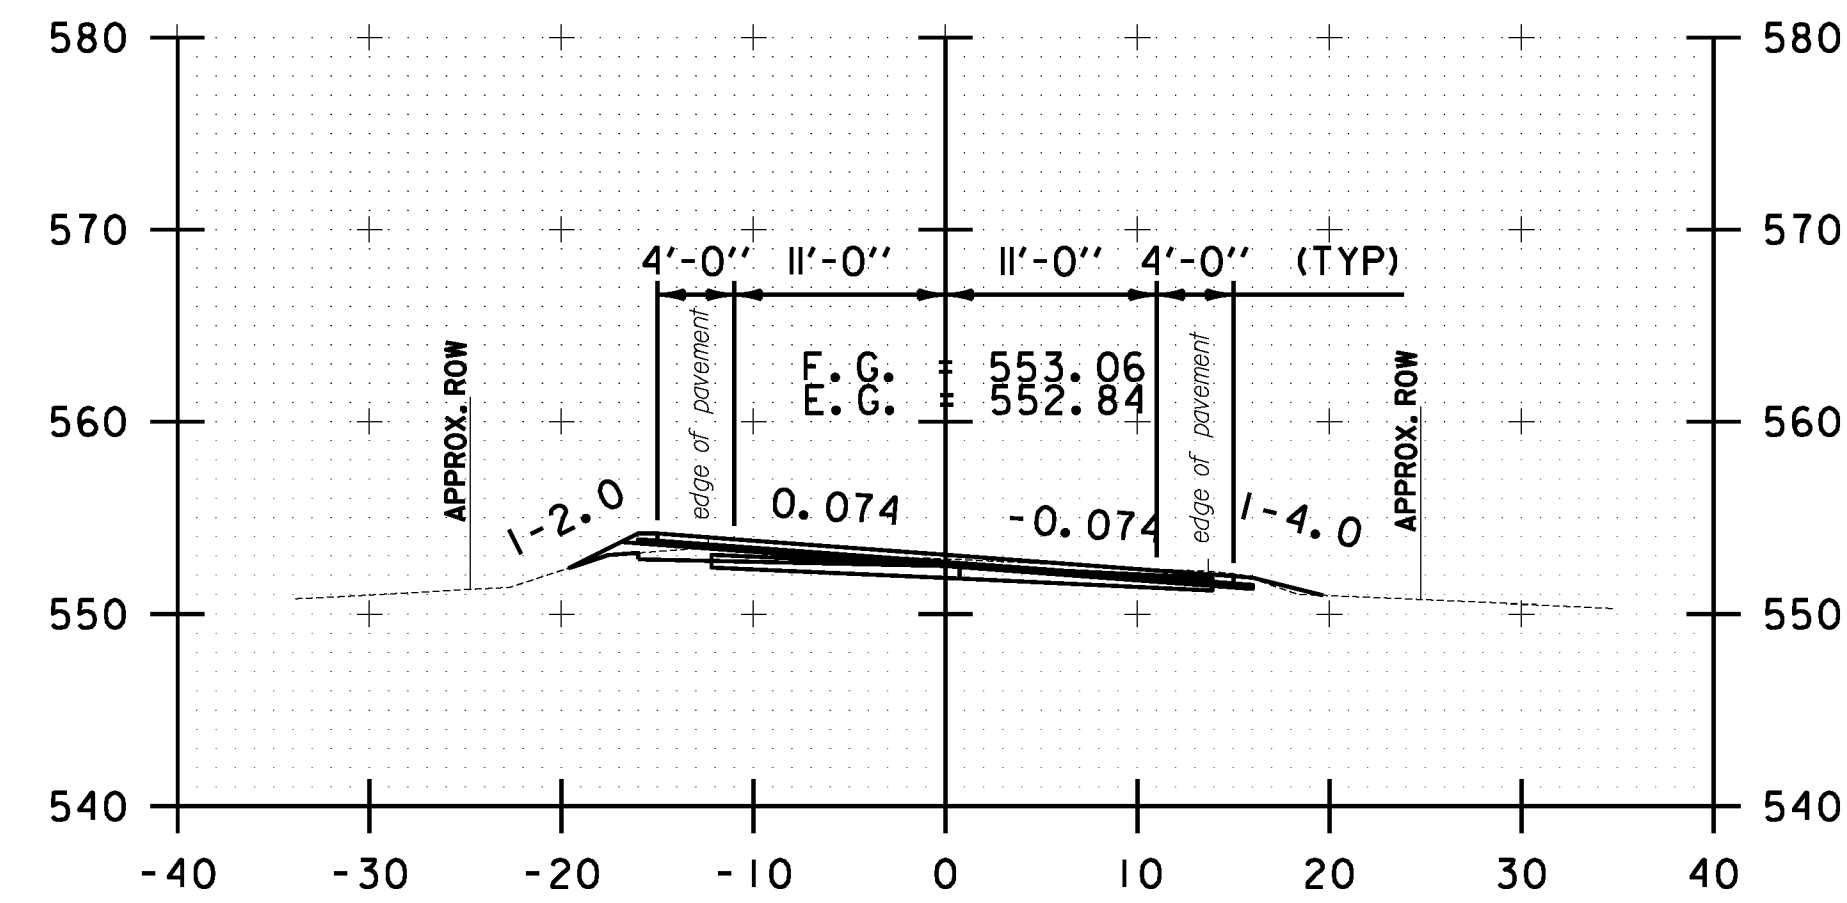

BETHEL CROSS SECTION SHEET #50	PROJECT NAME: STOCKBRIDGE-BETHEL
	PROJECT NUMBER: STP 2910(1)
	FILE NAME: z10b214.bethel.xc.dgn
	IPARM FILE: z10b214xs162.i
	PLOT DATE: 3/17/2014
	DRAWN BY: W.G.P.
	CHECKED BY: J.P.S.
	SHEET 375 OF 397

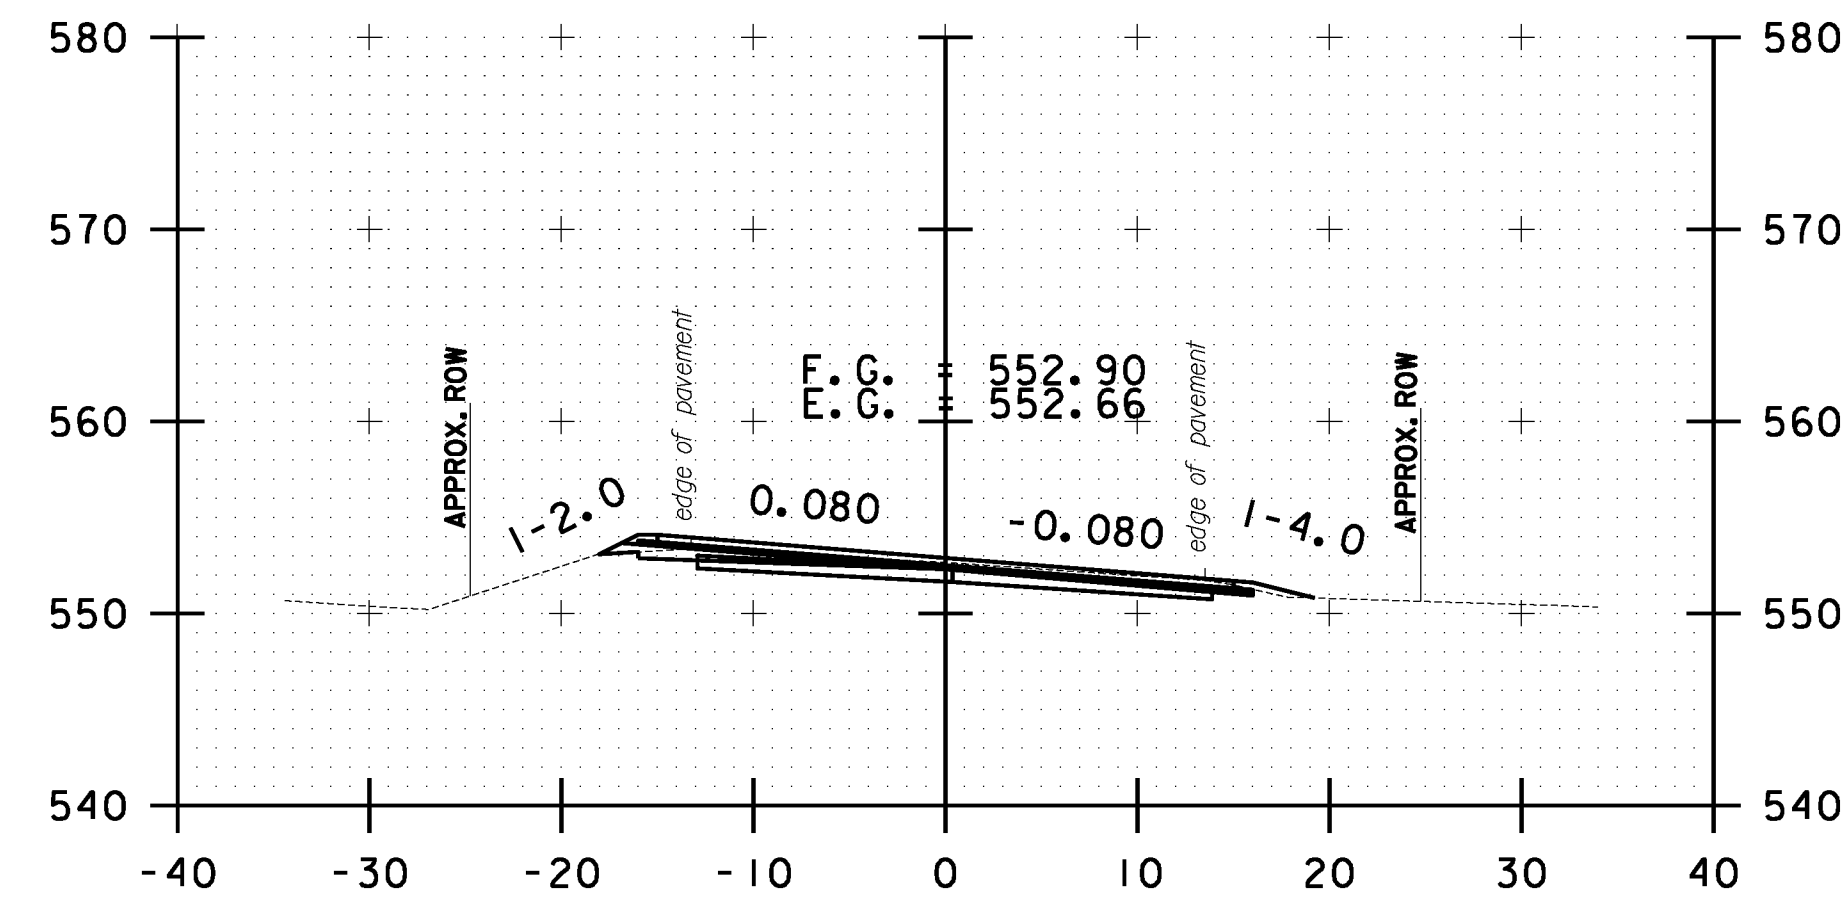