




FILE NAME = V:\P\c\res\any\k2\22425\CADD\MSTN\10b214_bethel.xc.dgn
 DATE/TIME = 3/17/2014
 USER = 4916

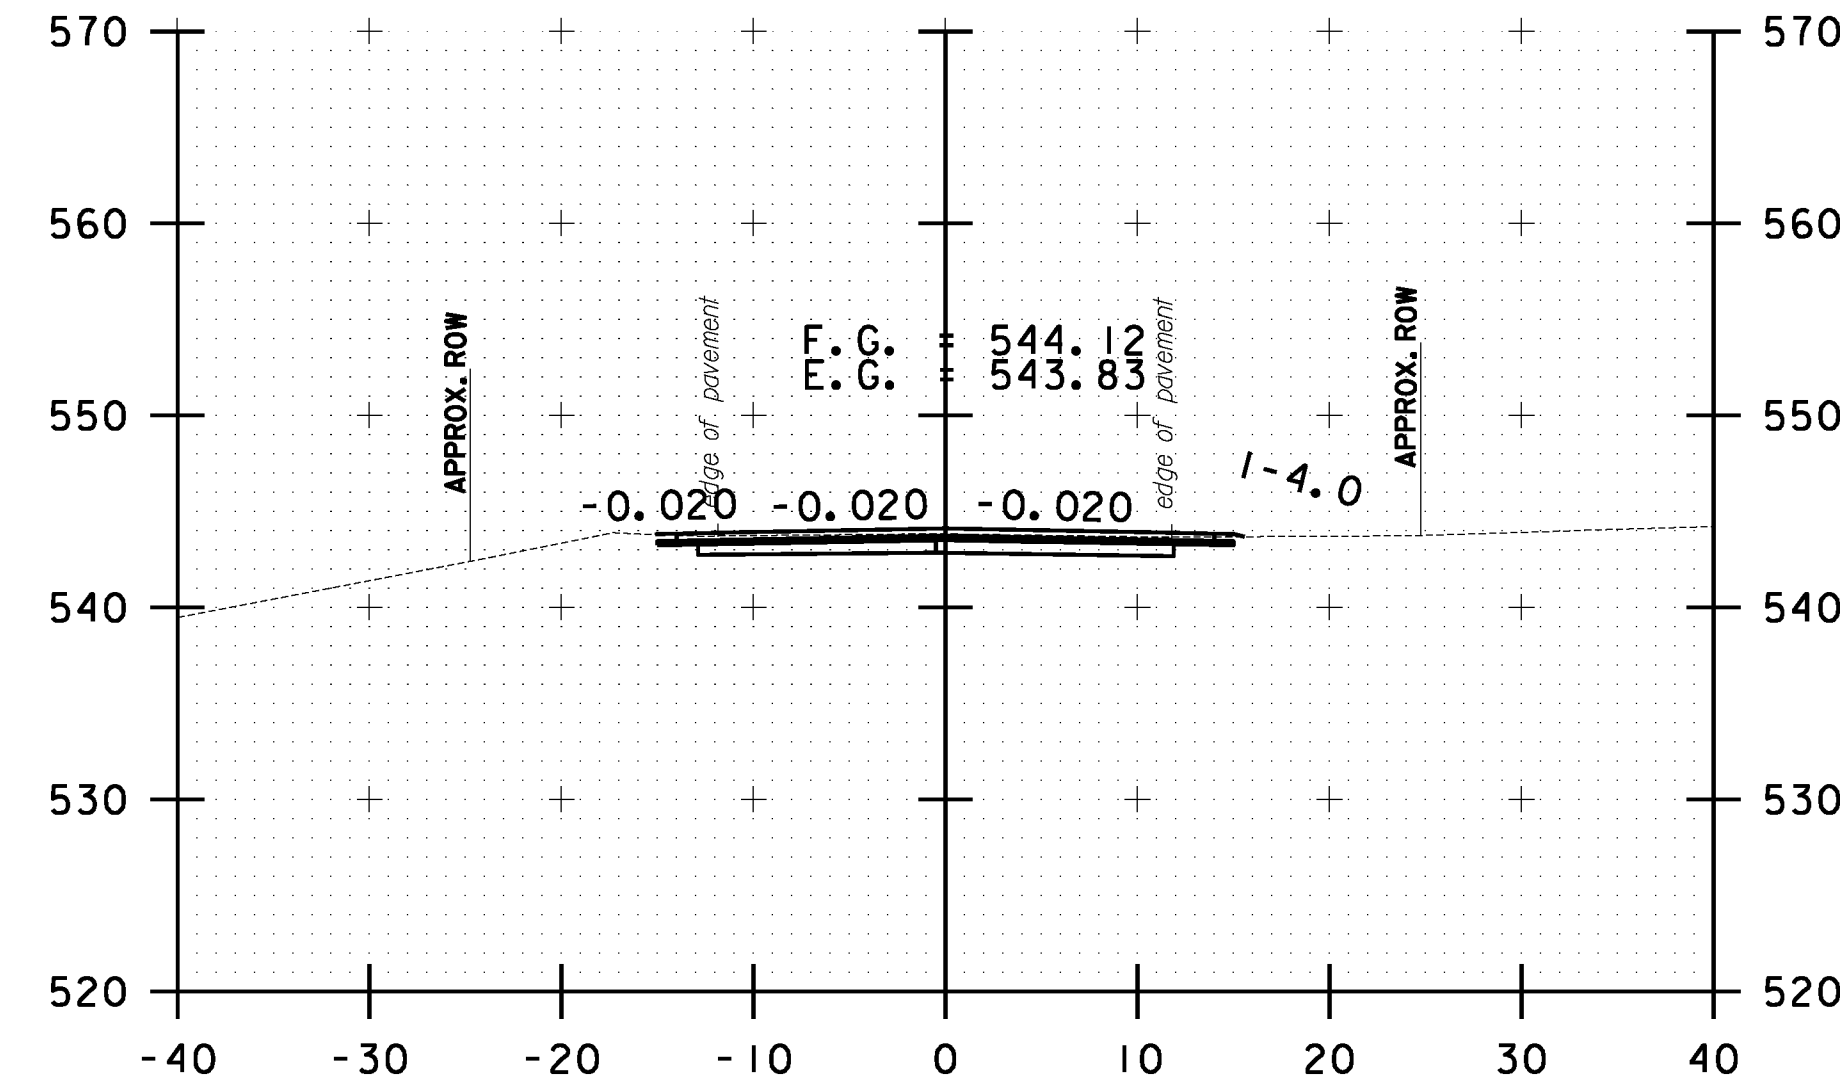


B 164+00.00

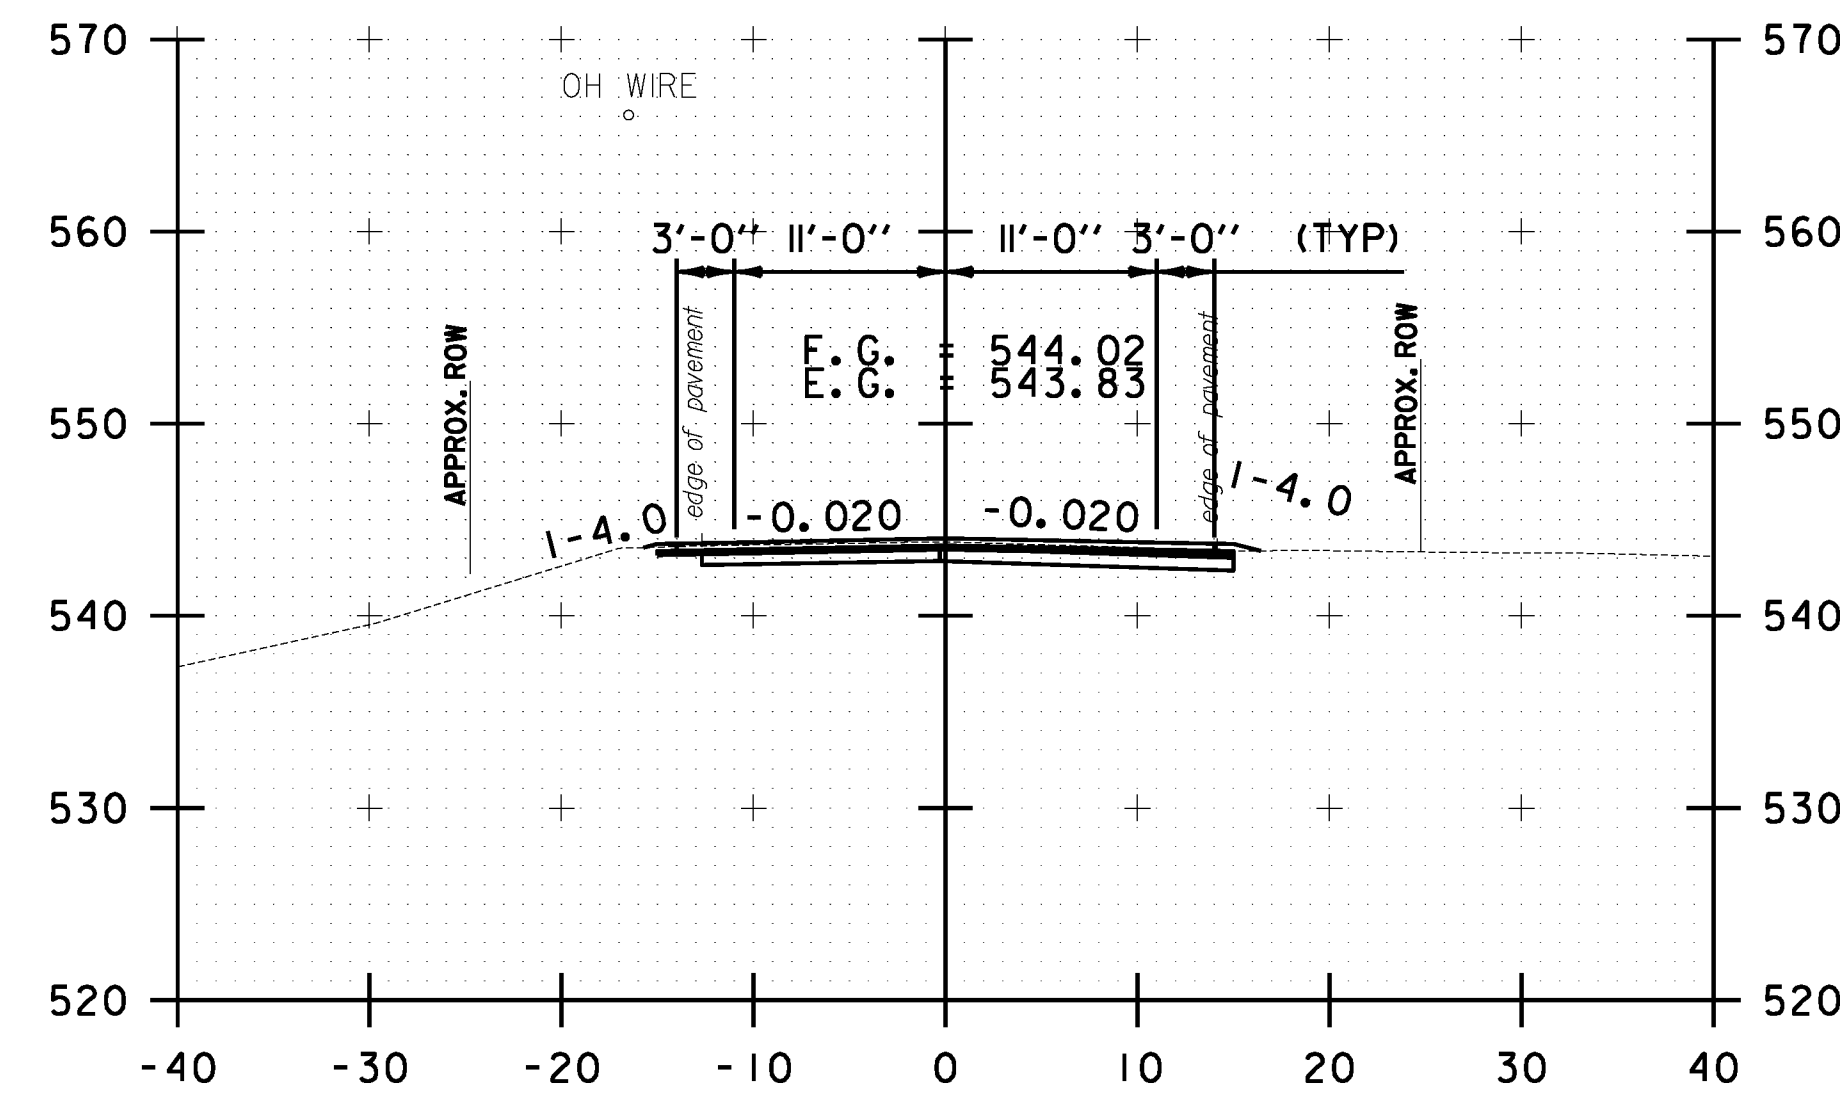


B 163+50.00

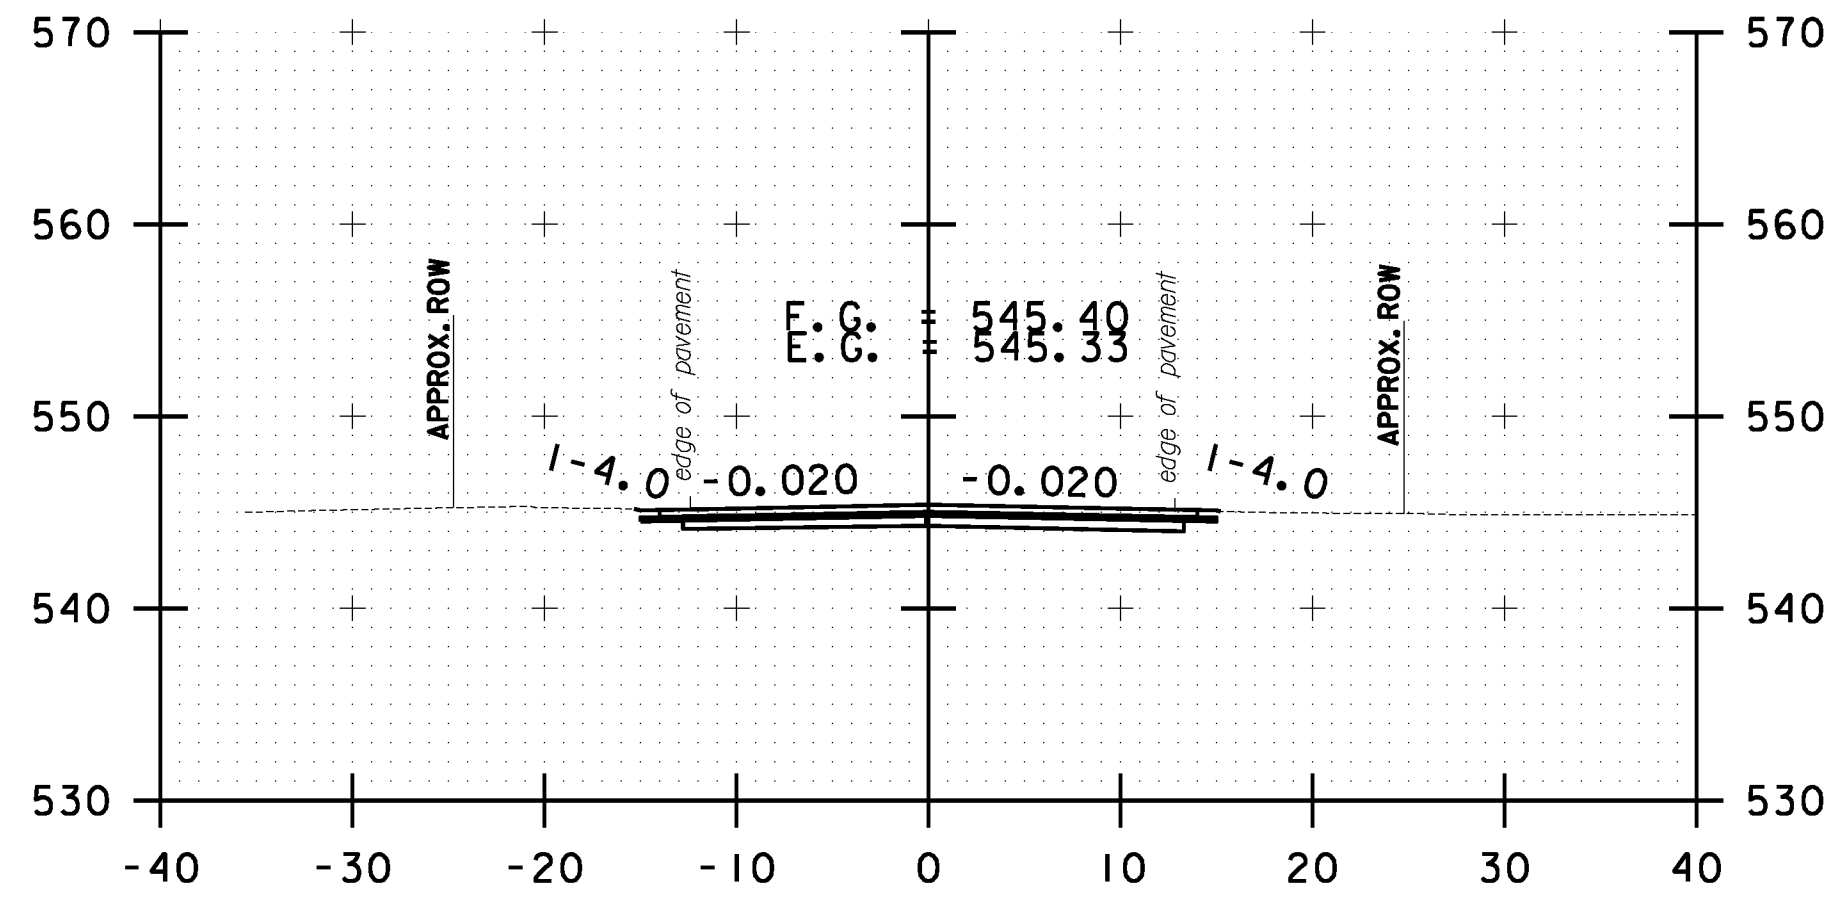


B 165+50.00

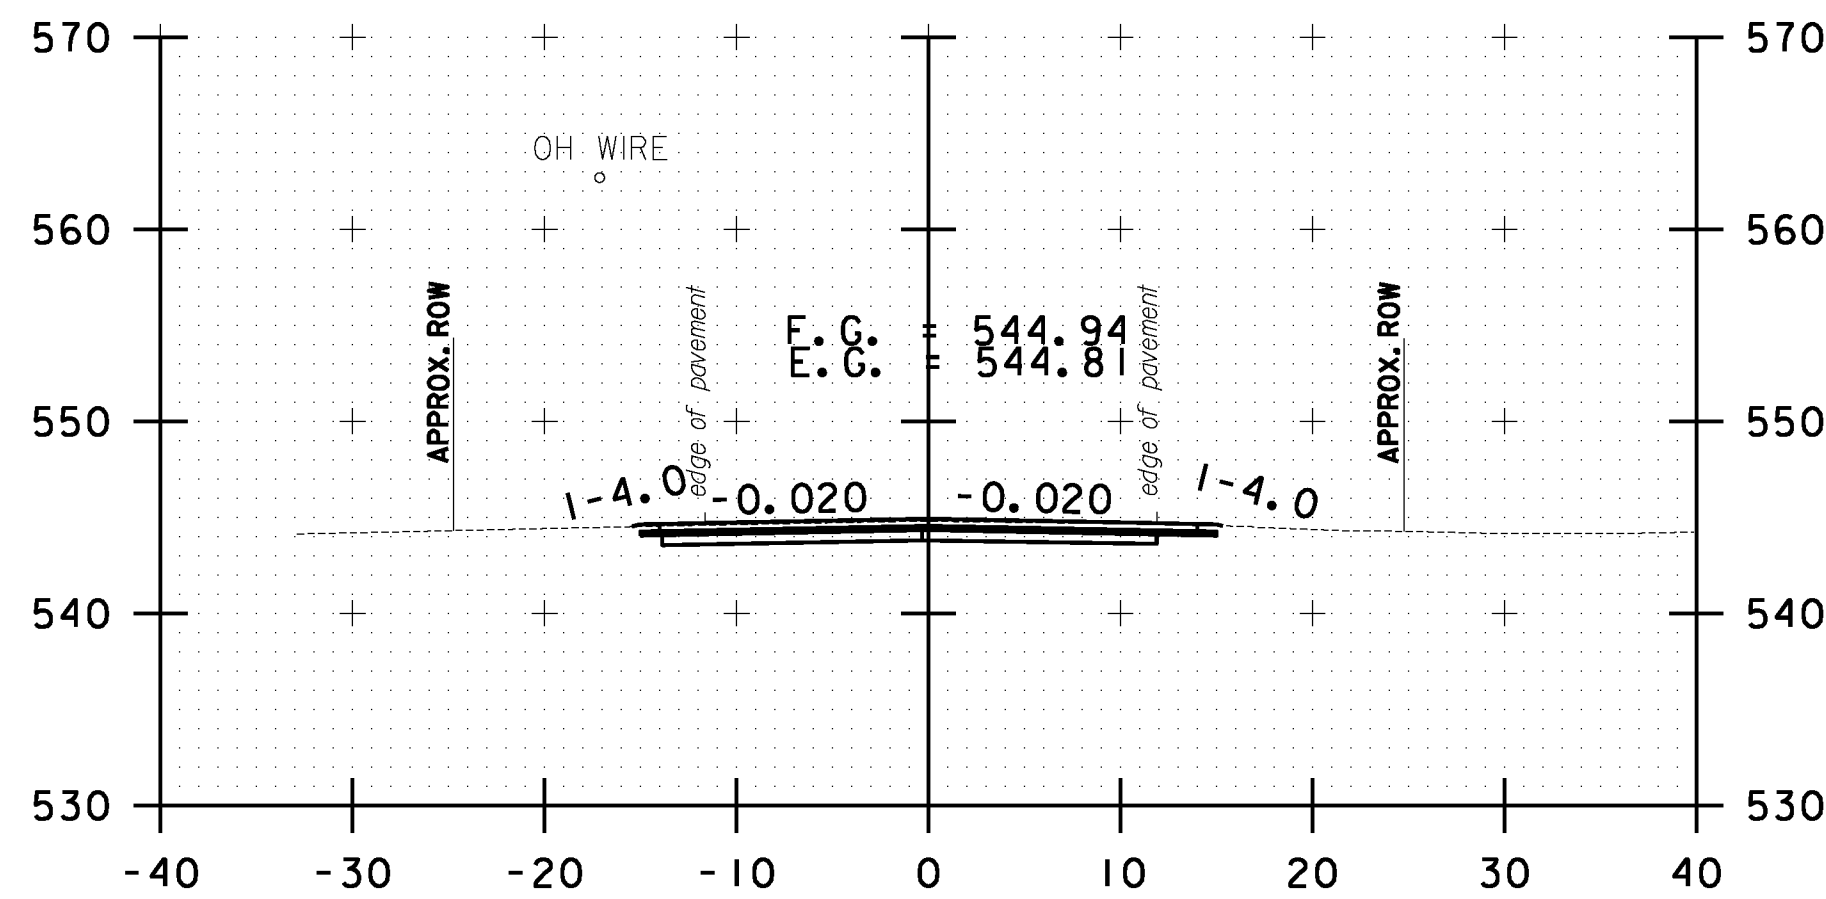


B 165+00.00

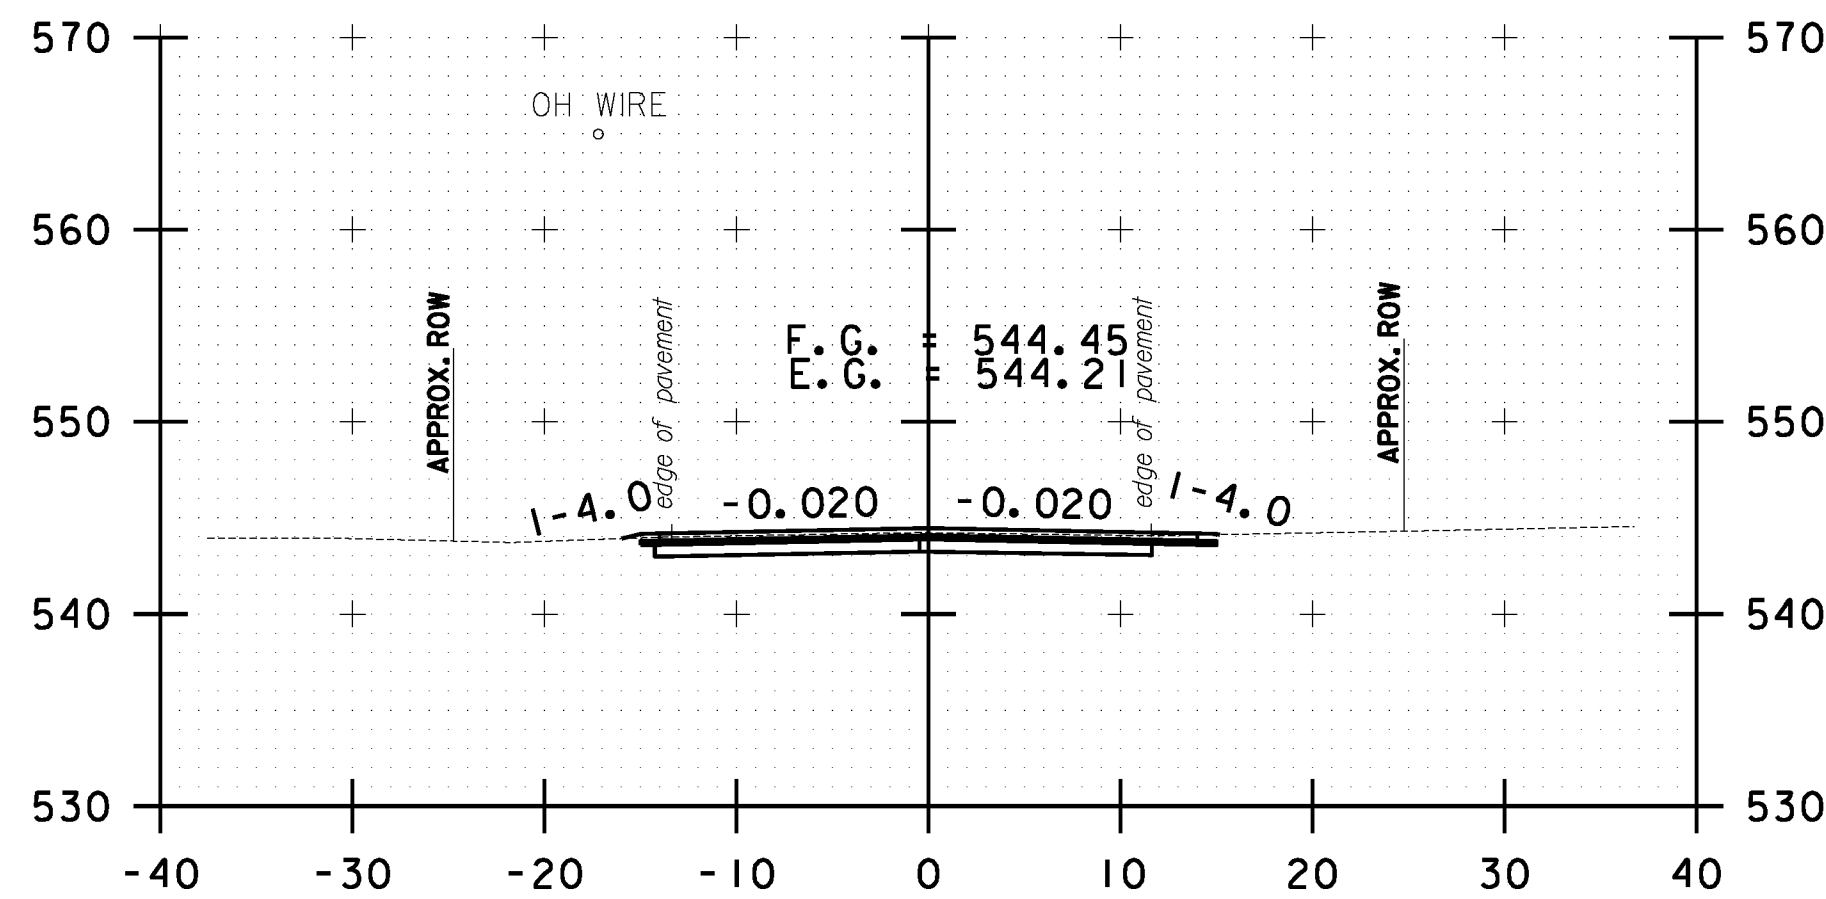


B 164+50.00

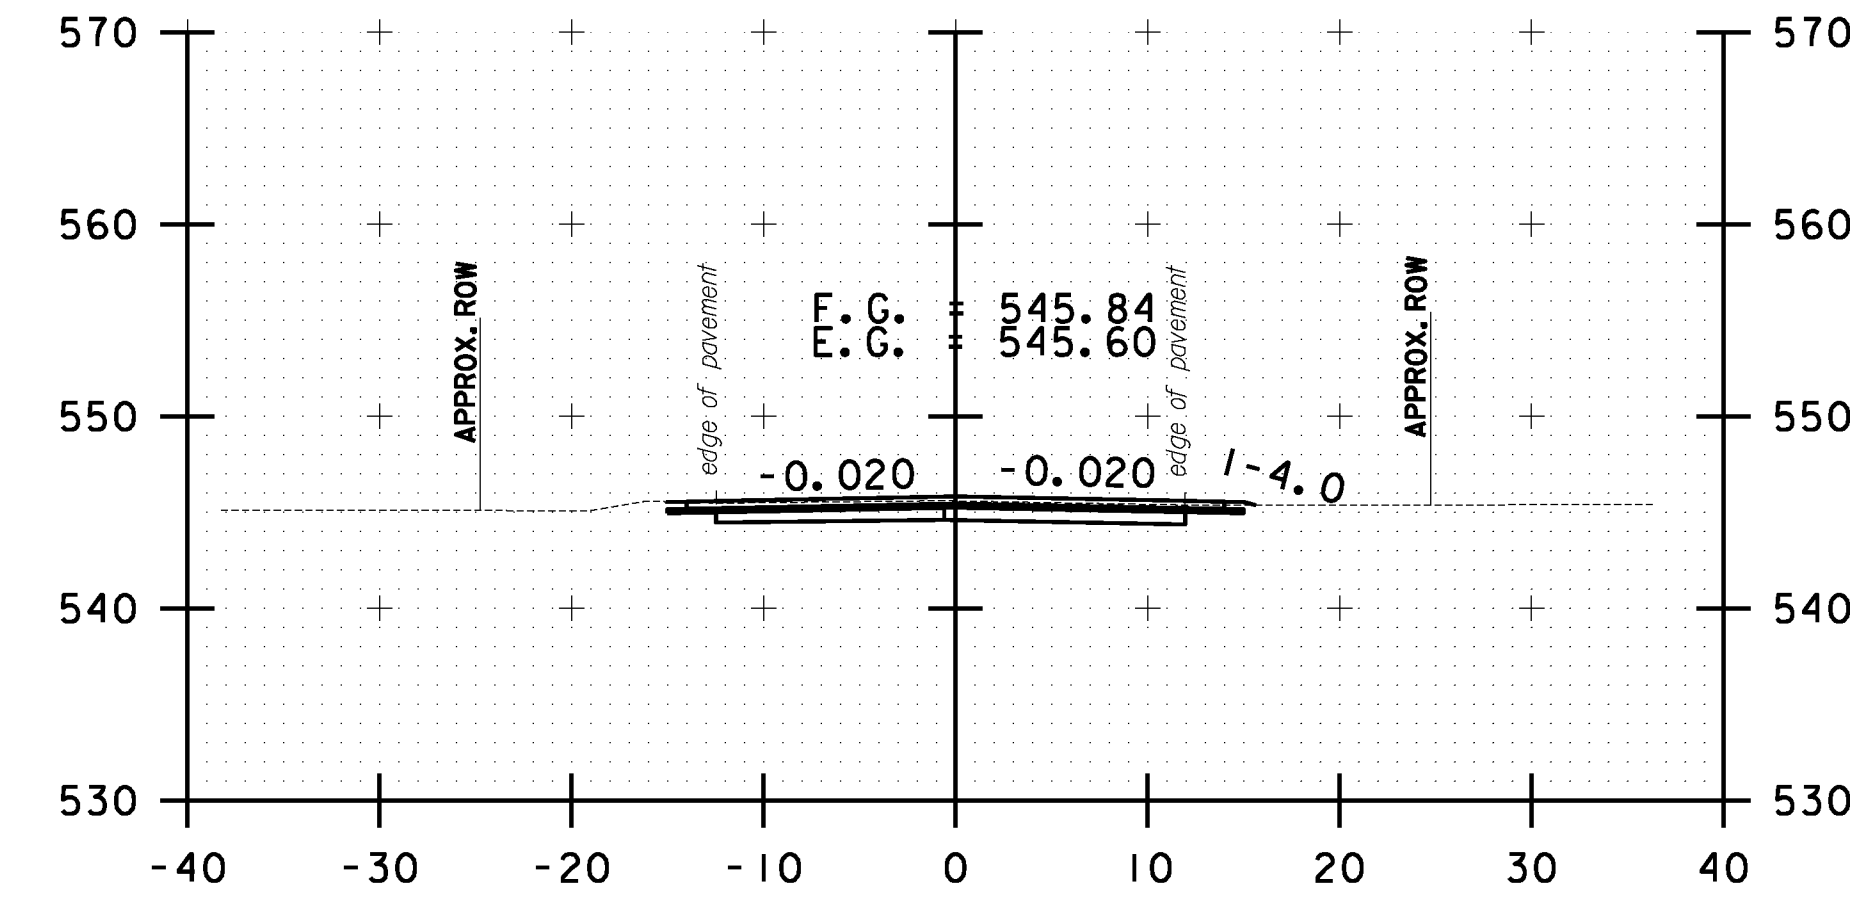

B 167+00.00

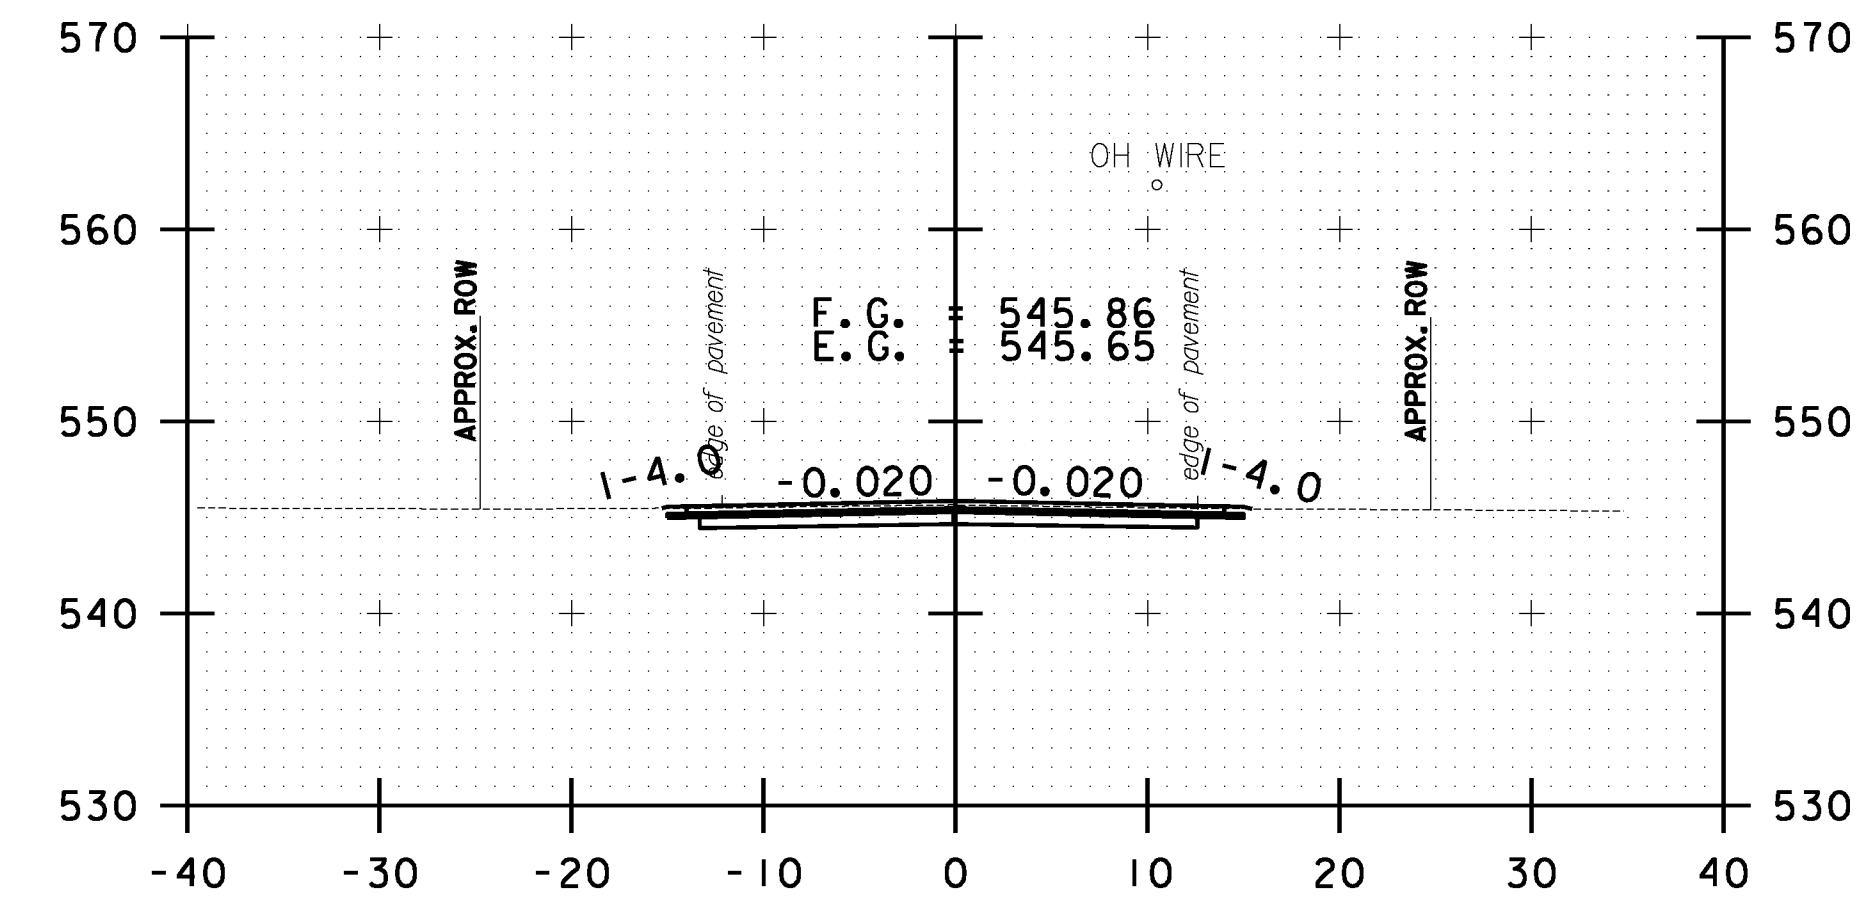

B 166+50.00

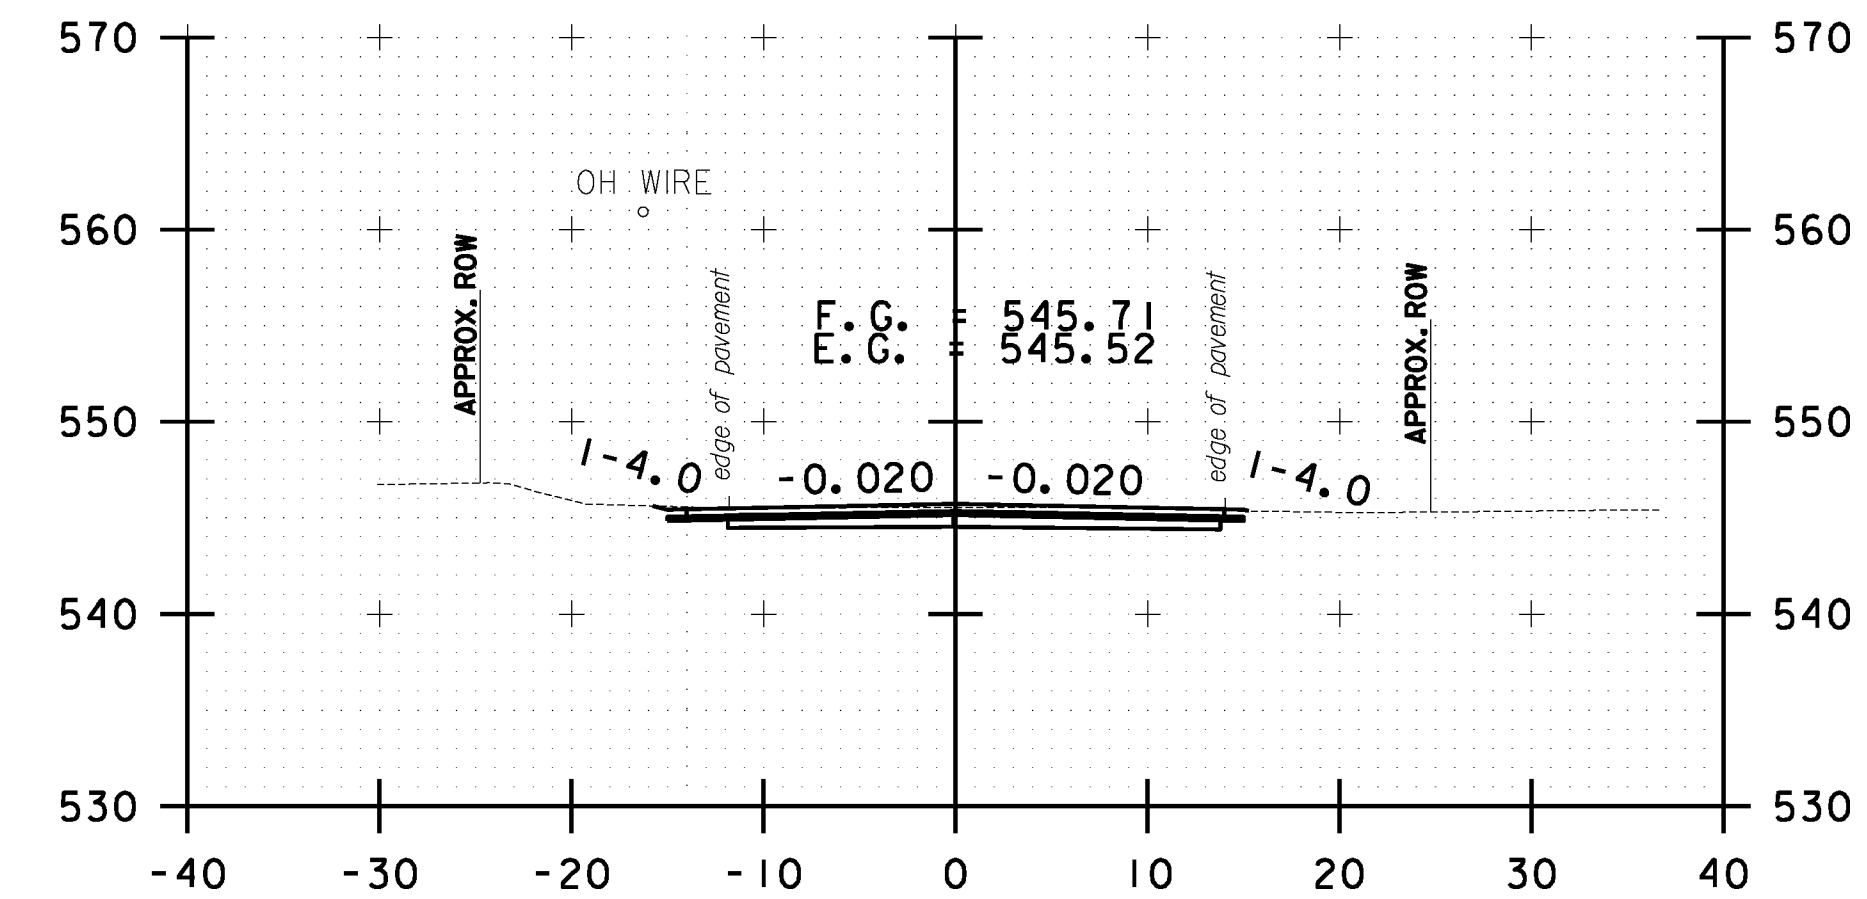

B 166+00.00



BETHEL CROSS SECTION SHEET #54	PROJECT NAME: STOCKBRIDGE-BETHEL
	PROJECT NUMBER: STP 2910(1)
	FILE NAME: z10b214.bethel.xc.dgn
	IPARM FILE: z10b214xs166.1
	PLOT DATE: 3/17/2014
	DRAWN BY: W.G.P.
	CHECKED BY: J.P.S.
	SHEET 379 OF 397