




FILE NAME = Y:\P\c\p\sc\any\k2\22425\CADD\MSTN10b214.bethel.xc.dgn
 DATE/TIME = 3/17/2014
 USER = 4916

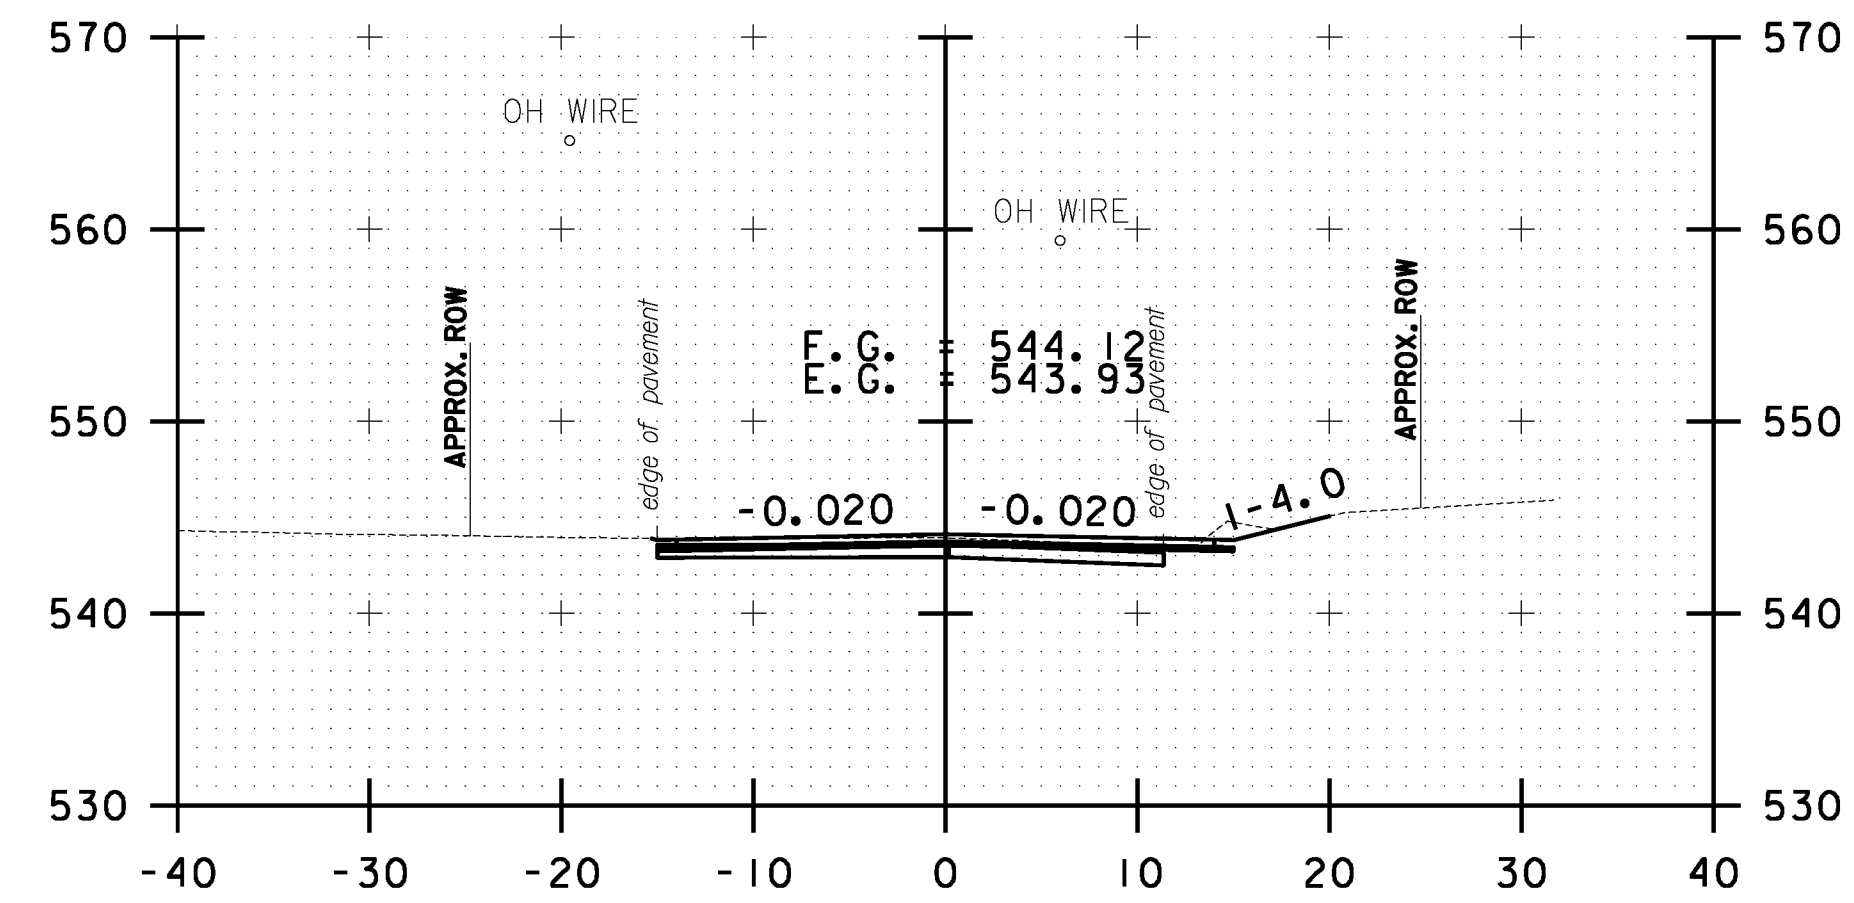


B 168+50.00

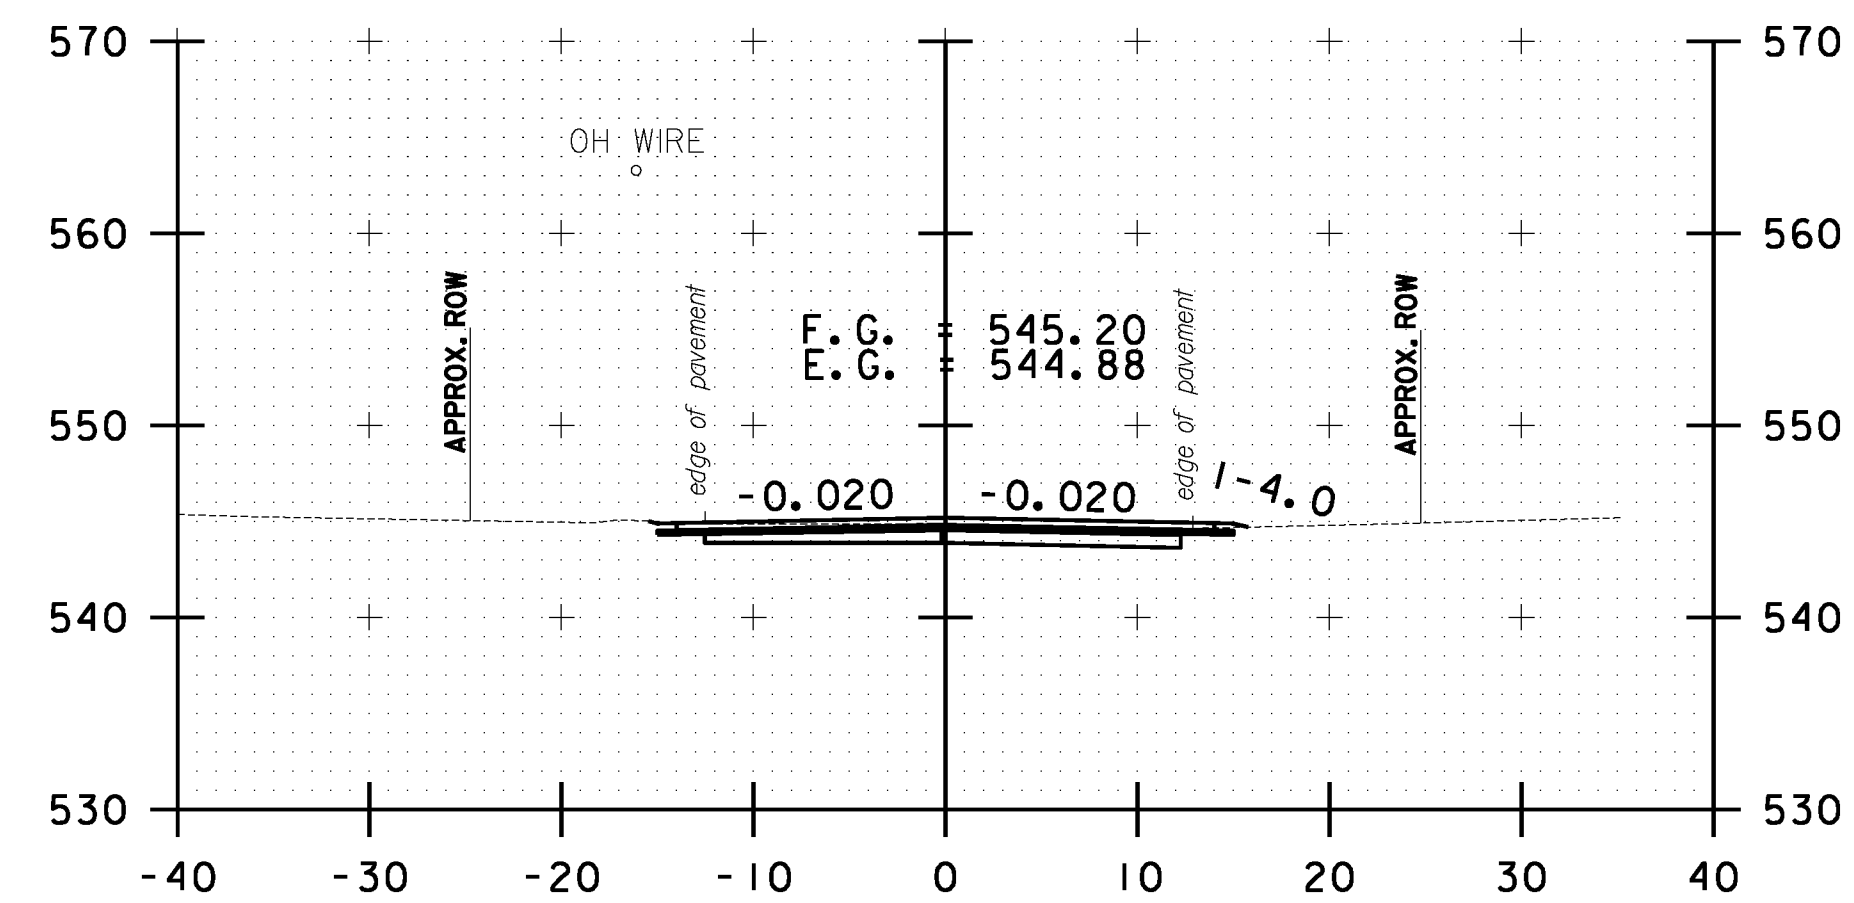


B 168+00.00

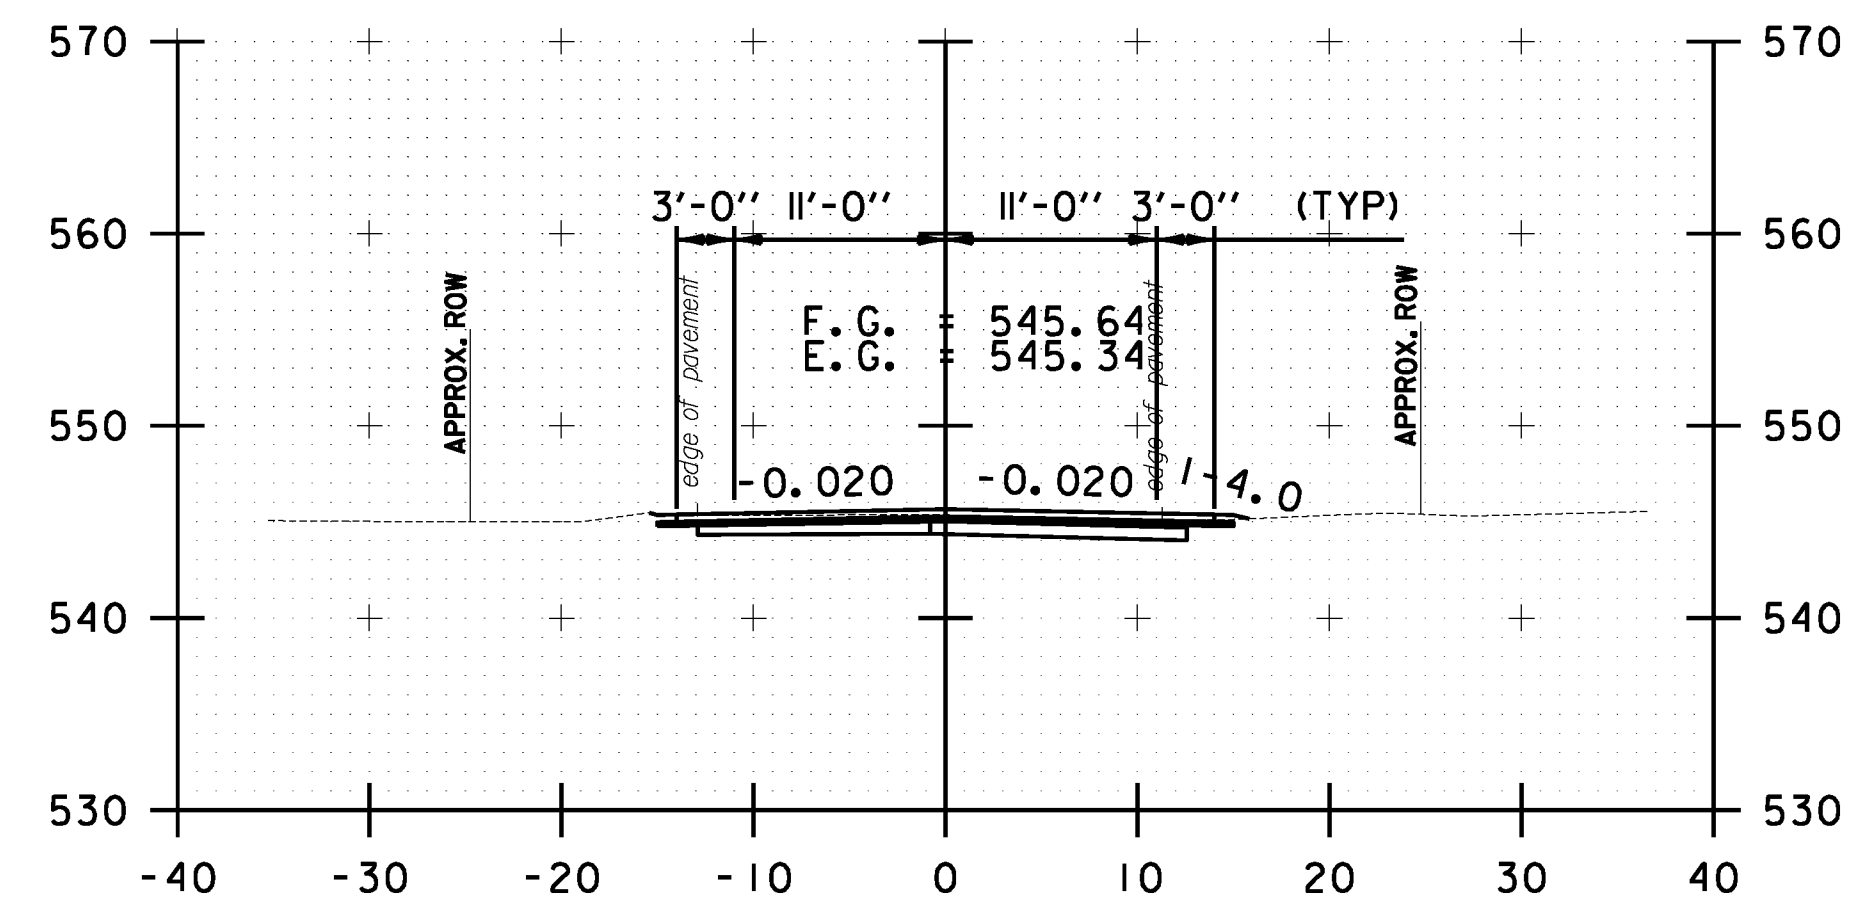


B 167+50.00

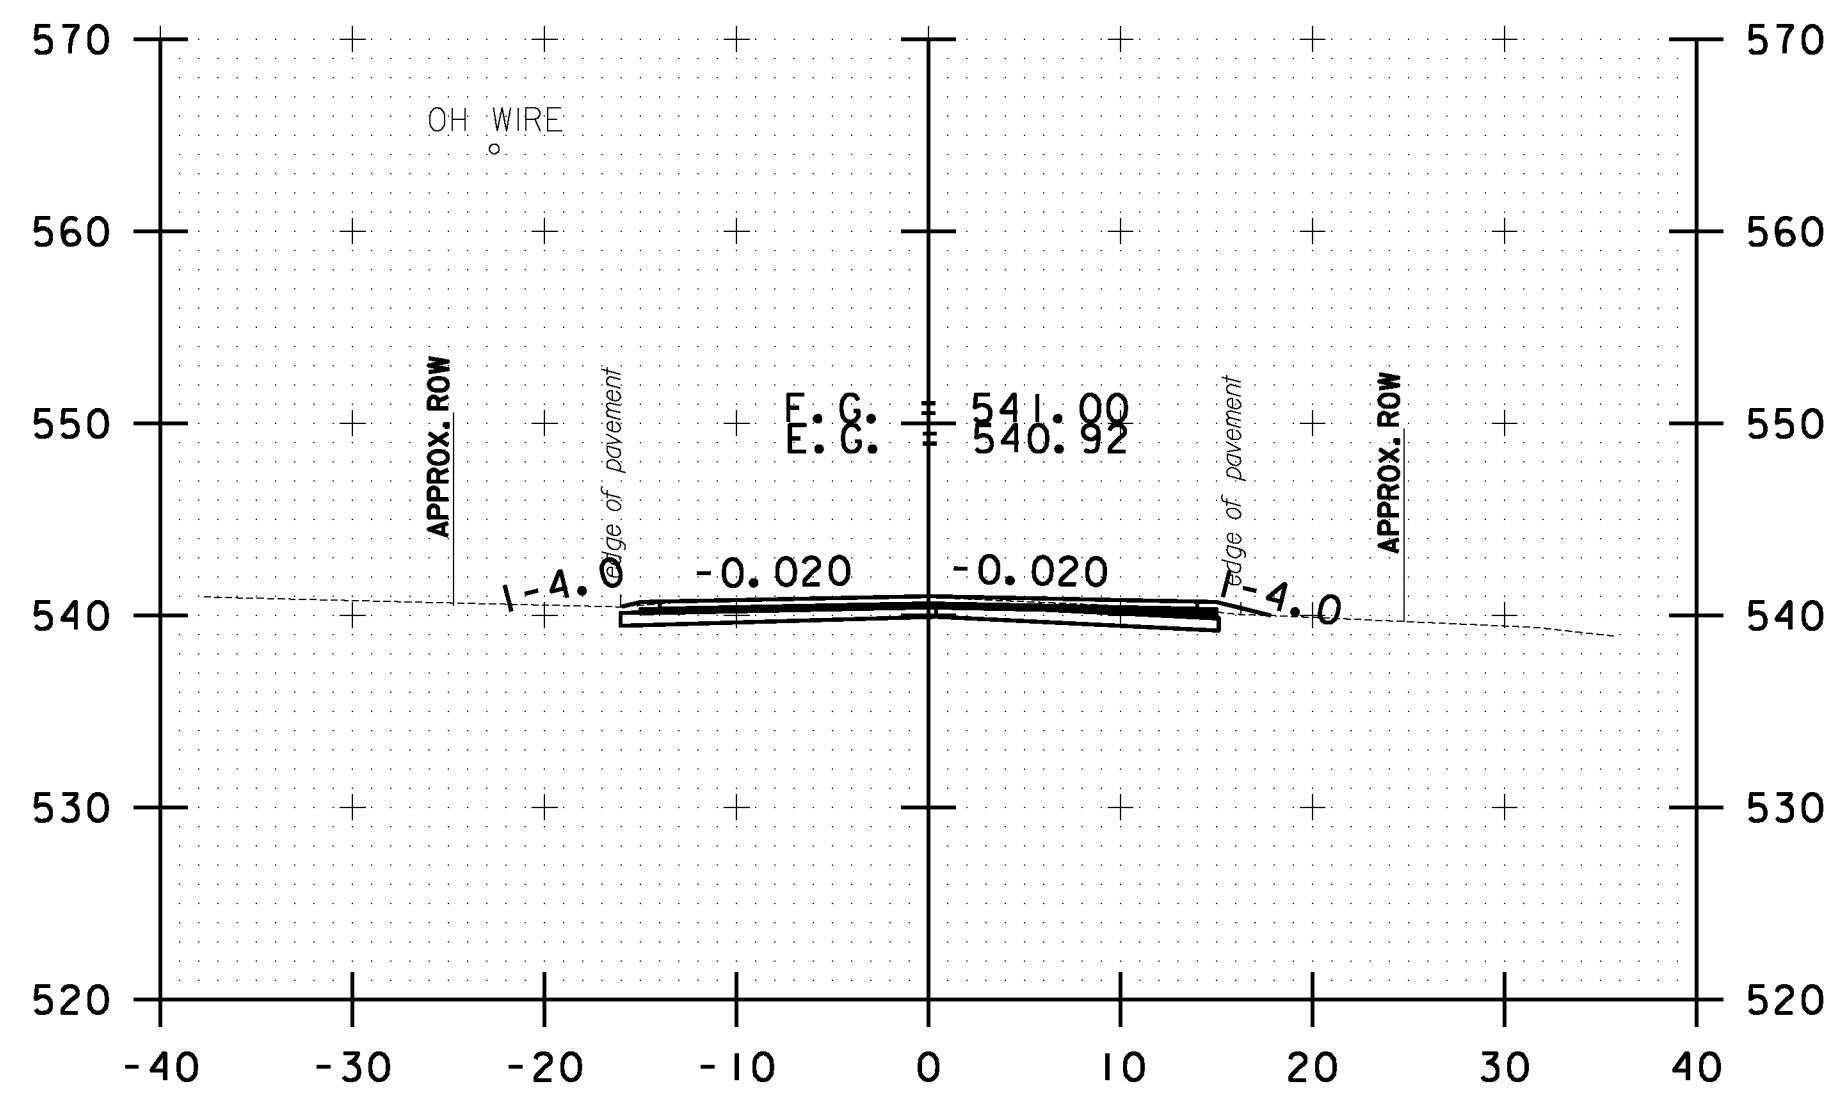


B 169+50.00

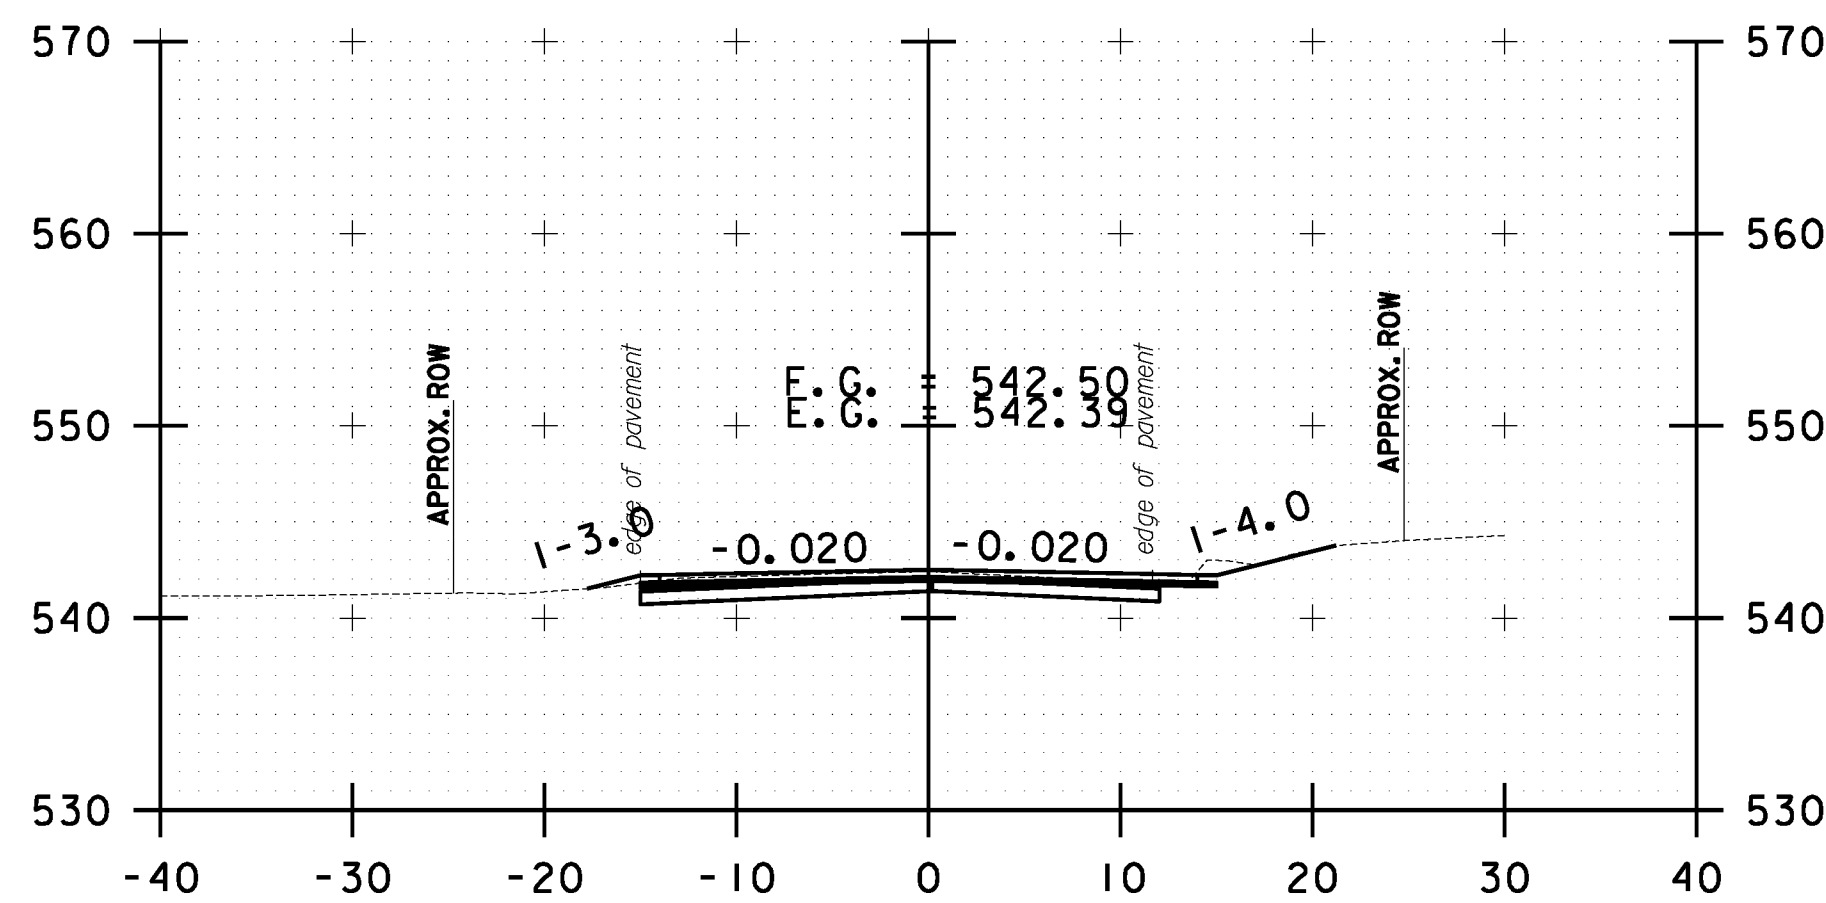


B 169+00.00

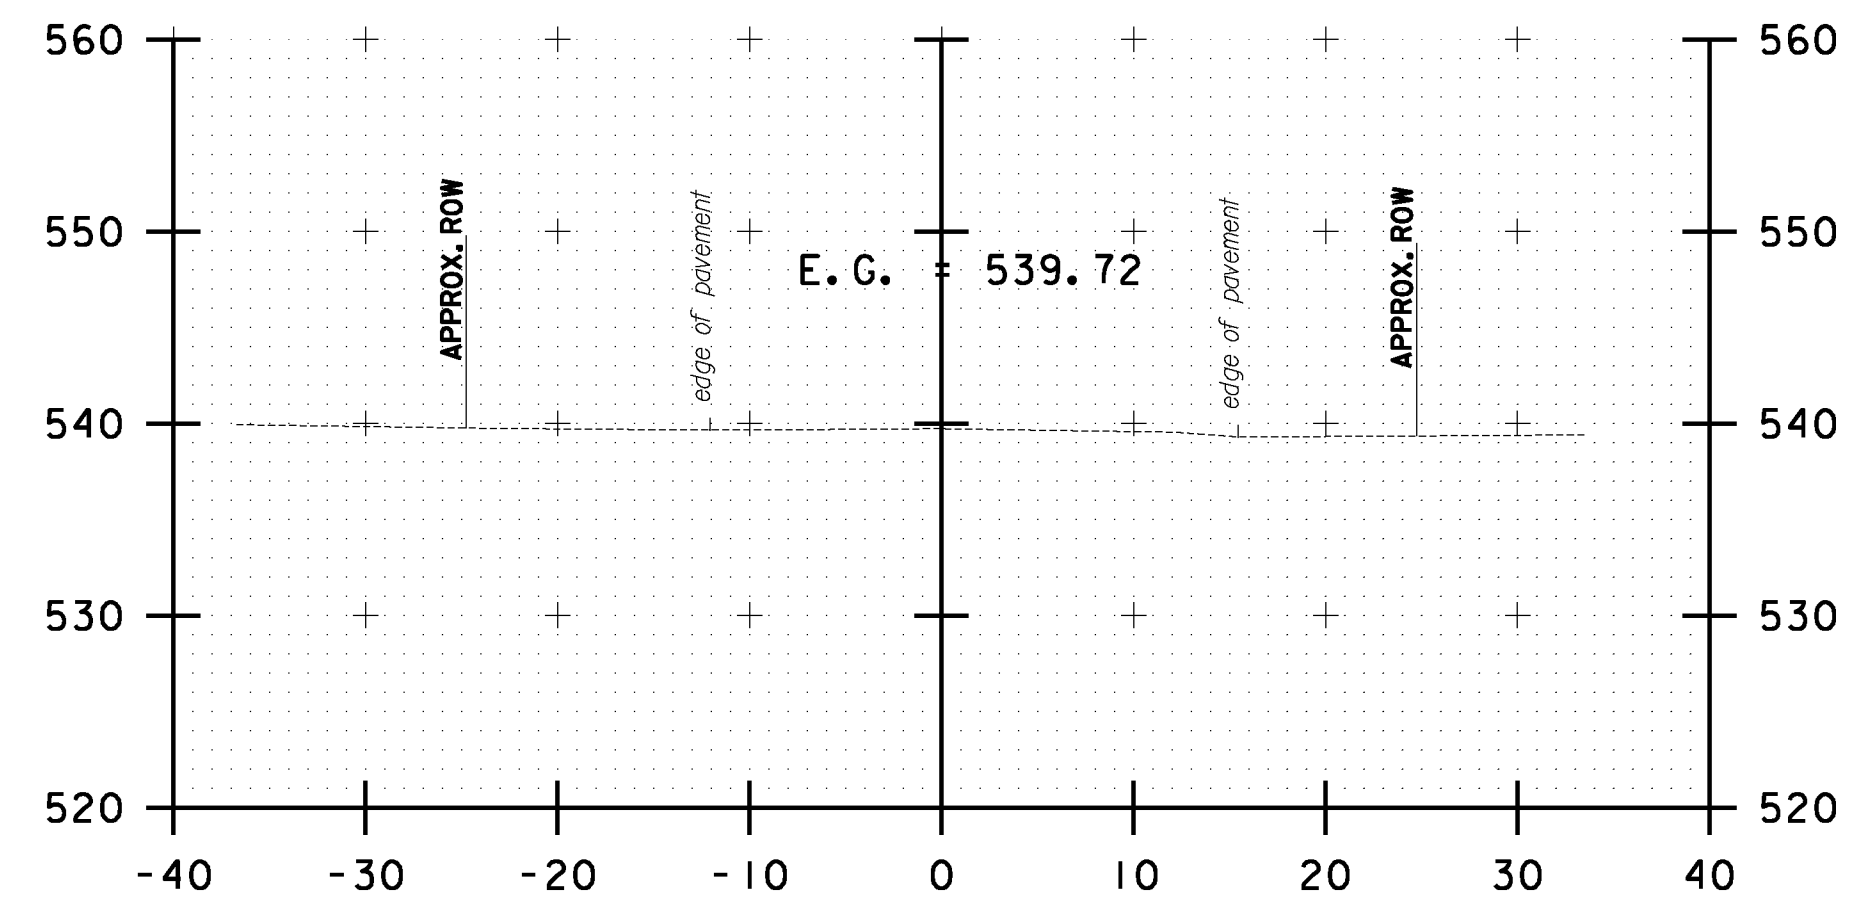

B 170+50.00

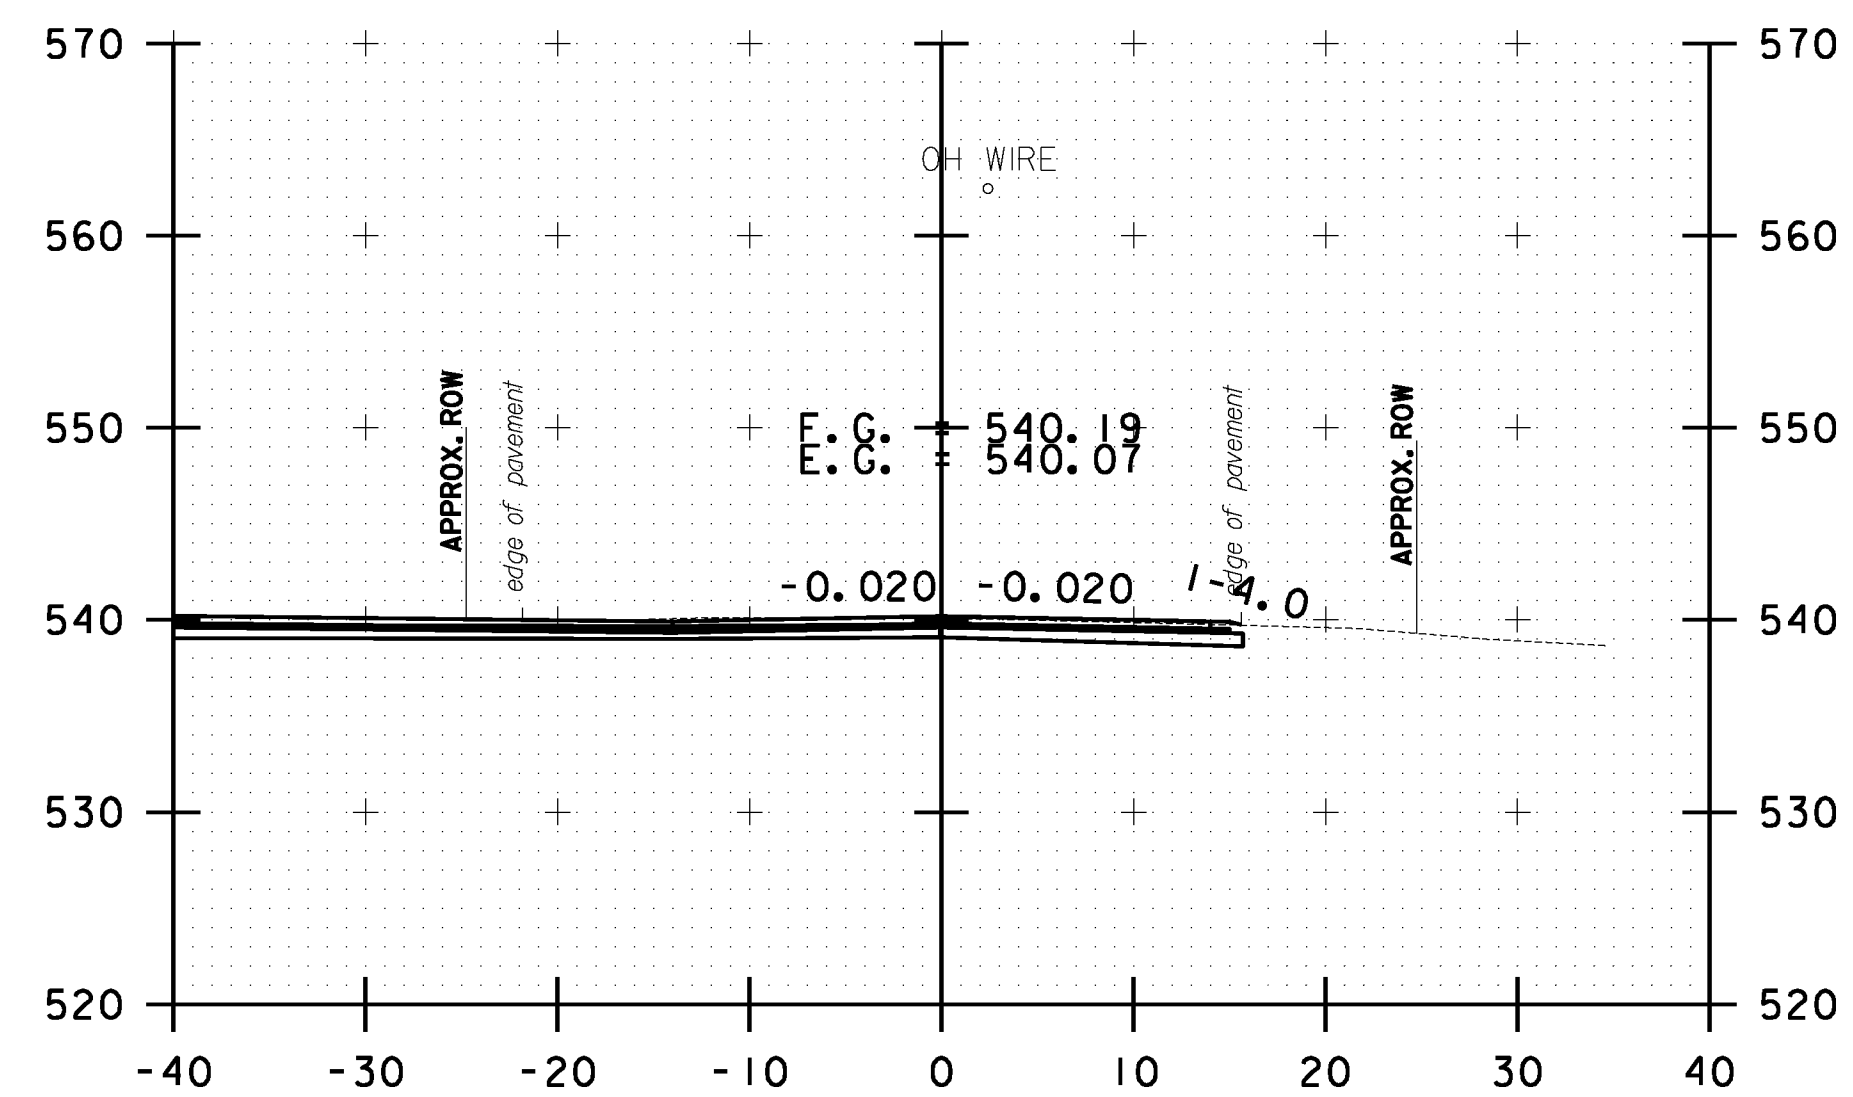

B 170+00.00

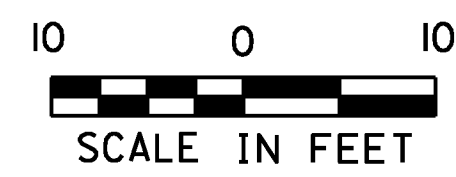

BETHEL CROSS SECTION SHEET #55	PROJECT NAME: STOCKBRIDGE-BETHEL
	PROJECT NUMBER: STP 2910(1)
	FILE NAME: z10b214.bethel.xc.dgn
	IPARM FILE: z10b214xsl67.1
	PLOT DATE: 3/17/2014
	DRAWN BY: W.C.P.
	CHECKED BY: J.P.S.
	SHEET 380 OF 397