



V 10+50.00

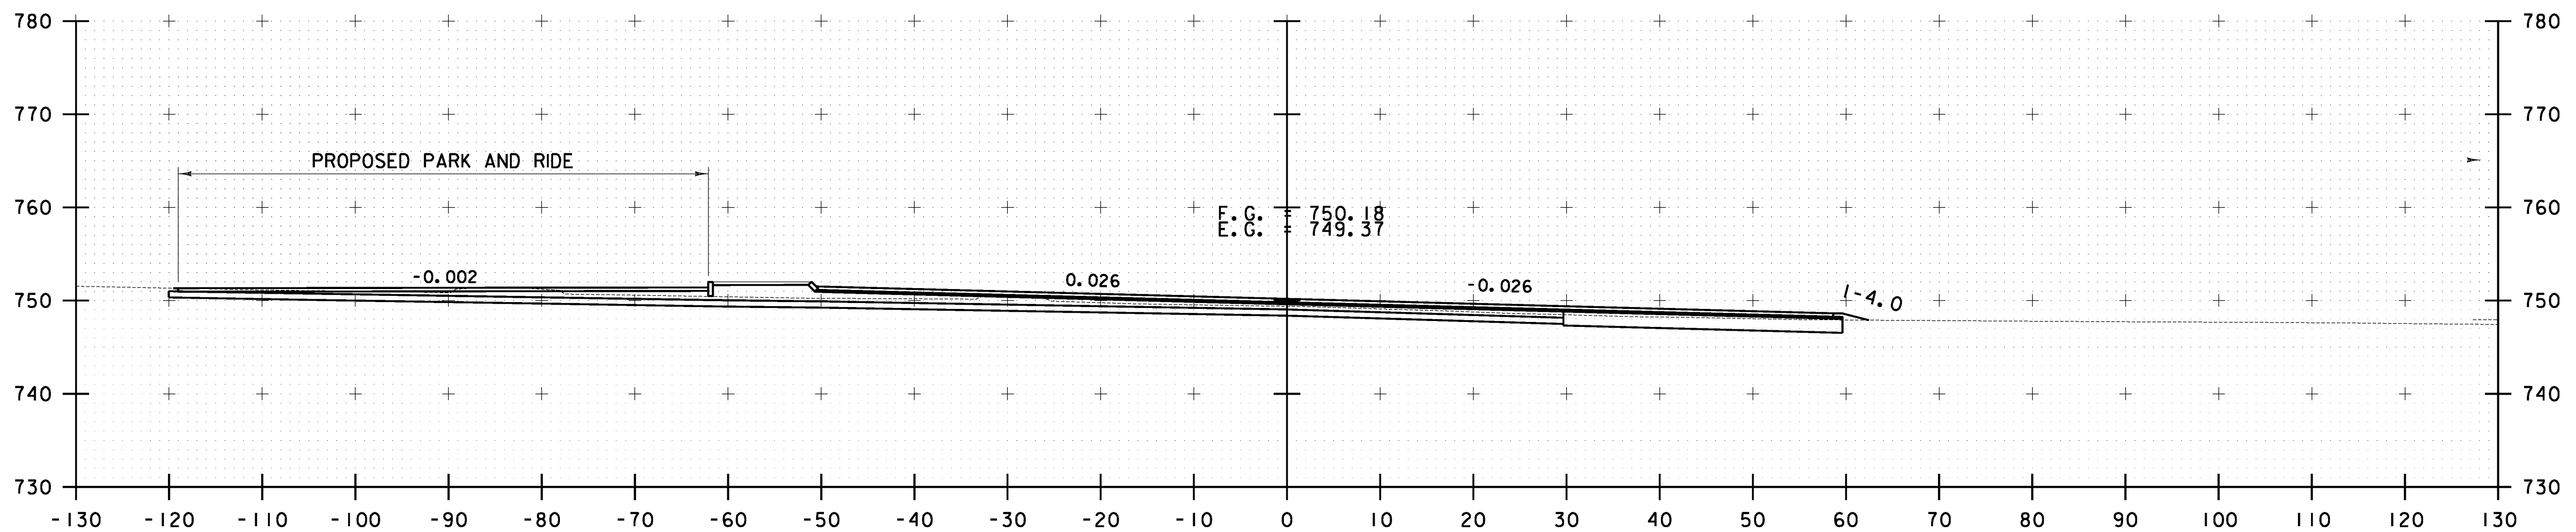

V 10+25.00

FILE NAME: Y:\P\c\sect\ANY\K2\22425\CA001\MSTN\10b214\_xsect\_v+100.dgn  
 DATE/TIME: 3/17/2014 4:16  
 USER: jps

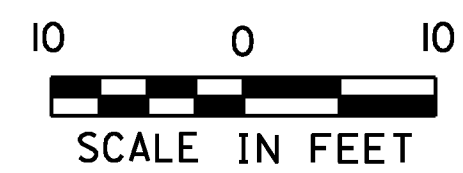

|  |                                    |
|--|------------------------------------|
| <b>VT ROUTE 100<br/>CROSS SECTION<br/>SHEET #1</b> | PROJECT NAME: STOCKBRIDGE-BETHEL   |
|  | PROJECT NUMBER: STP 2910(1)        |
|  | FILE NAME: z10b214_xsect_v+100.dgn |
| DESIGNED BY: L.M.B.                                | PLOT DATE: 3/17/2014               |
| IPARM FILE: z10b214xsl67.i                         | DRAWN BY: W.G.P.                   |
|  | CHECKED BY: J.P.S.                 |
|  | SHEET 381 OF 397                   |