


FILE NAME = \\172\projects\10b214\10b214\_bdt\_03.dgn  
 DATE TIME = 3/17/2014 4:49:16  
 USER = jlp

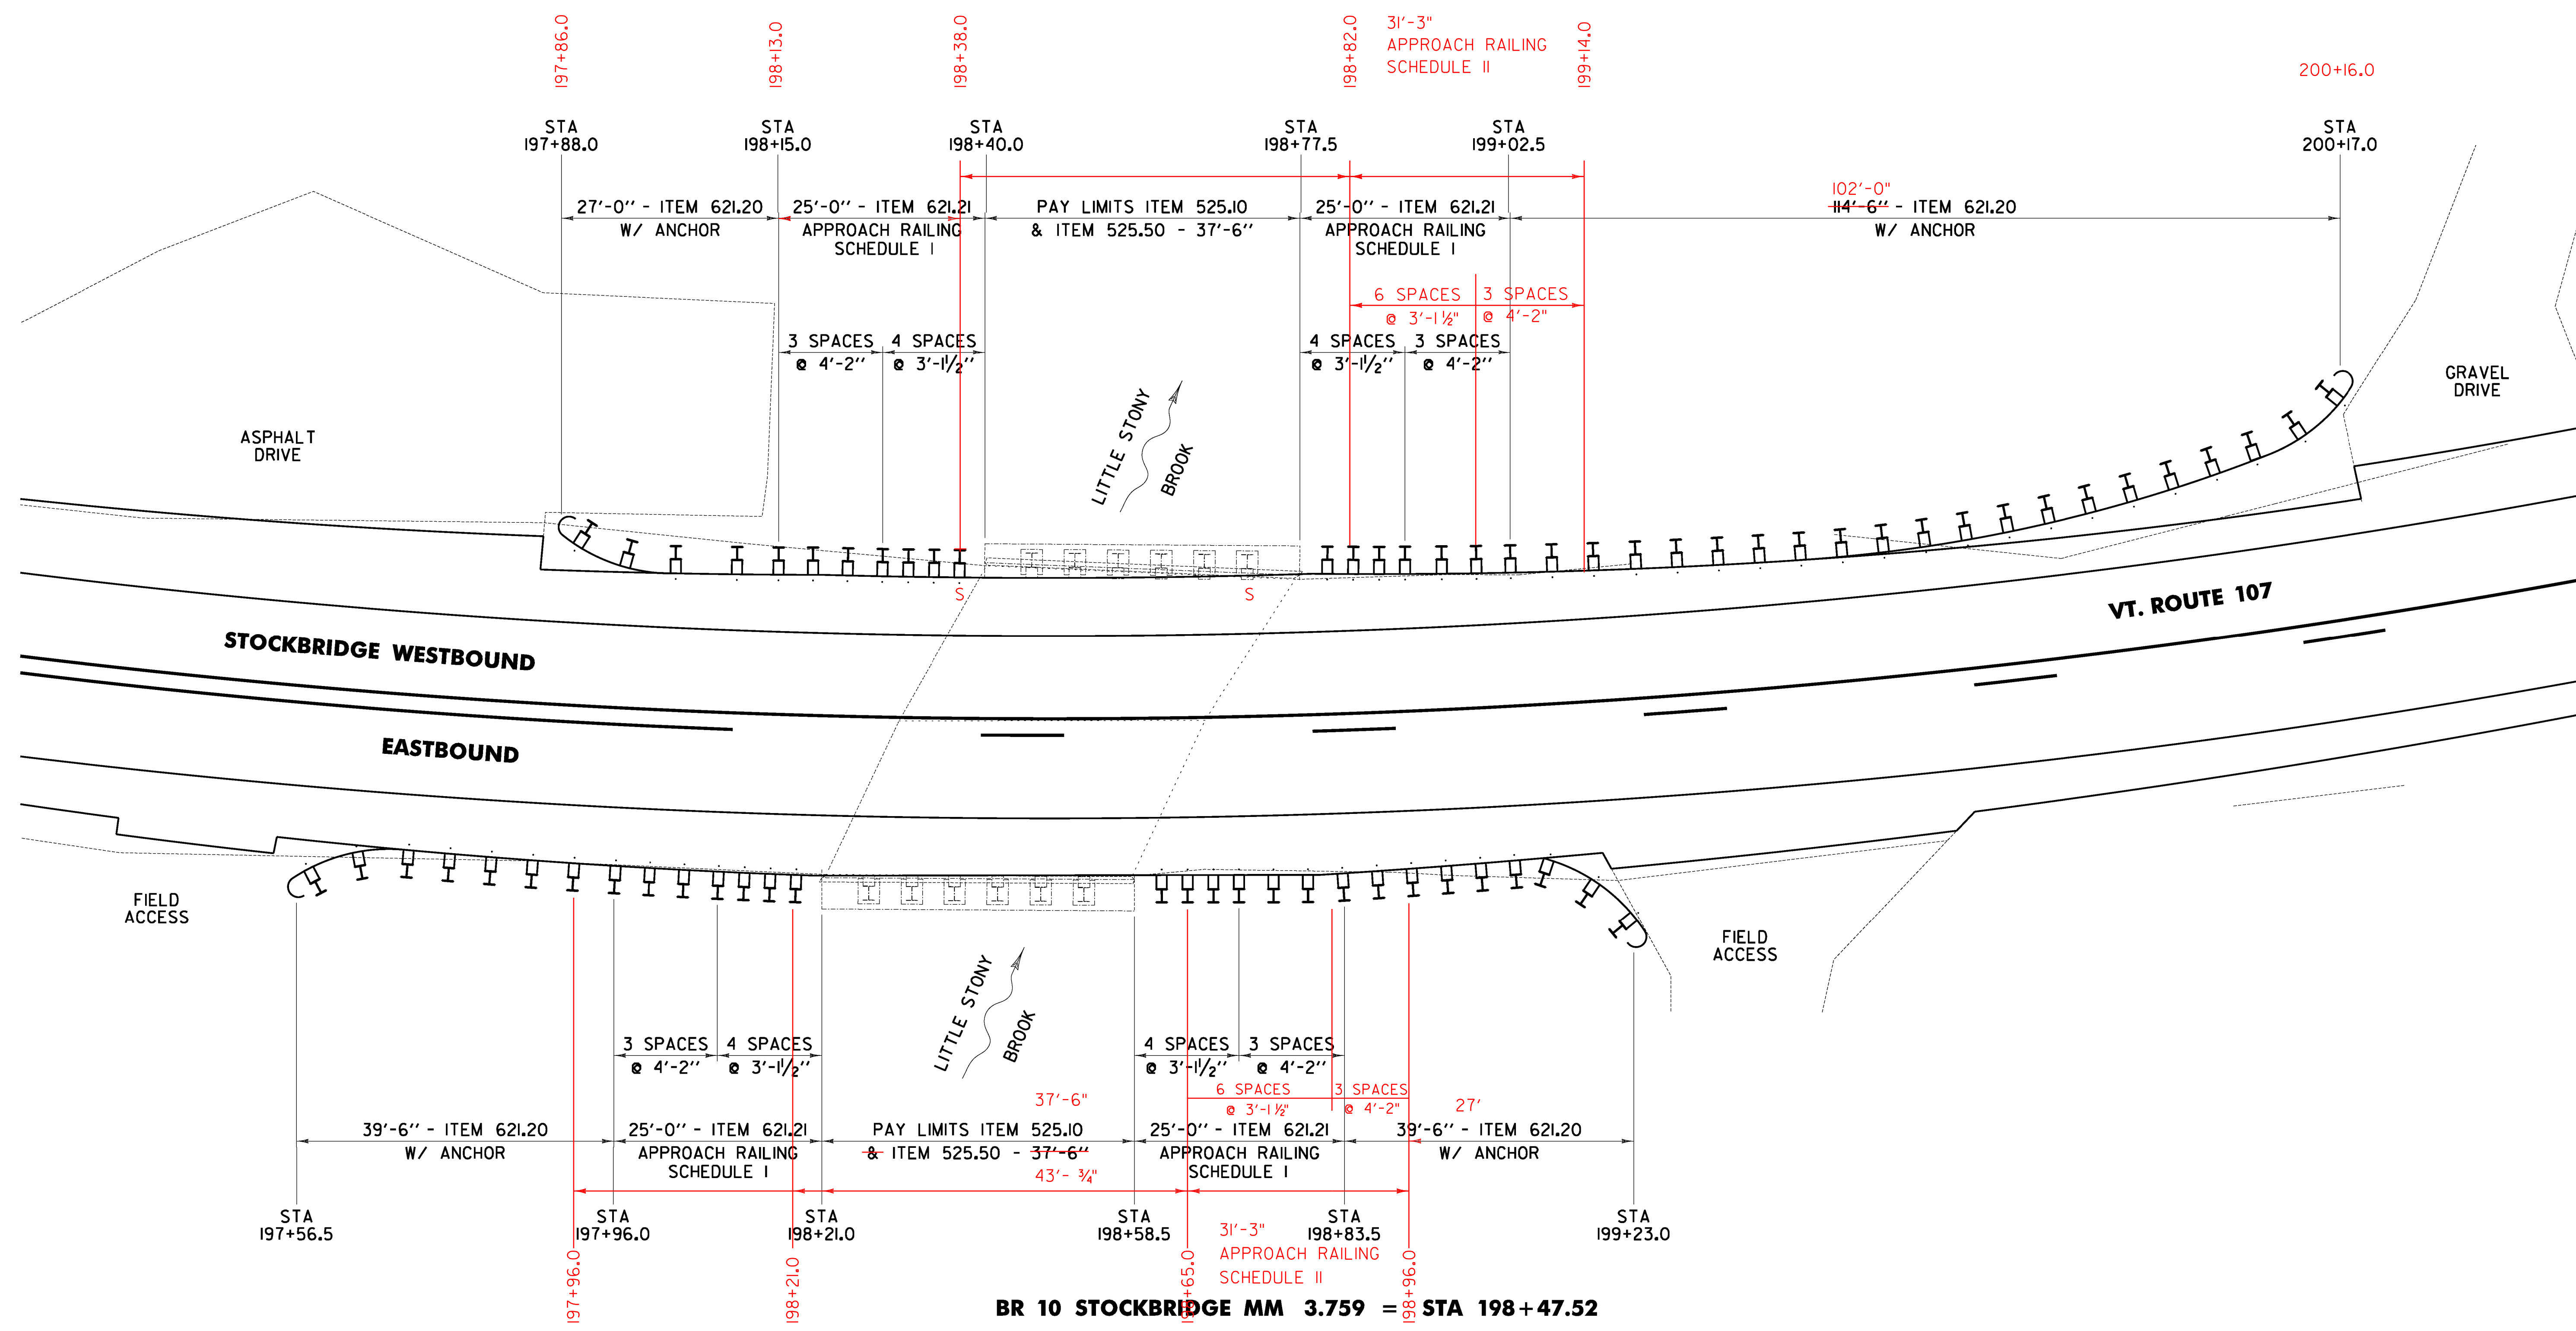

<b>NOT TO SCALE</b>	
<b>BRIDGE DETAIL SHEET #3</b>	PROJECT NAME: STOCKBRIDGE-BETHEL
	PROJECT NUMBER: STP 2910(1)
	FILE NAME: z10b214_bdt_03.dgn
	IPARM FILE: z10b214bd+3.i
	PLOT DATE: 3/17/2014
	DRAWN BY: W.G.P.
	CHECKED BY: J.P.S.
	SHEET 396 OF 397