


FILE NAME = \\157\projects\10b214\10b214\_bdt\_04.dgn  
 DATE/TIME = 3/17/2014 1:49:16  
 USER = jlp

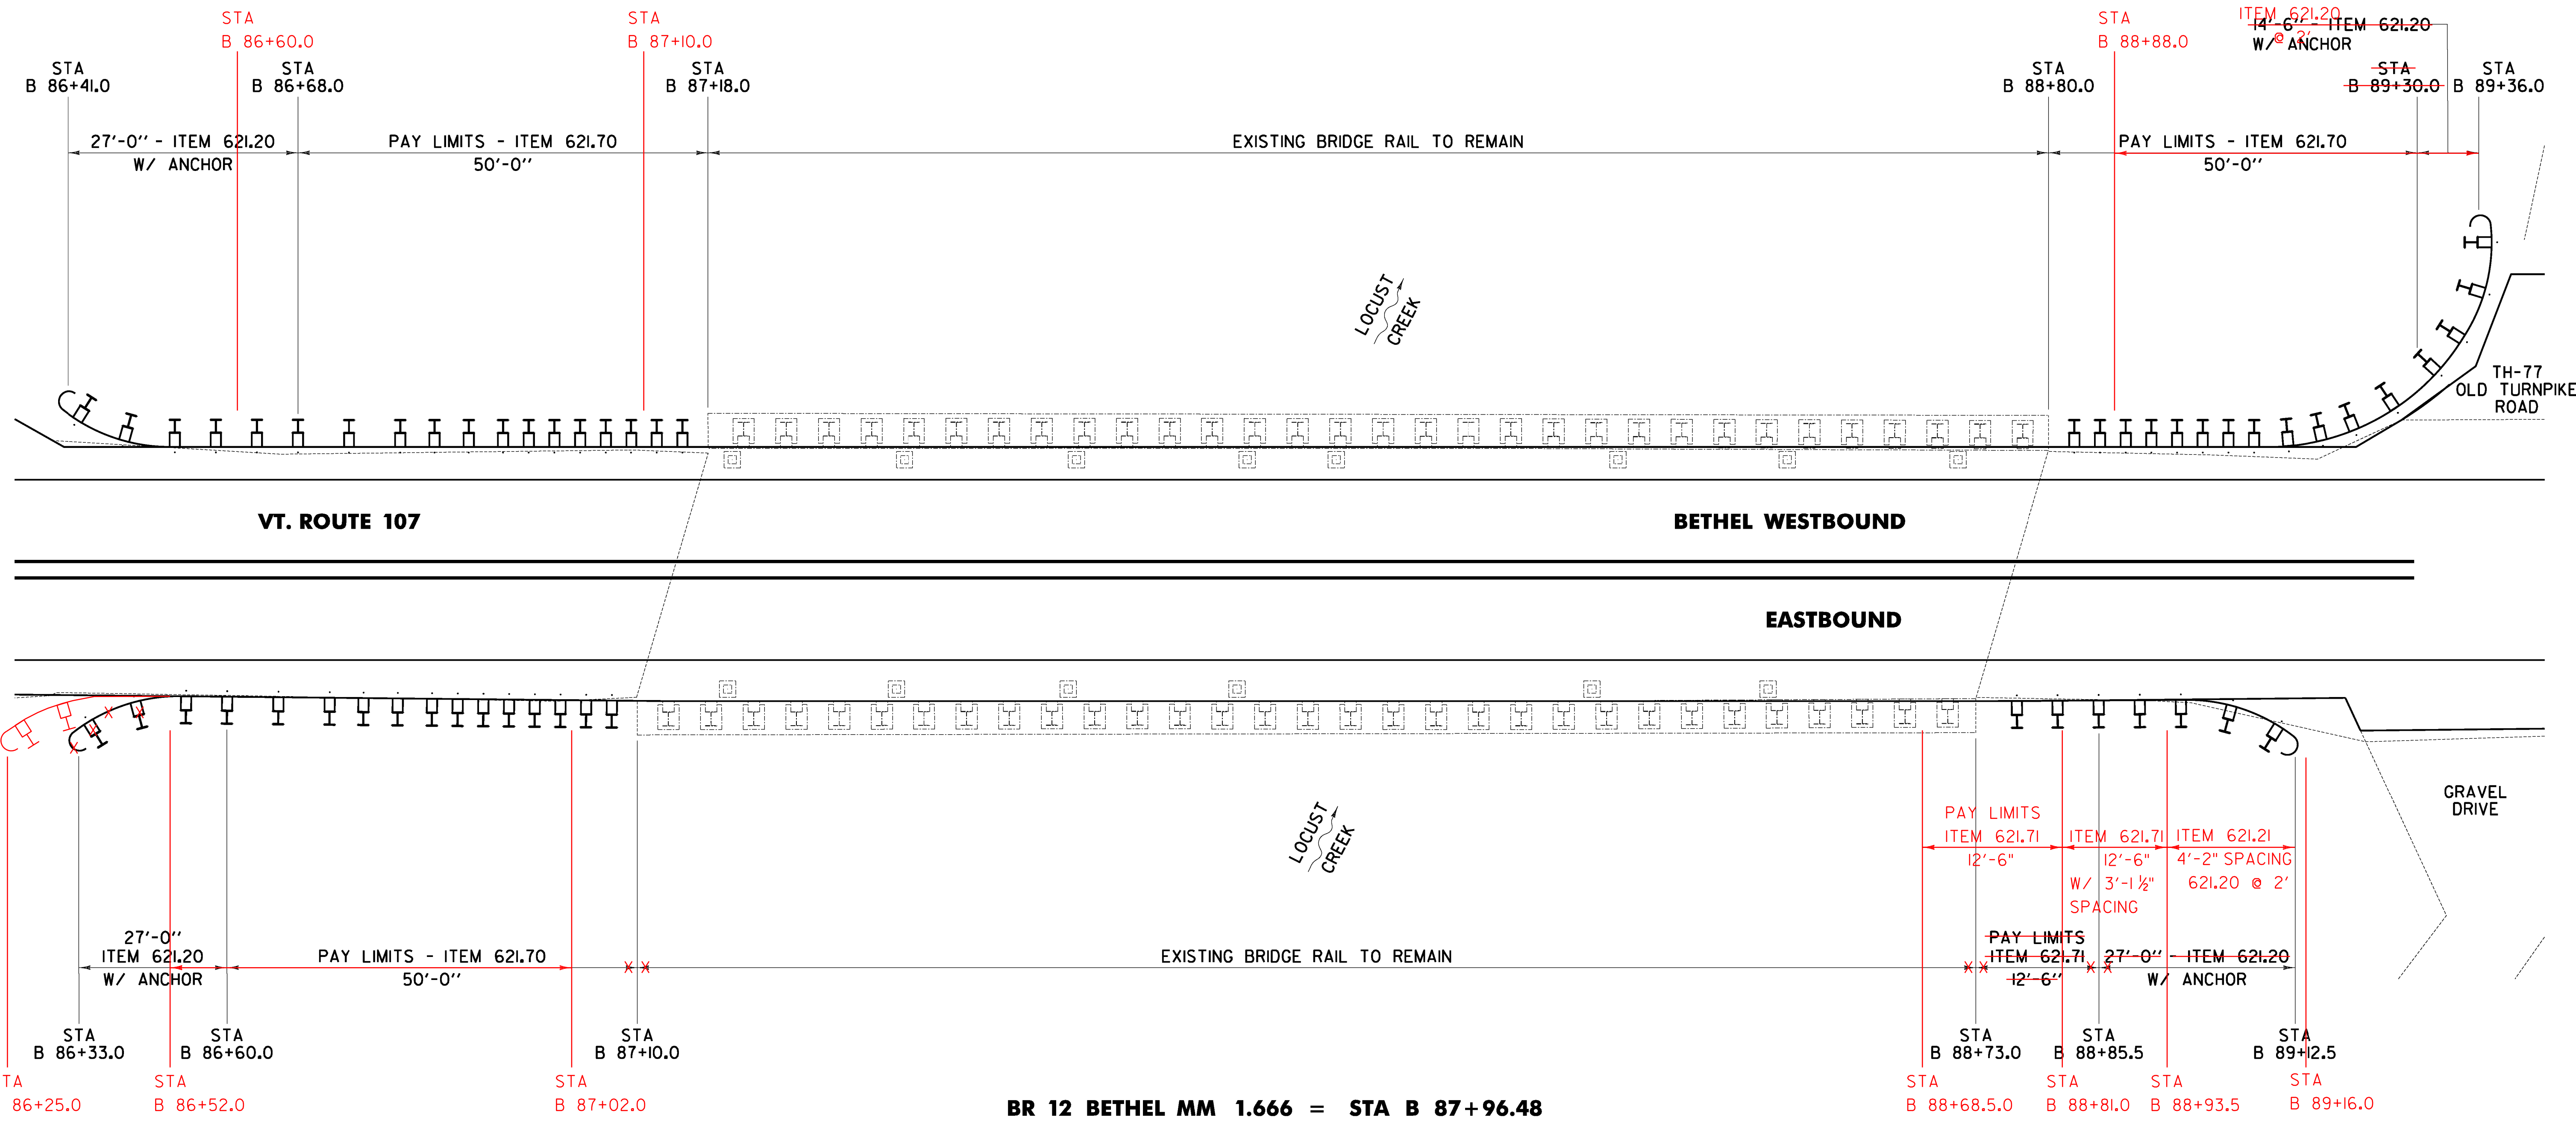

**BR 12 BETHEL MM 1.666 = STA B 87+96.48**

<b>BRIDGE DETAIL SHEET #4</b>	<b>NOT TO SCALE</b>	
	PROJECT NAME: STOCKBRIDGE-BETHEL	
	PROJECT NUMBER: STP 2910(1)	
FILE NAME: z10b214_bdt_04.dgn	PROJECT LEADER: D.E.G.	PLOT DATE: 3/17/2014
DESIGNED BY: L.M.B.	CHECKED BY: J.P.S.	DRAWN BY: W.G.P.
IPARM FILE: z10b214bd+4.i	SHEET 397 OF 397	