
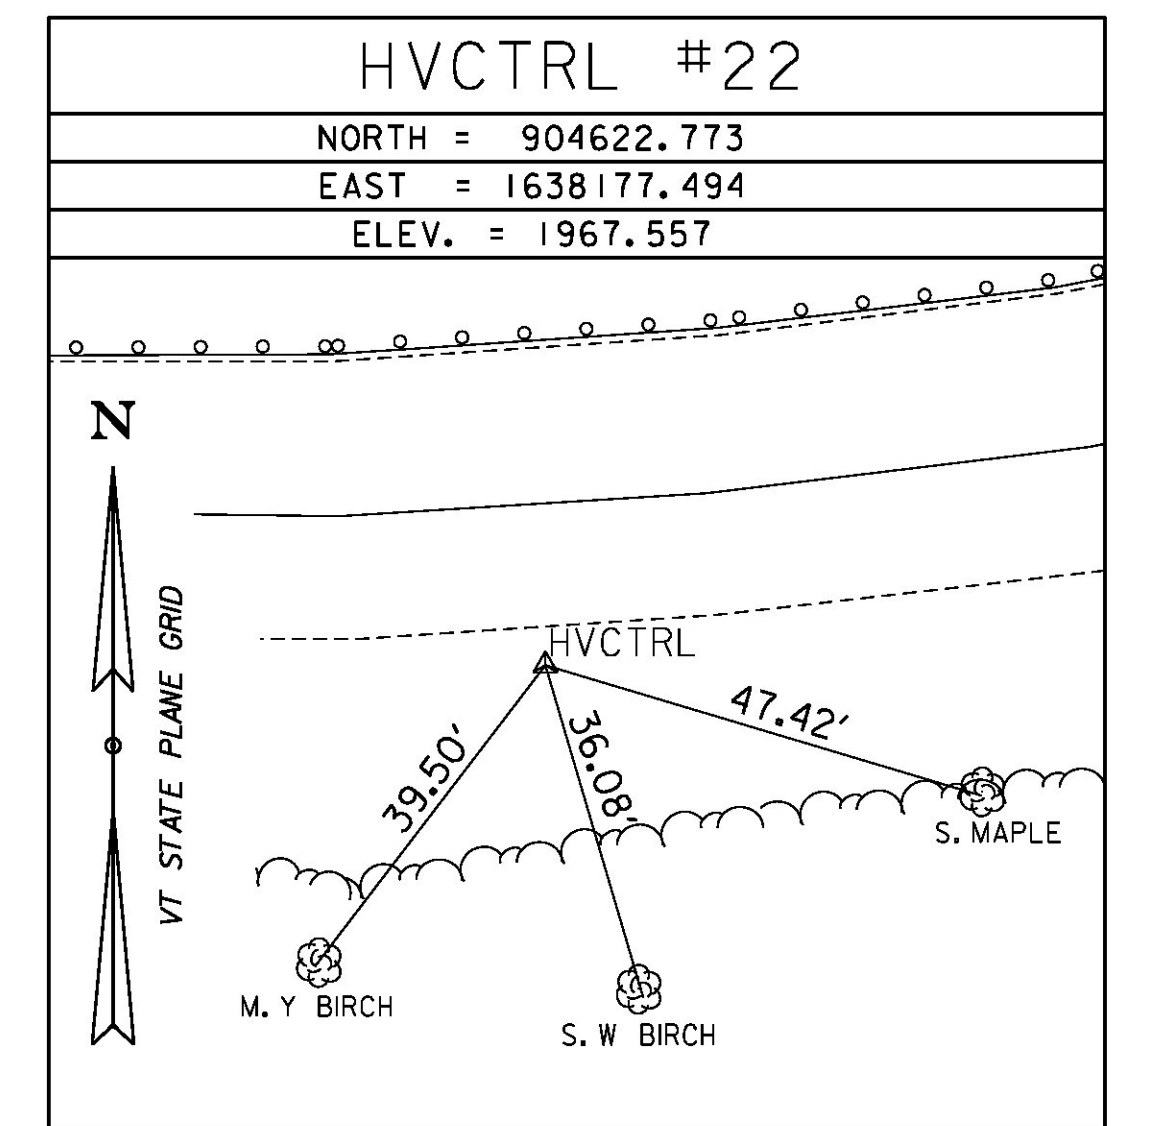
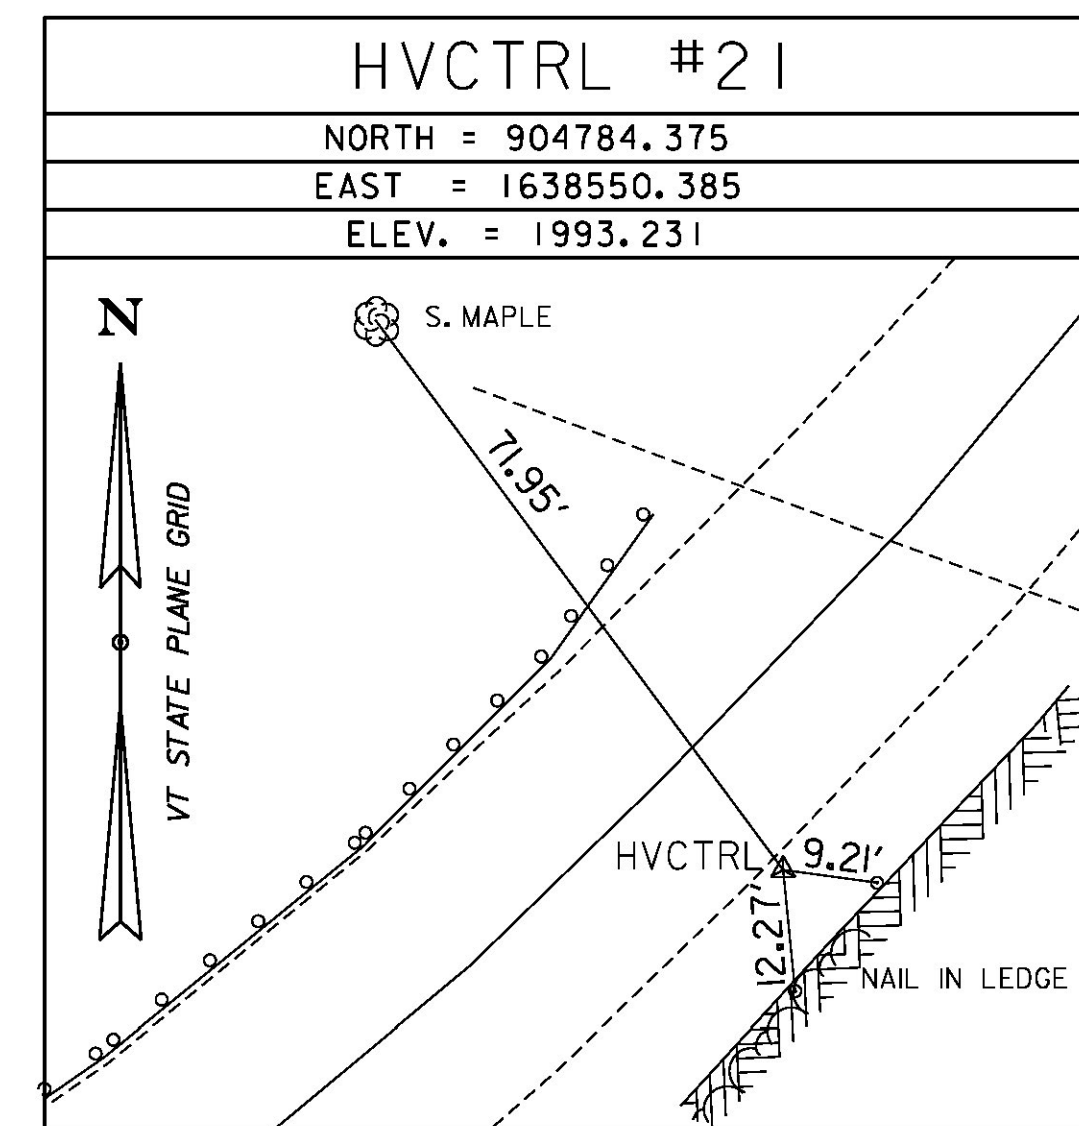
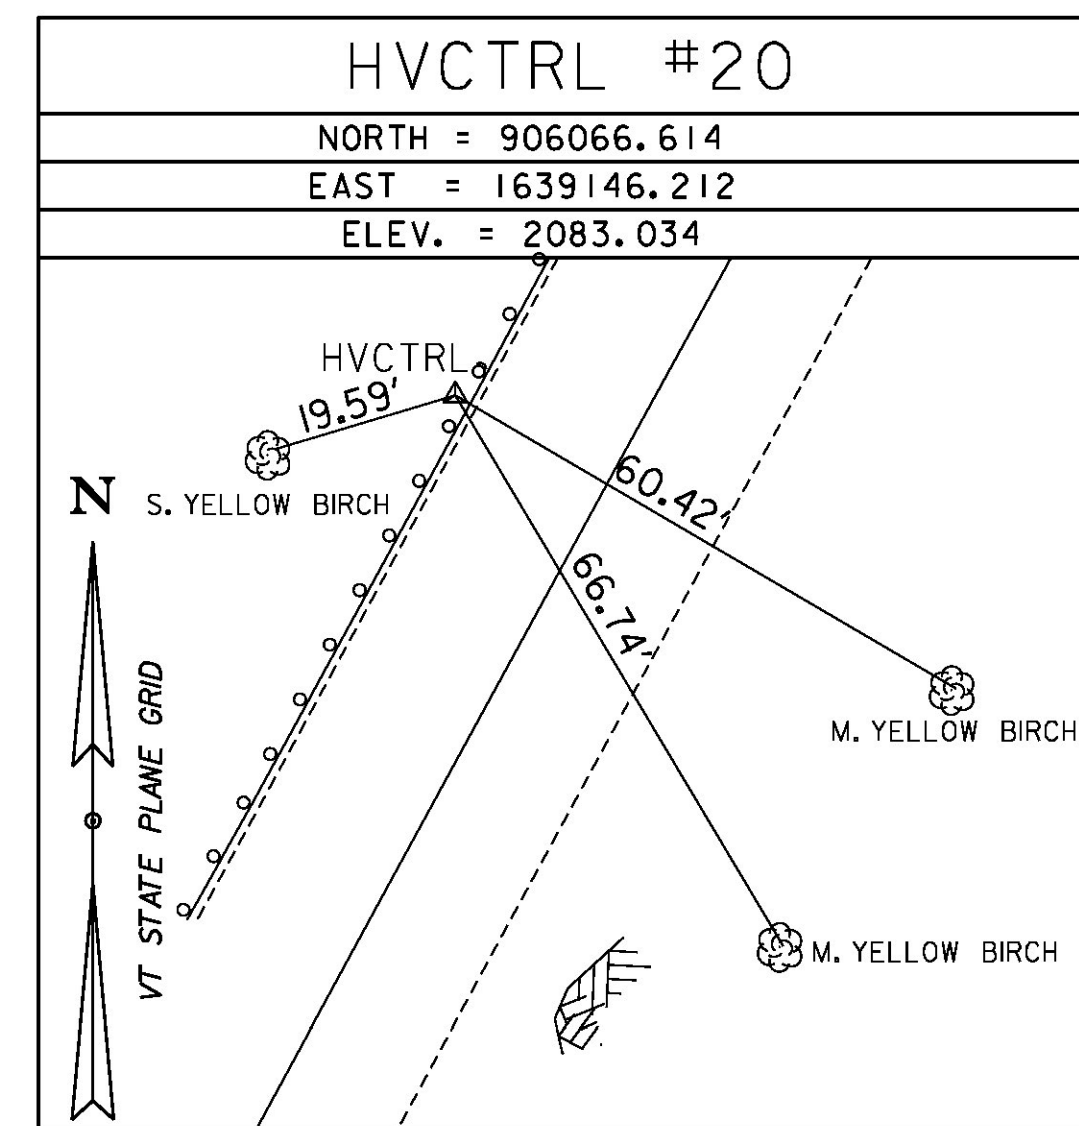
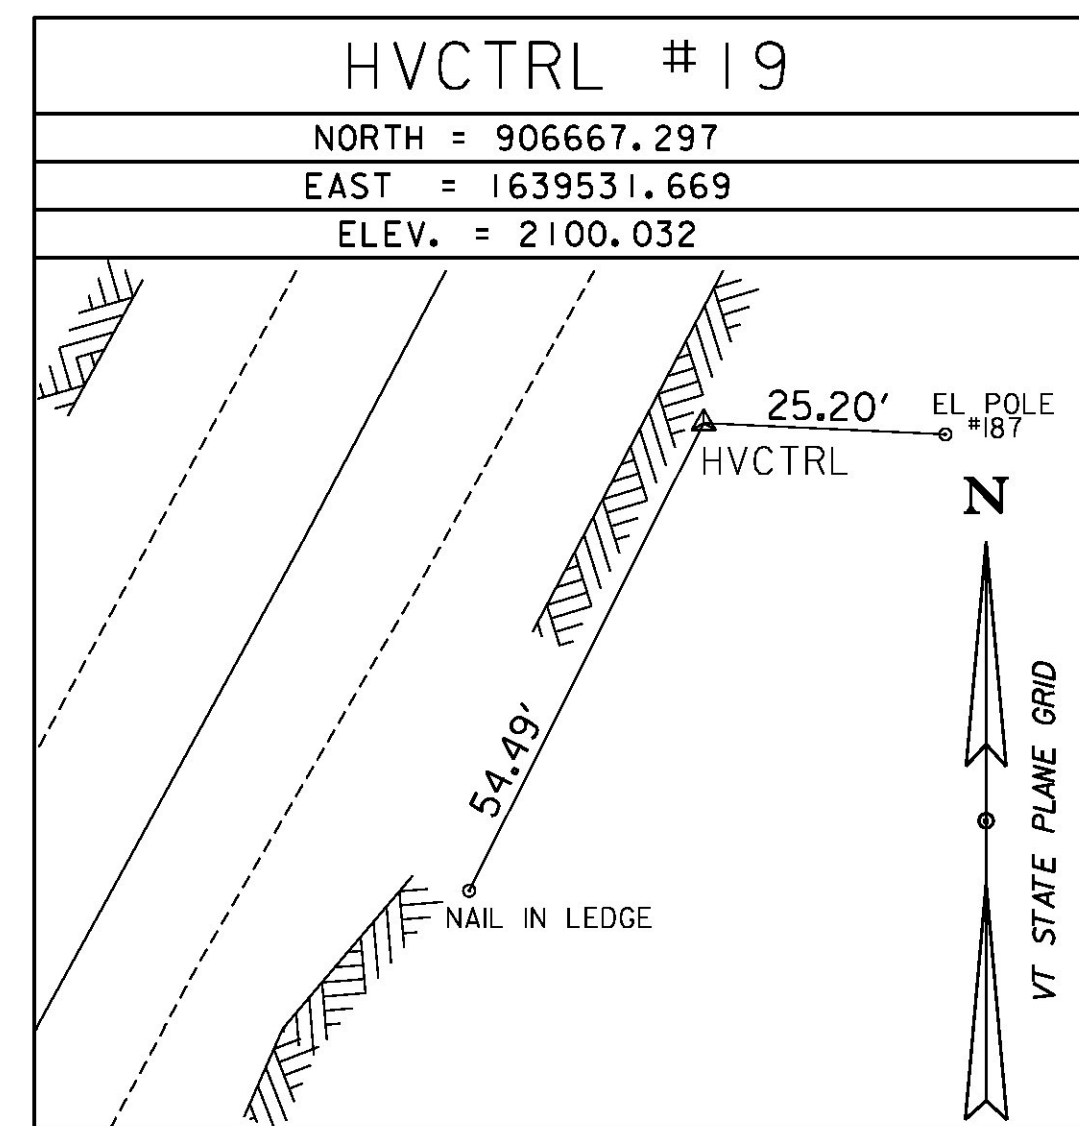


GPS CONTROL POINTS

TRAVERSE TIES

ALIGNMENT TIES

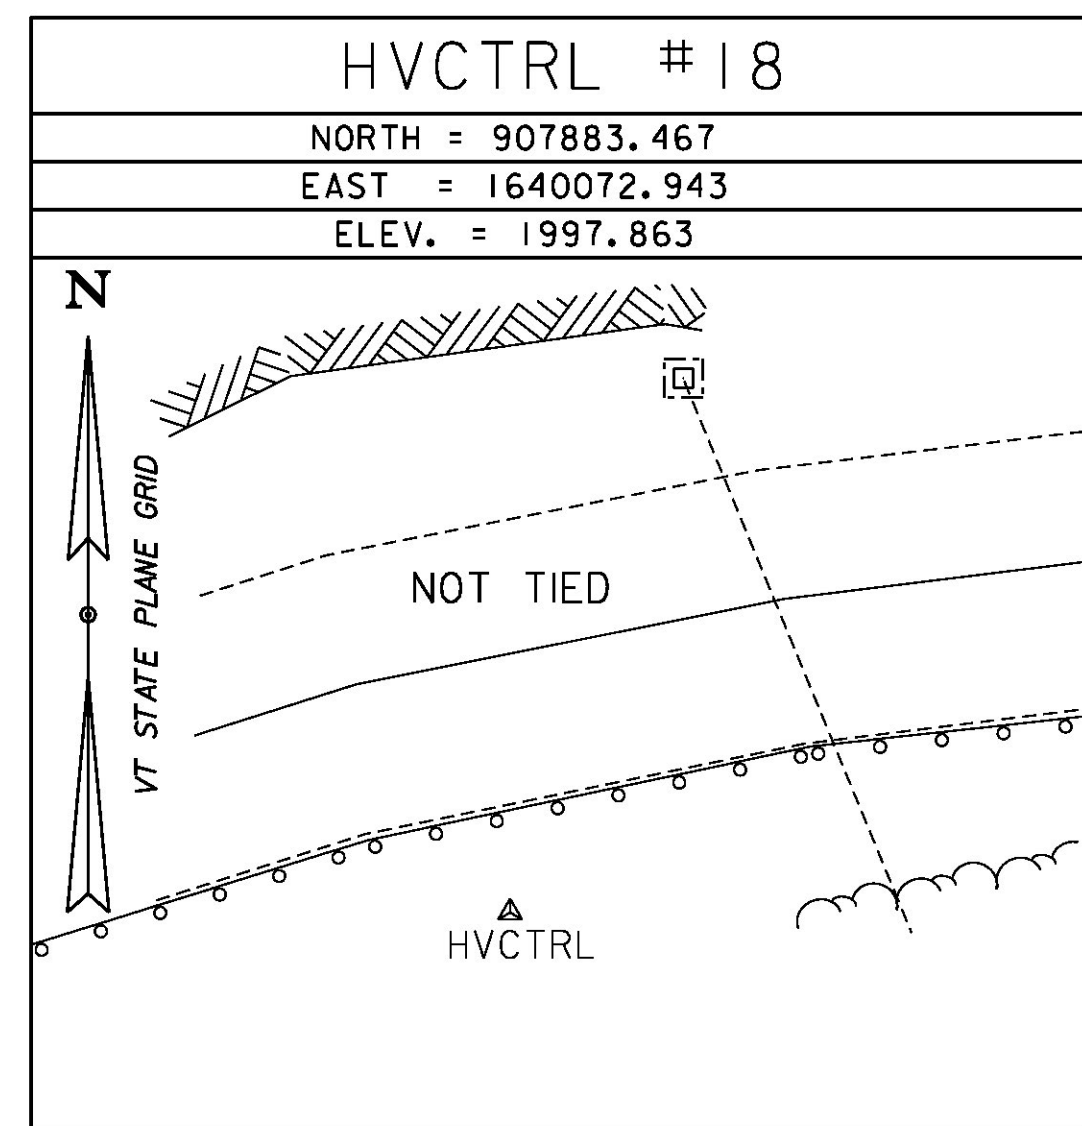

NORTH =
EAST =
ELEV. =

NORTH =
EAST =
ELEV. =

DATUM	
VERTICAL	NAVD 88
HORIZONTAL	NAD 83 (2007)
ADJUSTMENT	COMPASS

PROJECT NAME:	JAY-TROY
PROJECT NUMBER:	STP 2915(I)
FILE NAME:	M:\0b232\Survey\10b232\1
PROJECT LEADER:	M. FOWLER
DESIGNED BY:	VTrans
TIE SHEET	4
PLOT DATE:	5/16/2014
DRAWN BY:	S. DONOVAN
CHECKED BY:	M. FOWLER
SHEET	7 OF 244