
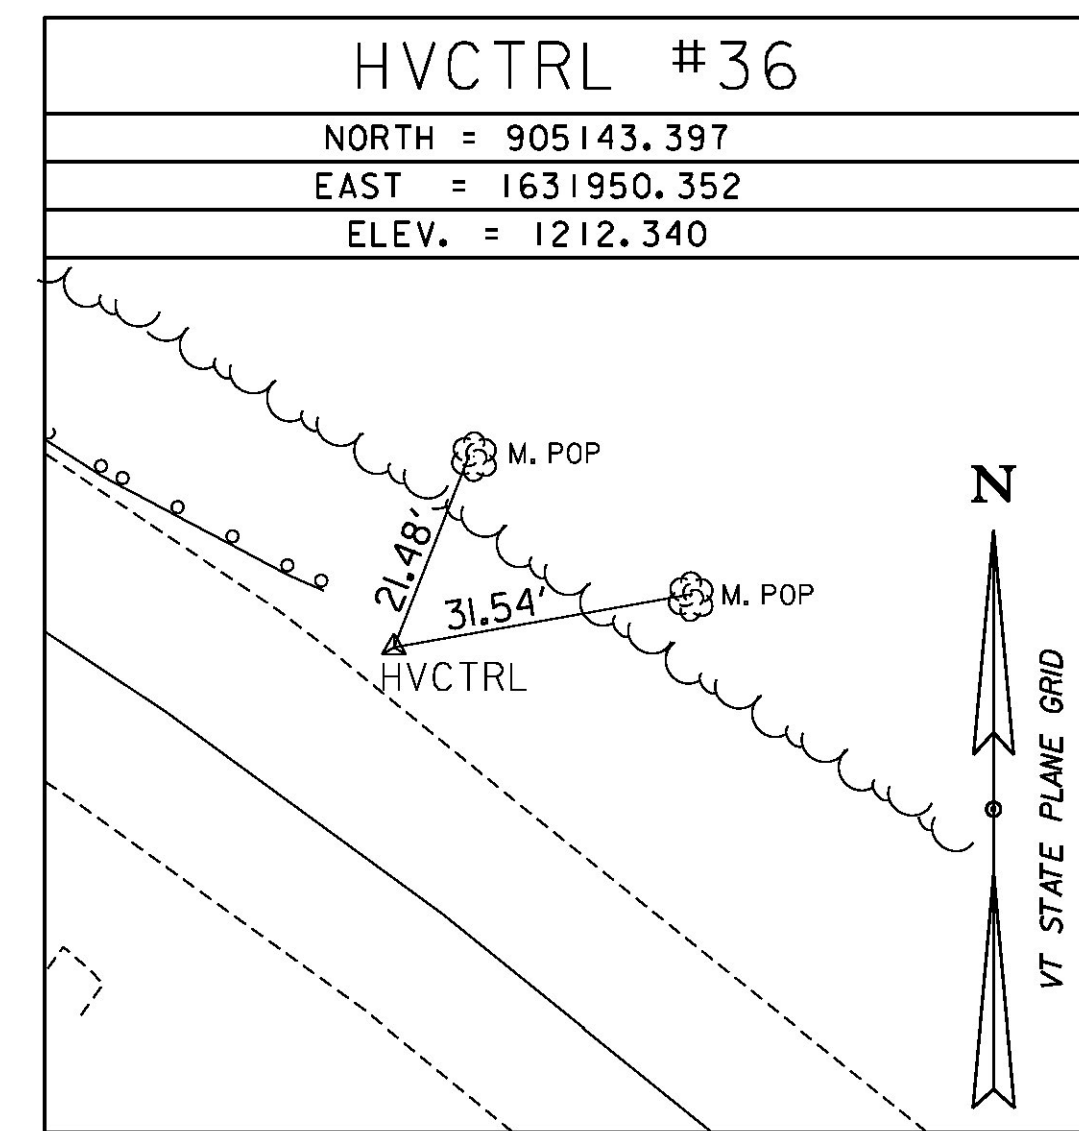
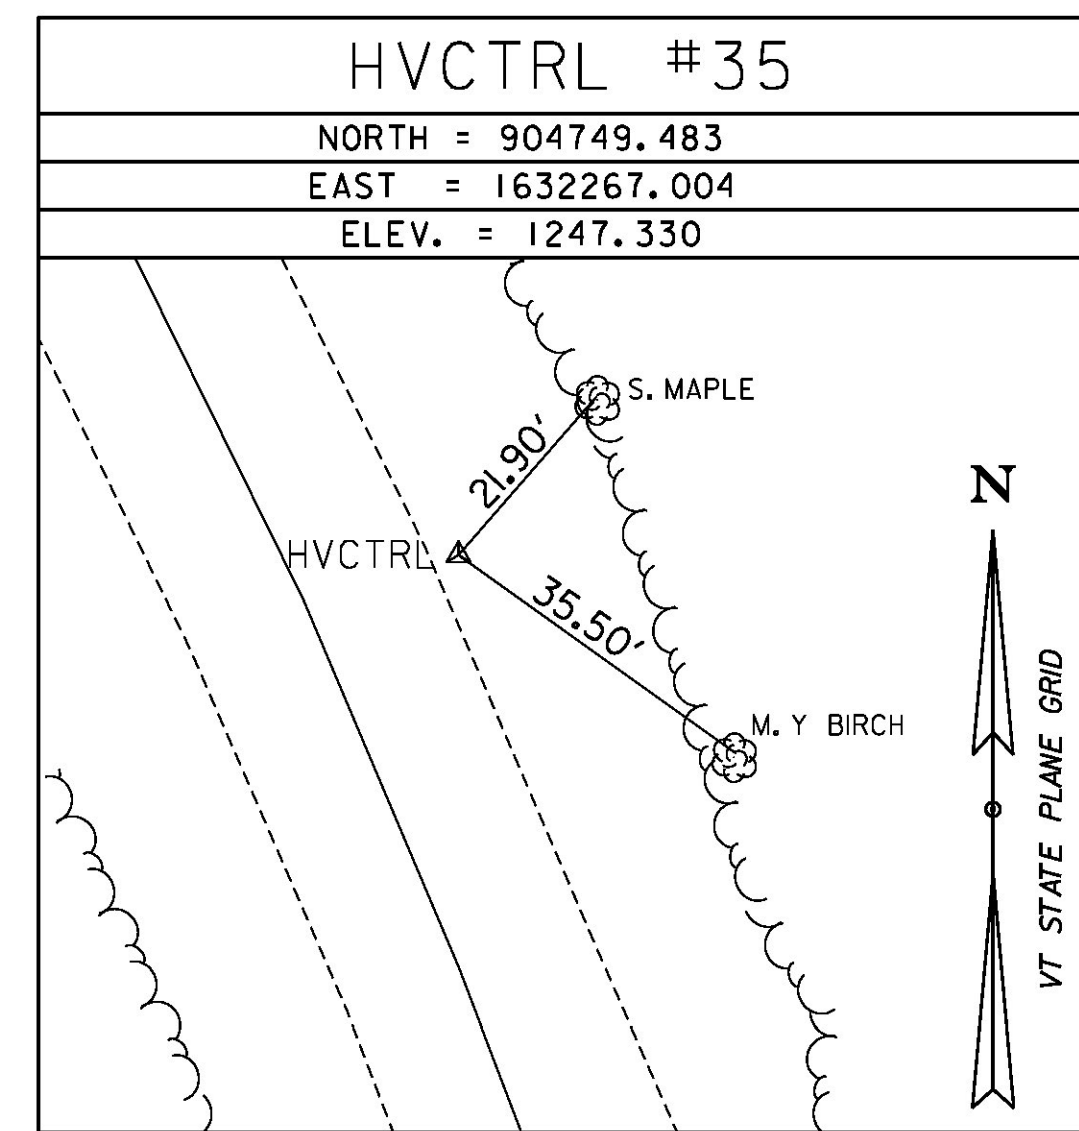
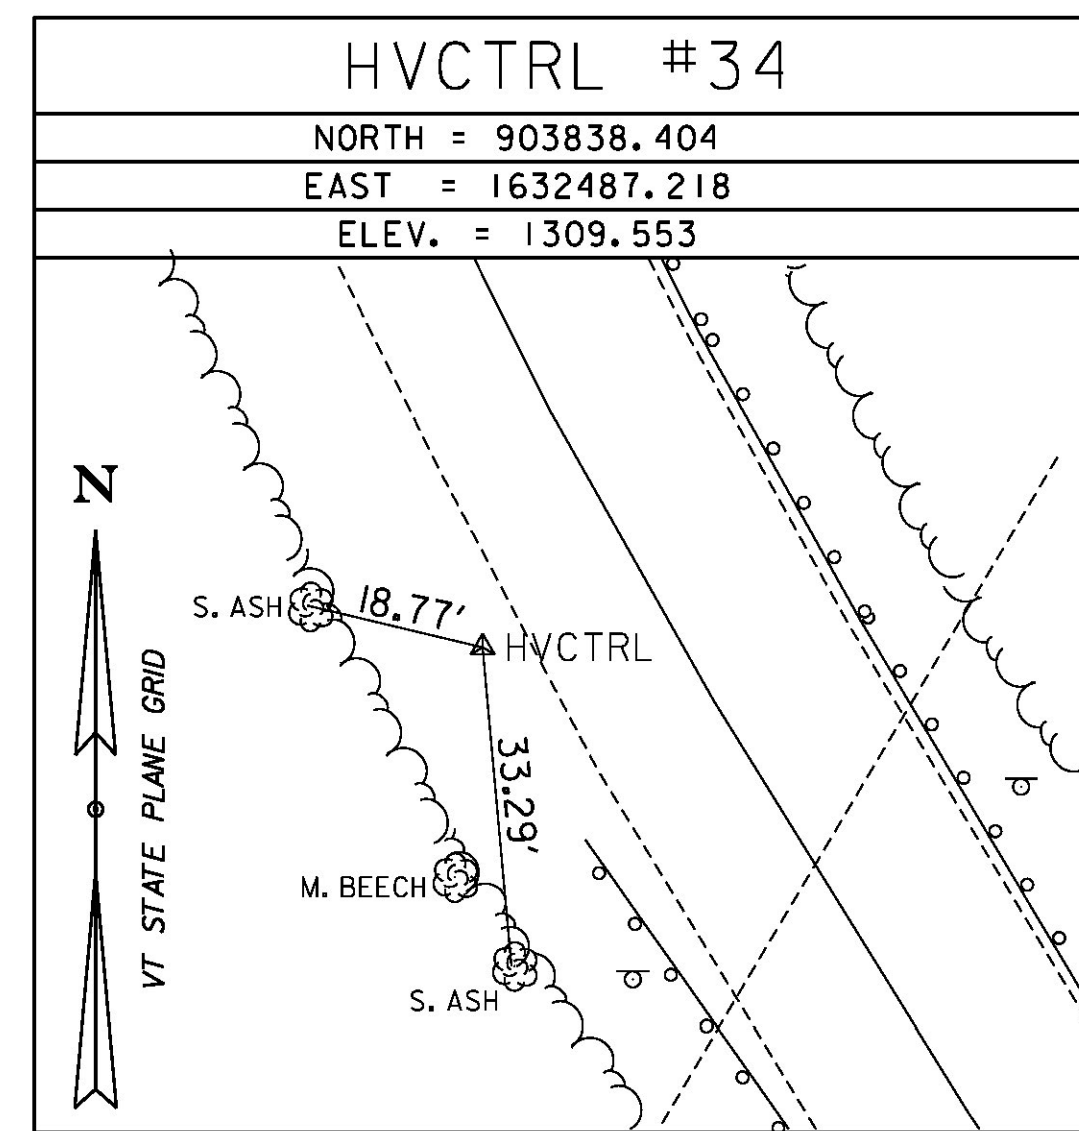


GPS CONTROL POINTS

TRAVERSE TIES

ALIGNMENT TIES

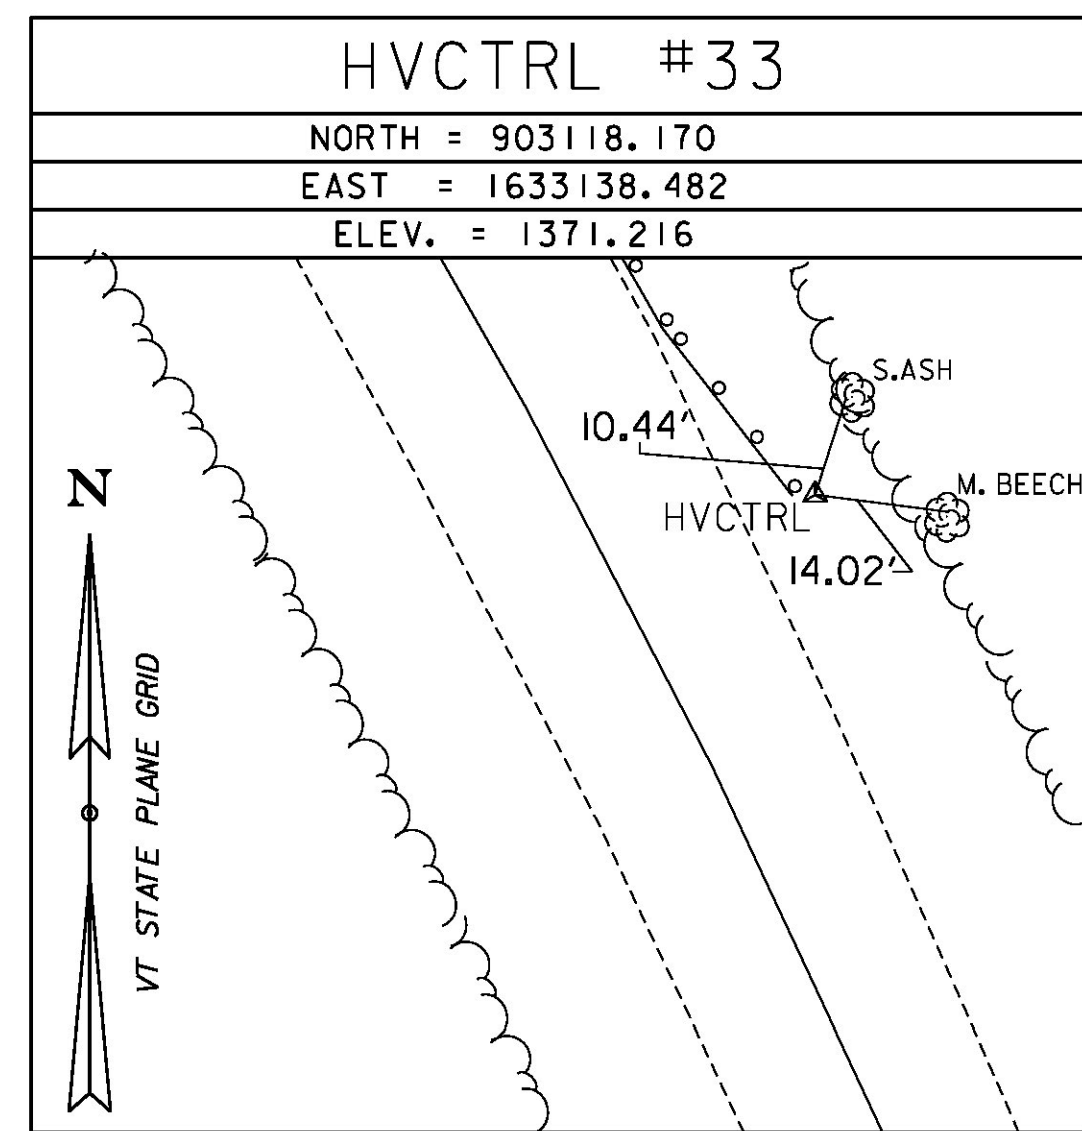

NORTH =
EAST =
ELEV. =

NORTH =
EAST =
ELEV. =

DATUM	
VERTICAL	NAVD 88
HORIZONTAL	NAD 83 (2007)
ADJUSTMENT	COMPASS

PROJECT NAME:	JAY-TROY
PROJECT NUMBER:	STP 2915(I)
FILE NAME: M:\0b232\Survey\10b232t1	PLOT DATE: 5/16/2014
PROJECT LEADER: M. FOWLER	DRAWN BY: S. DONOVAN
DESIGNED BY: VTrans	CHECKED BY: M. FOWLER
TIE SHEET 7	SHEET 10 OF 244