
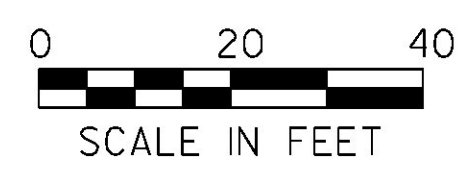
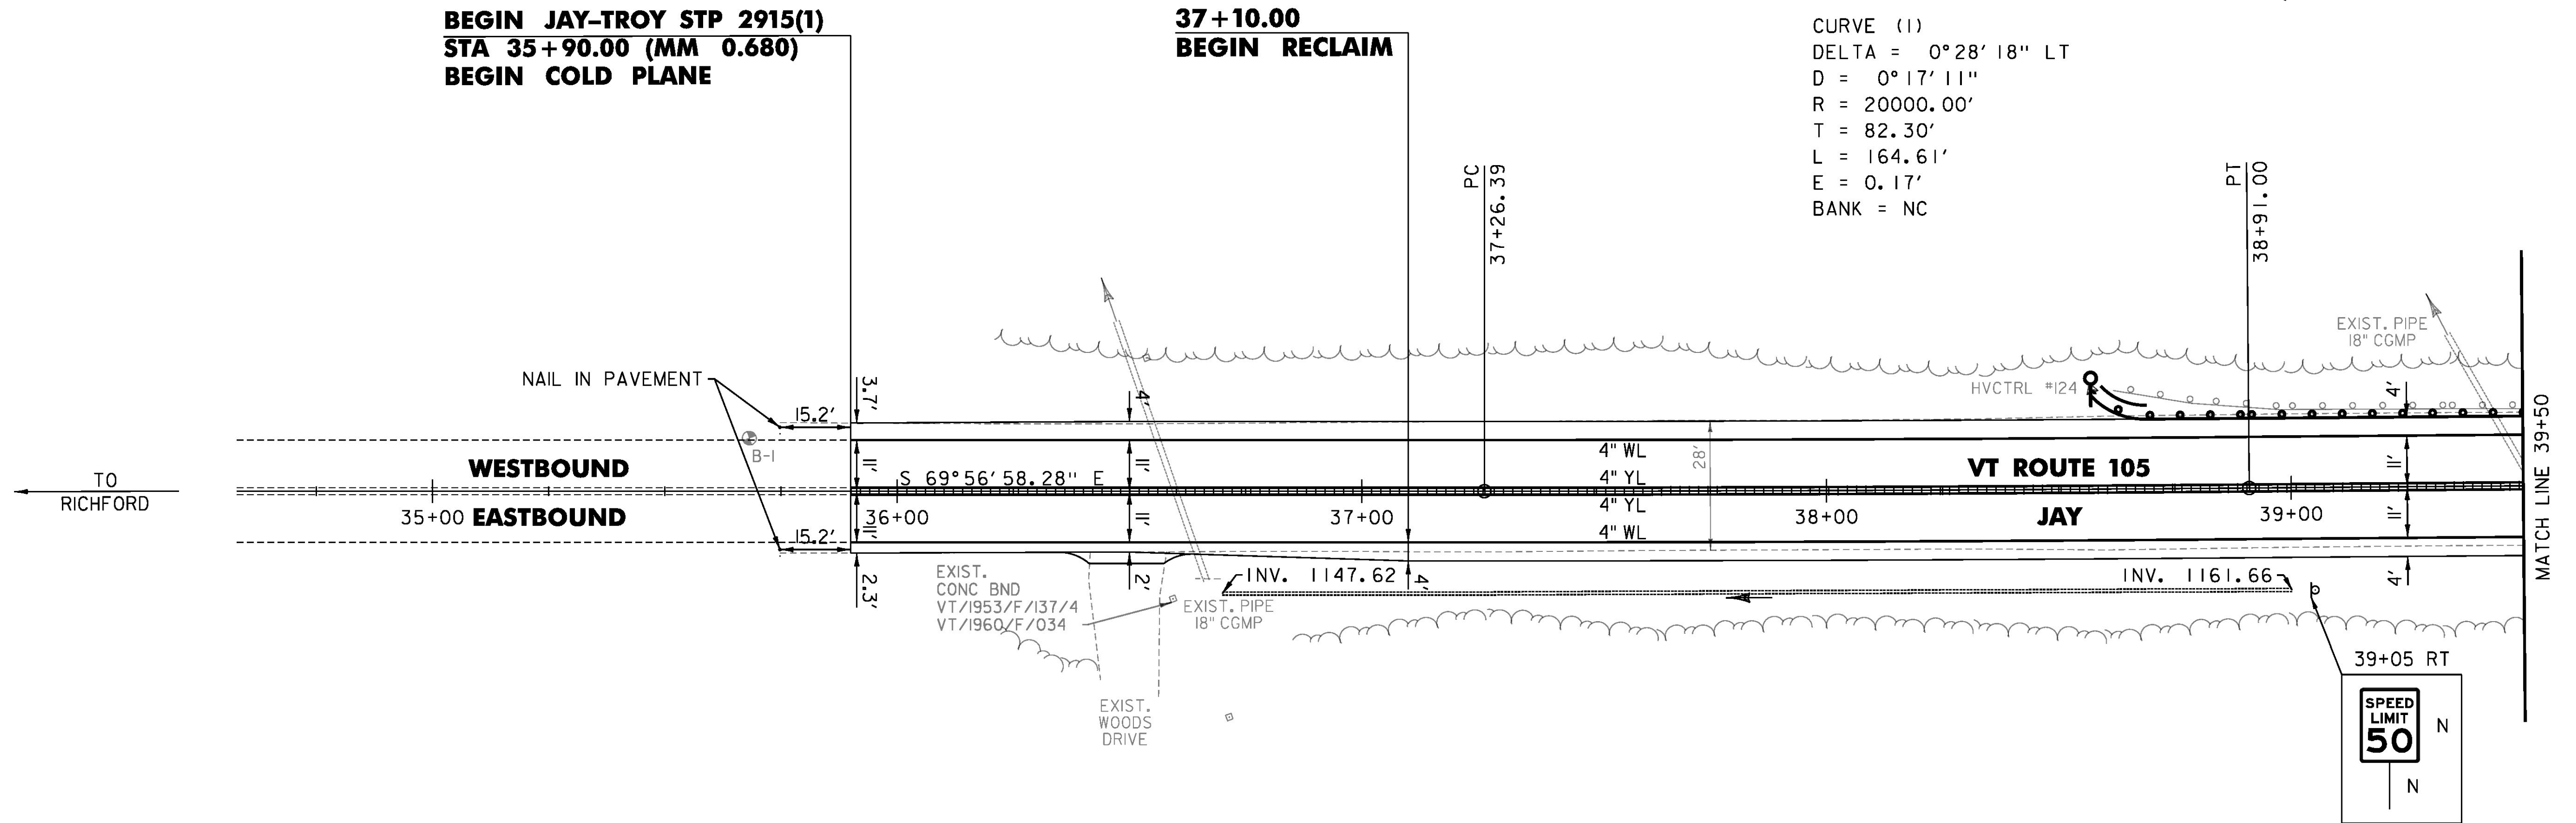


TEMPORARY 4 INCH WHITE LINE, PAINT
 DURABLE 4 INCH WHITE LINE, POLYUREA
 35+90 TO 39+50 SOLID LT & RT
 TEMPORARY 4 INCH YELLOW LINE, PAINT
 DURABLE 4 INCH YELLOW LINE, POLYUREA
 35+90 TO 39+50 SOLID LT & RT

STEEL BEAM GUARDRAIL, GALVANIZED
 38+57 TO 38+69.5 LT
 STEEL BEAM GUARDRAIL,
 GALVANIZED W/8 FEET POSTS
 38+69.5 TO 39+50 LT
 ANCHOR FOR STEEL BEAM RAIL
 1' (SEE STANDARD G-1d)

REMOVAL AND DISPOSAL OF GUARDRAIL
 38+62 TO 39+50 LT
 DELINEATOR WITH STEEL POST
 38+57 LT

MILLED RUMBLE STRIPS
 35+90 TO 39+50 CL
 6 INCH UNDERDRAIN PIPE
 36+70 TO 39+00 RT

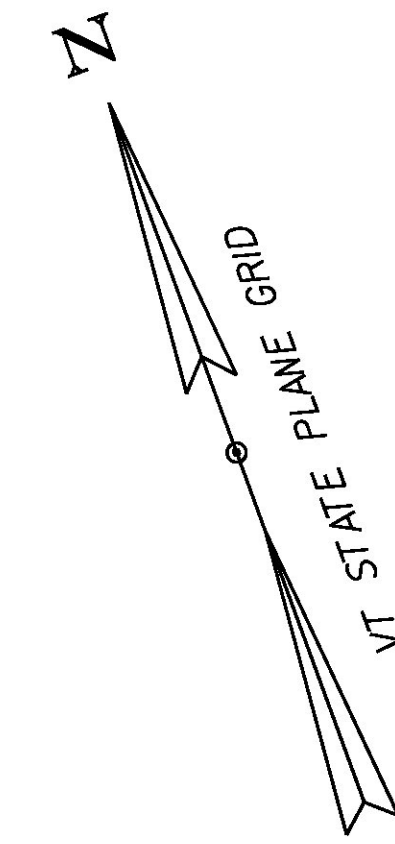

PROJECT NAME:	JAY-TROY	PLOT DATE:	5/16/2014
PROJECT NUMBER:	STP 2915(1)	DRAWN BY:	W. GORDON
FILE NAME:	10b232/COS/z10b232bdr.dgn	CHECKED BY:	P. SHEDD
DESIGNED BY:	N. LEMAY	SHEET	34 OF 244