


TEMPORARY 4 INCH WHITE LINE, PAINT
 DURABLE 4 INCH WHITE LINE, POLYUREA
 57+50 TO 63+50 SOLID LT & RT
 TEMPORARY 4 INCH YELLOW LINE, PAINT
 DURABLE 4 INCH YELLOW LINE, POLYUREA
 57+50 TO 63+50 SOLID LT & RT

STEEL BEAM GUARDRAIL, GALVANIZED
 58+20 TO ~~60+82.5~~ 60+70.0 LT
 ANCHOR FOR STEEL BEAM RAIL
 2 (SEE STANDARD G-1d)


REMOVAL AND DISPOSAL OF GUARDRAIL
 58+26 TO 60+58 LT
 59+78 TO 60+79 RT
 DELINEATOR WITH STEEL POST
 58+20 LT
 60+82.5 LT

MILLED RUMBLE STRIPS
 57+50 TO 63+50 CL
 6 INCH UNDERDRAIN PIPE
 57+50 TO 58+25 RT
 61+00 TO 63+50 LT
 REMOVING SIGNS
 AS SHOWN - 2

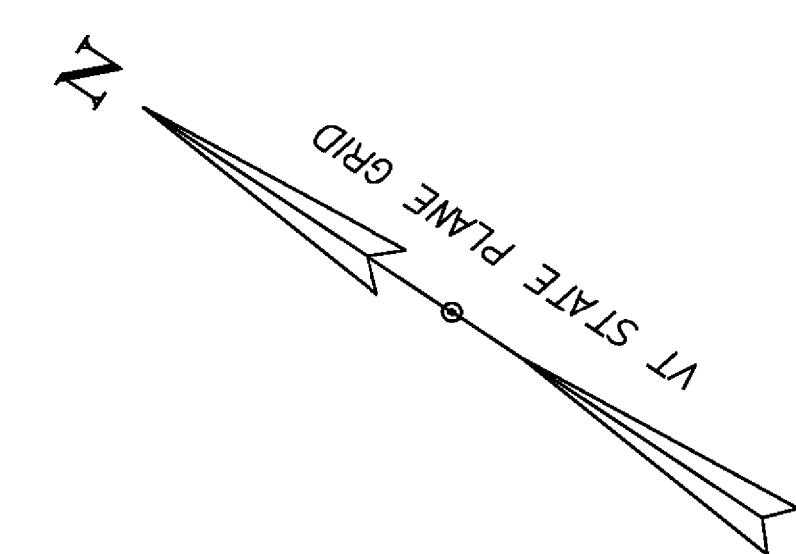

CURVE (5)
 DELTA = 30°06'23" LT
 D = 6°18'36"
 R = 908.00'
 T = 244.20'
 L = 477.11'
 E = 32.26'
 BANK = 0.078

CURVE (6)
 DELTA = 3°34'23" LT
 D = 2°58'07"
 R = 1930.00'
 T = 60.20'
 L = 120.36'
 E = 0.94'
 BANK = 0.052

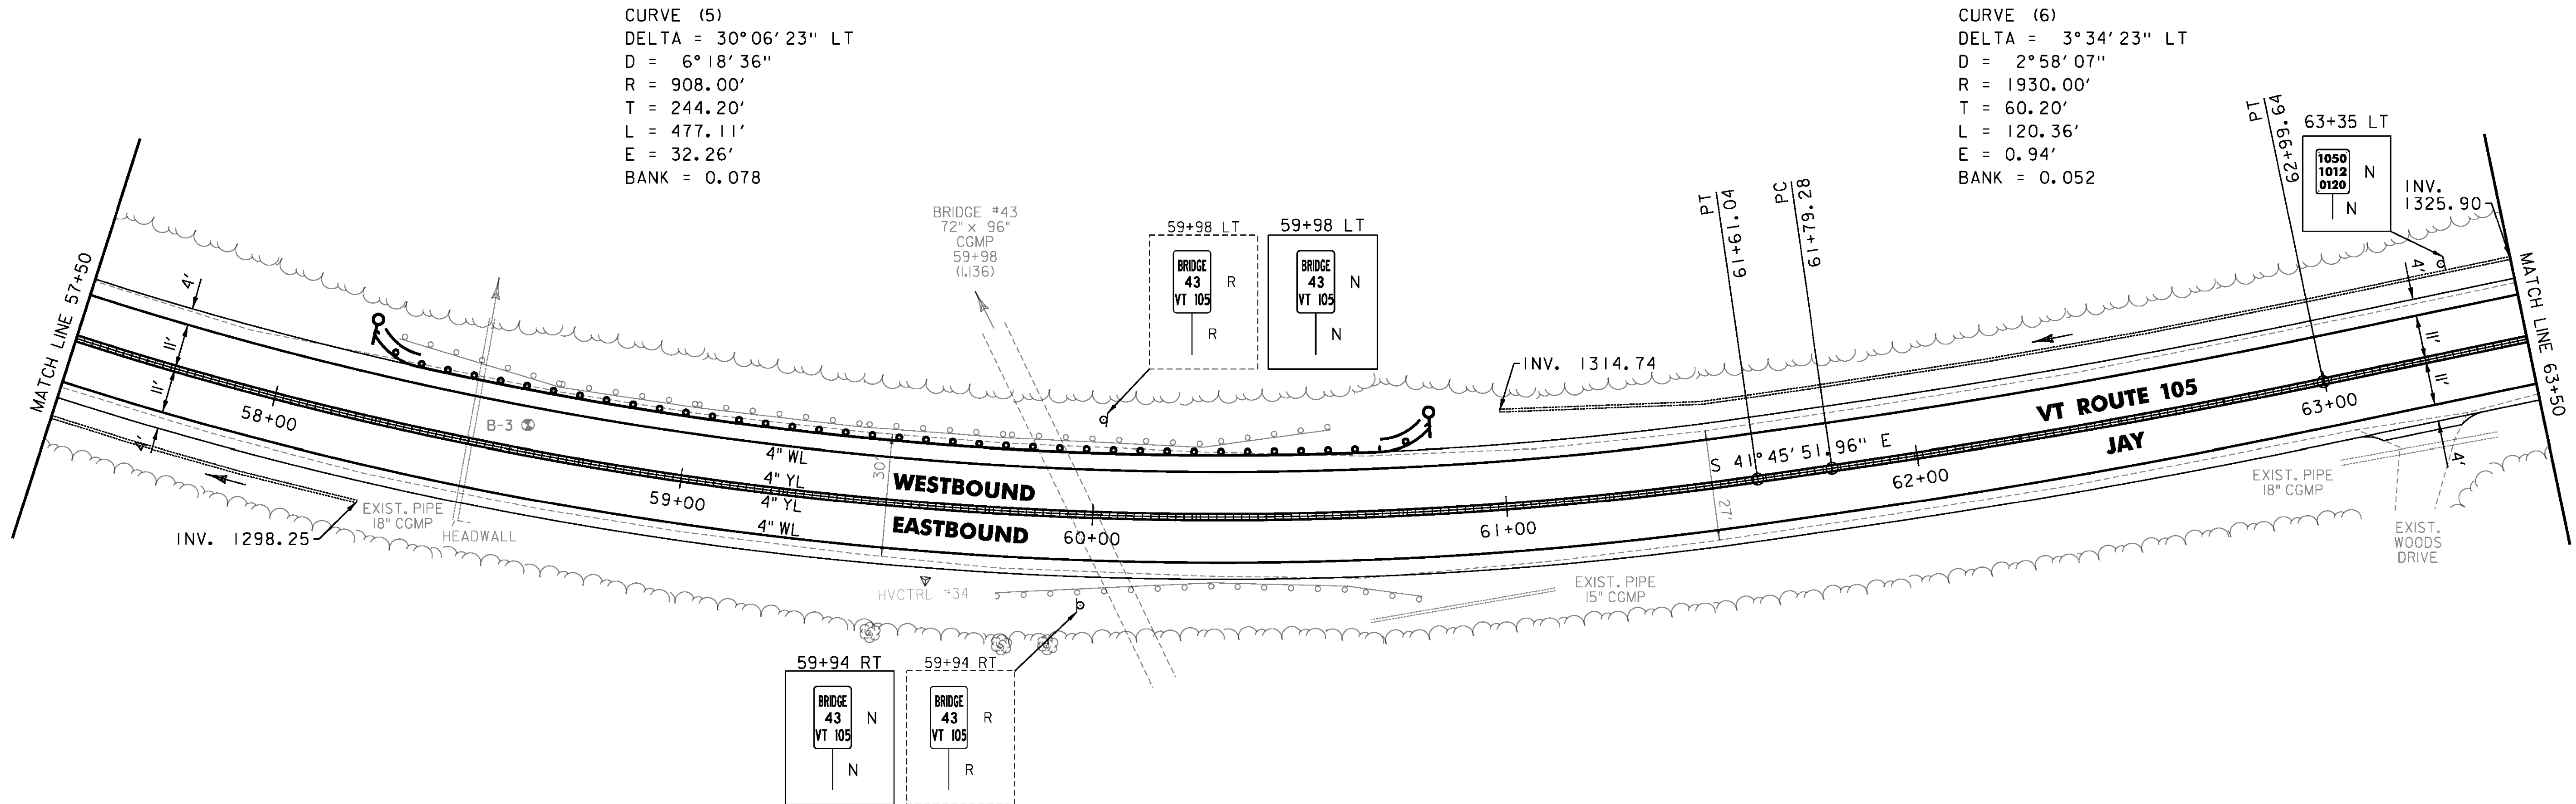

PROJECT NAME:	JAY-TROY	PLOT DATE:	5/16/2014
PROJECT NUMBER:	STP 2915(I)	DRAWN BY:	W. GORDON
FILE NAME:	z10b232bdr.dgn	CHECKED BY:	P. SHEDD
PROJECT LEADER:	P. SHEDD	SHEET	38 OF 244
DESIGNED BY:	N. LEMAY		
PLAN SHEET	5		

