



TEMPORARY 4 INCH WHITE LINE, PAINT  
 DURABLE 4 INCH WHITE LINE, POLYUREA  
 63+50 TO 69+50 SOLID LT & RT

TEMPORARY 4 INCH YELLOW LINE, PAINT  
 DURABLE 4 INCH YELLOW LINE, POLYUREA  
 63+50 TO 69+50 SOLID LT & RT

REMOVAL AND DISPOSAL OF GUARDRAIL  
 63+87 TO 69+33 LT

MILLED RUMBLE STRIPS  
 63+50 TO 69+50 CL

6 INCH UNDERDRAIN PIPE  
 65+50 TO 67+85 RT  
 68+35 TO 69+50 RT

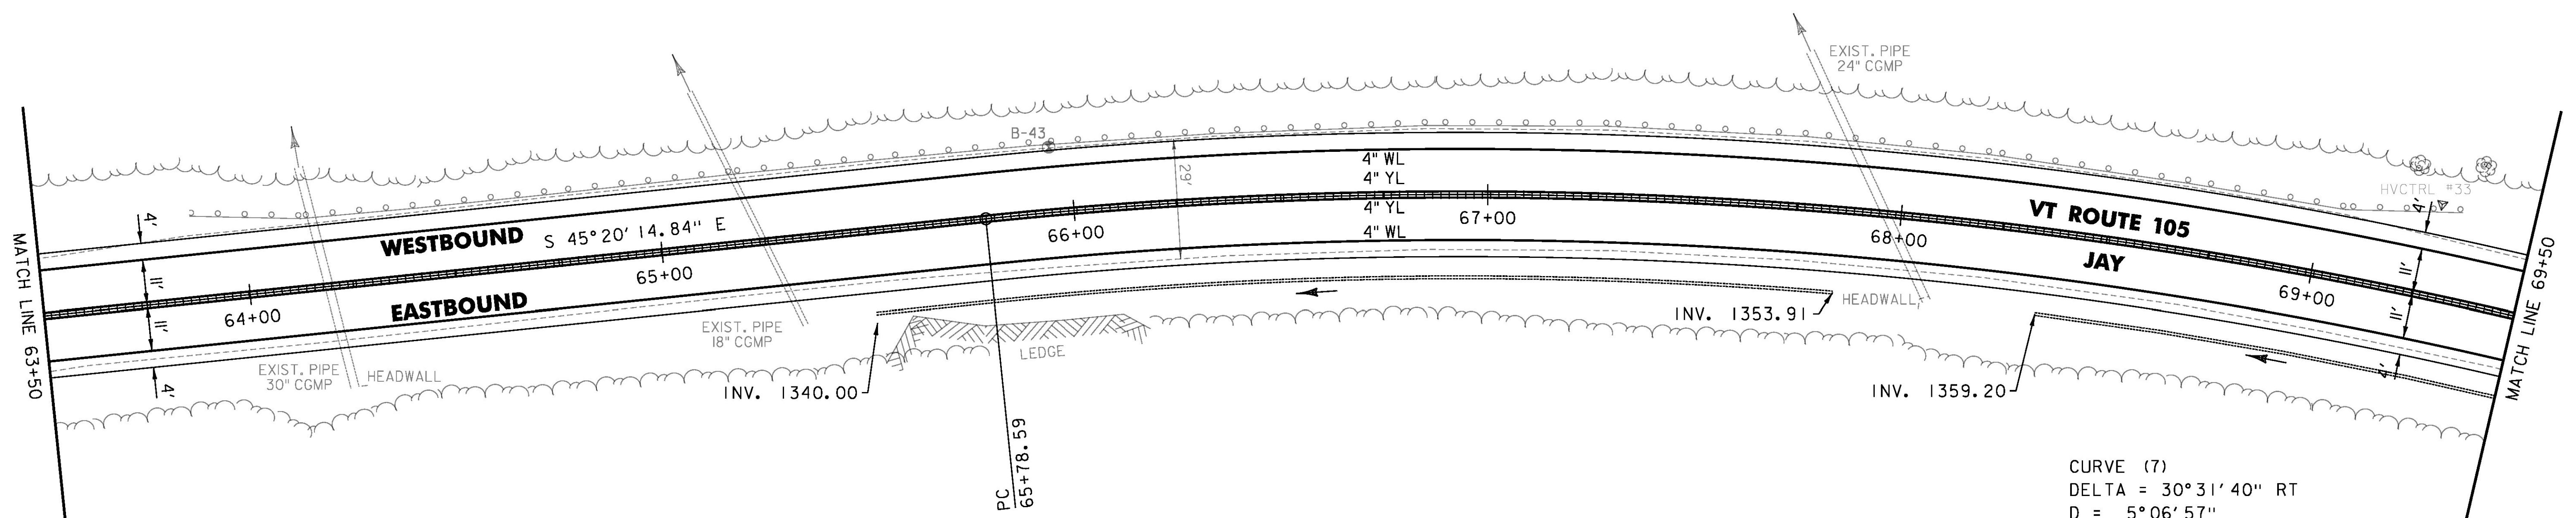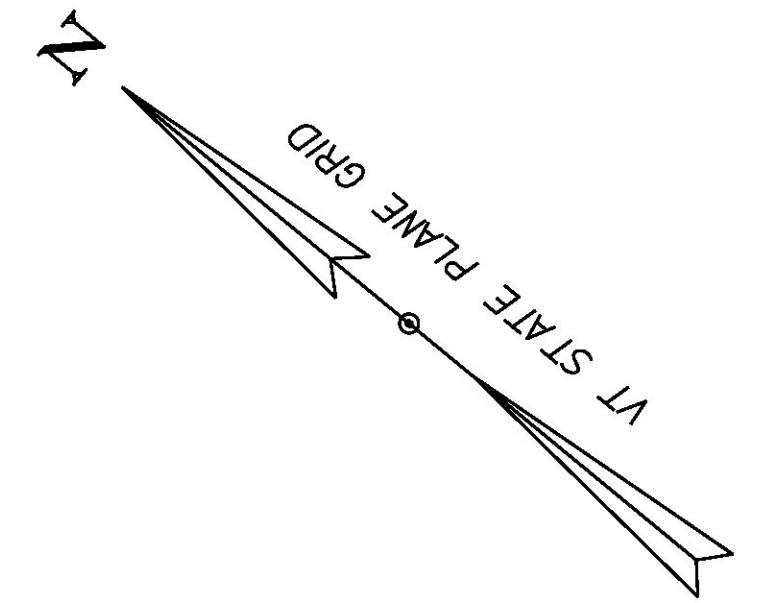

CURVE (7)  
 DELTA = 30° 31' 40" RT  
 D = 5° 06' 57"  
 R = 1120.00'  
 T = 305.64'  
 L = 596.75'  
 E = 40.95'  
 BANK = 0.072



PROJECT NAME:	JAY-TROY
PROJECT NUMBER:	STP 2915(I)
FILE NAME:	z10b232bdr.dgn
PROJECT LEADER:	P. SHEDD
DESIGNED BY:	N. LEMAY
PLAN SHEET	6
PLOT DATE:	5/16/2014
DRAWN BY:	W. GORDON
CHECKED BY:	P. SHEDD
SHEET	39 OF 244