

TEMPORARY 4 INCH WHITE LINE, PAINT
 DURABLE 4 INCH WHITE LINE, POLYUREA
 147+50 TO 153+50 SOLID LT & RT

TEMPORARY 4 INCH YELLOW LINE, PAINT
 DURABLE 4 INCH YELLOW LINE, POLYUREA
 147+50 TO 153+50 SOLID LT & RT

REHAB. DROP INLETS, CATCH BASINS,
 OR MANHOLES, CLASS J
 148+59 LT - DI

BITUMINOUS CONCRETE CURB, TYPE A
 147+50 TO 151+75 LT

STEEL BEAM GUARDRAIL, GALVANIZED
 148+65 TO 149+90 RT

STEEL BEAM GUARDRAIL,
 GALVANIZED W/8 FEET POSTS
 147+50 TO 153+50 LT

ANCHOR FOR STEEL BEAM RAIL
 2 (SEE STANDARD G-1d)


REMOVAL AND DISPOSAL OF GUARDRAIL
 147+50 TO 153+50 LT
 148+97 TO 149+85 RT

DELINEATOR WITH STEEL POST
 148+65 RT
 149+90 RT


MILLED RUMBLE STRIPS
 147+50 TO 153+50 CL

6 INCH UNDERDRAIN PIPE
 147+50 TO 148+50 RT
 151+00 TO 153+50 RT

REMOVING SIGNS
 AS SHOWN - 1

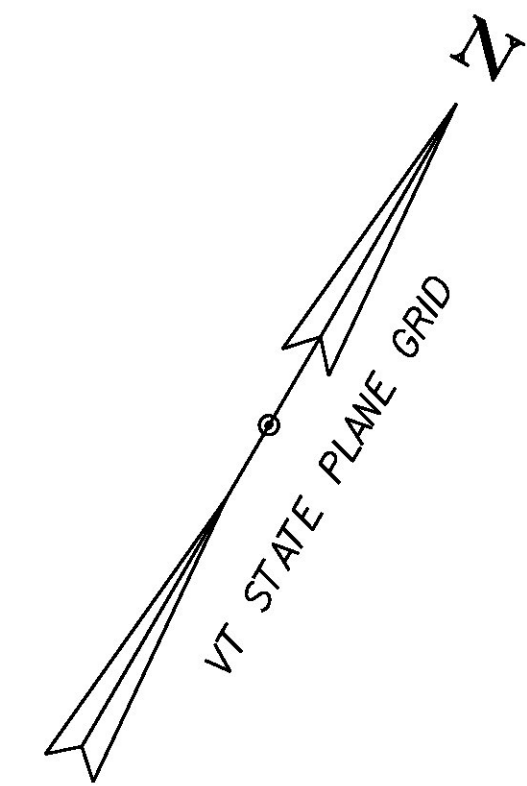

CURVE (19)
 DELTA = 33°05'05" LT
 D = 9°05'40"
 R = 630.00'
 T = 187.12'
 L = 363.79'
 E = 27.20'
 BANK = 0.080 AT 45 MPH

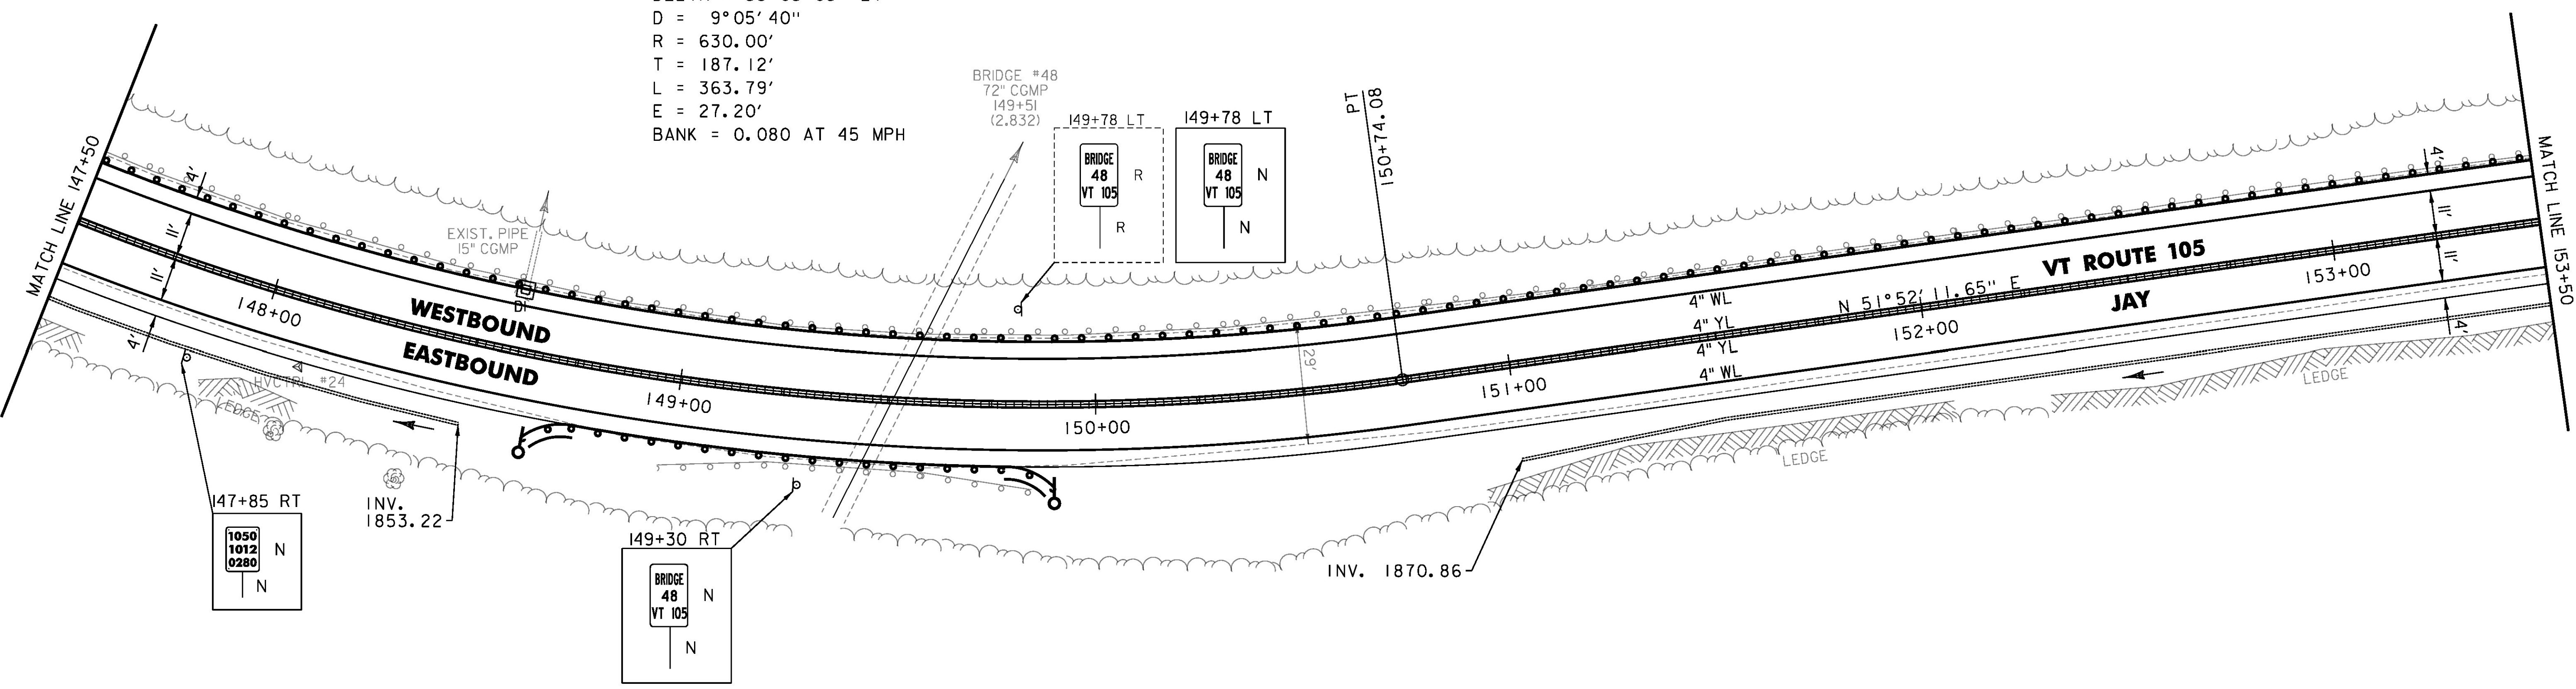

PROJECT NAME:	JAY-TROY	PLOT DATE:	5/16/2014
PROJECT NUMBER:	STP 2915(I)	DRAWN BY:	W. GORDON
FILE NAME:	z10b232bdr.dgn	CHECKED BY:	P. SHEDD
DESIGNED BY:	N. LEMAY	PLAN SHEET	20
		SHEET	53 OF 244