

TEMPORARY 4 INCH WHITE LINE, PAINT
 DURABLE 4 INCH WHITE LINE, POLYUREA
 165+50 TO 171+50 SOLID LT & RT

TEMPORARY 4 INCH YELLOW LINE, PAINT
 DURABLE 4 INCH YELLOW LINE, POLYUREA
 165+50 TO 171+50 SOLID LT & RT

REMOVAL OF EXISTING BRIDGE RAIL
 168+51.5 TO 168+76.5 LT
 168+51.5 TO 168+76.5 RT

BRIDGE RAILING REPAIR, TYPE I
 168+51.5 TO 168+76.5 LT
 168+51.5 TO 168+76.5 RT

BITUMINOUS CONCRETE CURB, TYPE A
 165+50 TO 168+56 LT
 168+72 TO 169+35 LT

STEEL BEAM GUARDRAIL, GALVANIZED
 165+50 TO 168+26.5 LT
 167+89 TO 168+26.5 RT
 169+01.5 TO 169+14 RT
 169+01.5 TO 170+64 LT

ANCHOR FOR STEEL BEAM RAIL
 3 (SEE STANDARD G-1d)

GUARDRAIL APPROACH SECTION,
 GALV HD STEEL BEAM
 168+76.5 TO 169+01.5 RT

GUARDRAIL APPROACH SECTION,
 GALV HD STEEL BEAM W/8' POSTS
 168+26.5 TO 168+51.5 LT
 168+26.5 TO 168+51.5 RT
 168+76.5 TO 169+01.5 LT



REMOVAL AND DISPOSAL OF GUARDRAIL
 165+50 TO 168+51.5 LT
 168+14 TO 168+51.5 RT
 168+76.5 TO 169+14 RT
 168+76.5 TO 170+19 LT

DELINEATOR WITH STEEL POST
 167+89 RT
 169+14 RT
 170+64 LT

MILLED RUMBLE STRIPS
 165+50 TO 171+50 CL

REMOVING SIGNS
 AS SHOWN - 3

6" UNDERDRAIN
 169+25 TO 170+35 RT
 170+55 TO 171+50 RT

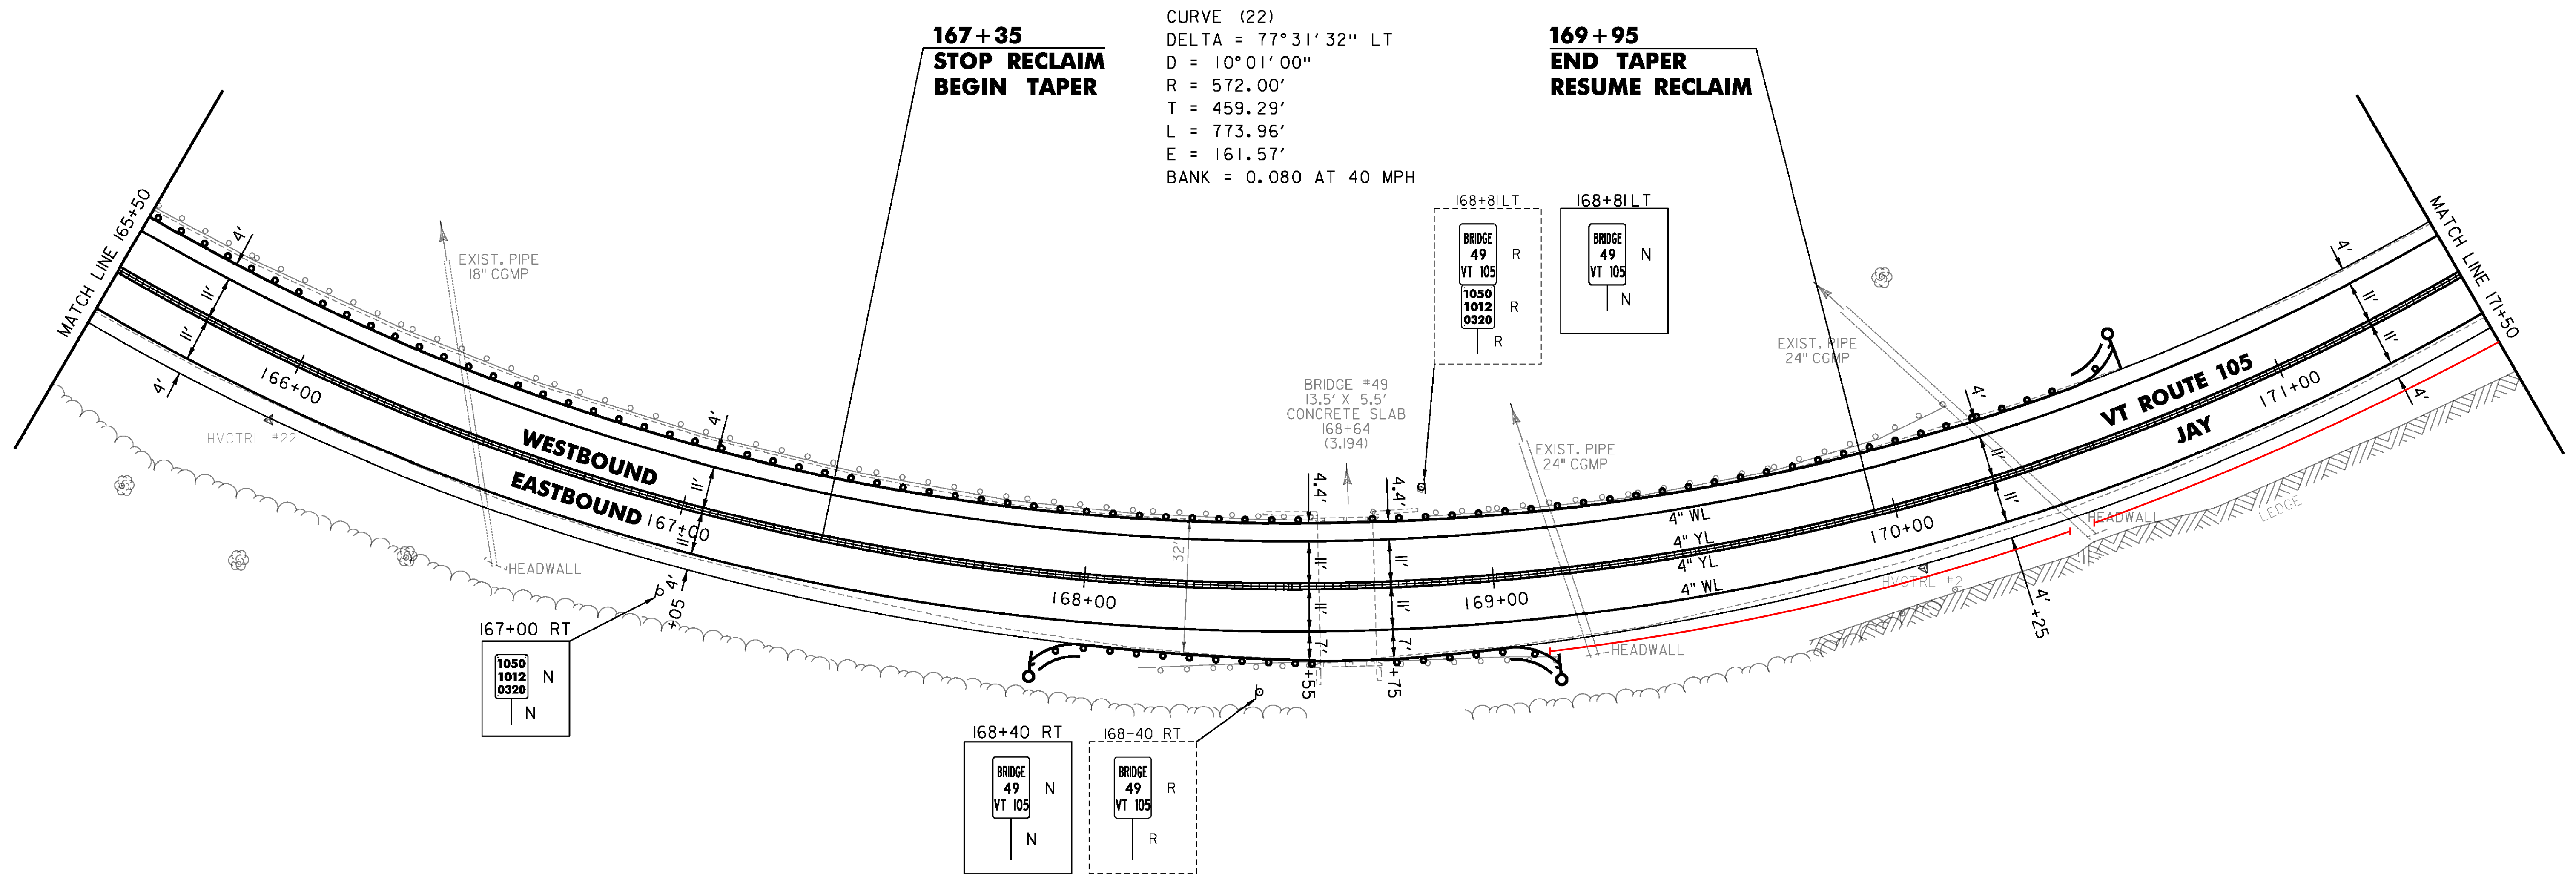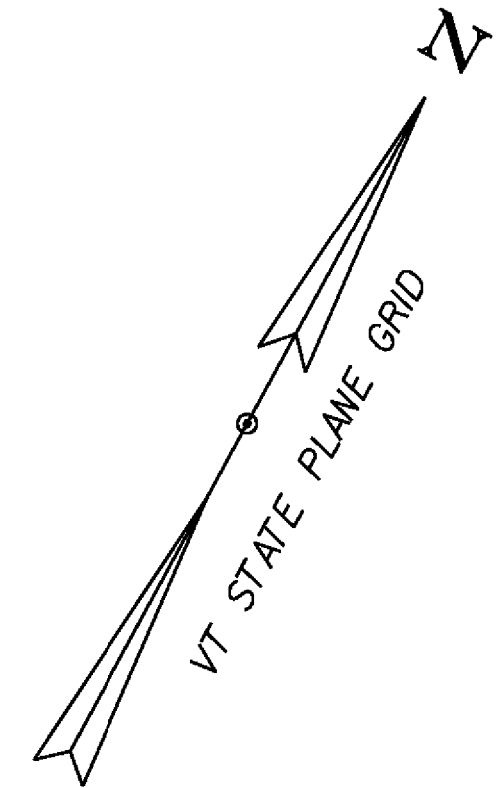

PROJECT NAME:	JAY-TROY	PLOT DATE:	5/16/2014
PROJECT NUMBER:	STP 2915(I)	DRAWN BY:	W. GORDON
FILE NAME:	z10b232bdr.dgn	CHECKED BY:	P. SHEDD
DESIGNED BY:	N. LEMAY	SHEET	56 OF 244
PLAN SHEET	23		