
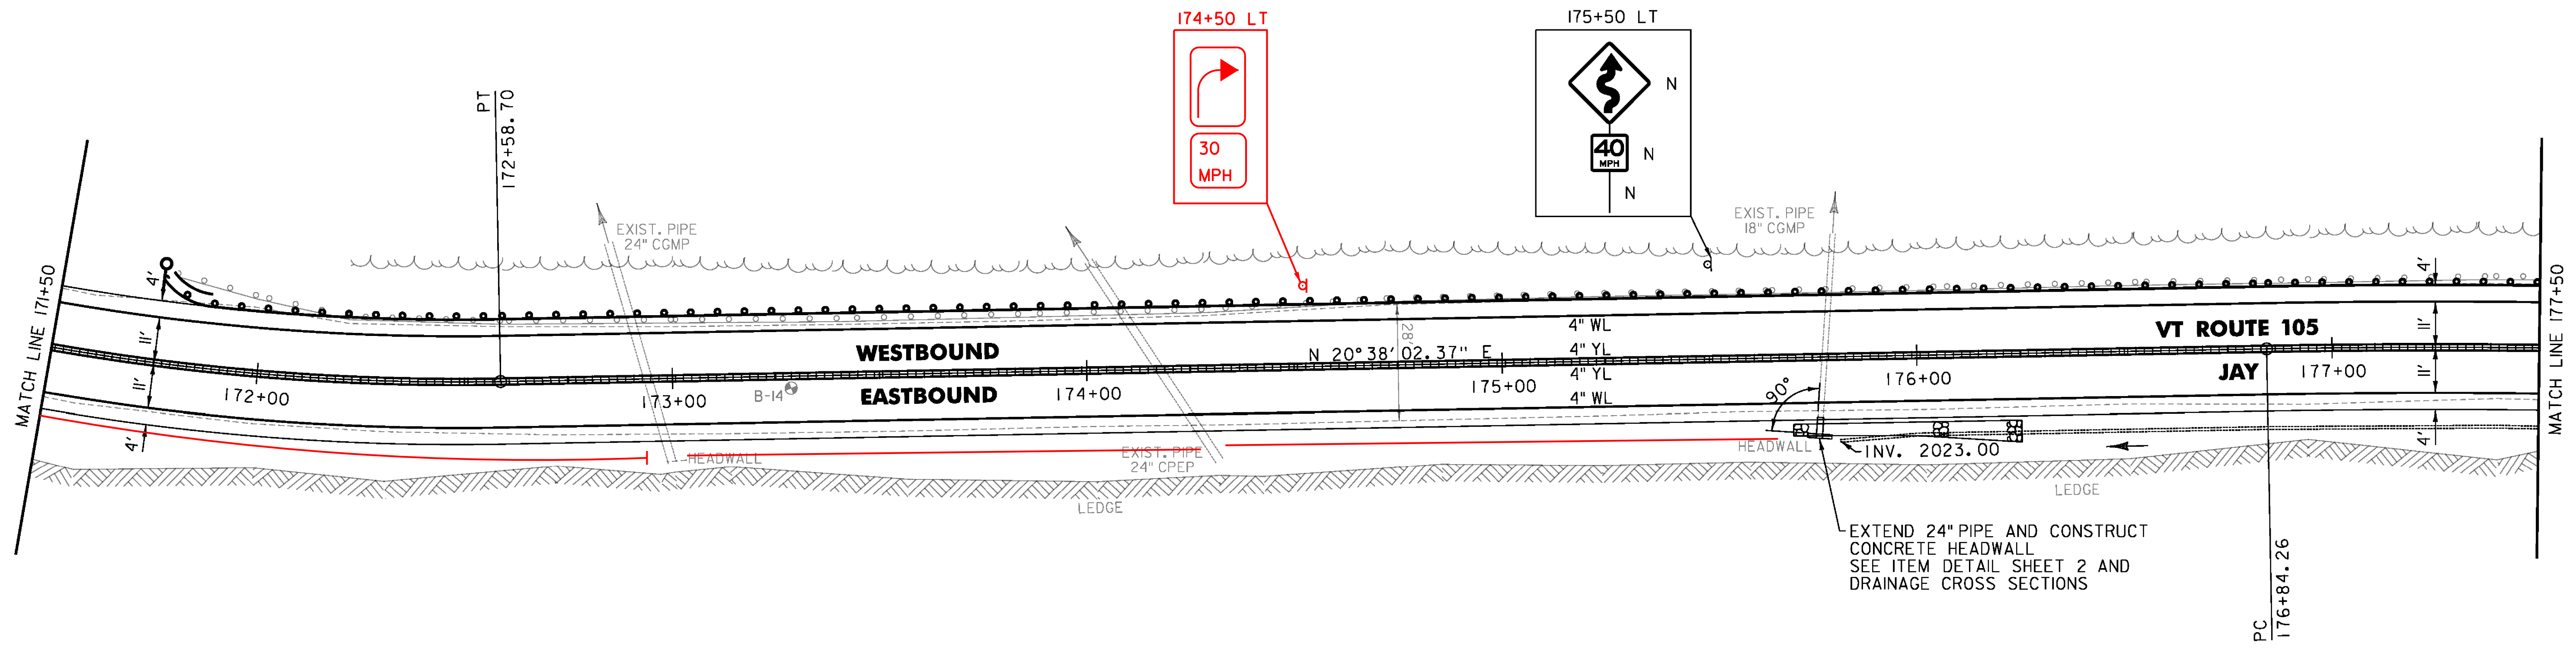


TEMPORARY 4 INCH WHITE LINE, PAINT
 DURABLE 4 INCH WHITE LINE, POLYUREA
 171+50 TO 177+50 SOLID LT & RT
 TEMPORARY 4 INCH YELLOW LINE, PAINT
 DURABLE 4 INCH YELLOW LINE, POLYUREA
 171+50 TO 177+50 SOLID LT & RT

GRUBBING MATERIAL (6")
 STONE FILL, TYPE I
 GEOTEXTILE UNDER STONE FILL
 175+70 TO 176+25 RT
 STEEL BEAM GUARDRAIL, GALVANIZED
 171+75 TO 171+87.5 LT
 STEEL BEAM GUARDRAIL,
 GALVANIZED W/8 FEET POSTS
 171+87.5 TO 177+50 LT
 ANCHOR FOR STEEL BEAM RAIL
 I (SEE STANDARD G-1d)

REMOVAL AND DISPOSAL OF GUARDRAIL
 171+78 TO 177+50 LT
 DELINEATOR WITH STEEL POST
 171+75 LT

MILLED RUMBLE STRIPS
 171+50 TO 177+50 CL
 6 INCH UNDERDRAIN PIPE
 175+81 TO 177+50 RT
 171+50 TO 172+90 RT
 173+15 TO 174+25 RT
 174+40 TO 175+70 RT

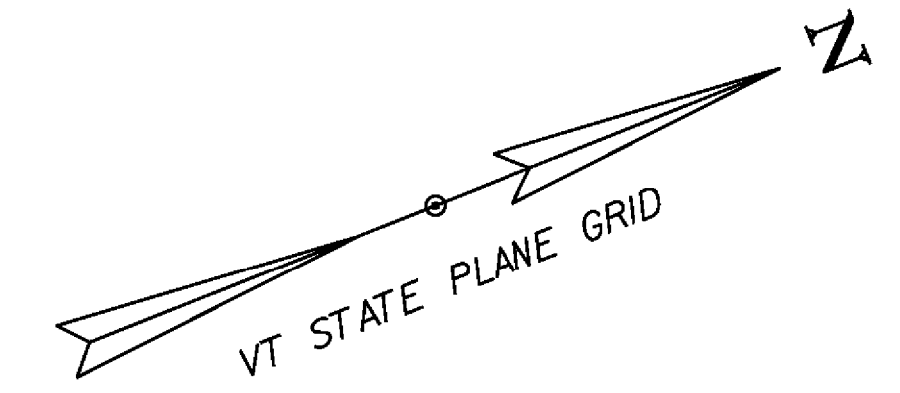

PROJECT NAME:	JAY-TROY	PLOT DATE:	5/16/2014
PROJECT NUMBER:	STP 2915(I)	DRAWN BY:	W. GORDON
FILE NAME:	z10b232bdr.dgn	CHECKED BY:	P. SHEDD
PROJECT LEADER:	P. SHEDD	SHEET	57 OF 244
DESIGNED BY:	N. LEMAY		
PLAN SHEET	24		