

TEMPORARY 4 INCH WHITE LINE, PAINT  
 DURABLE 4 INCH WHITE LINE, POLYUREA  
 189+50 TO 195+50 SOLID LT & RT

TEMPORARY 4 INCH YELLOW LINE, PAINT  
 DURABLE 4 INCH YELLOW LINE, POLYUREA  
 189+50 TO 195+50 SOLID LT & RT

STEEL BEAM GUARDRAIL, GALVANIZED  
 194+20 TO 194+32.5 RT

STEEL BEAM GUARDRAIL,  
 GALVANIZED W/8 FEET POSTS  
 194+32.5 TO 195+50 RT

ANCHOR FOR STEEL BEAM RAIL  
 1" (SEE STANDARD G-1d)


REMOVAL AND DISPOSAL OF GUARDRAIL  
 194+62 TO 195+50 RT

DELINEATOR WITH STEEL POST  
 194+20 RT


MILLED RUMBLE STRIPS  
 189+50 TO 195+50 CL

6 INCH UNDERDRAIN PIPE  
 195+00 TO 195+50 LT

REMOVING SIGNS  
 AS SHOWN - 2

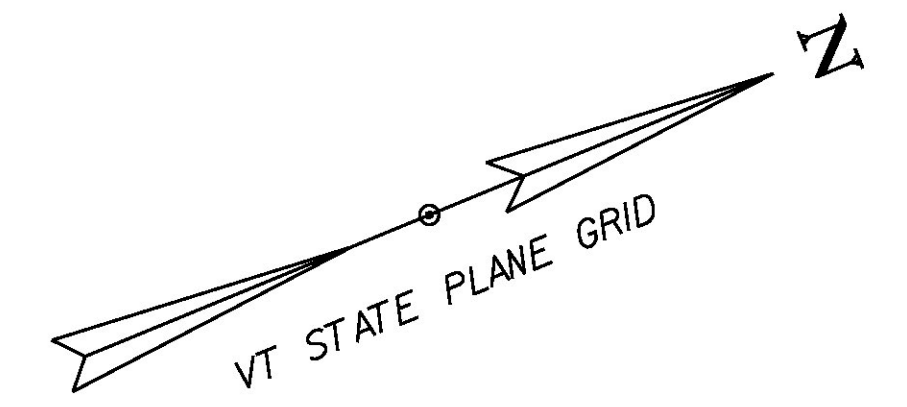

CURVE (24)  
 DELTA = 22°20'53" LT  
 D = 4°24'27"  
 R = 1300.00'  
 T = 256.79'  
 L = 507.06'  
 E = 25.12'  
 BANK = 0.067

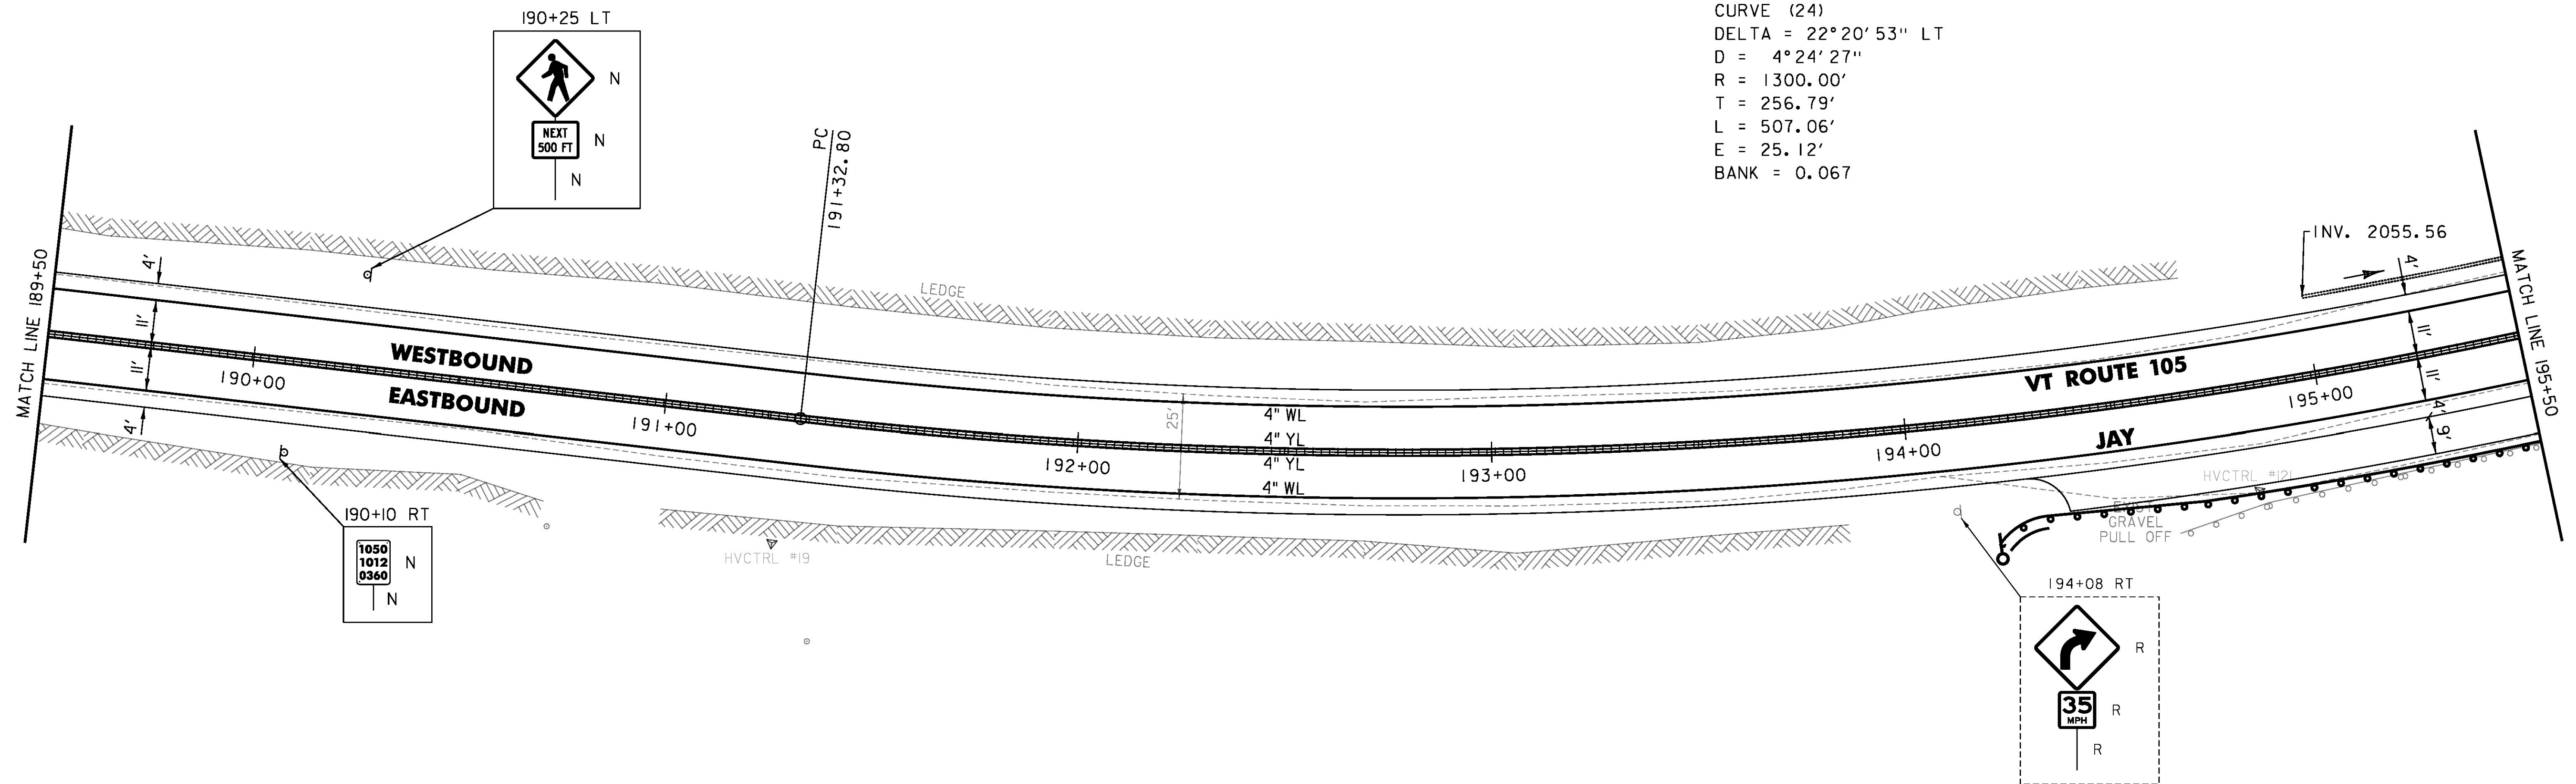

PROJECT NAME:	JAY-TROY	PLOT DATE:	5/16/2014
PROJECT NUMBER:	STP 2915(1)	DRAWN BY:	W. GORDON
FILE NAME:	z10b232bdr.dgn	DESIGNED BY:	N. LEMAY
PROJECT LEADER:	P. SHEDD	CHECKED BY:	P. SHEDD
PLAN SHEET 27		SHEET	60 OF 244

