

TEMPORARY 4 INCH WHITE LINE, PAINT
 DURABLE 4 INCH WHITE LINE, POLYUREA
 207+50 TO 213+50 SOLID LT & RT

TEMPORARY 4 INCH YELLOW LINE, PAINT
 DURABLE 4 INCH YELLOW LINE, POLYUREA
 207+50 TO 213+50 SOLID LT & RT

REHAB. DROP INLETS, CATCH BASINS,
 OR MANHOLES, CLASS I
 209+33 RT - DI

REHAB. DROP INLETS, CATCH BASINS,
 OR MANHOLES, CLASS II
 211+69 LT - OTDI

GRUBBING MATERIAL (6")
 STONE FILL, TYPE I
 GEOTEXTILE UNDER STONE FILL
 211+75 TO 212+25 RT

BITUMINOUS CONCRETE CURB, TYPE A
 207+50 TO 213+50 RT



STEEL BEAM GUARDRAIL,
 GALVANIZED W/8 FEET POSTS
 207+50 TO 213+50 RT

REMOVAL AND DISPOSAL OF GUARDRAIL
 207+50 TO 213+50 RT

MILLED RUMBLE STRIPS
 207+50 TO 213+50 CL

6 INCH UNDERDRAIN PIPE
 207+50 TO 207+70 LT
 208+00 TO 209+50 LT
 209+75 TO 211+68 LT
 212+00 TO 213+50 LT

REMOVING SIGNS
 AS SHOWN - 1

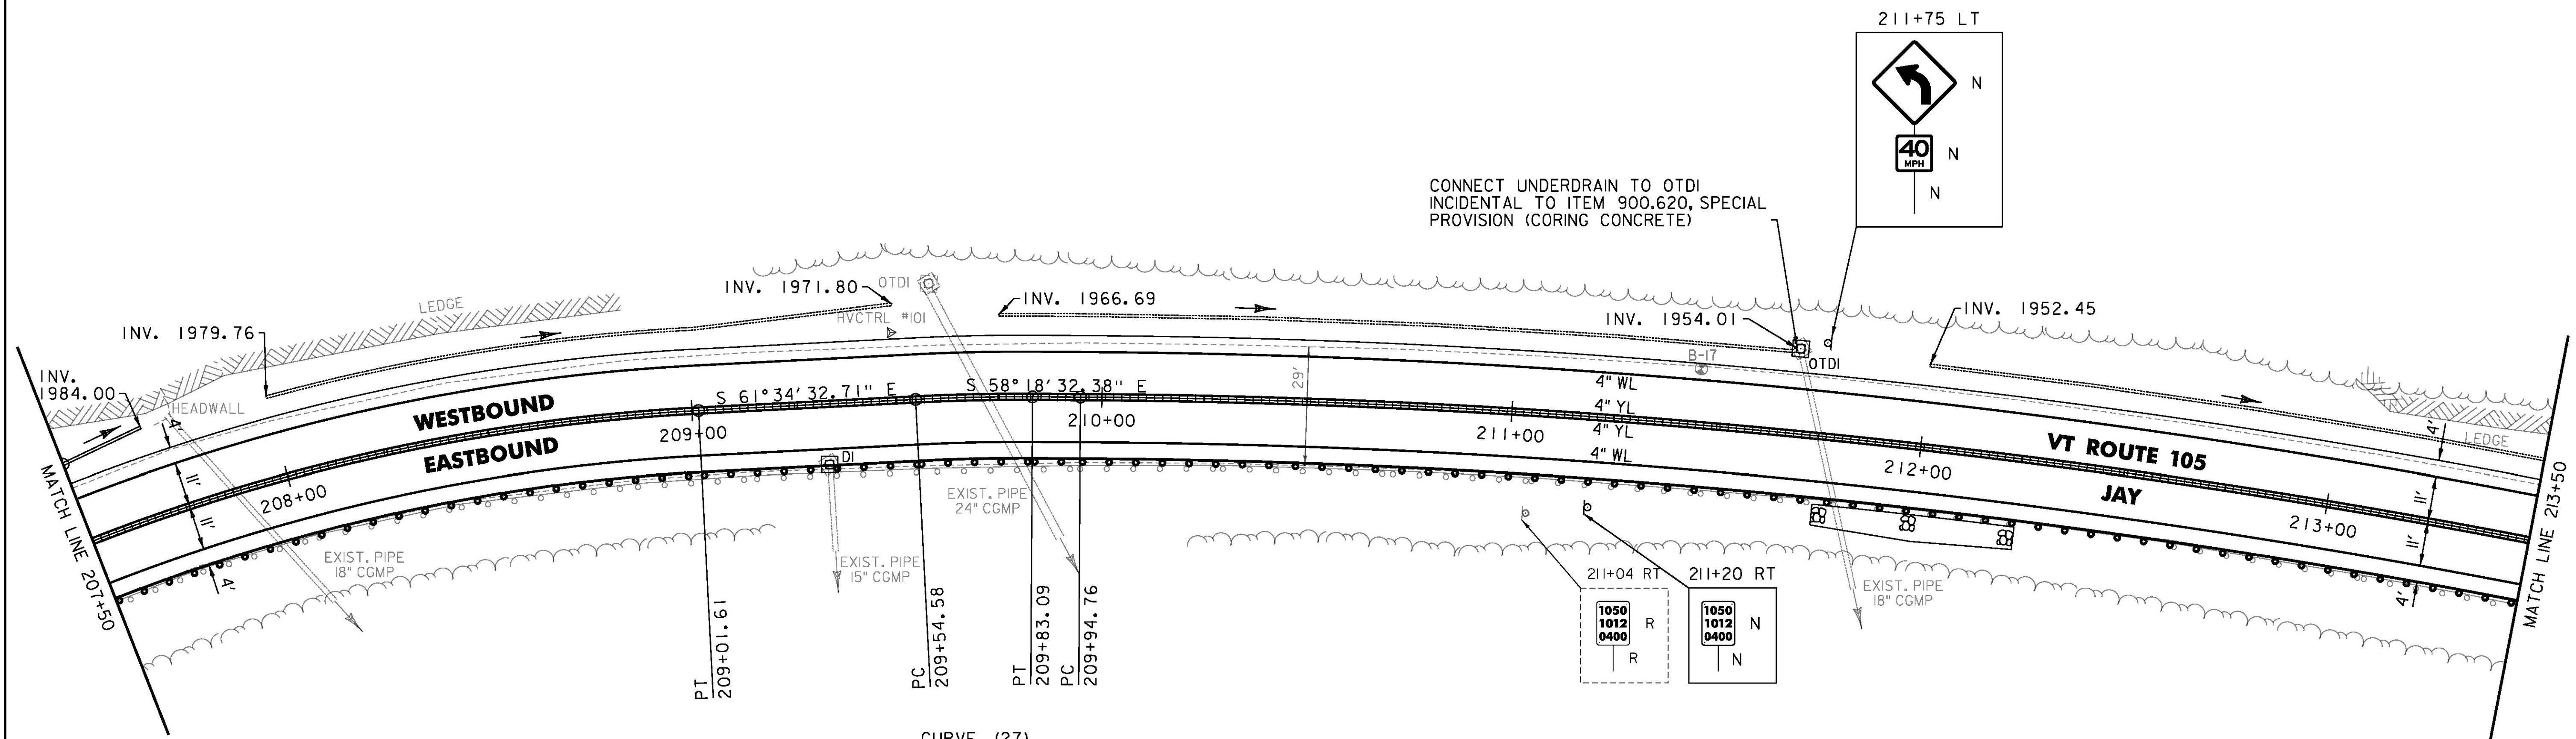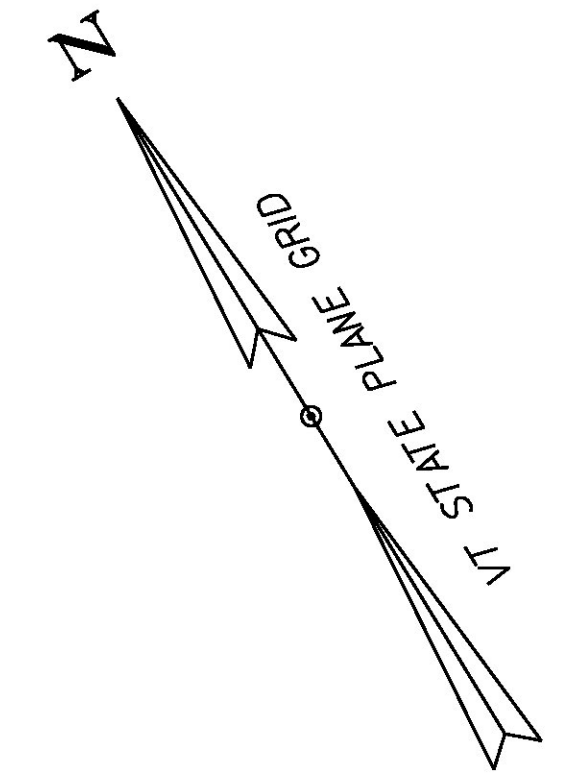

CURVE (27)
 DELTA = 3° 16' 00" RT
 D = 11° 27' 33"
 R = 500.00'
 T = 14.26'
 L = 28.51'
 E = 0.20'
 BANK = 0.080 AT 40 MPH



PROJECT NAME:	JAY-TROY	PLOT DATE:	5/16/2014
PROJECT NUMBER:	STP 2915(I)	DRAWN BY:	W. GORDON
FILE NAME:	z10b232bdr.dgn	CHECKED BY:	P. SHEDD
DESIGNED BY:	N. LEMAY	PLAN SHEET	30
		SHEET	63 OF 244