

TEMPORARY 4 INCH WHITE LINE, PAINT  
 DURABLE 4 INCH WHITE LINE, POLYUREA  
 219+50 TO 225+50 SOLID LT & RT

TEMPORARY 4 INCH YELLOW LINE, PAINT  
 DURABLE 4 INCH YELLOW LINE, POLYUREA  
 219+50 TO 225+50 SOLID LT & RT

BITUMINOUS CONCRETE CURB, TYPE A  
 219+50 TO 221+75 RT



STEEL BEAM GUARDRAIL,  
 GALVANIZED W/8 FEET POSTS  
 219+50 TO 225+50 RT

REMOVAL AND DISPOSAL OF GUARDRAIL  
 219+50 TO 225+50 RT

MILLED RUMBLE STRIPS  
 219+50 TO 225+50 CL

6 INCH UNDERDRAIN PIPE  
 219+50 TO 222+12 LT  
 223+50 TO 225+50 LT

REMOVING SIGNS  
 AS SHOWN - 2

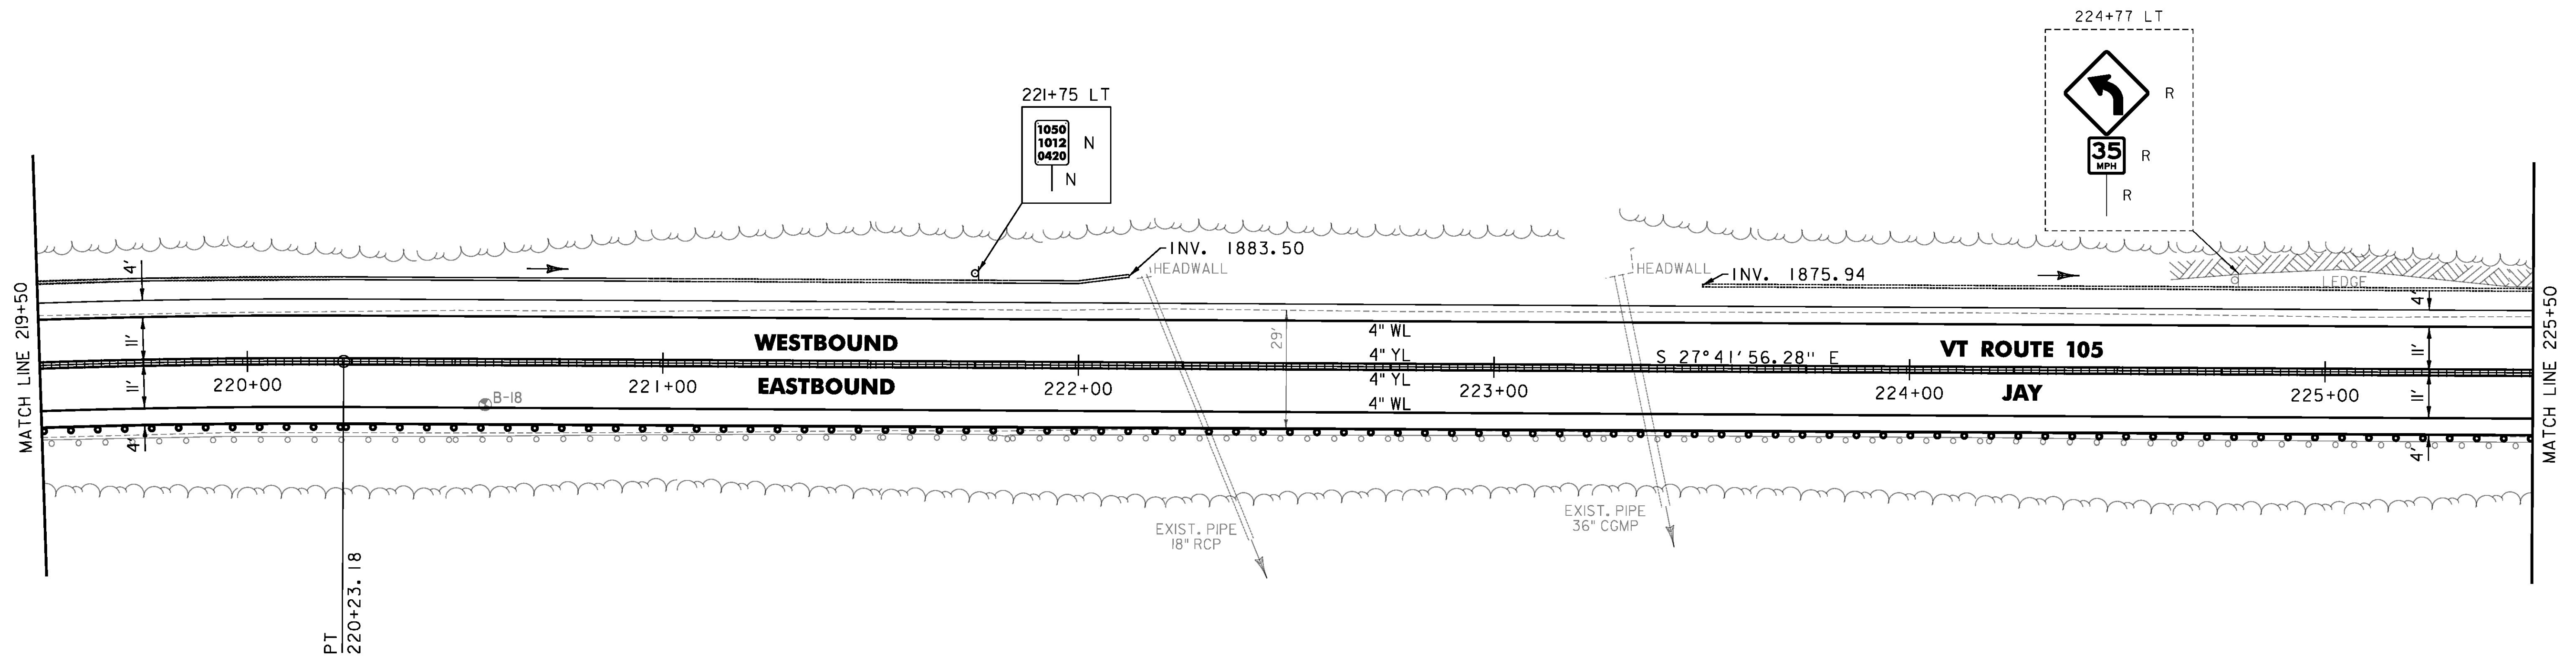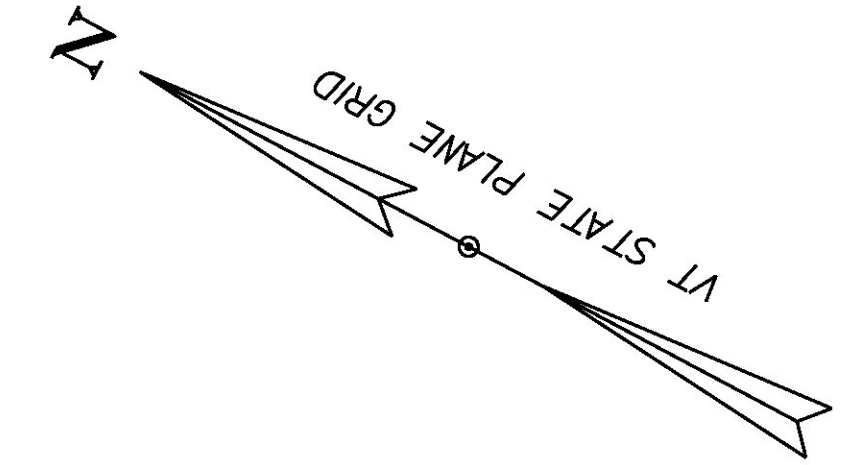

PROJECT NAME:	JAY-TROY	PLOT DATE:	5/16/2014
PROJECT NUMBER:	STP 2915(I)	DRAWN BY:	W. GORDON
FILE NAME:	z10b232bdr.dgn	DESIGNED BY:	N. LEMAY
PROJECT LEADER:	P. SHEDD	CHECKED BY:	P. SHEDD
PLAN SHEET 32		SHEET	65 OF 244