

TEMPORARY 4 INCH WHITE LINE, PAINT  
 DURABLE 4 INCH WHITE LINE, POLYUREA  
 231+50 TO 237+50 SOLID LT & RT

TEMPORARY 4 INCH YELLOW LINE, PAINT  
 DURABLE 4 INCH YELLOW LINE, POLYUREA  
 231+50 TO 237+50 SOLID LT, DASHED RT



STEEL BEAM GUARDRAIL,  
 GALVANIZED W/8 FEET POSTS  
 231+50 TO 237+50 RT

REMOVAL AND DISPOSAL OF GUARDRAIL  
 231+50 TO 237+50 RT

MILLED RUMBLE STRIPS  
 231+50 TO 237+50 CL

6 INCH UNDERDRAIN PIPE  
 231+50 TO 232+00 LT  
 236+50 TO 237+50 LT

REMOVING SIGNS  
 AS SHOWN - 2

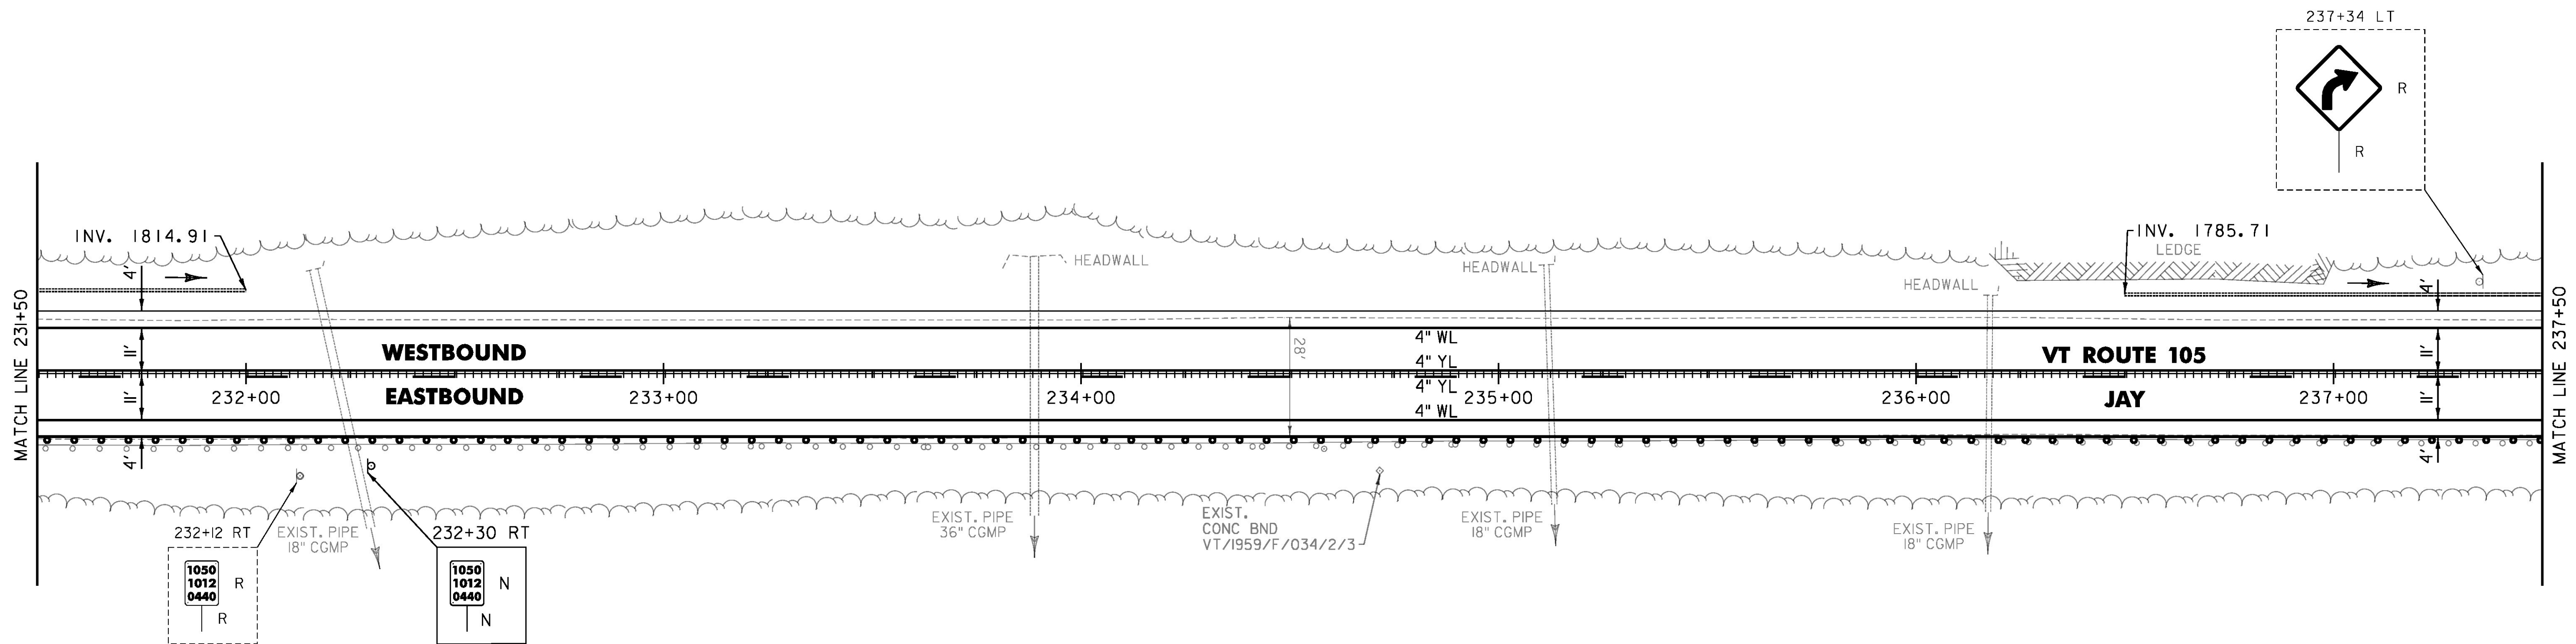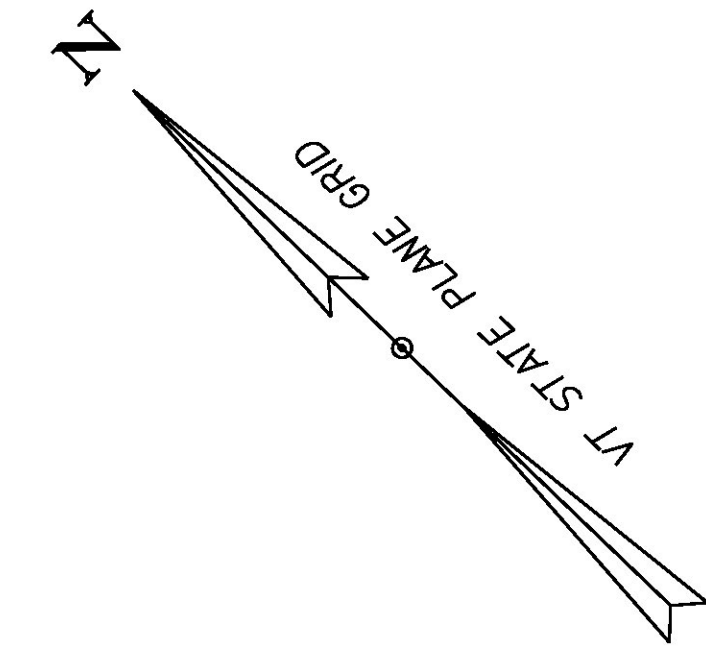

PROJECT NAME:	JAY-TROY
PROJECT NUMBER:	STP 2915(I)
FILE NAME:	z10b232bdr.dgn
PROJECT LEADER:	P. SHEDD
DESIGNED BY:	N. LEMAY
PLAN SHEET 34	
PLOT DATE:	5/16/2014
DRAWN BY:	W. GORDON
CHECKED BY:	P. SHEDD
SHEET 67 OF 244	

