

TEMPORARY 4 INCH WHITE LINE, PAINT
 DURABLE 4 INCH WHITE LINE, POLYUREA
 237+50 TO 243+50 SOLID LT & RT

TEMPORARY 4 INCH YELLOW LINE, PAINT
 DURABLE 4 INCH YELLOW LINE, POLYUREA
 237+50 TO 237+60 SOLID LT, DASHED RT
 237+60 TO 243+40 DASHED CL
 243+40 TO 243+50 DASHED LT, SOLID RT



STEEL BEAM GUARDRAIL,
 GALVANIZED W/8 FEET POSTS
 237+50 TO 243+50 RT

REMOVAL AND DISPOSAL OF GUARDRAIL
 237+50 TO 243+50 RT

MILLED RUMBLE STRIPS
 237+50 TO 243+50 CL

6 INCH UNDERDRAIN PIPE
 237+50 TO 238+17 LT
 238+50 TO 240+15 LT
 240+50 TO 242+15 LT
 242+40 TO 243+50 LT

REMOVING SIGNS
 AS SHOWN - 1

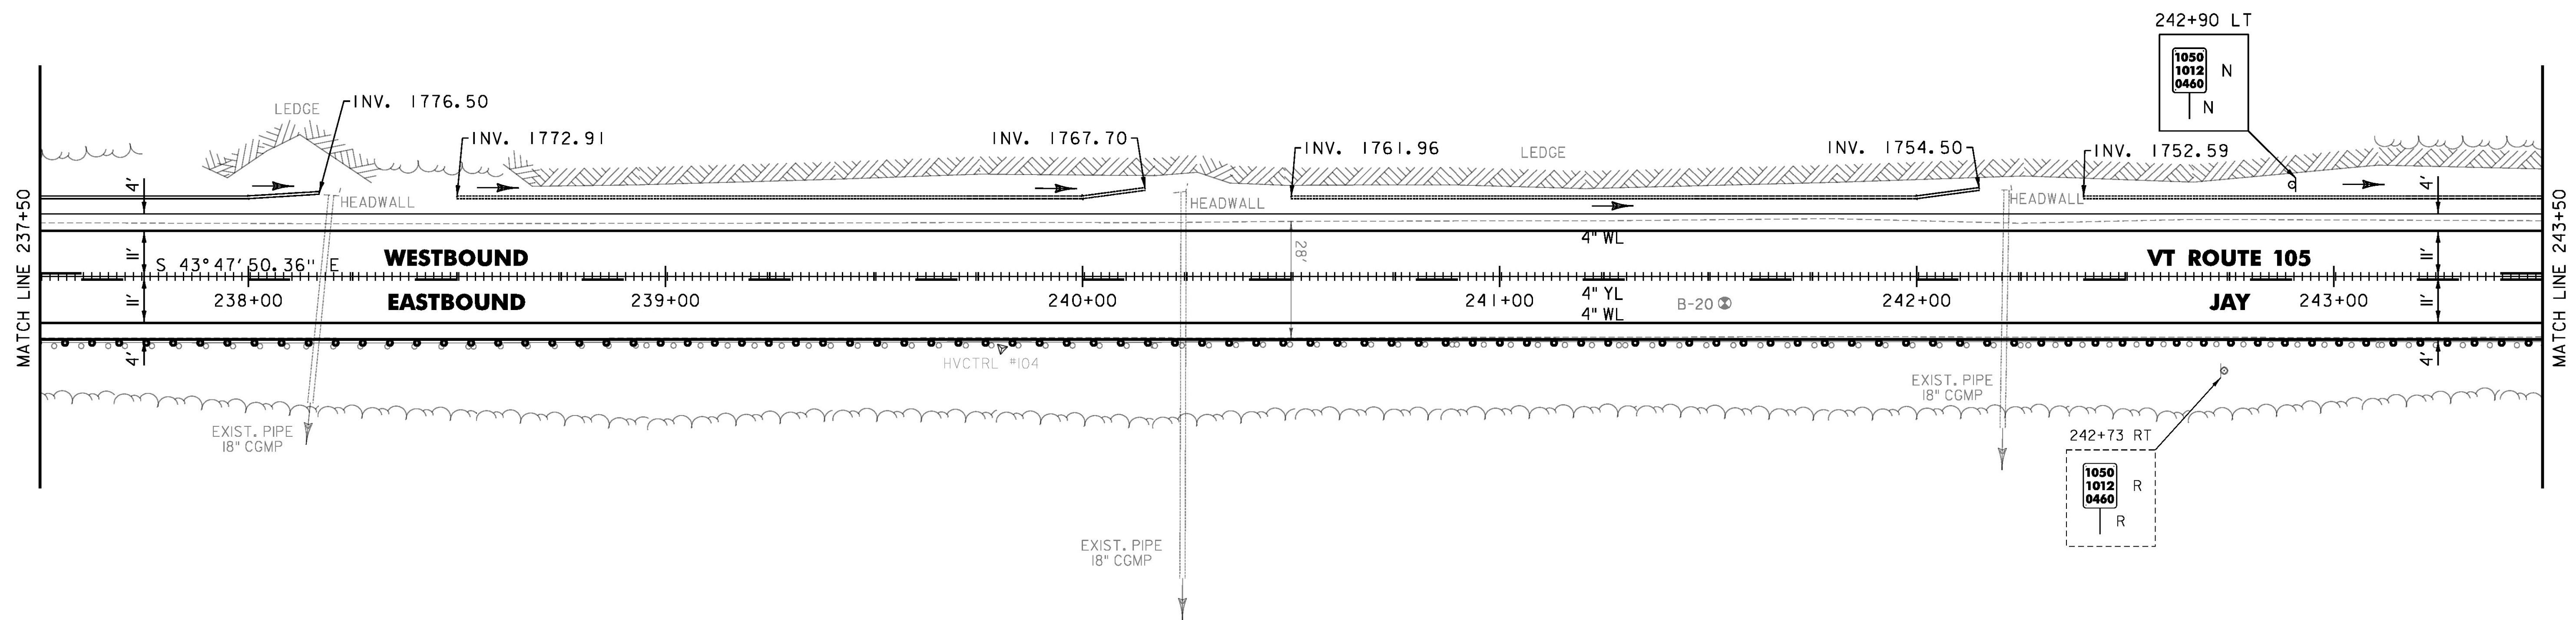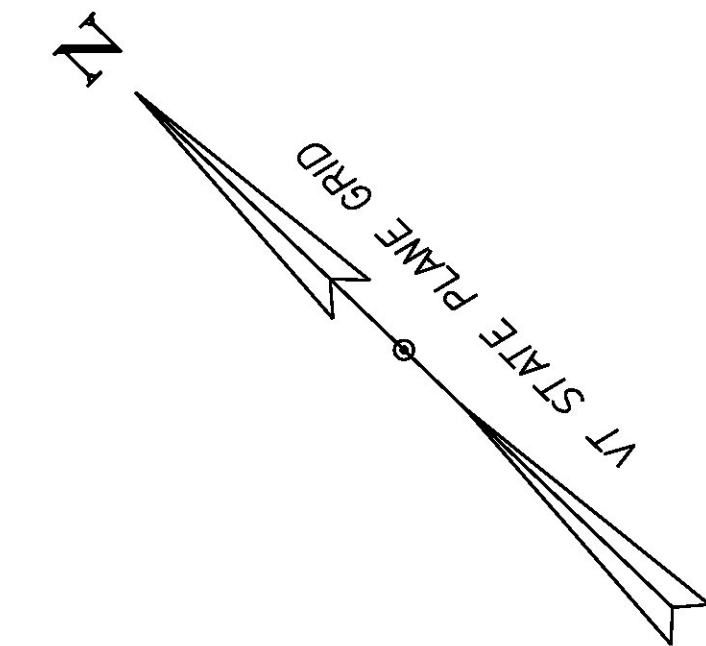

PROJECT NAME:	JAY-TROY	PLOT DATE:	5/16/2014
PROJECT NUMBER:	STP 2915(I)	DRAWN BY:	W. GORDON
FILE NAME:	z10b232bdr.dgn	CHECKED BY:	P. SHEDD
DESIGNED BY:	N. LEMAY	PLAN SHEET	35
		SHEET	68 OF 244

