


TEMPORARY 4 INCH WHITE LINE, PAINT  
 DURABLE 4 INCH WHITE LINE, POLYUREA  
 249+50 TO 255+50 SOLID LT & RT


TEMPORARY 4 INCH YELLOW LINE, PAINT  
 DURABLE 4 INCH YELLOW LINE, POLYUREA  
 249+50 TO 251+30 DASHED LT, SOLID RT  
 251+30 TO 255+50 SOLID LT & RT

REMOVAL AND DISPOSAL OF GUARDRAIL  
 249+50 TO 254+81 RT  
 MILLED RUMBLE STRIPS  
 249+50 TO 255+50 CL

6 INCH UNDERDRAIN PIPE  
 249+50 TO 252+45 LT  
 PROJECT DEMARCATION FENCE  
 253+05 TO 254+30 RT

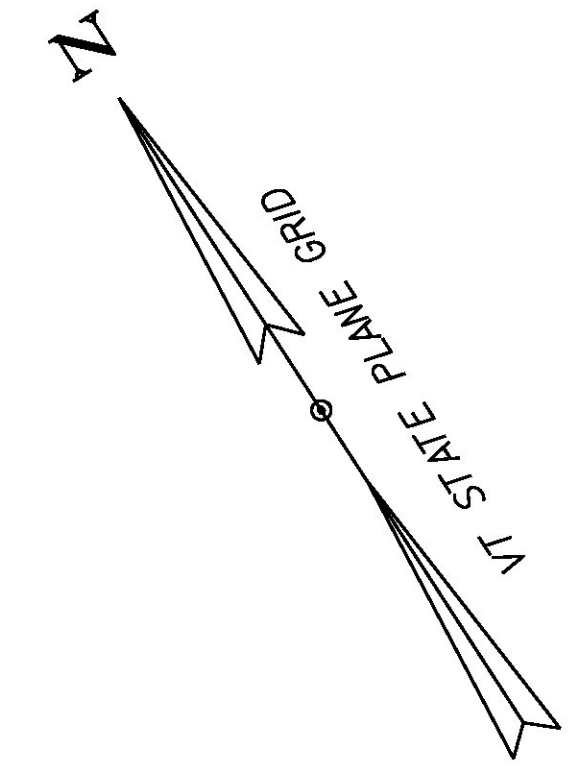

CURVE (31)  
 DELTA = 18° 29' 18" LT  
 D = 2° 58' 07"  
 R = 1930.00'  
 T = 314.12'  
 L = 622.77'  
 E = 25.39'  
 BANK = 0.052

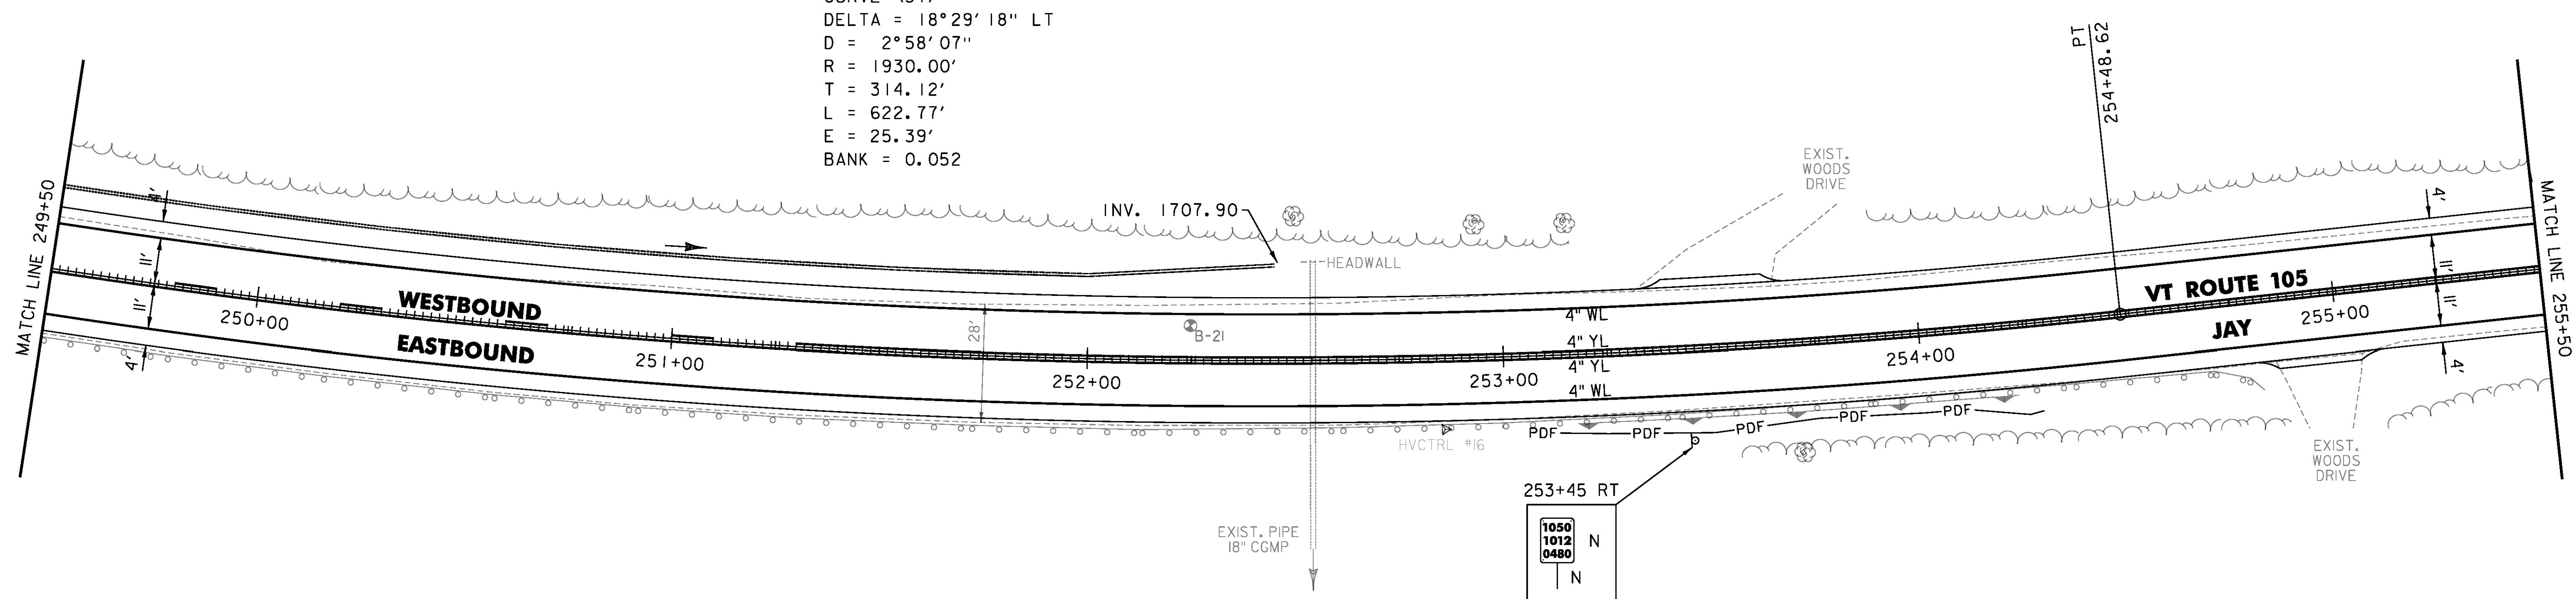

1050	N
1012	N
0480	N



PROJECT NAME:	JAY-TROY
PROJECT NUMBER:	STP 2915(I)
FILE NAME:	z10b232bdr.dgn
PROJECT LEADER:	P. SHEDD
DESIGNED BY:	N. LEMAY
PLAN SHEET	37
PLOT DATE:	5/16/2014
DRAWN BY:	W. GORDON
CHECKED BY:	P. SHEDD
SHEET	70 OF 244