
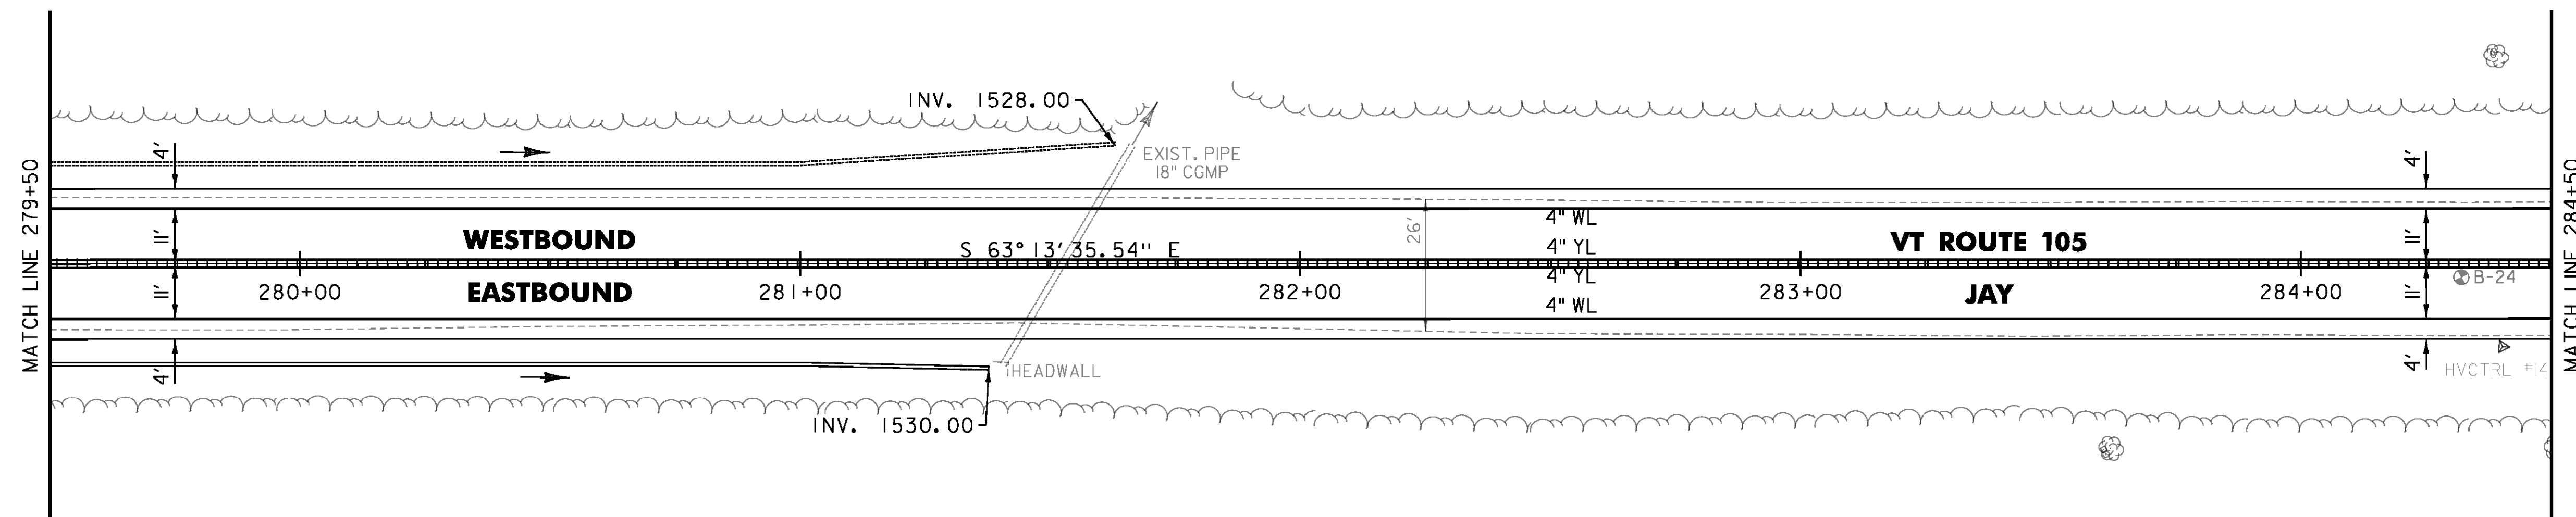


TEMPORARY 4 INCH WHITE LINE, PAINT
 DURABLE 4 INCH WHITE LINE, POLYUREA
 279+50 TO 284+50 SOLID LT & RT
 TEMPORARY 4 INCH YELLOW LINE, PAINT
 DURABLE 4 INCH YELLOW LINE, POLYUREA
 279+50 TO 284+50 SOLID LT & RT

MILLED RUMBLE STRIPS
 279+50 TO 284+50 CL
 6 INCH UNDERDRAIN PIPE
 279+50 TO 281+63 LT
~~279+50~~ TO 281+38 RT
 281+25

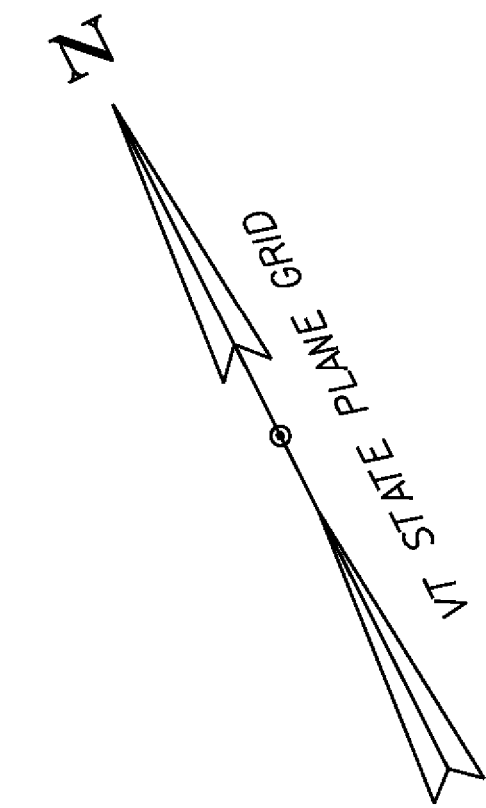

PROJECT NAME: JAY-TROY	PLOT DATE: 5/16/2014
PROJECT NUMBER: STP 2915(I)	DRAWN BY: W. GORDON
FILE NAME: z10b232bdr.dgn	CHECKED BY: P. SHEDD
DESIGNED BY: N. LEMAY	SHEET 75 OF 244
PLAN SHEET 42	