

TEMPORARY 4 INCH WHITE LINE, PAINT  
 DURABLE 4 INCH WHITE LINE, POLYUREA  
 284+50 TO 285+25 SOLID RT  
 284+50 TO 290+50 SOLID LT  
 286+05 TO 290+50 SOLID RT

TEMPORARY 4 INCH YELLOW LINE, PAINT  
 DURABLE 4 INCH YELLOW LINE, POLYUREA  
 284+50 TO 285+45 SOLID LT & RT  
 285+85 TO 290+50 SOLID LT & RT


REMOVAL AND DISPOSAL OF GUARDRAIL  
 289+61 TO 290+50 RT

MILLED RUMBLE STRIPS  
 284+50 TO 285+45 CL  
 285+85 TO 290+50 CL


REMOVING SIGNS  
 AS SHOWN - 3

STEEL BEAM GUARDRAIL, GALVANIZED  
 289+61 TO 289+73.5 RT

STEEL BEAM GUARDRAIL,  
 GALVANIZED W/ 8' POST  
 289+73.5 TO 290+50 RT

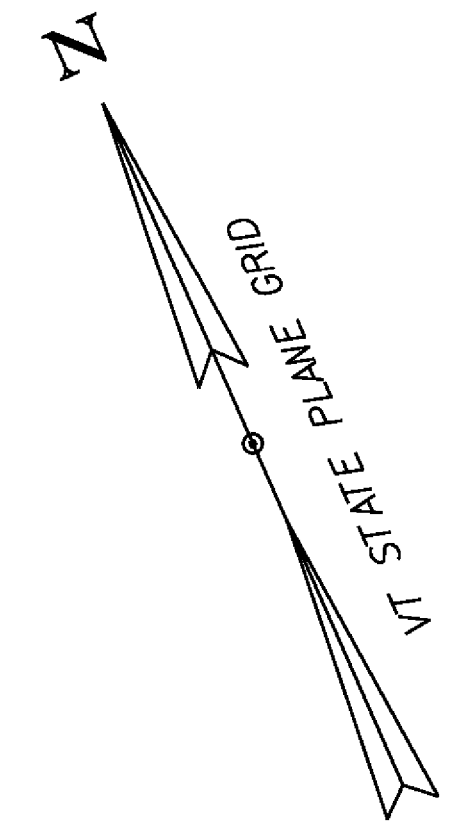

CURVE (34)  
 DELTA = 10° 17' 02" LT  
 D = 2° 29' 28"  
 R = 2300.00'  
 T = 206.97'  
 L = 412.82'  
 E = 9.29'  
 BANK = 0.046

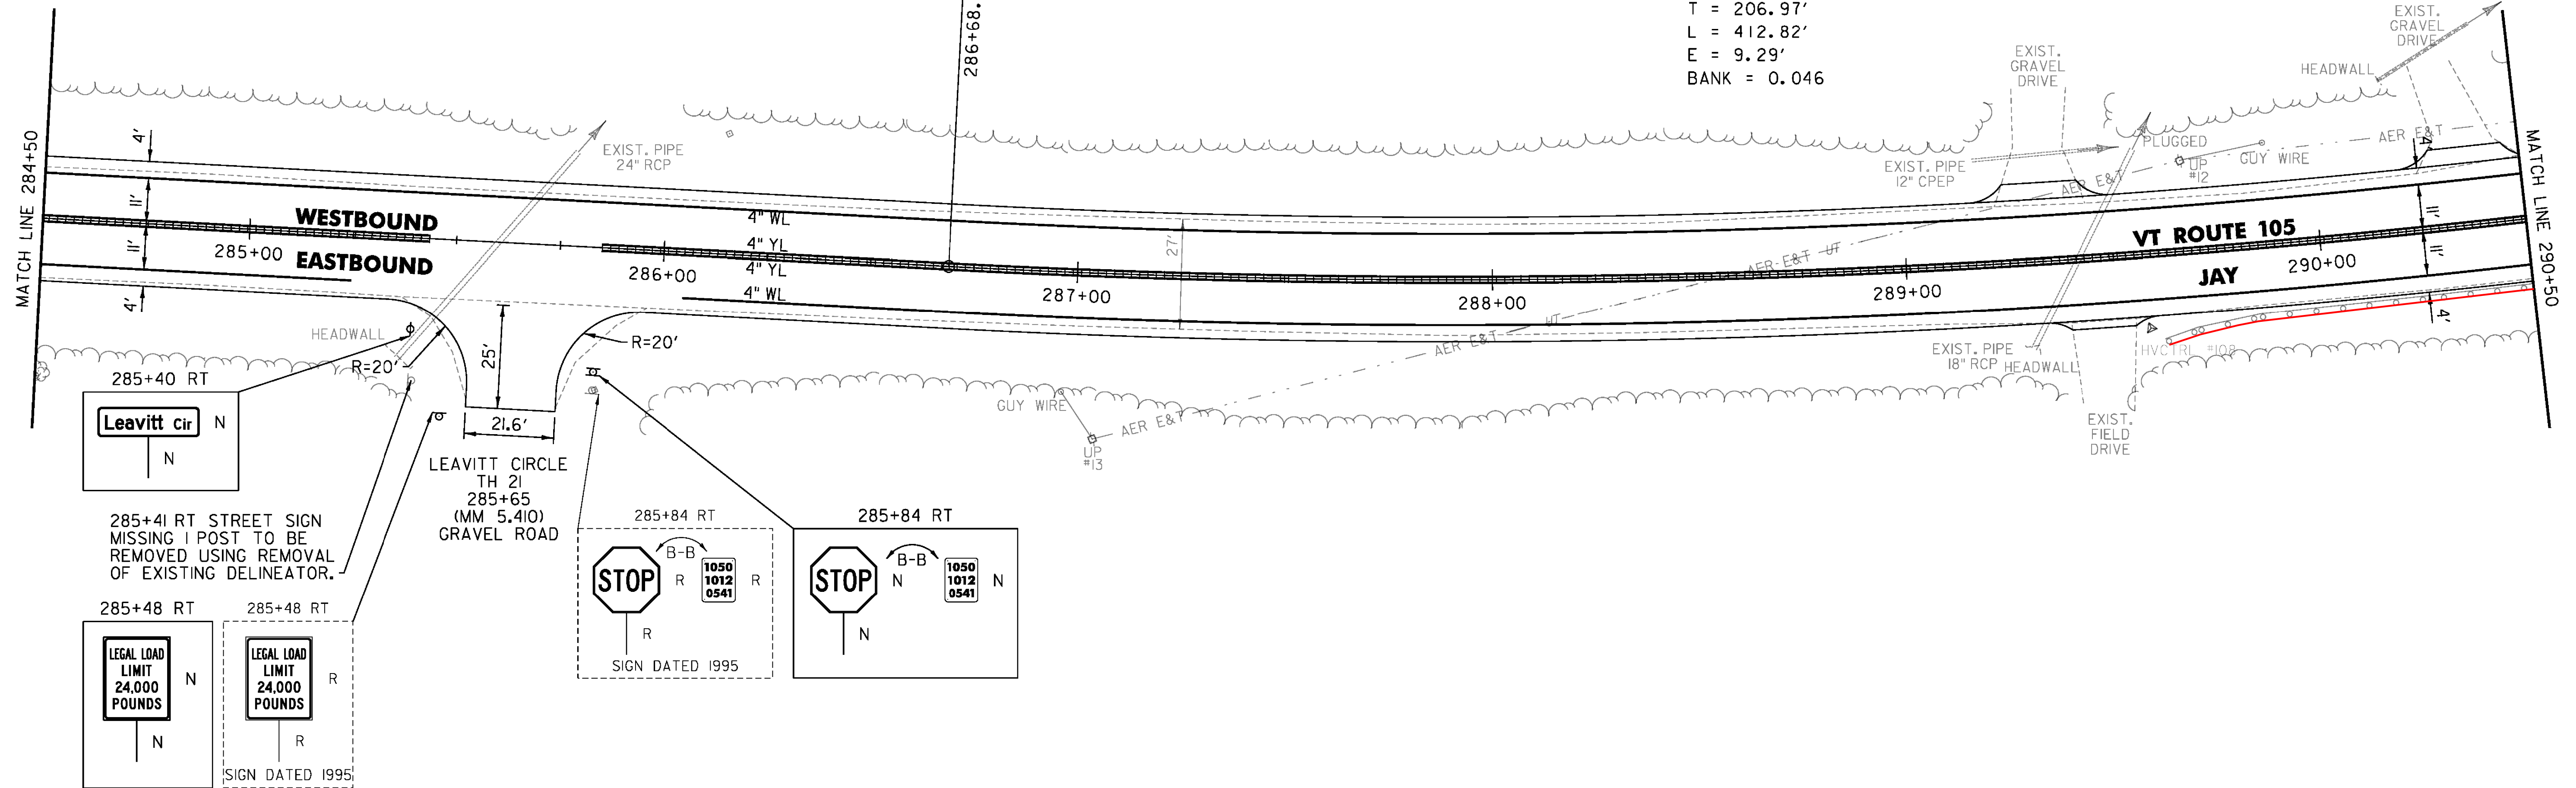

|                 |                |             |           |
|-----------------|----------------|-------------|-----------|
| PROJECT NAME:   | JAY-TROY       | PLOT DATE:  | 5/16/2014 |
| PROJECT NUMBER: | STP 2915(I)    | DRAWN BY:   | W. GORDON |
| FILE NAME:      | z10b232bdr.dgn | CHECKED BY: | P. SHEDD  |
| DESIGNED BY:    | N. LEMAY       | SHEET       | 76 OF 244 |
| PLAN SHEET      | 43             |             |           |