
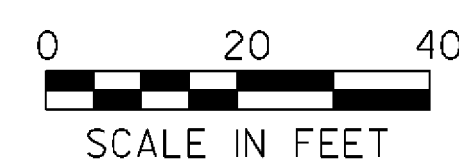
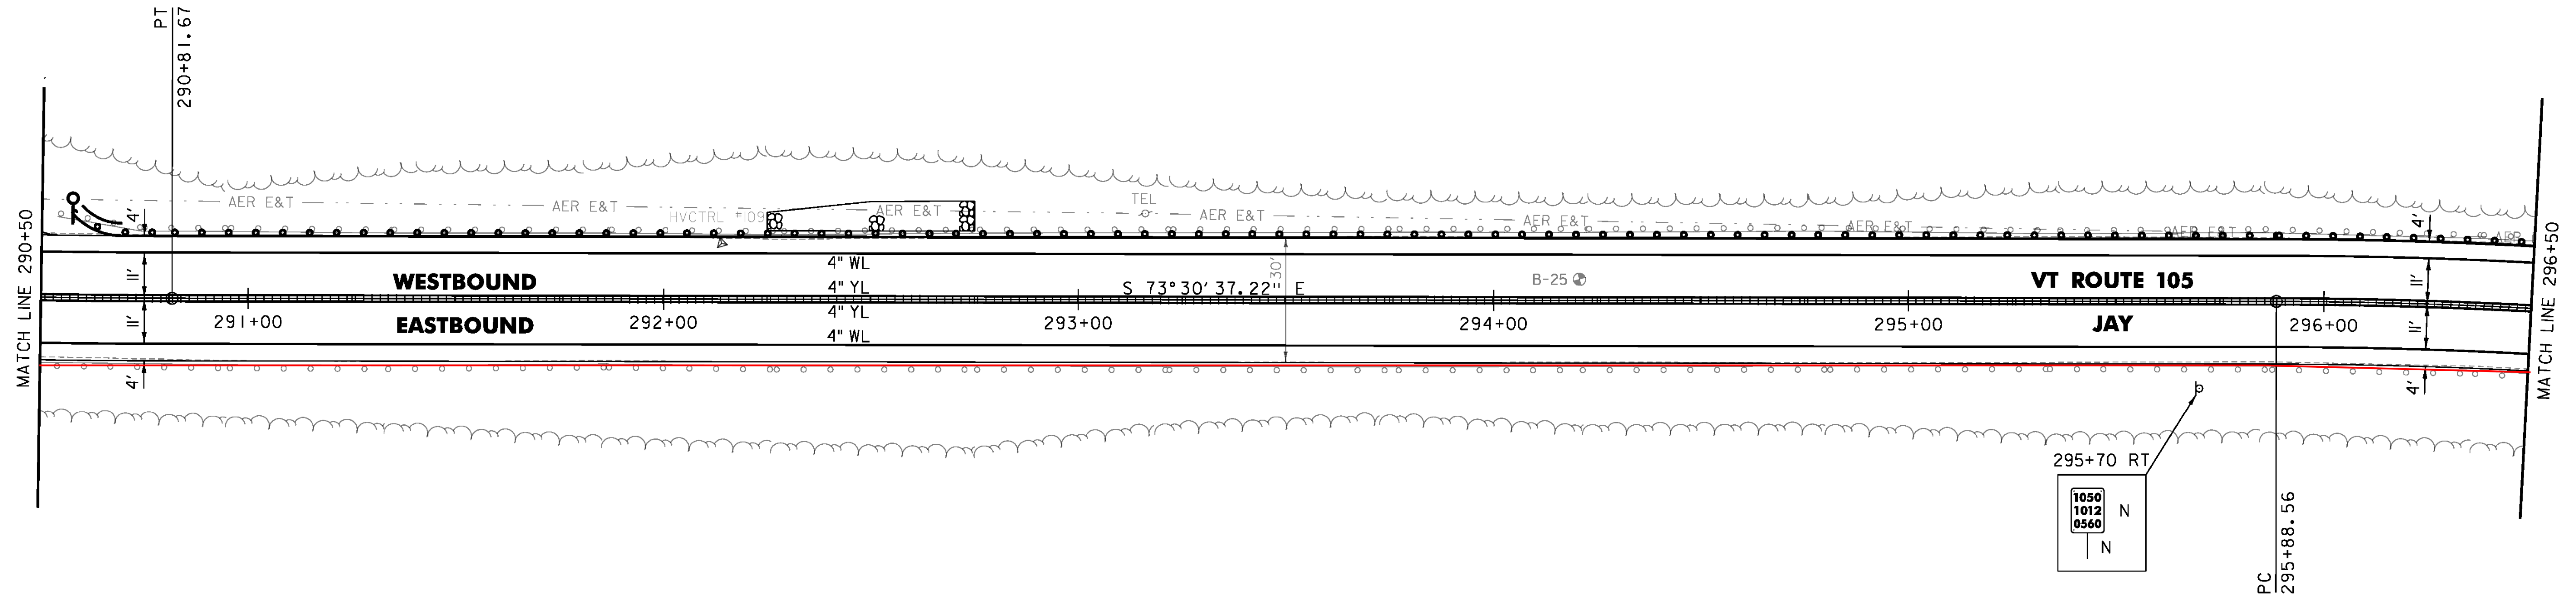


TEMPORARY 4 INCH WHITE LINE, PAINT  
 DURABLE 4 INCH WHITE LINE, POLYUREA  
 290+50 TO 296+50 SOLID LT & RT  
 TEMPORARY 4 INCH YELLOW LINE, PAINT  
 DURABLE 4 INCH YELLOW LINE, POLYUREA  
 290+50 TO 296+50 SOLID LT & RT

GRUBBING MATERIAL (6")  
 STONE FILL, TYPE I  
 GEOTEXTILE UNDER STONE FILL  
 292+25 TO 292+75 LT  
 STEEL BEAM GUARDRAIL, GALVANIZED  
 290+57.5 TO 290+70 LT  
 STEEL BEAM GUARDRAIL,  
 GALVANIZED W/8 FEET POSTS  
 290+70 TO 296+50 LT  
 290+50 TO 296+50 RT  
 ANCHOR FOR STEEL BEAM RAIL  
 I (SEE STANDARD G-1d)

REMOVAL AND DISPOSAL OF GUARDRAIL  
 290+50 TO 296+50 RT  
 290+54 TO 296+50 LT  
 DELINEATOR WITH STEEL POST  
 290+57.5 LT

MILLED RUMBLE STRIPS  
 290+50 TO 296+50 CL

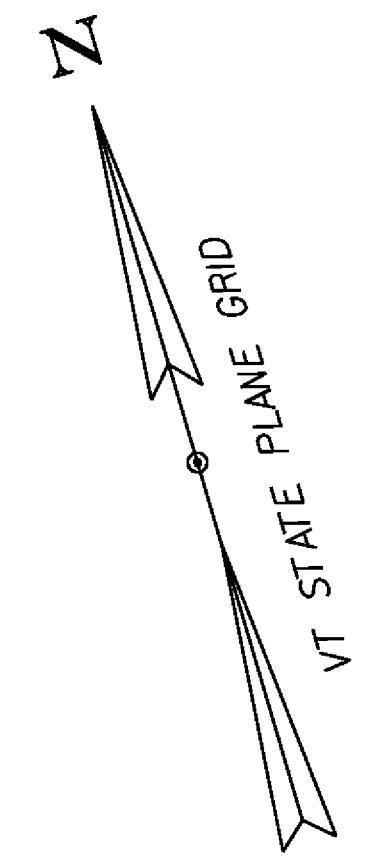

PROJECT NAME:	JAY-TROY	PLOT DATE:	5/16/2014
PROJECT NUMBER:	STP 2915(I)	DRAWN BY:	W. GORDON
FILE NAME:	z10b232bdr.dgn	CHECKED BY:	P. SHEDD
PROJECT LEADER:	P. SHEDD	SHEET	77 OF 244
DESIGNED BY:	N. LEMAY		
PLAN SHEET	44		