

TEMPORARY 4 INCH WHITE LINE, PAINT
 DURABLE 4 INCH WHITE LINE, POLYUREA
 420+50 TO 426+50 SOLID LT & RT

TEMPORARY 4 INCH YELLOW LINE, PAINT
 DURABLE 4 INCH YELLOW LINE, POLYUREA
 420+50 TO 425+05 SOLID LT, DASHED RT
 425+05 TO 426+50 DASHED LT, SOLID RT

REMOVAL AND DISPOSAL OF GUARDRAIL
 422+97 TO 424+72 RT
 425+19 TO 426+50 RT



MILLED RUMBLE STRIPS
 420+50 TO 426+50 CL

RELOCATE MAILBOX, SINGLE SUPPORT
 425+14 LT

6 INCH UNDERDRAIN PIPE
 420+50 TO 423+00 LT

PROJECT DEMARCATION FENCE
 423+65 TO 425+75 LT

REMOVING SIGNS
 AS SHOWN - 1

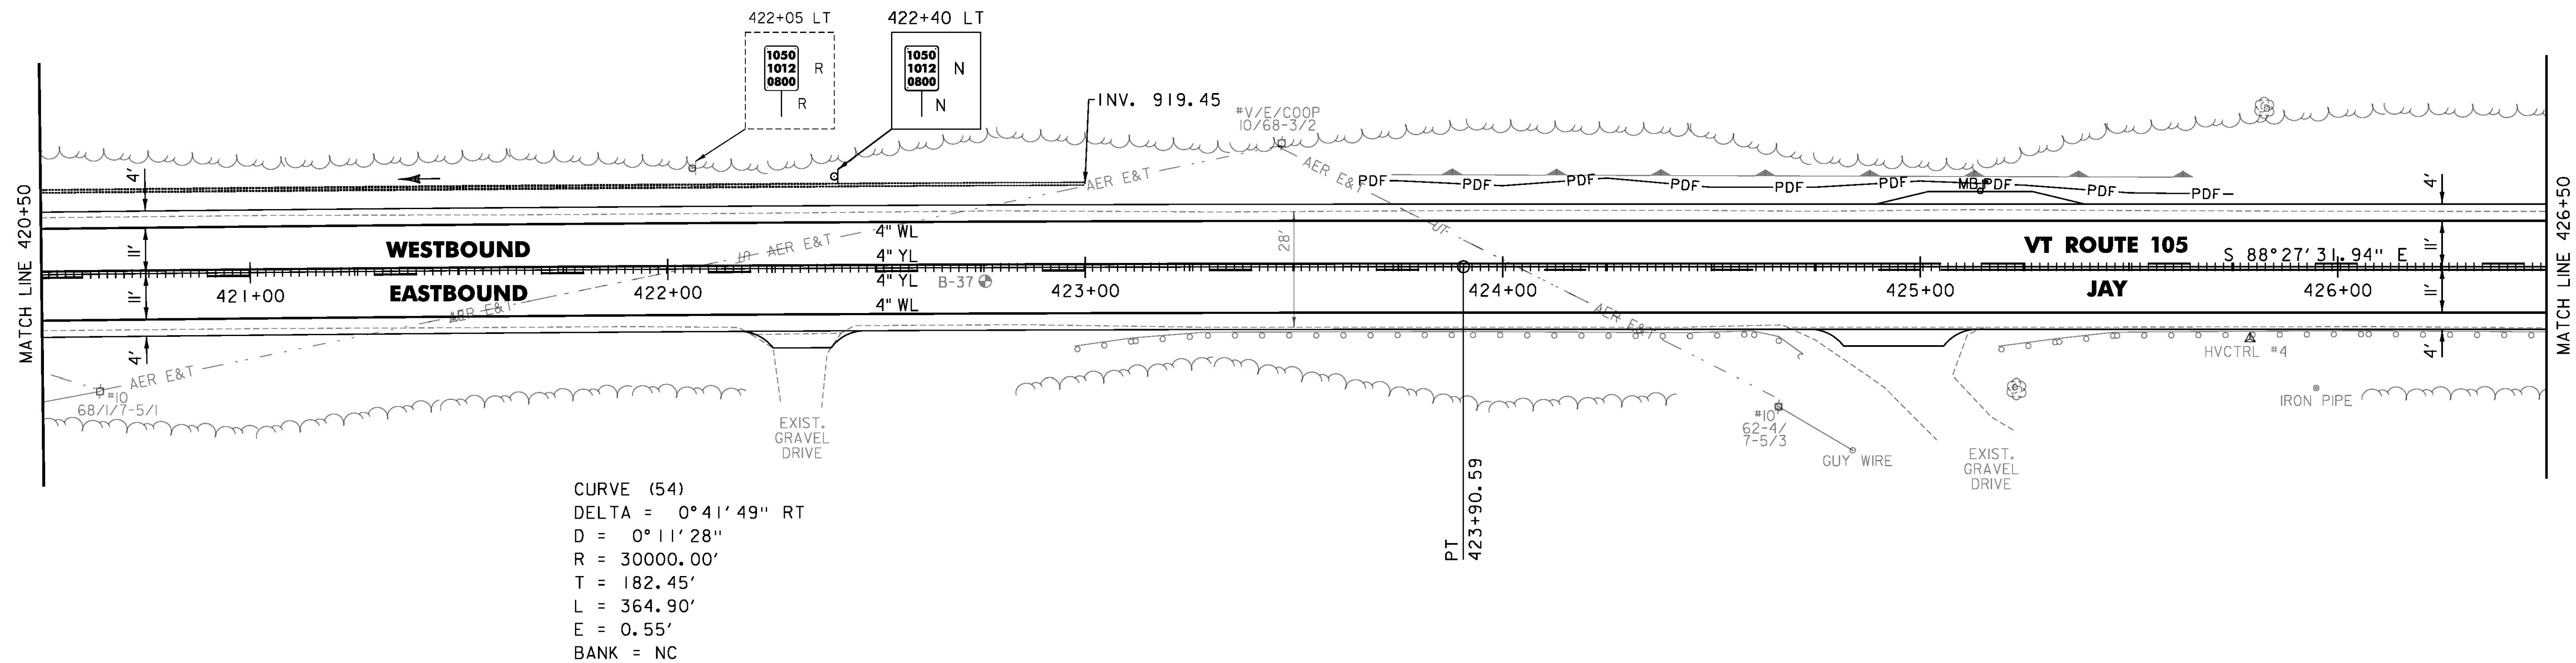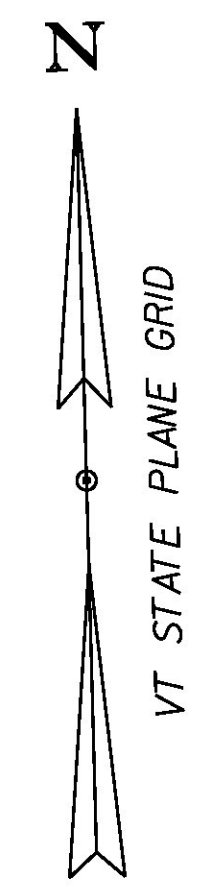

PROJECT NAME:	JAY-TROY
PROJECT NUMBER:	STP 2915(I)
FILE NAME:	z10b232bdr.dgn
PROJECT LEADER:	P. SHEDD
DESIGNED BY:	N. LEMAY
PLAN SHEET	66
PLOT DATE:	5/16/2014
DRAWN BY:	W. GORDON
CHECKED BY:	P. SHEDD
SHEET	99 OF 244

