
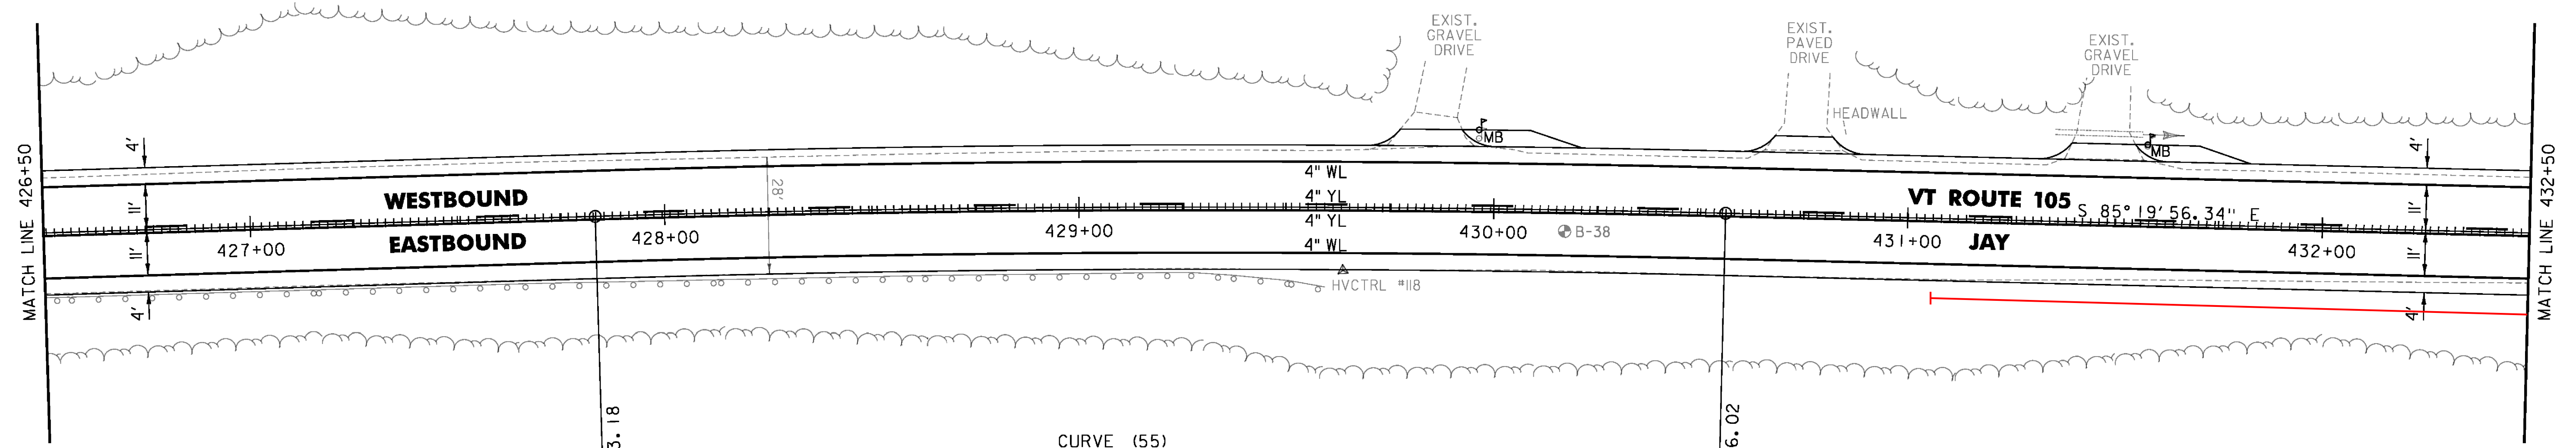


TEMPORARY 4 INCH WHITE LINE, PAINT  
 DURABLE 4 INCH WHITE LINE, POLYUREA  
 426+50 TO 432+50 SOLID LT & RT  
 TEMPORARY 4 INCH YELLOW LINE, PAINT  
 DURABLE 4 INCH YELLOW LINE, POLYUREA  
 426+50 TO 432+50 DASHED LT, SOLID RT

REMOVAL AND DISPOSAL OF GUARDRAIL  
 426+50 TO 429+59 RT  
 MILLED RUMBLE STRIPS  
 426+50 TO 432+50 CL  
 RELOCATE MAILBOX, SINGLE SUPPORT  
 429+96 LT  
 431+57 LT

6" UNDERDRAIN  
 431+10 TO 432+50 RT

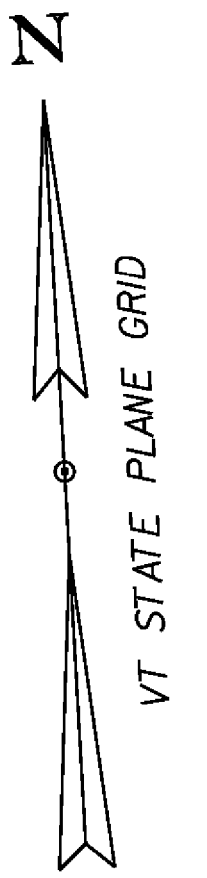

CURVE (55)  
 DELTA = 3° 07' 36" RT  
 D = 1° 08' 45"  
 R = 5000.00'  
 T = 136.46'  
 L = 272.84'  
 E = 1.86'  
 BANK = 0.024



PROJECT NAME: JAY-TROY	PLOT DATE: 5/16/2014
PROJECT NUMBER: STP 2915(1)	DRAWN BY: W. GORDON
FILE NAME: z10b232bdr.dgn	CHECKED BY: P. SHEDD
DESIGNED BY: N. LEMAY	SHEET 100 OF 244
PLAN SHEET 67	