
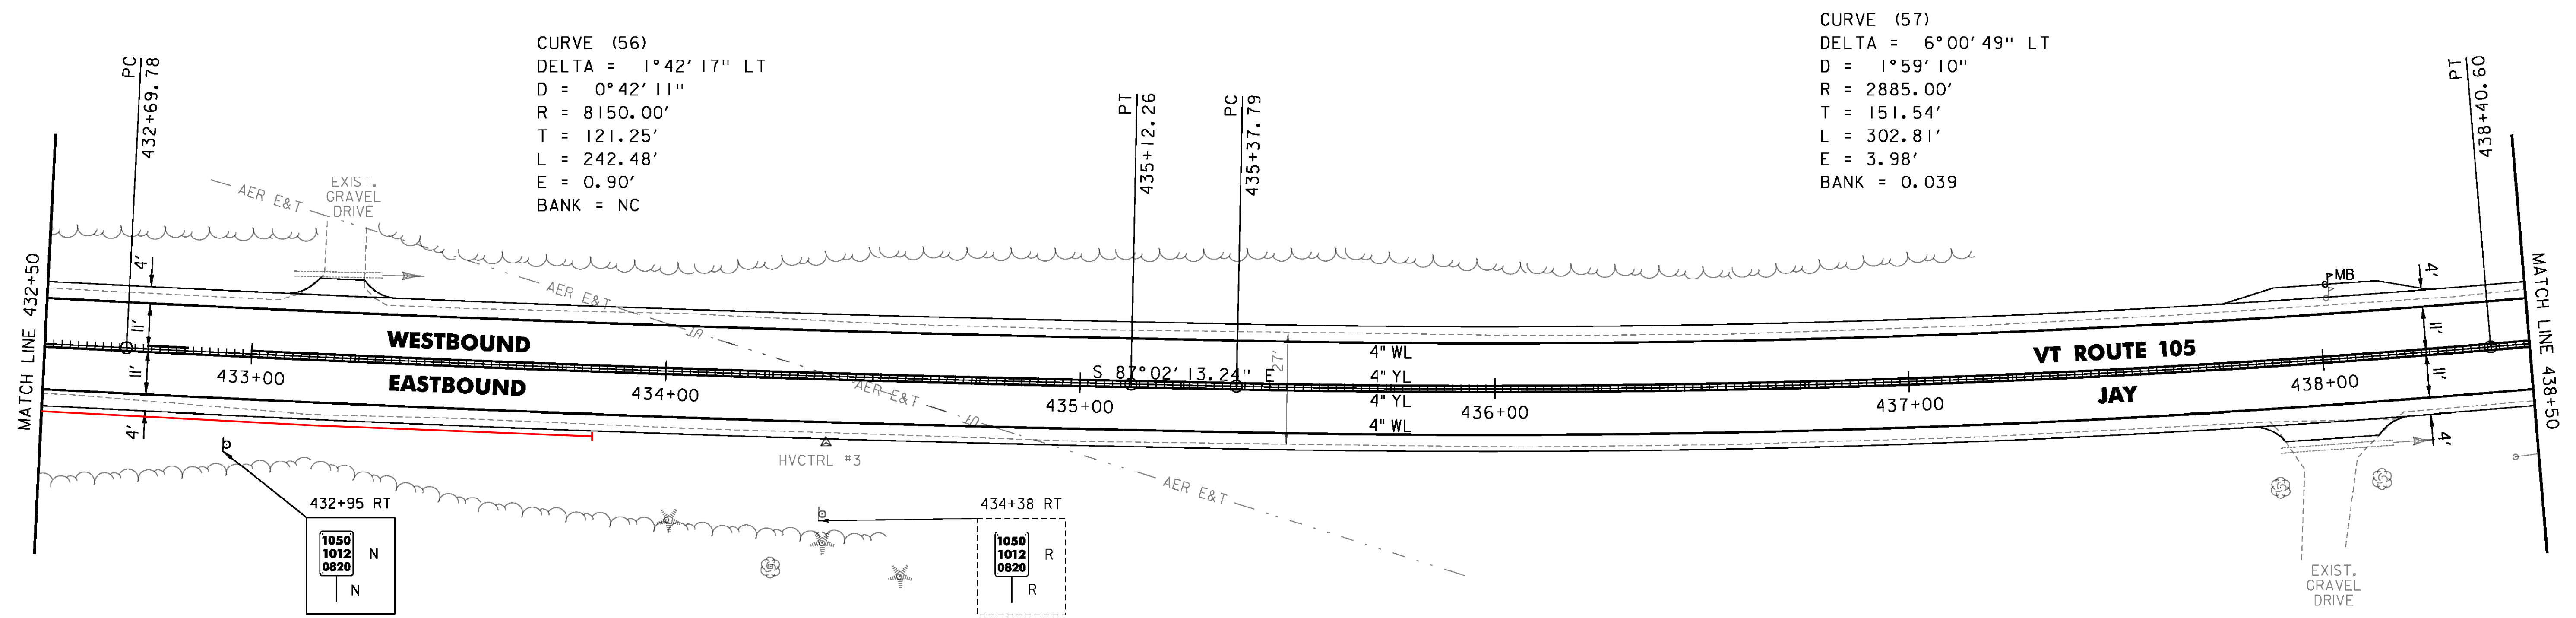


TEMPORARY 4 INCH WHITE LINE, PAINT
 DURABLE 4 INCH WHITE LINE, POLYUREA
 432+50 TO 438+50 SOLID LT & RT
 TEMPORARY 4 INCH YELLOW LINE, PAINT
 DURABLE 4 INCH YELLOW LINE, POLYUREA
 432+50 TO 433+00 DASHED LT, SOLID RT
 433+00 TO 438+50 SOLID LT & RT

MILLED RUMBLE STRIPS
 432+50 TO 438+50 CL
 RELOCATE MAILBOX, SINGLE SUPPORT
 438+02 LT
 REMOVING SIGNS
 AS SHOWN - 1

6" UNDERDRAIN
 432+50 TO 433+80 RT
 438+47 TO 438+50 LT

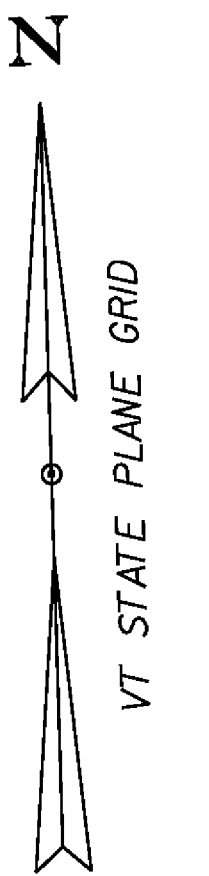

PROJECT NAME: JAY-TROY	PLOT DATE: 5/16/2014
PROJECT NUMBER: STP 2915(1)	DRAWN BY: W. GORDON
FILE NAME: z10b232bdr.dgn	CHECKED BY: P. SHEDD
DESIGNED BY: N. LEMAY	SHEET 101 OF 244
PLAN SHEET 68	