

TEMPORARY 4 INCH WHITE LINE, PAINT
 DURABLE 4 INCH WHITE LINE, POLYUREA
 438+50 TO 441+00 SOLID LT
 438+50 TO T1+50 SOLID RT
 441+00 TO 441+22 SOLID LT (TH 30)
 441+43 TO 442+02 SOLID LT (TH 30)
 442+02 TO T1+50 SOLID LT

TEMPORARY 4 INCH YELLOW LINE, PAINT
 DURABLE 4 INCH YELLOW LINE, POLYUREA
 438+50 TO 441+23 SOLID LT & RT
 441+32 TO 441+43 DOUBLE SOLID LT (TH 30)
 441+63 TO 442+25 SOLID LT & RT
 T0+00 TO T1+50 SOLID LT, DASHED RT

TEMPORARY 24 INCH STOP BAR, PAINT
 DURABLE 24 INCH STOP BAR (OPTION BID ITEM)
 441+19 TO 441+42 LT (TH 30)



TEMPORARY LETTER OR SYMBOL, PAINT
 DURABLE LETTER OR SYMBOL (OPTION BID ITEM)
 441+32 LT - "STOP" (TH 30)

MILLED RUMBLE STRIPS
 438+50 TO 441+23 CL
 441+63 TO T1+50 CL

6" UNDERDRAIN
 438+50 TO 439+87 LT

PROJECT DEMARCATION FENCE
 441+70 TO T0+50 RT

REMOVING SIGNS
 AS SHOWN - 5

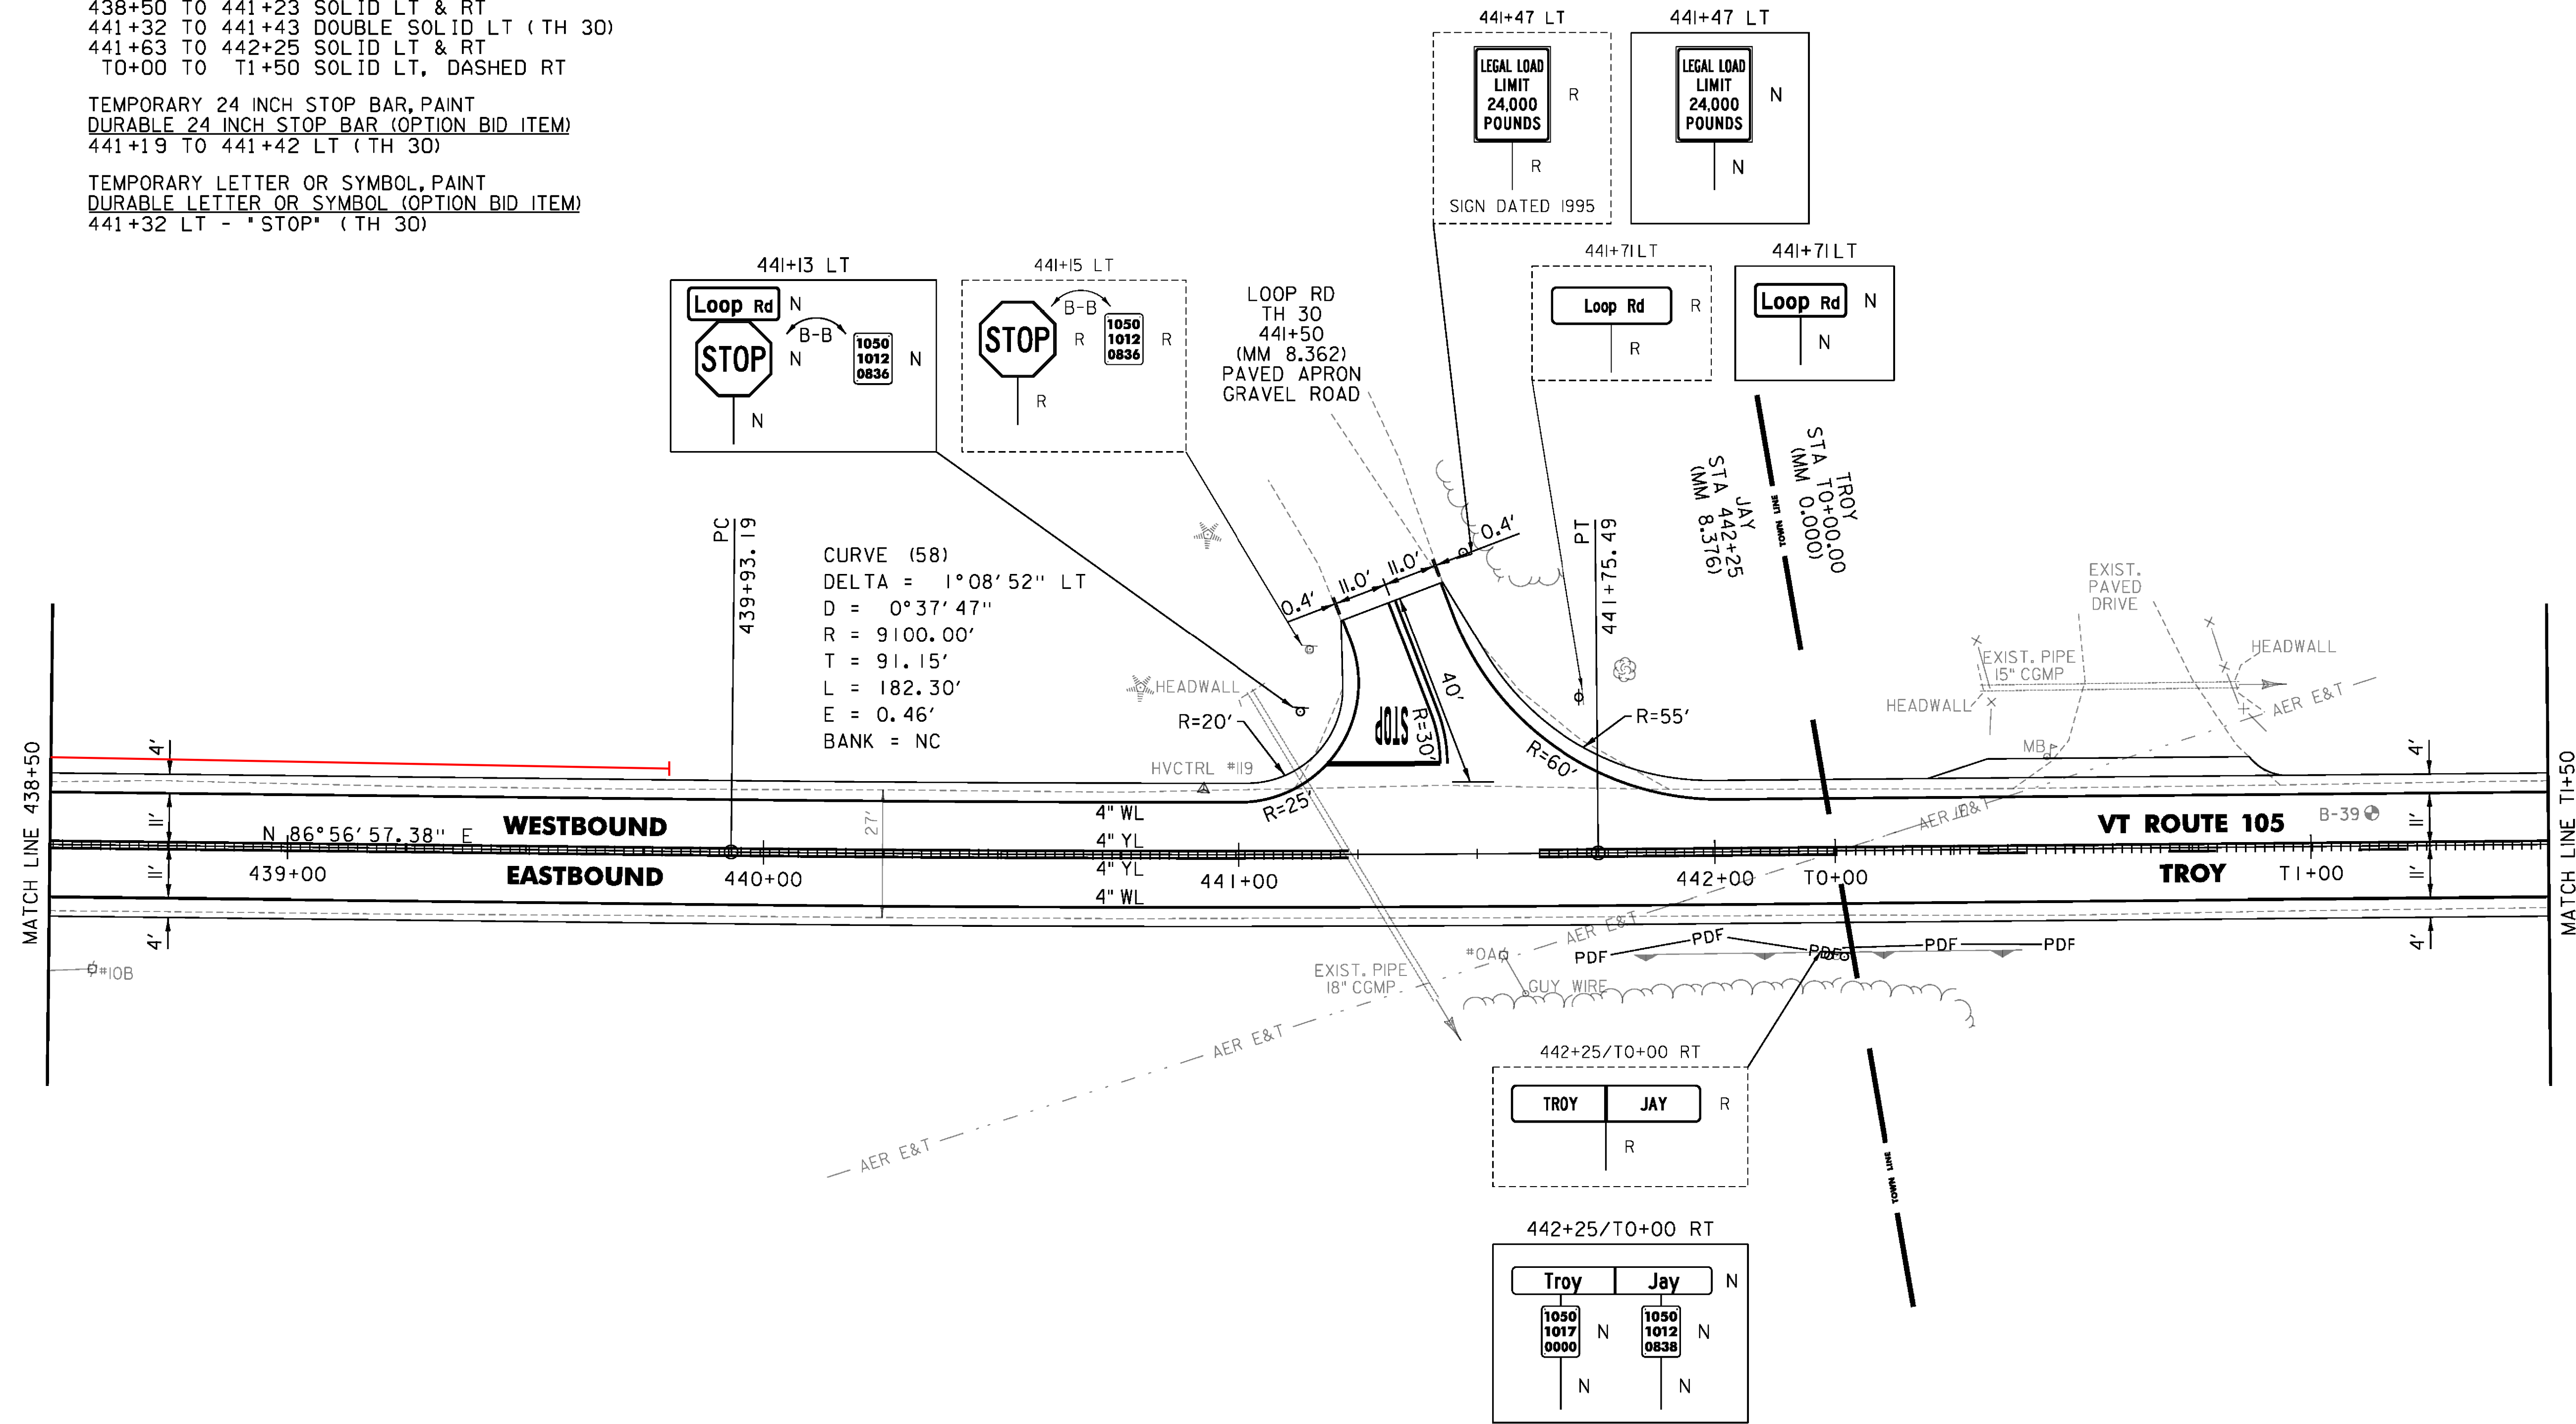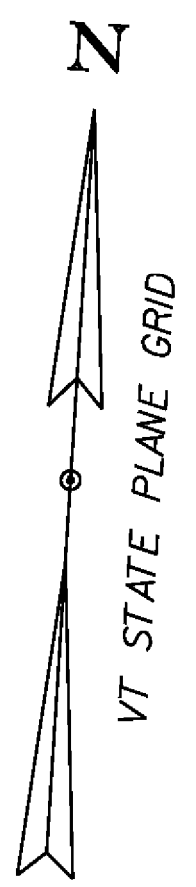

PROJECT NAME:	JAY-TROY	PLOT DATE:	5/16/2014
PROJECT NUMBER:	STP 2915(I)	DRAWN BY:	W. GORDON
FILE NAME:	z10b232bdr.dgn	CHECKED BY:	P. SHEDD
DESIGNED BY:	N. LEMAY	SHEET	102 OF 244
PLAN SHEET	69		