


**CURVE 1 - JAY**

**CURVE 2 - JAY**

**CURVE 3 - JAY**

**CURVE 4 - JAY**

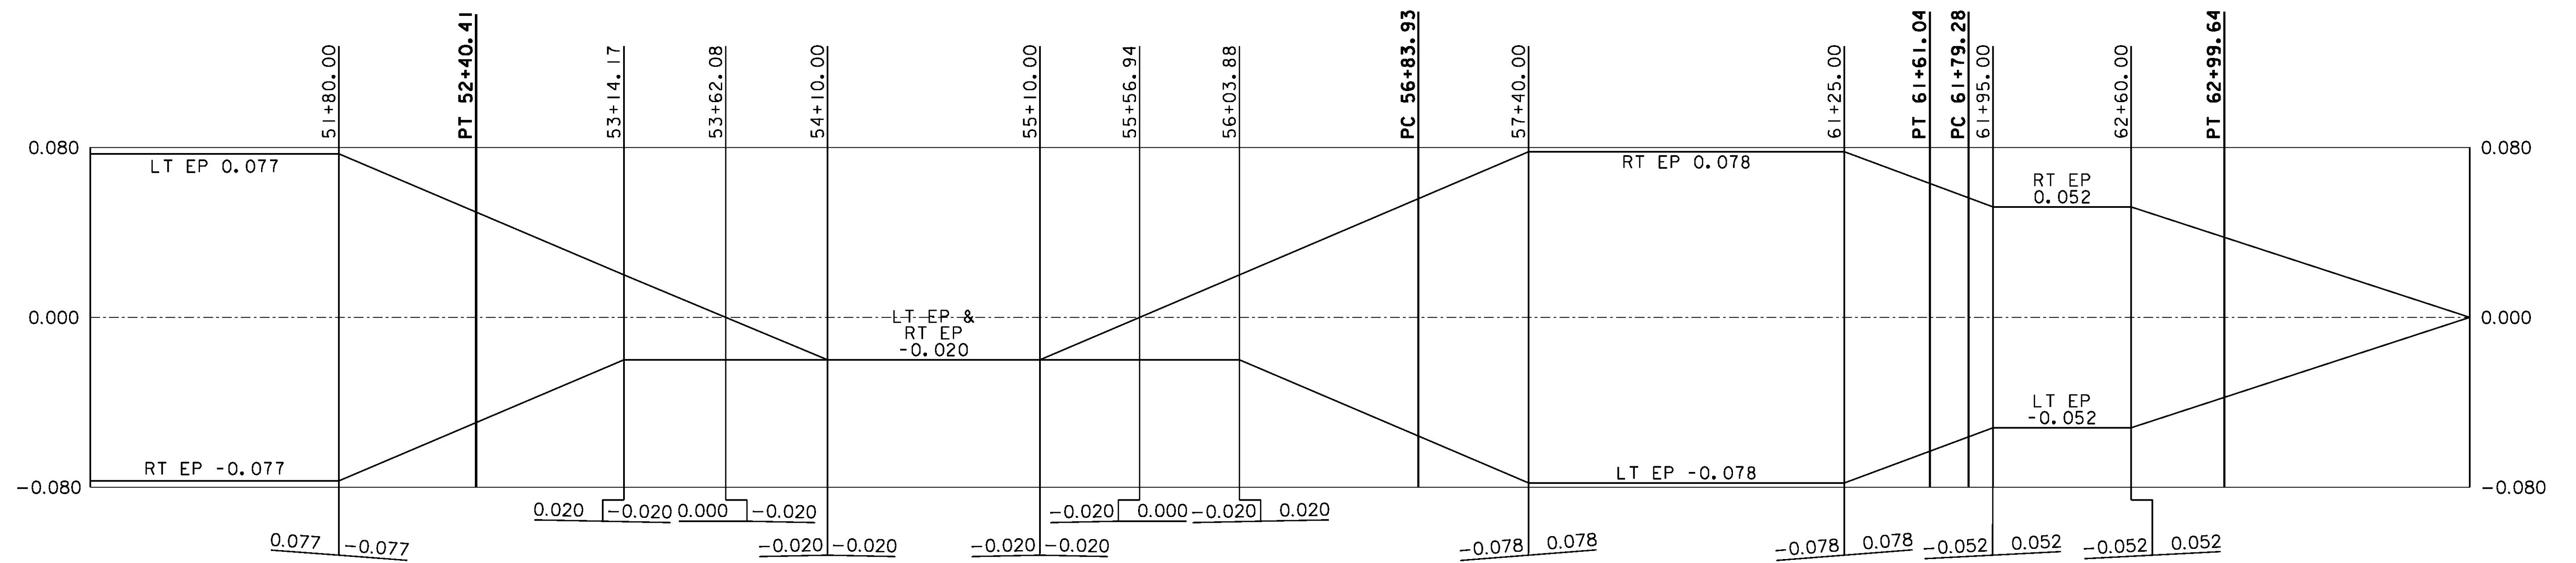

**CURVE 4 - JAY**

**CURVE 5 - JAY**

**CURVE 6 - JAY**

NOT TO SCALE

PROJECT NAME:	JAY-TROY	PLOT DATE:	5/16/2014
PROJECT NUMBER:	STP 2915(I)	DRAWN BY:	S. GOODWIN
FILE NAME:	z10b232frm.dgn	CHECKED BY:	P. SHEDD
PROJECT LEADER:	P. SHEDD	DESIGNED BY:	N. LEMAY
BANKING SHEET 1			SHEET 114 OF 244