


CURVE 7 - JAY

CURVE 8 - JAY

CURVE 9 - JAY

CURVE 10 - JAY

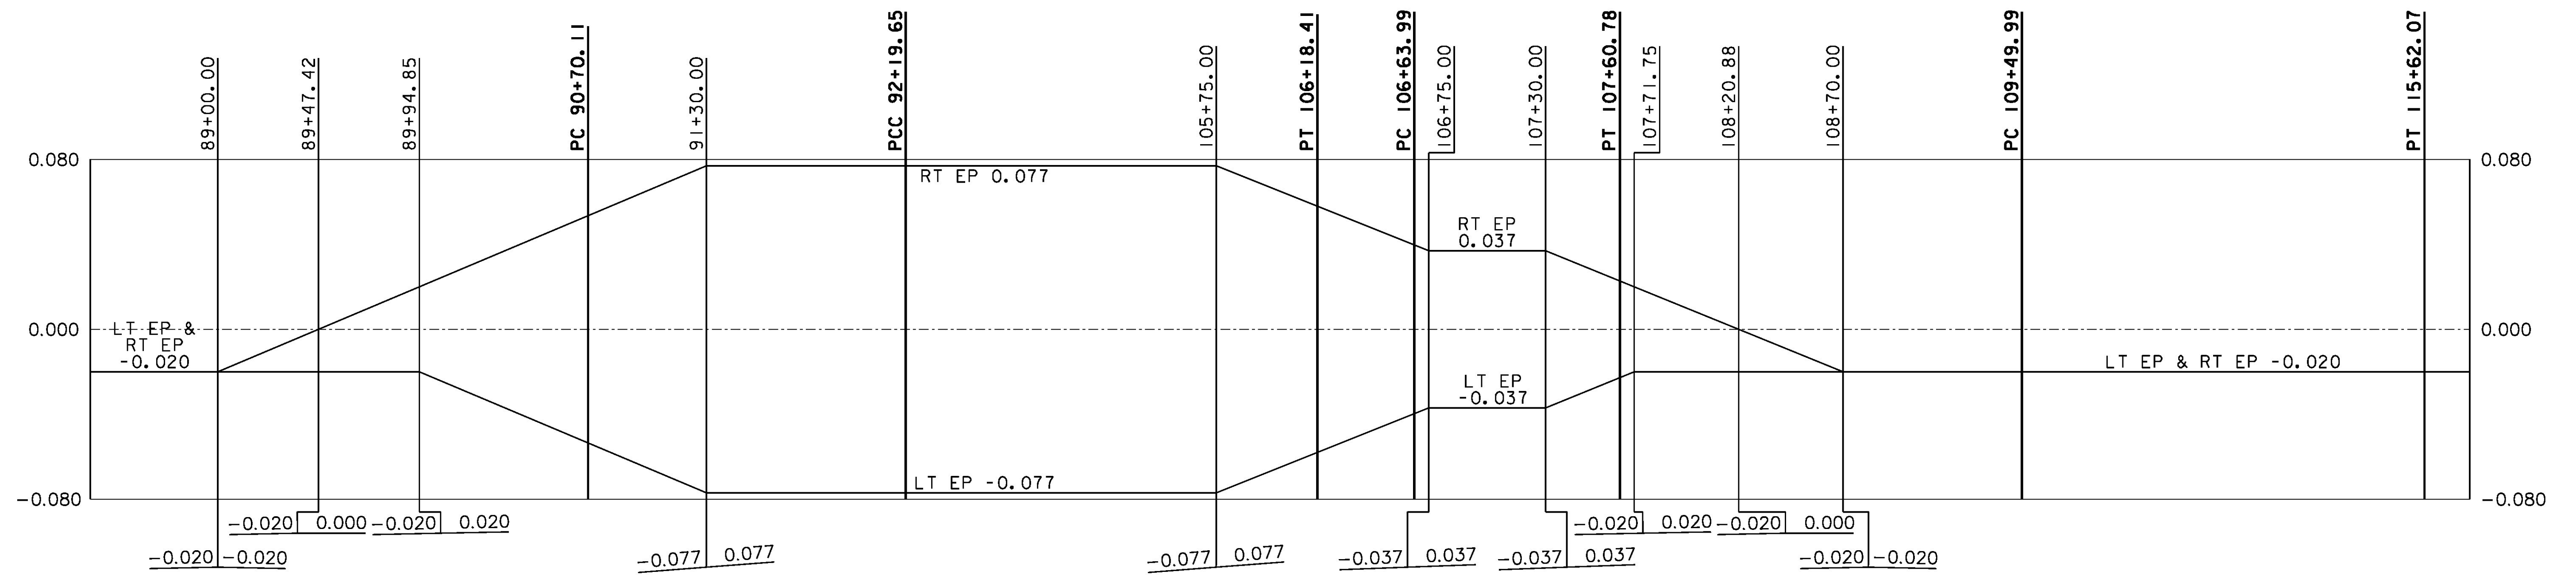

CURVE 11 - JAY

CURVE 12 - JAY

CURVE 13 - JAY

CURVE 14 - JAY

NOT TO SCALE

PROJECT NAME:	JAY-TROY
PROJECT NUMBER:	STP 2915(I)
FILE NAME:	z10b232frm.dgn
PROJECT LEADER:	P. SHEDD
DESIGNED BY:	N. LEMAY
BANKING SHEET 2	
PLOT DATE:	5/16/2014
DRAWN BY:	S. GOODWIN
CHECKED BY:	P. SHEDD
SHEET	115 OF 244