


CURVE 28 - JAY

CURVE 29 - JAY

CURVE 30 - JAY

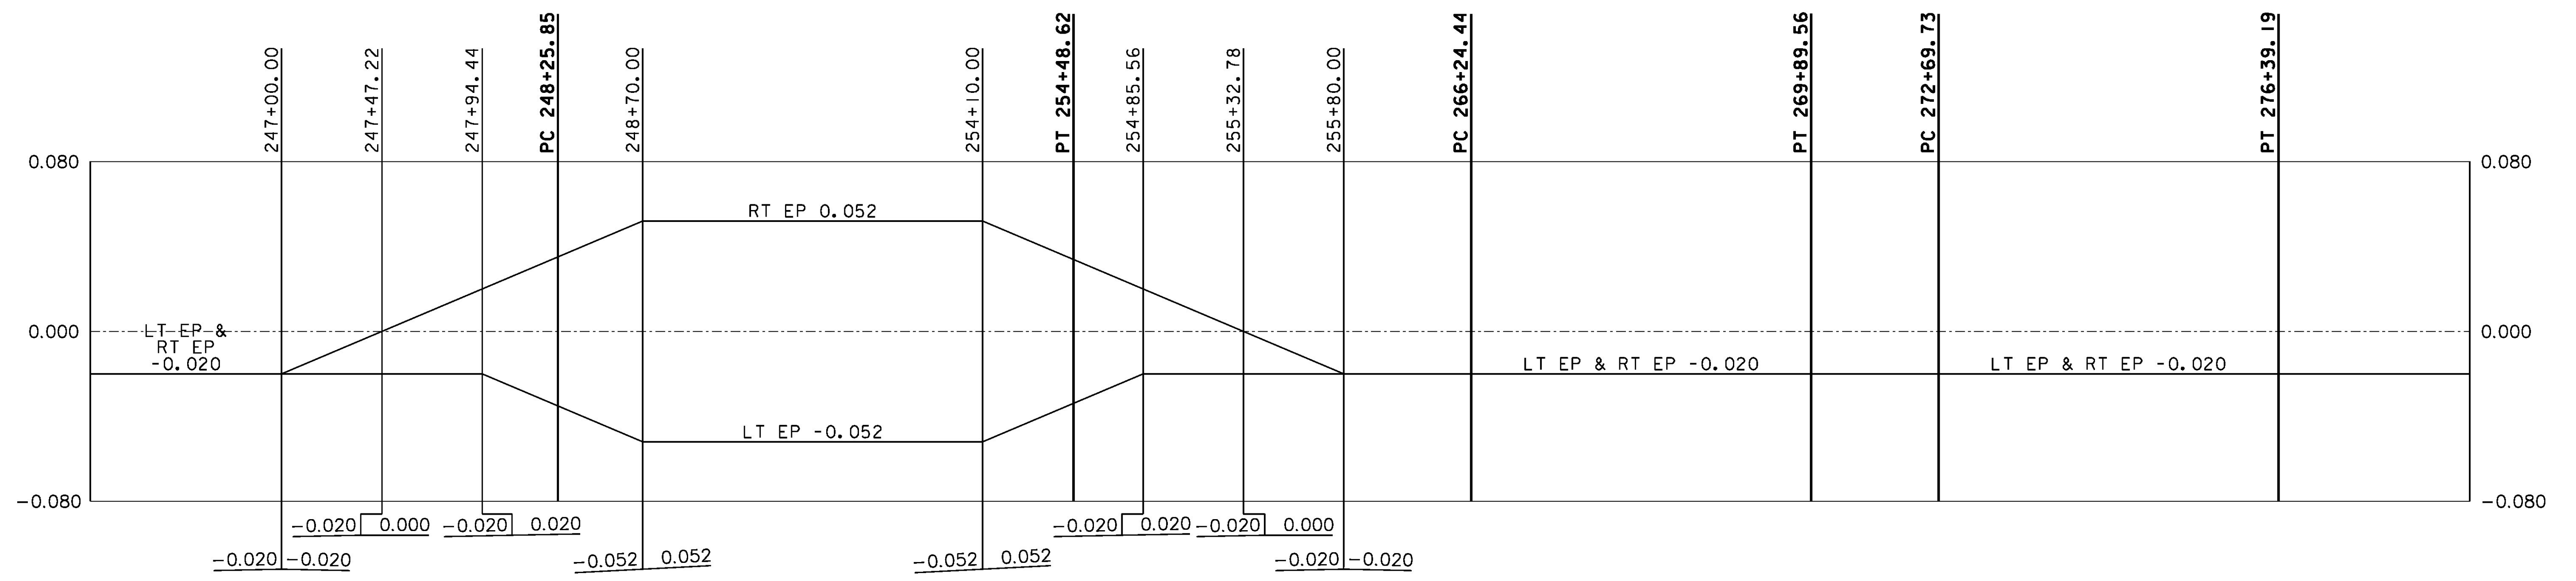

CURVE 31 - JAY

CURVE 32 - JAY

CURVE 33 - JAY

NOT TO SCALE

PROJECT NAME: JAY-TROY	PLOT DATE: 5/16/2014
PROJECT NUMBER: STP 2915(I)	DRAWN BY: S. GOODWIN
FILE NAME: z10b232frm.dgn	CHECKED BY: P. SHEDD
PROJECT LEADER: P. SHEDD	DESIGNED BY: N. LEMAY
BANKING SHEET 5	SHEET 118 OF 244