

CURVE 47 - JAY


CURVE 48 - JAY

CURVE 49 - JAY

CURVE 50 - JAY

CURVE 51 - JAY

CURVE 52 - JAY

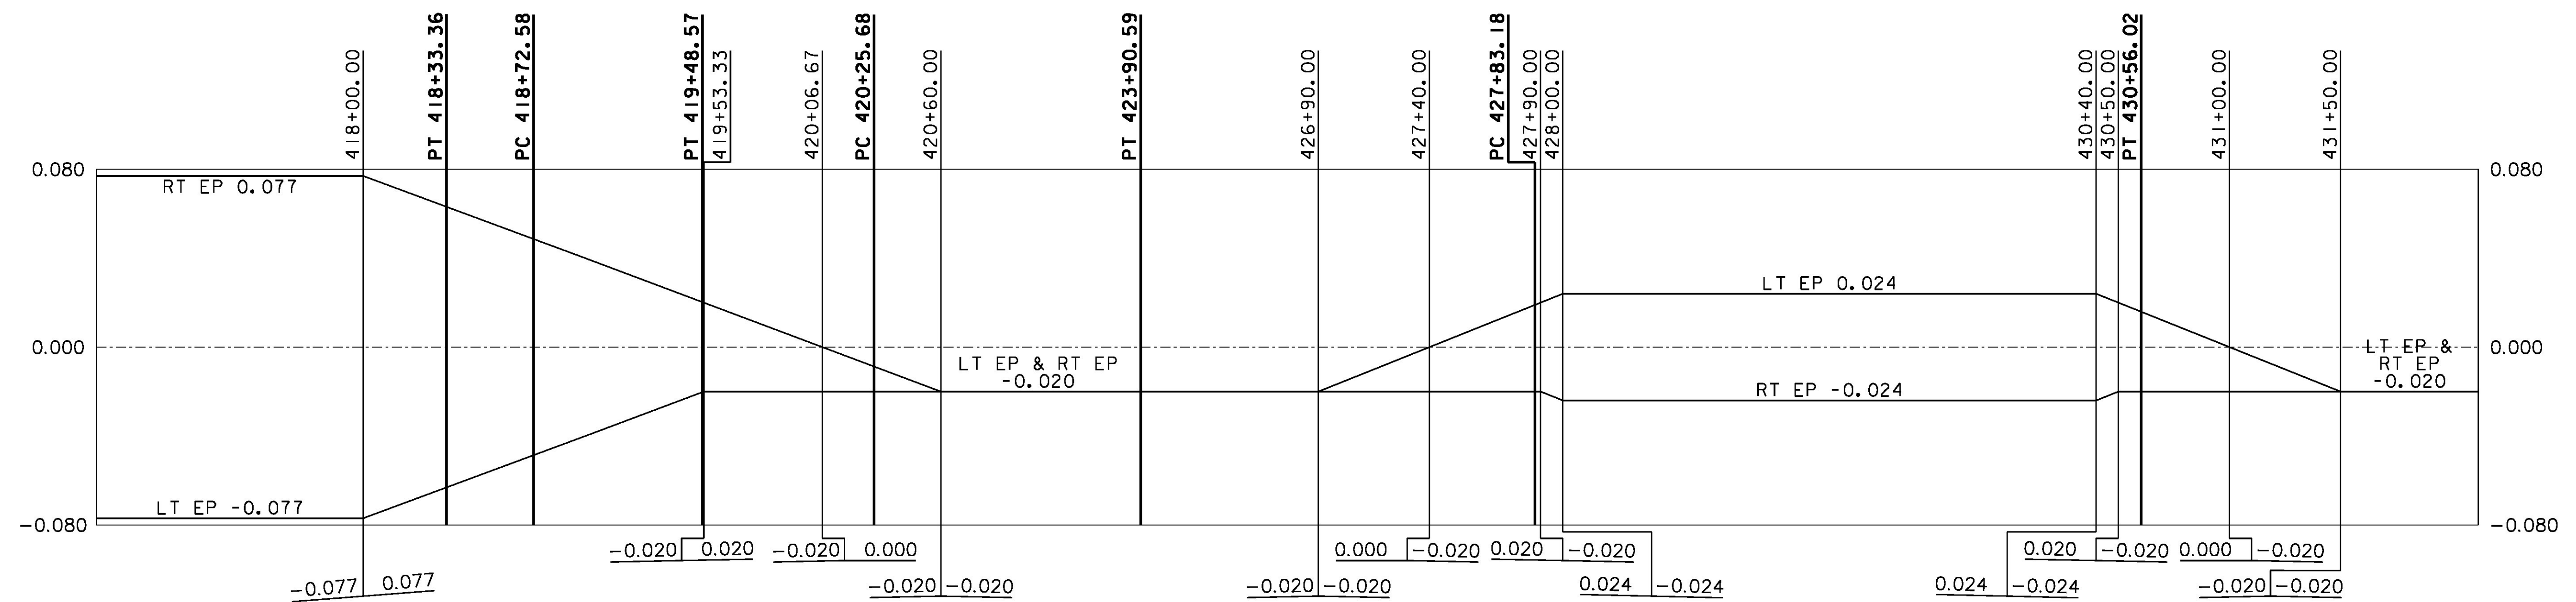

CURVE 52 - JAY

CURVE 53 - JAY

CURVE 54 - JAY

CURVE 55 - JAY

NOT TO SCALE

| | | | |
|-----------------|----------------|---------------|------------|
| PROJECT NAME: | JAY-TROY | PLOT DATE: | 5/16/2014 |
| PROJECT NUMBER: | STP 2915(I) | DRAWN BY: | S. GOODWIN |
| FILE NAME: | z10b232frm.dgn | CHECKED BY: | P. SHEDD |
| PROJECT LEADER: | P. SHEDD | BANKING SHEET | 8 |
| DESIGNED BY: | N. LEMAY | SHEET | 121 OF 244 |