




42+00

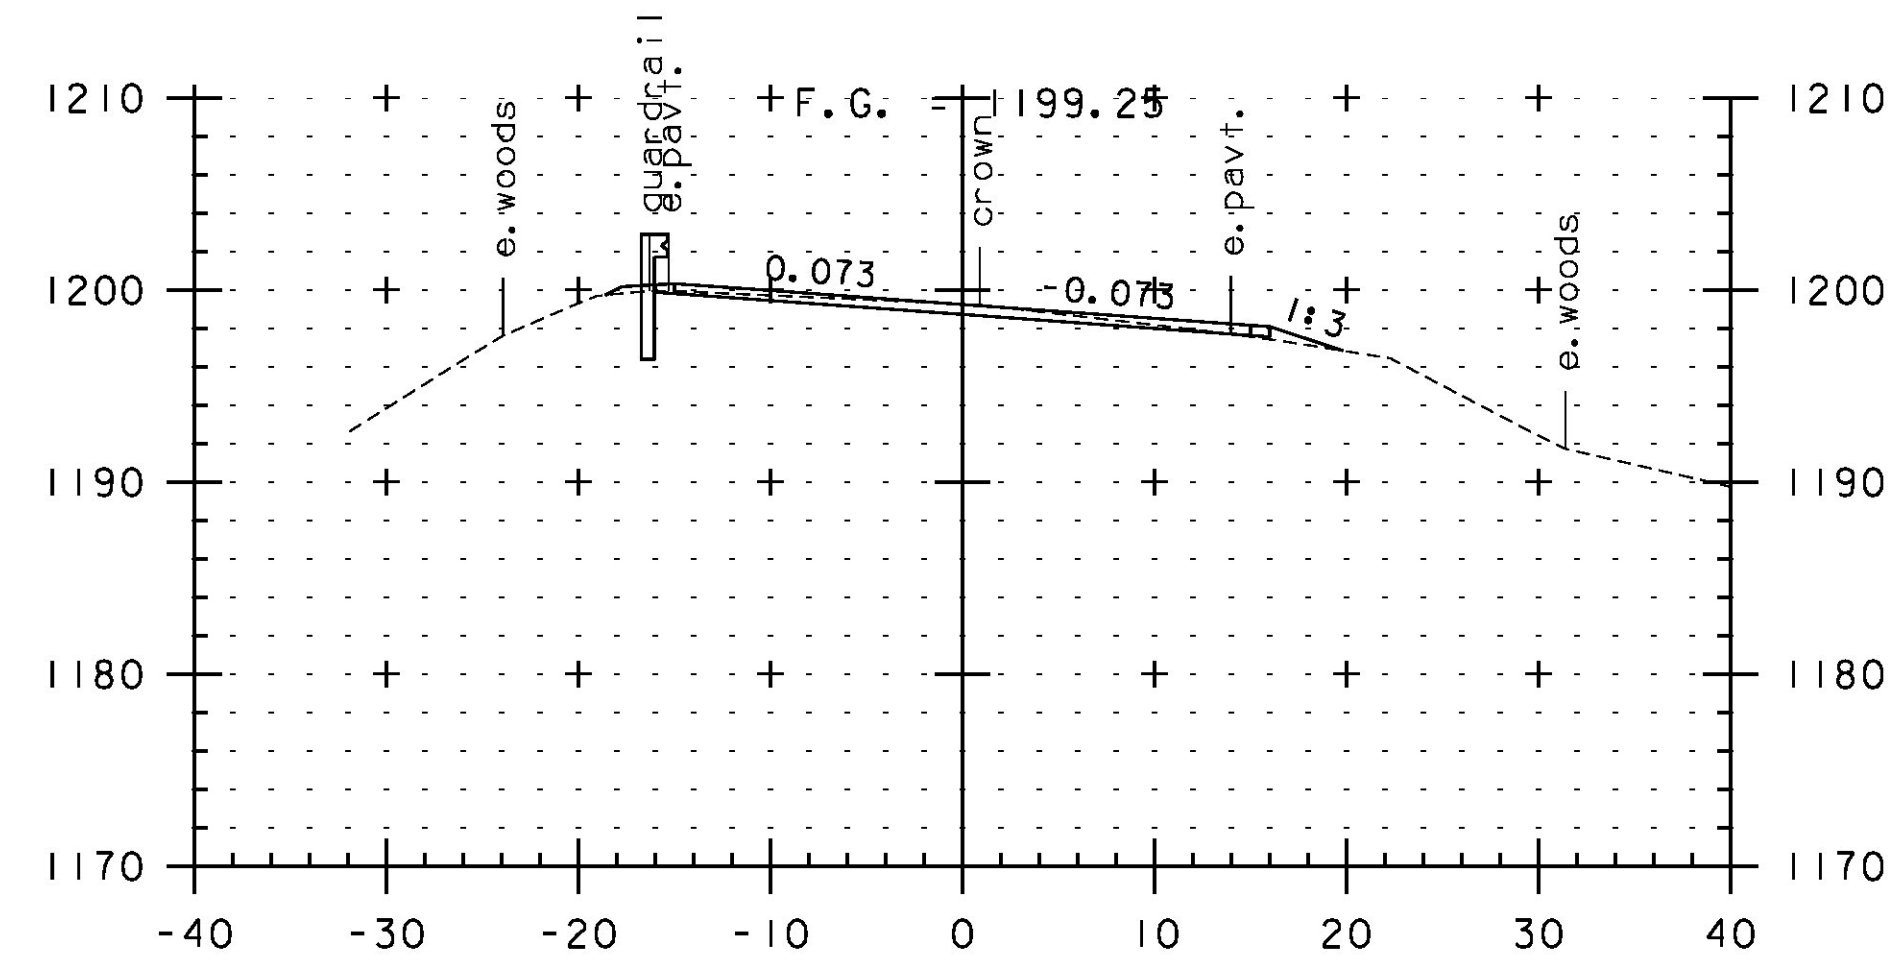


43+50

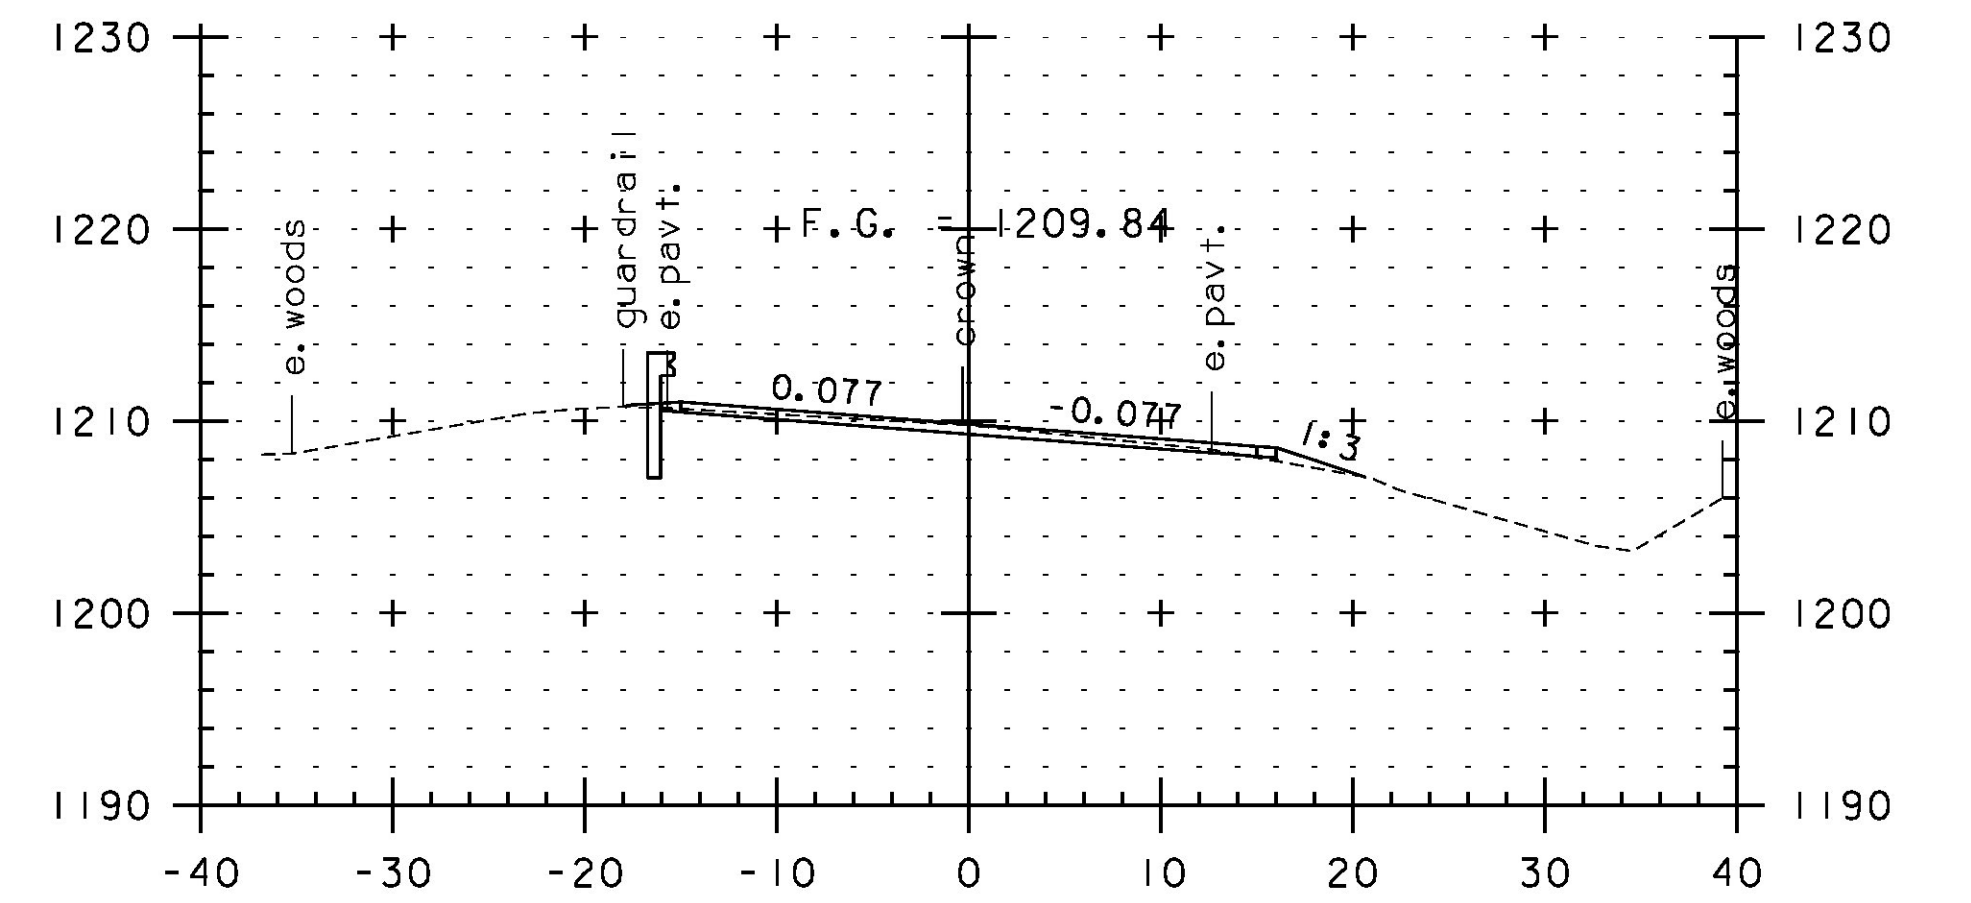


45+00

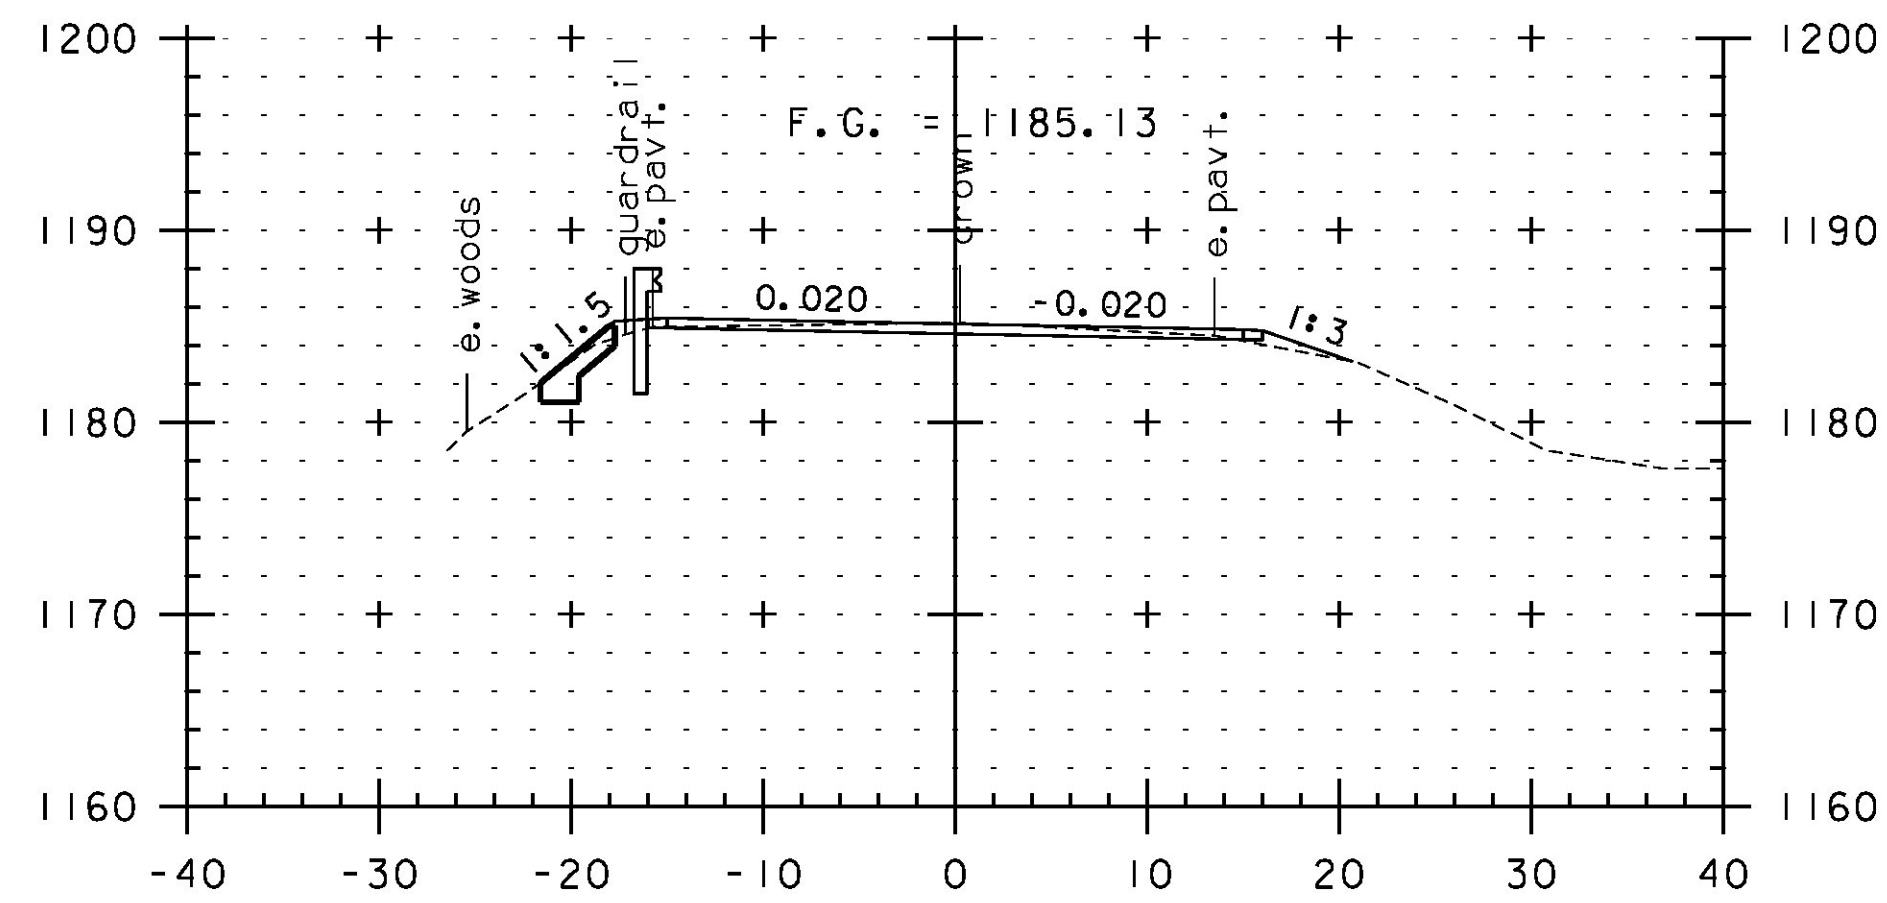


41+50

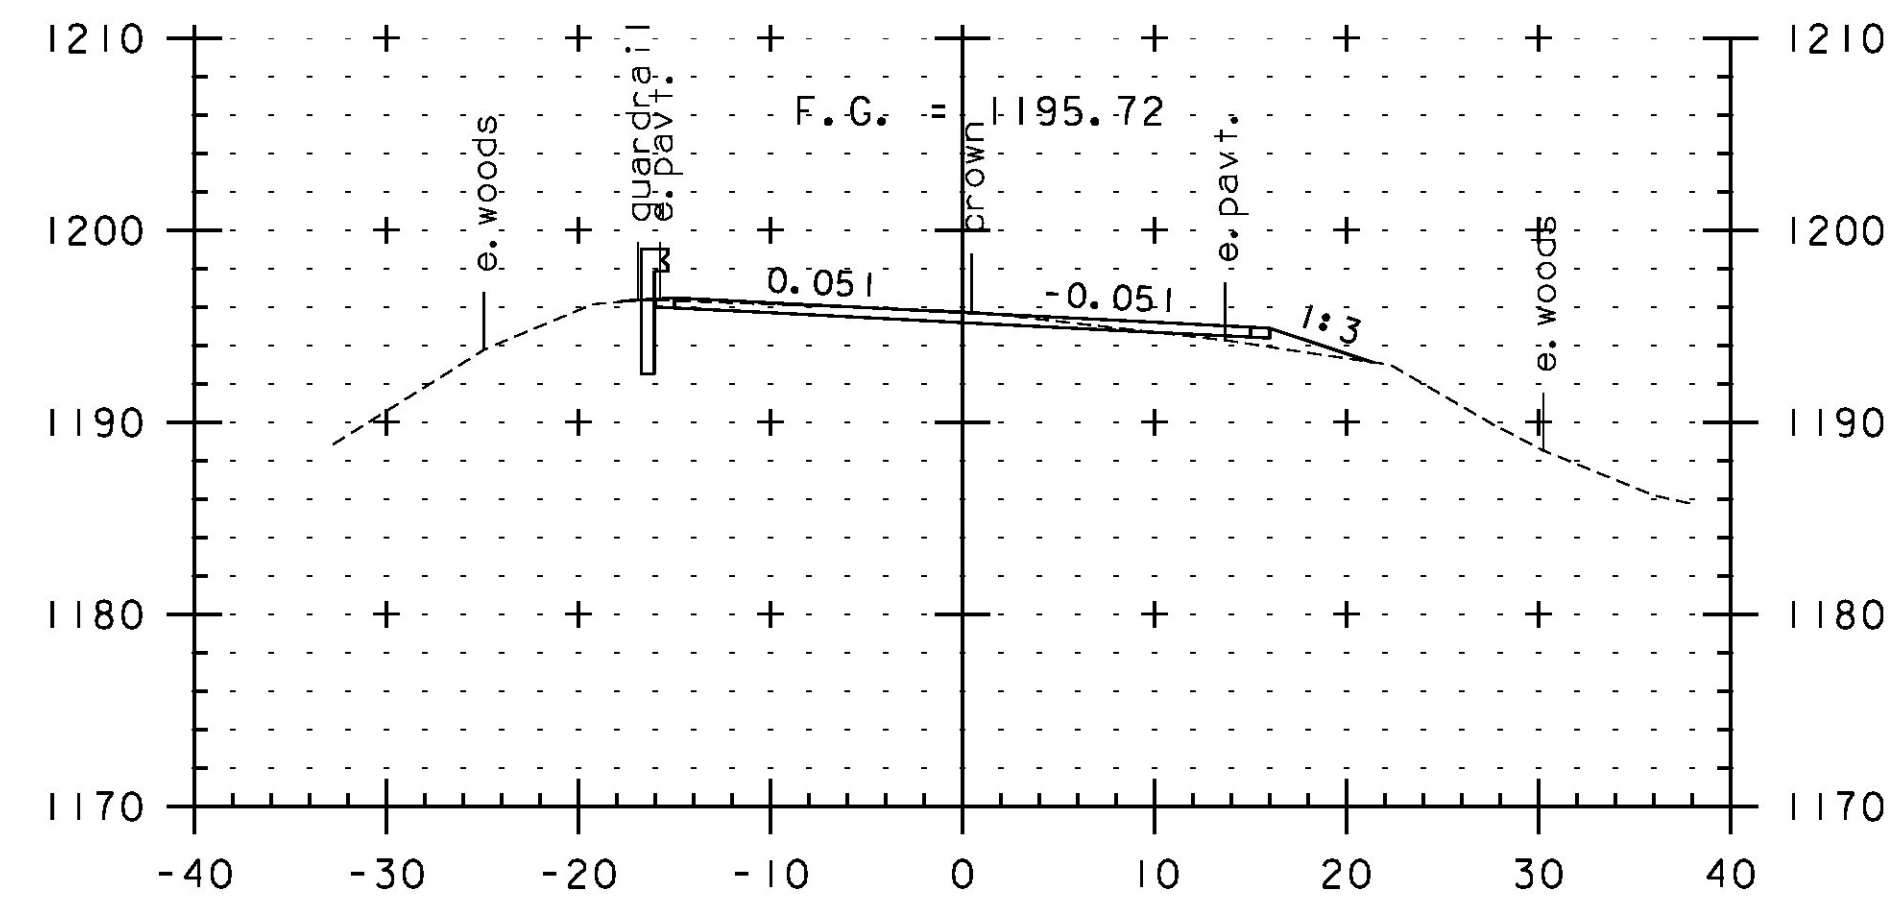


43+00

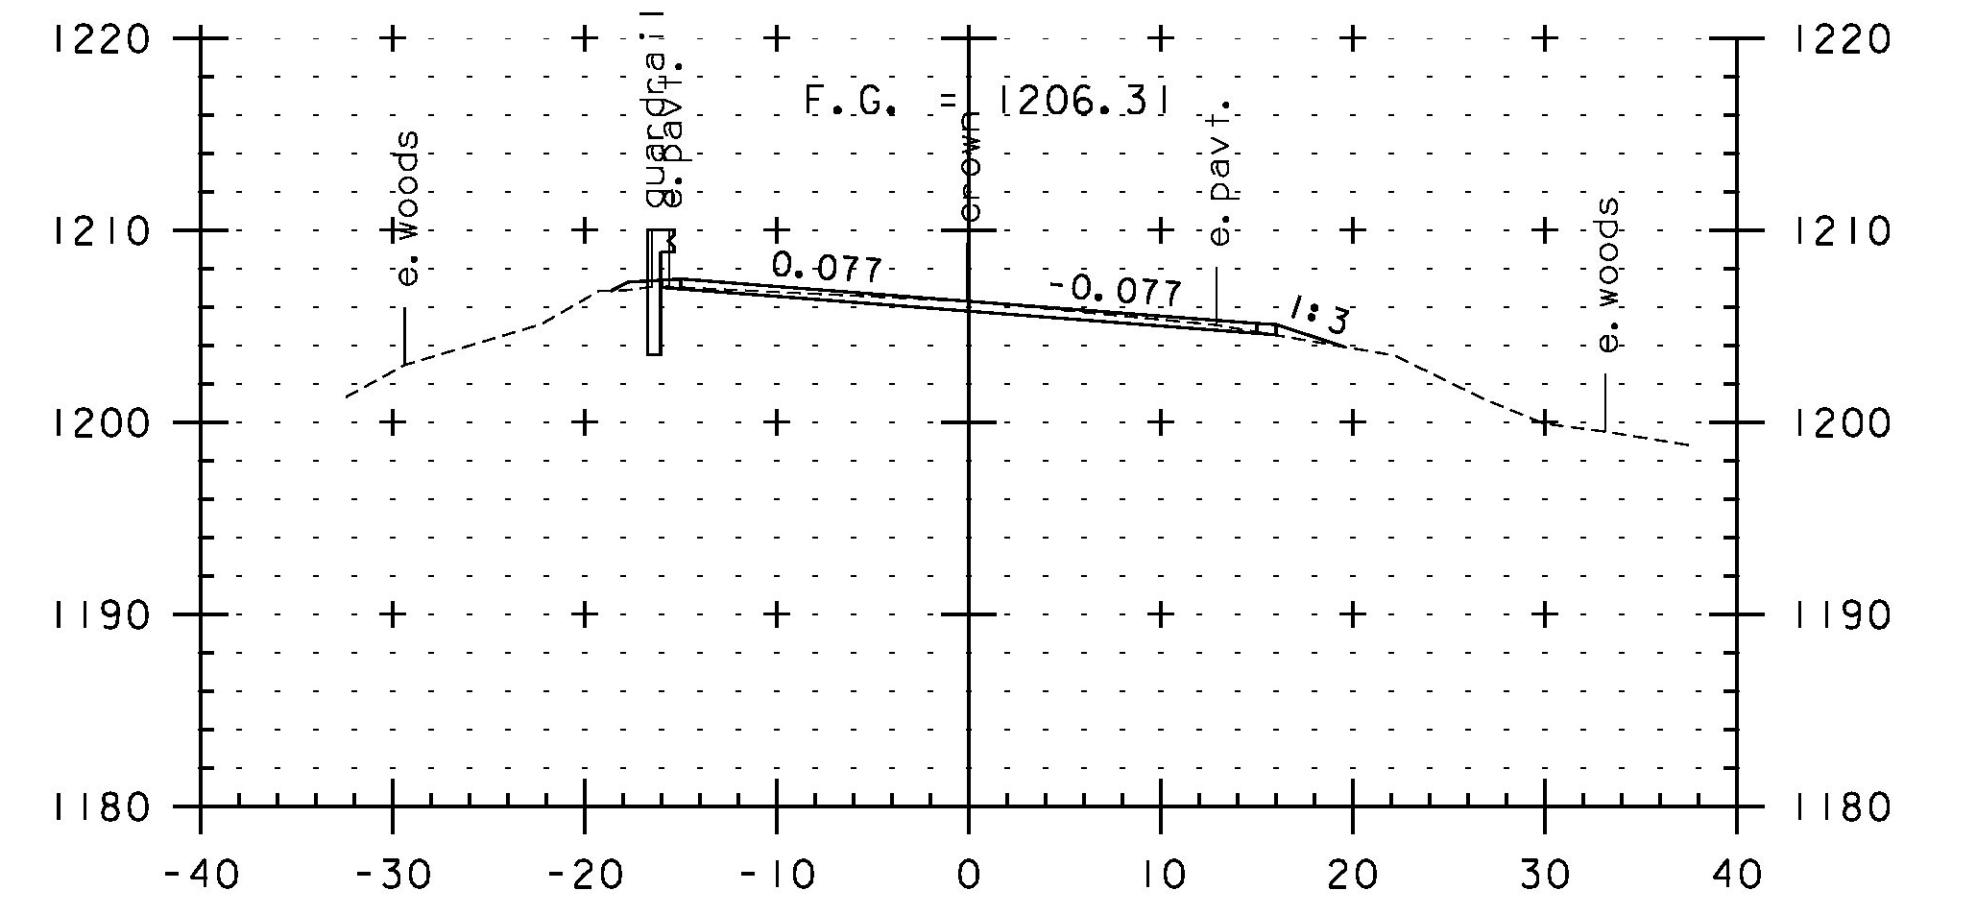


44+50

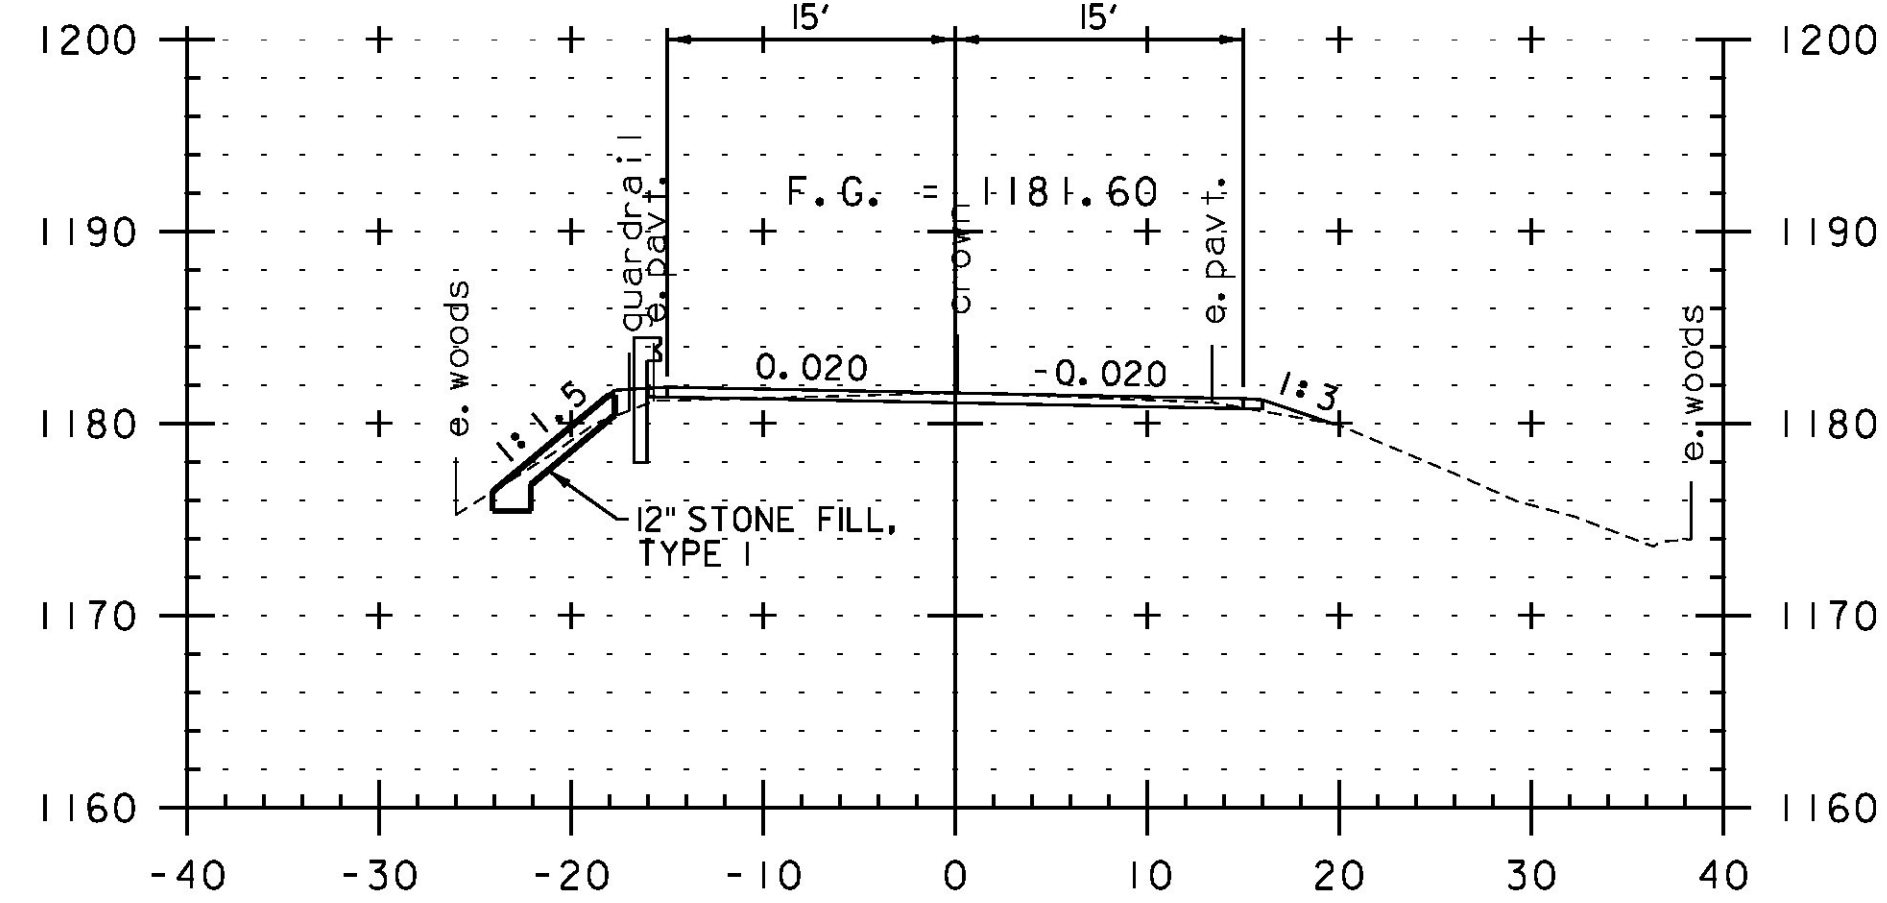

41+00

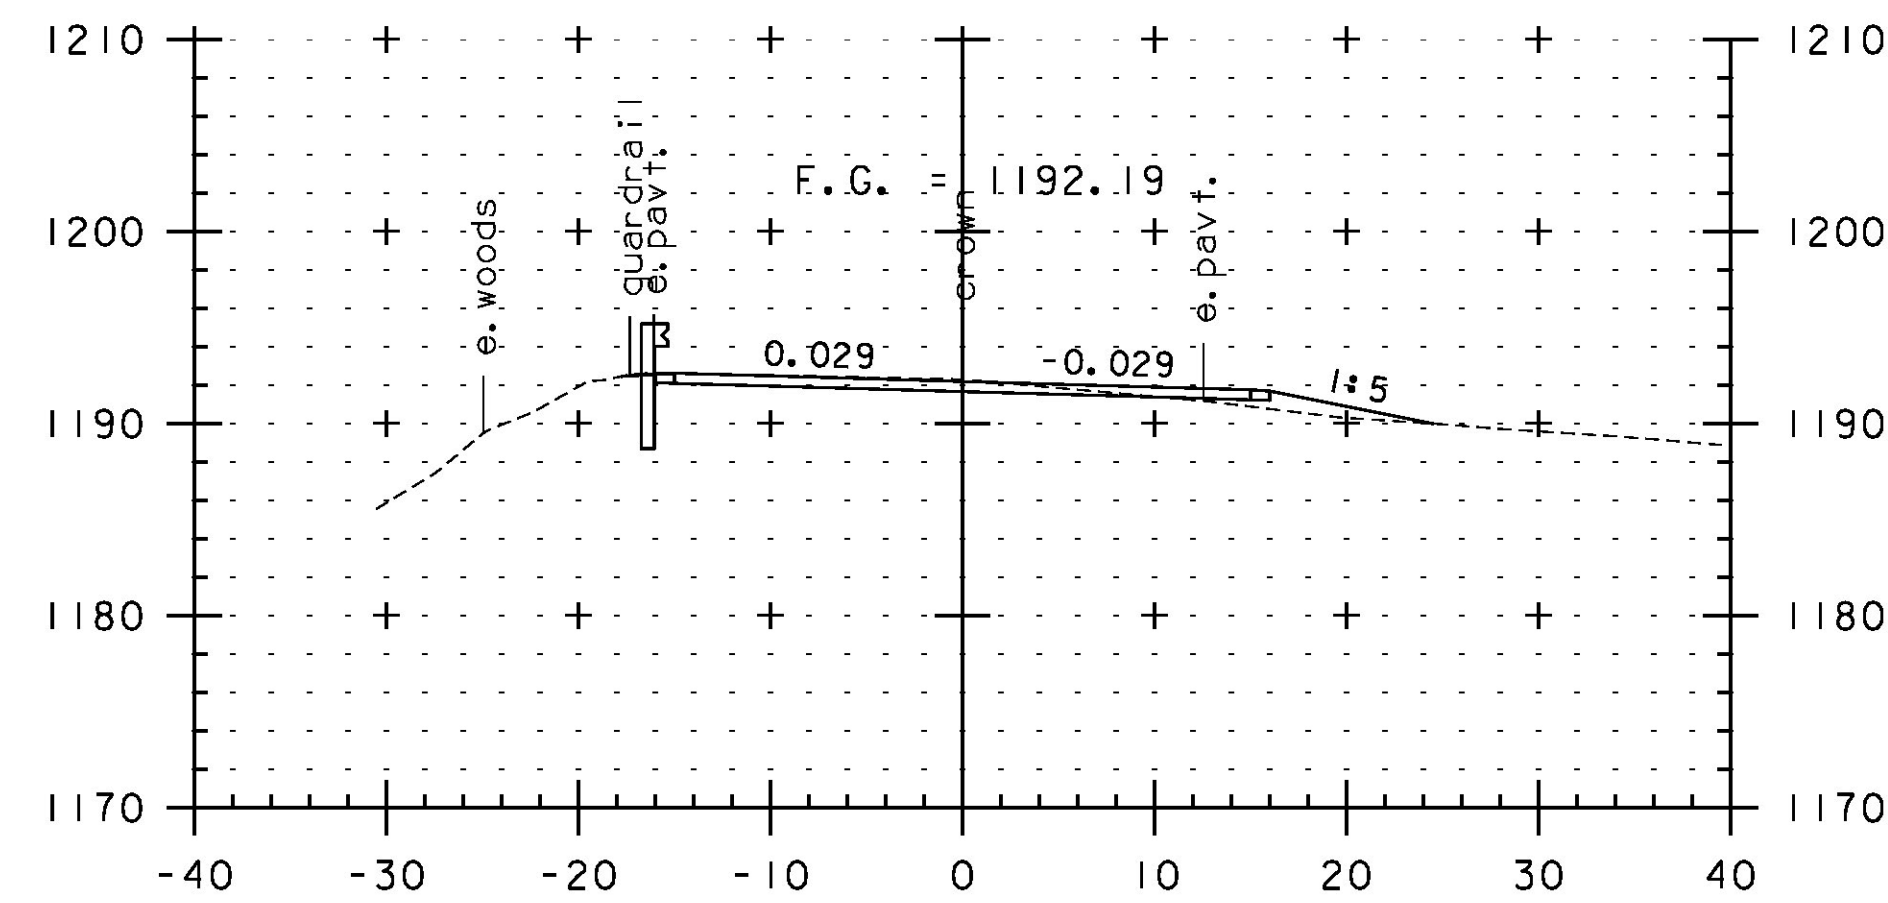

42+50

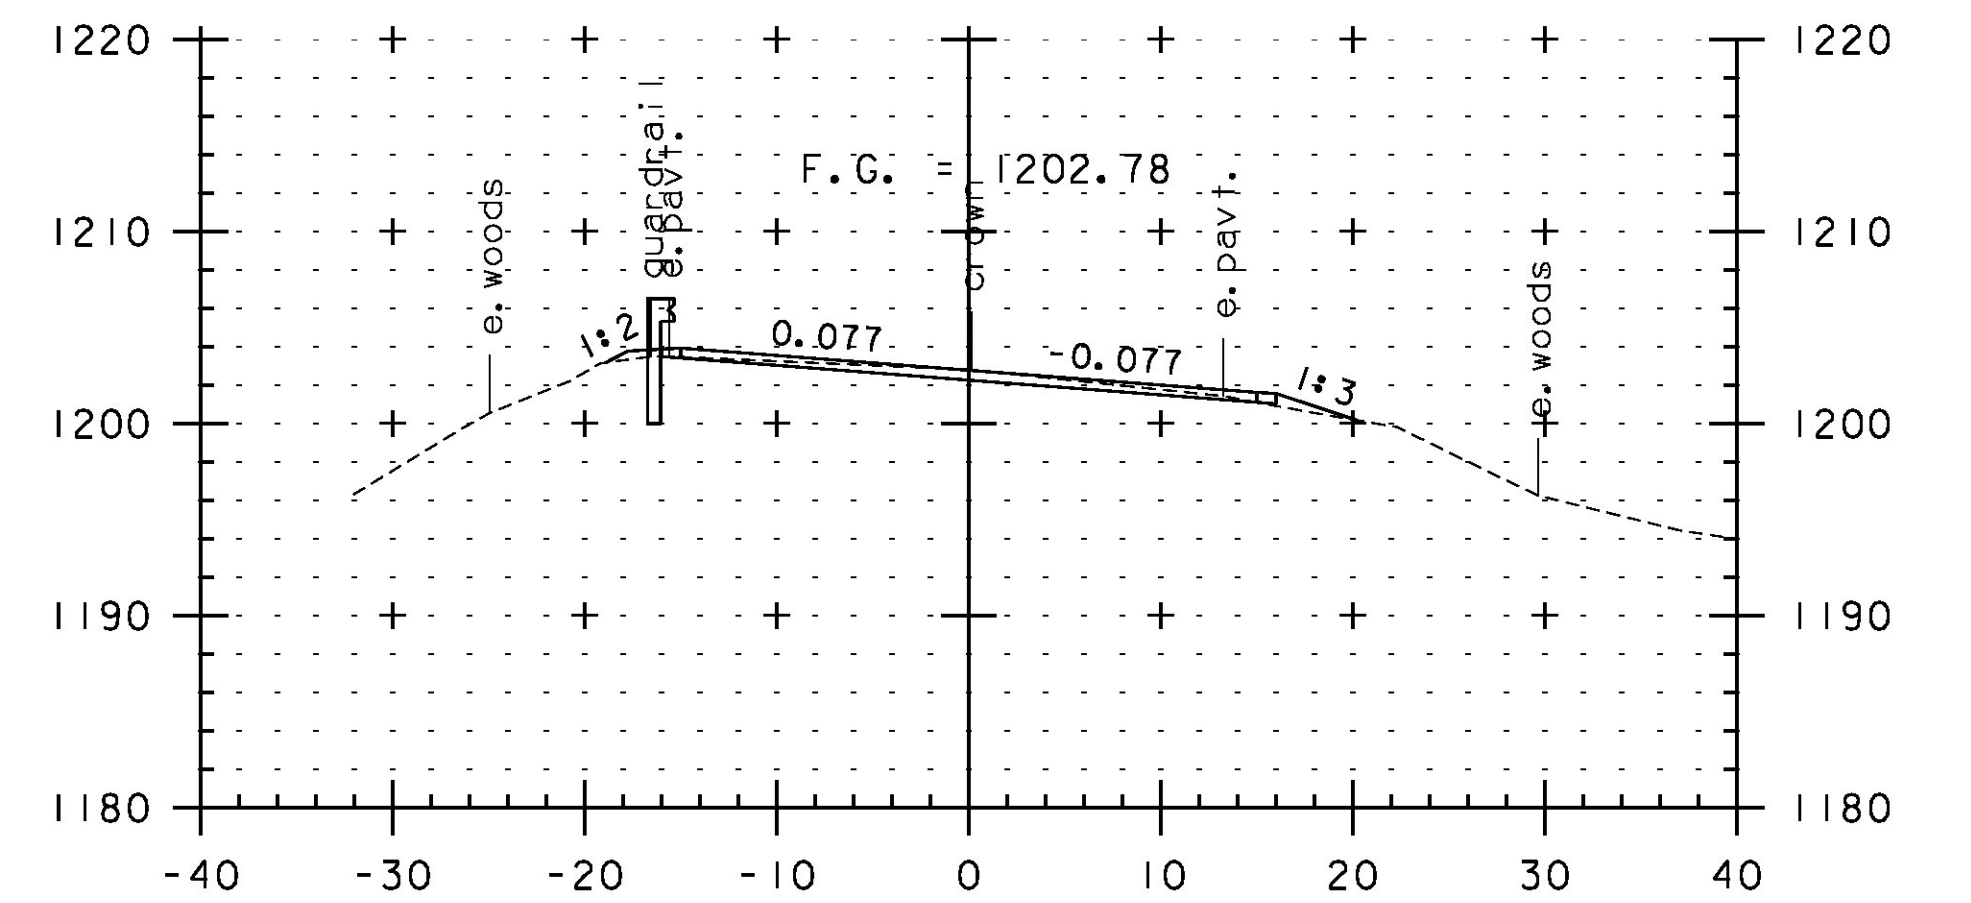

44+00



STA. 41+00 TO STA. 45+00

PROJECT NAME:	JAY-TROY	PLOT DATE:	5/16/2014
PROJECT NUMBER:	STP 2315(1)	DRAWN BY:	W. GORDON
FILE NAME:	z10b232xs.dgn	CHECKED BY:	P. SHEDD
PROJECT LEADER:	P. SHEDD	CROSS SECTION SHEET 2	SHEET 138 OF 244