




46+50

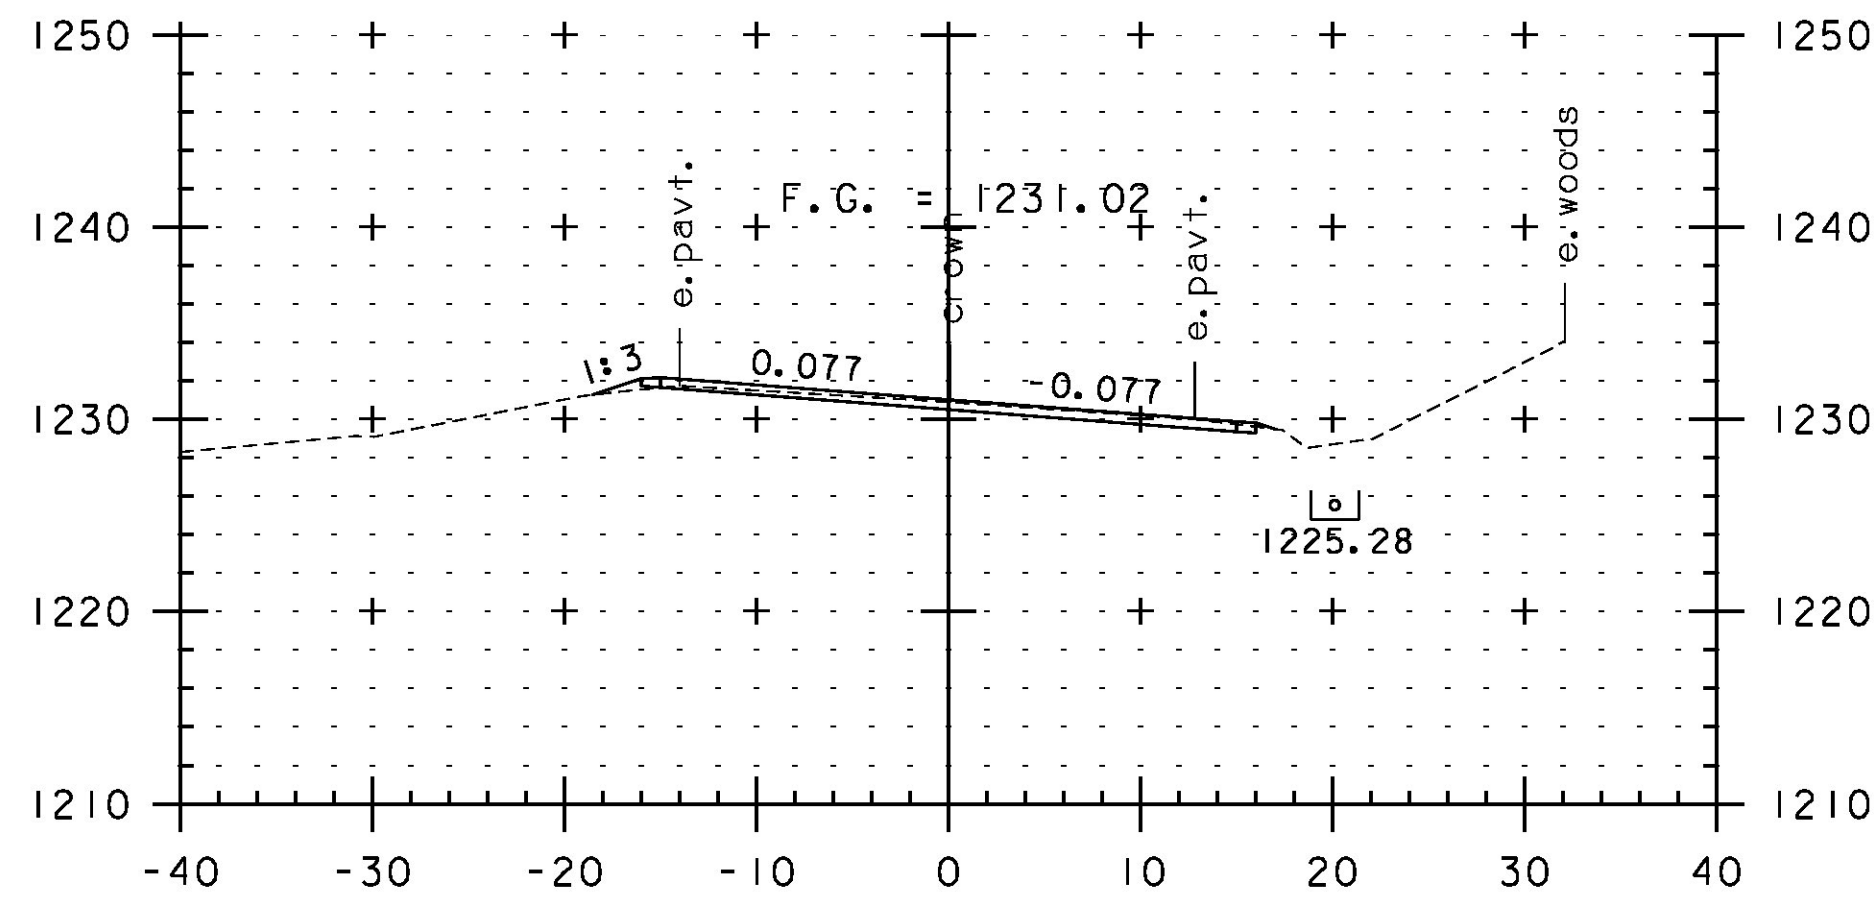


48+00

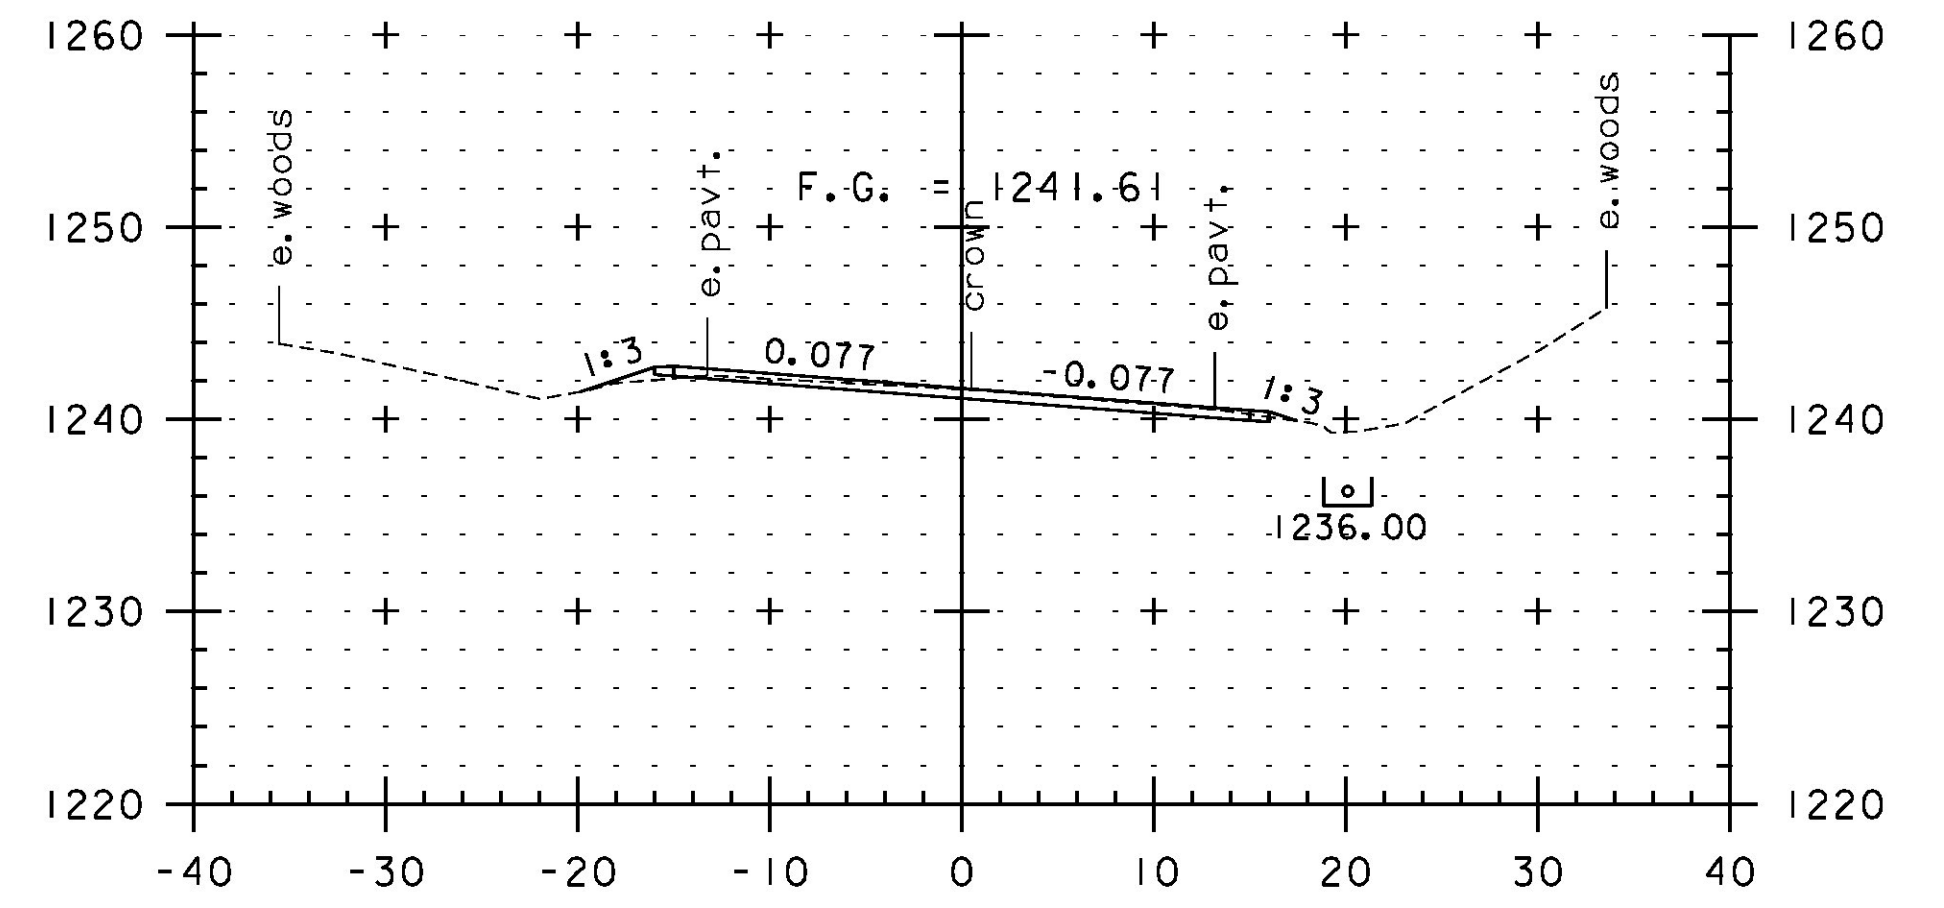


49+50

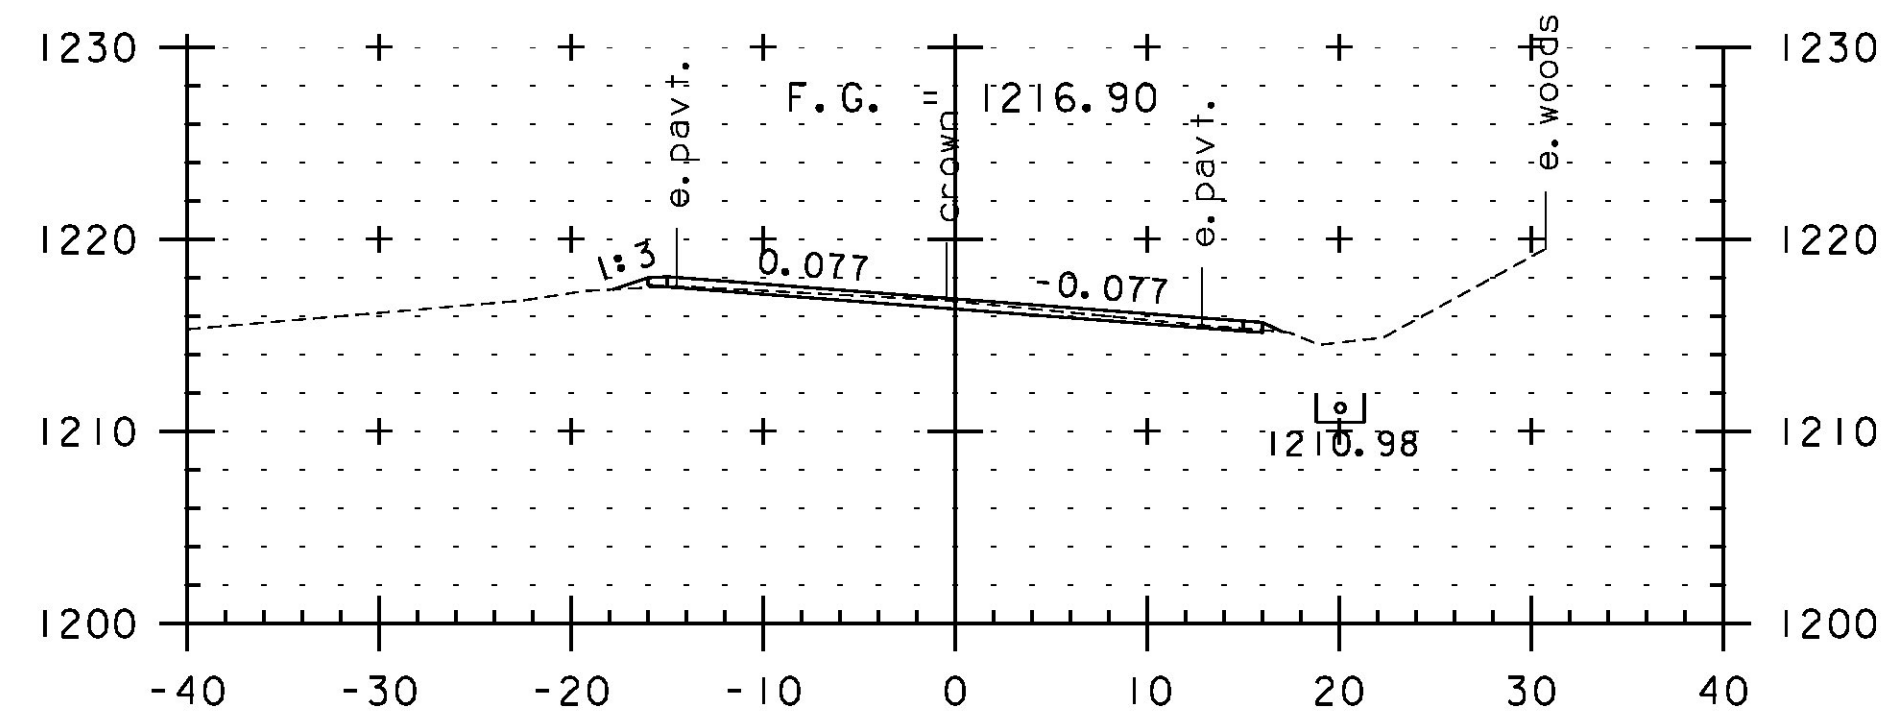


46+00

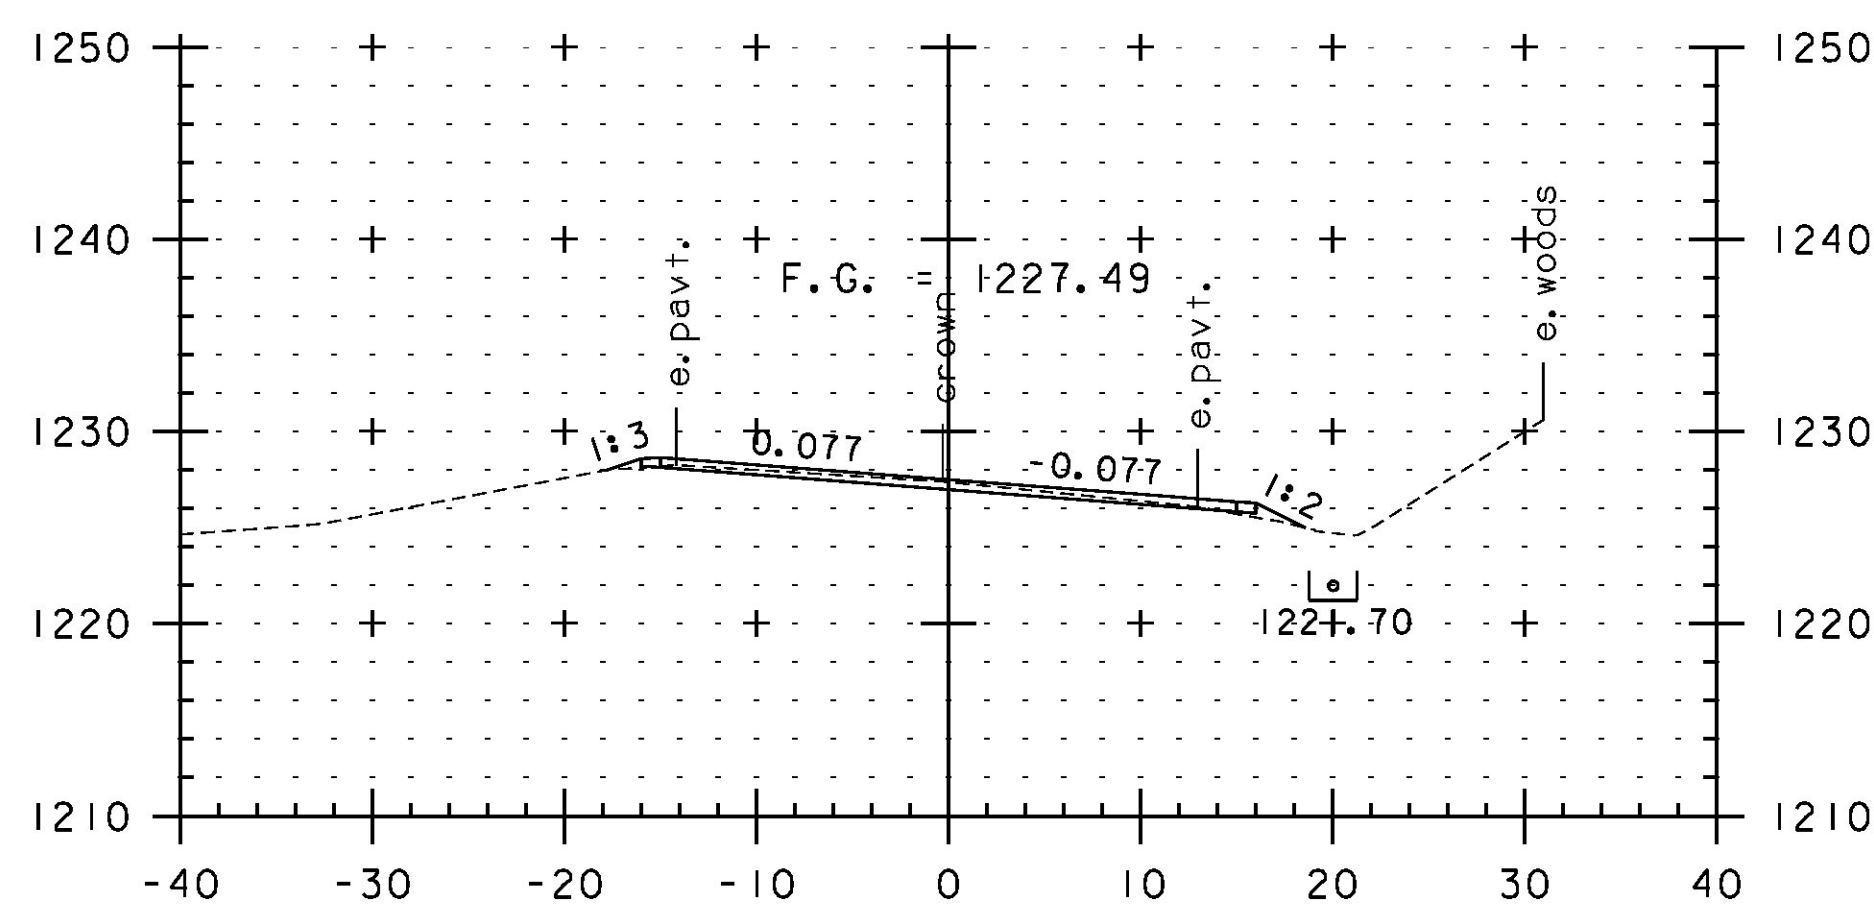


47+50

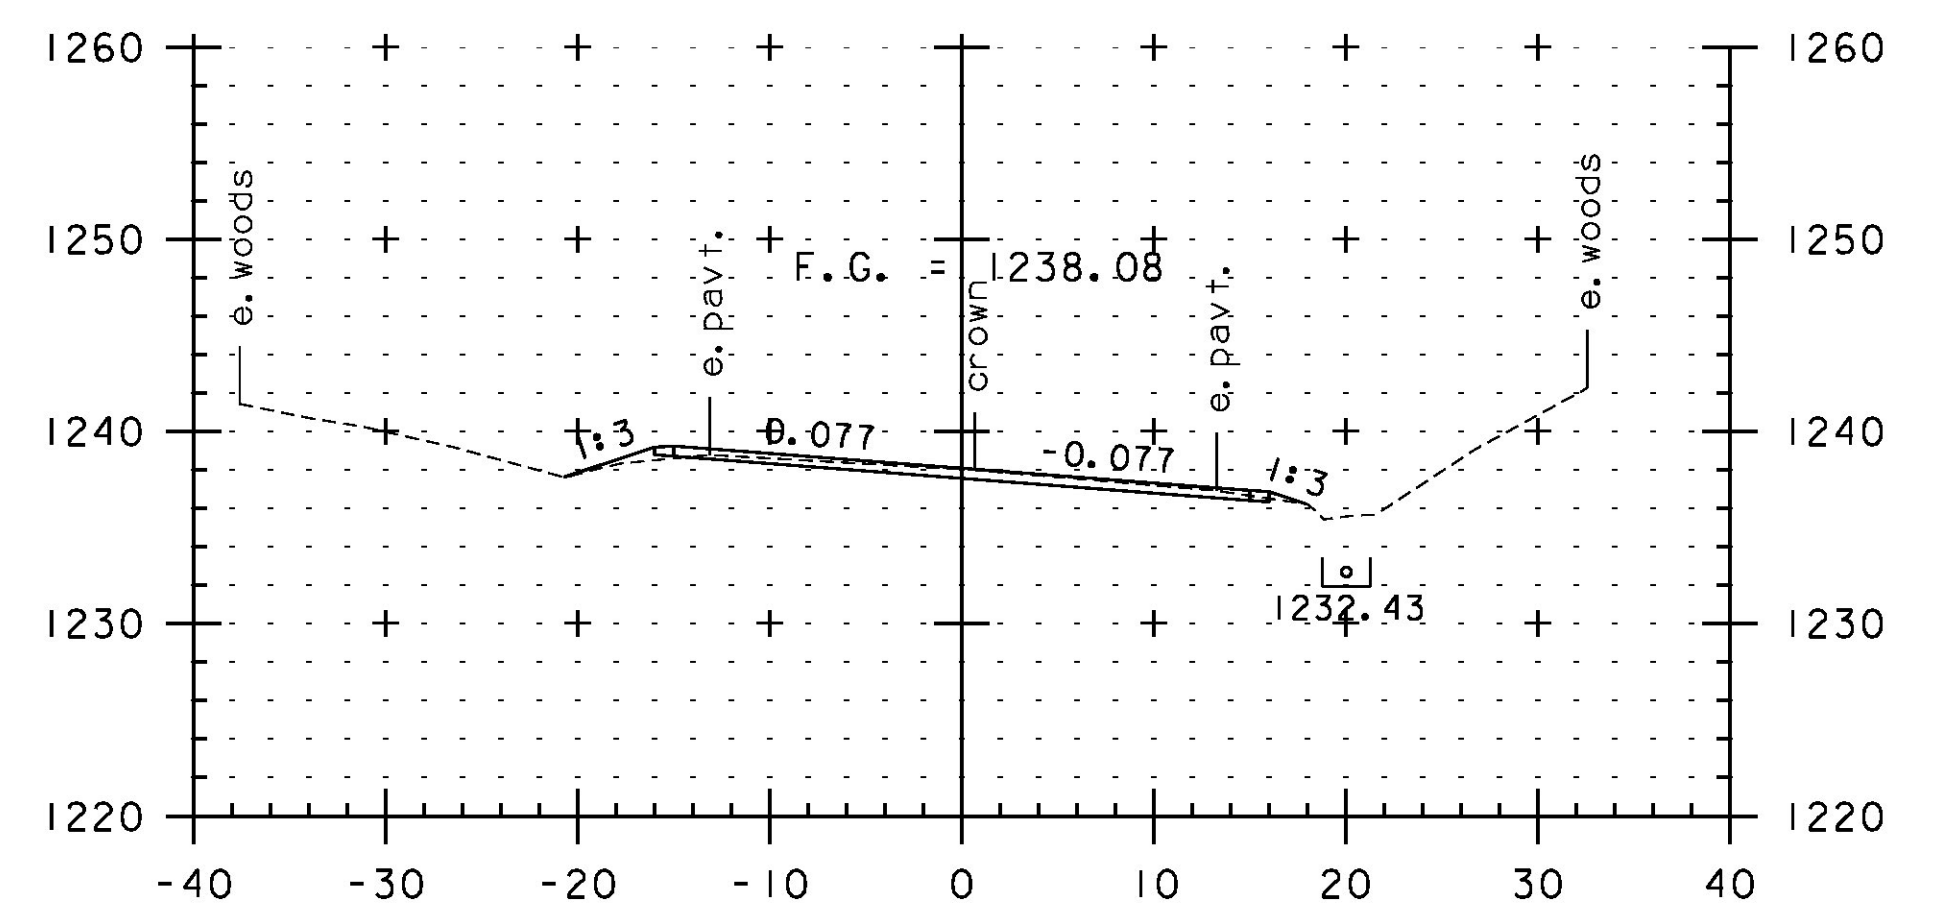


49+00

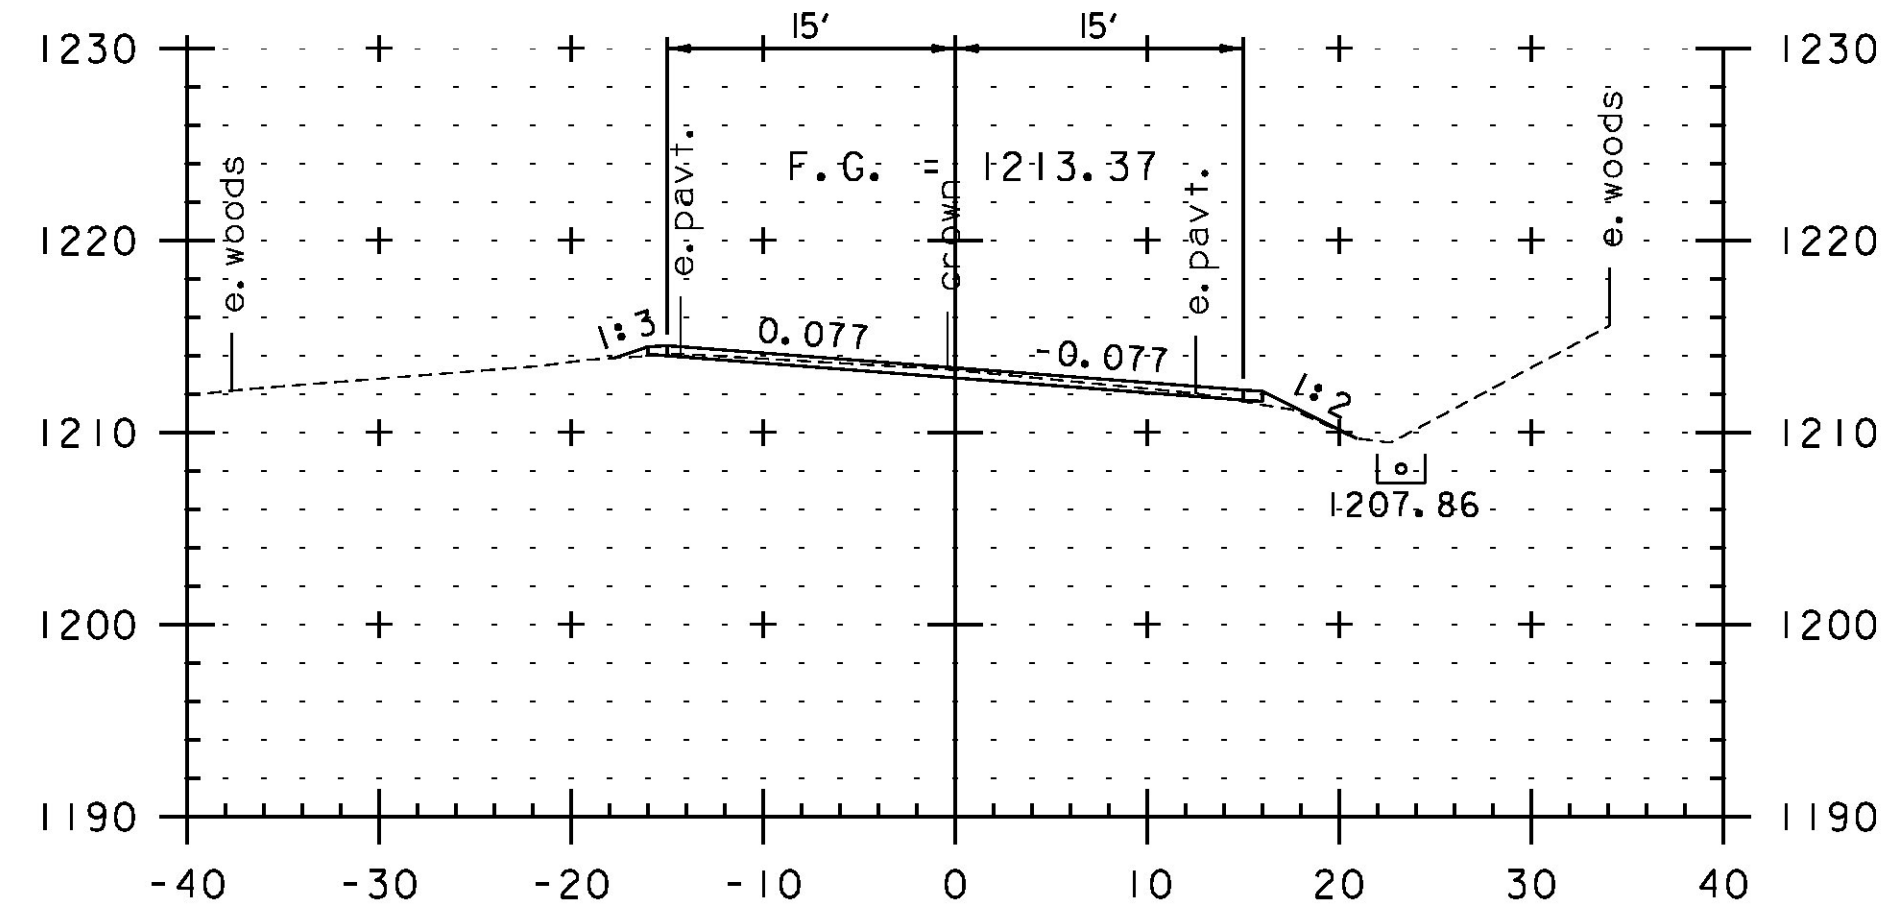

45+50

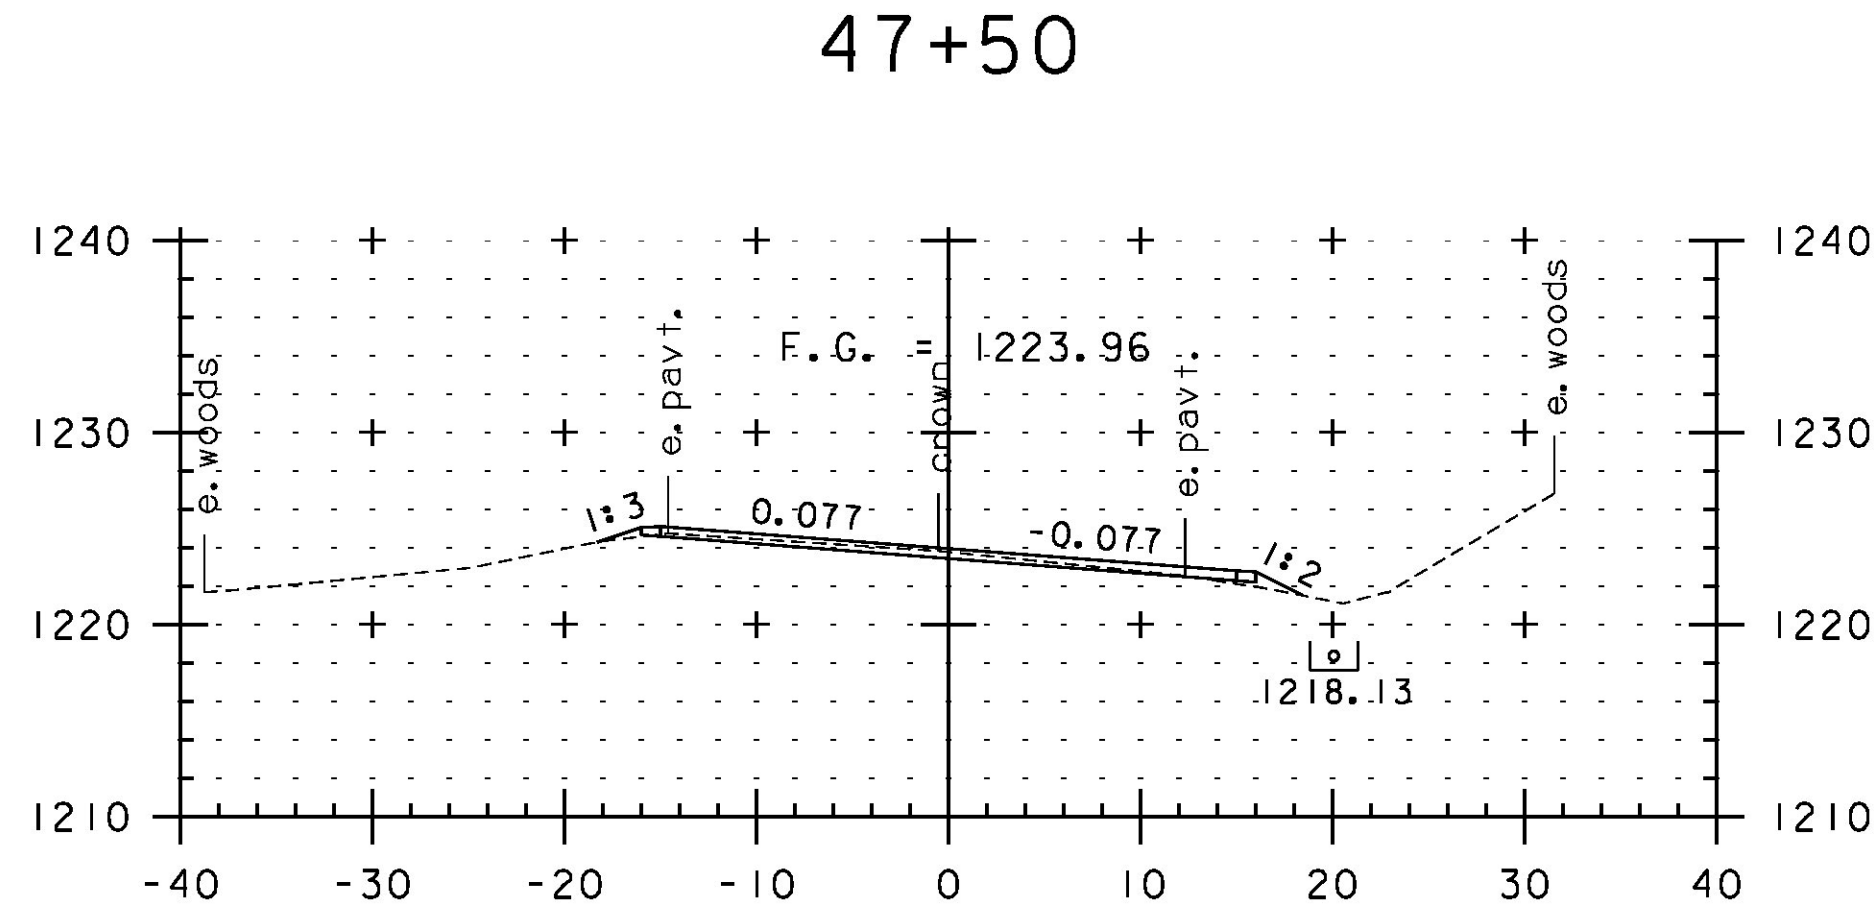

47+00

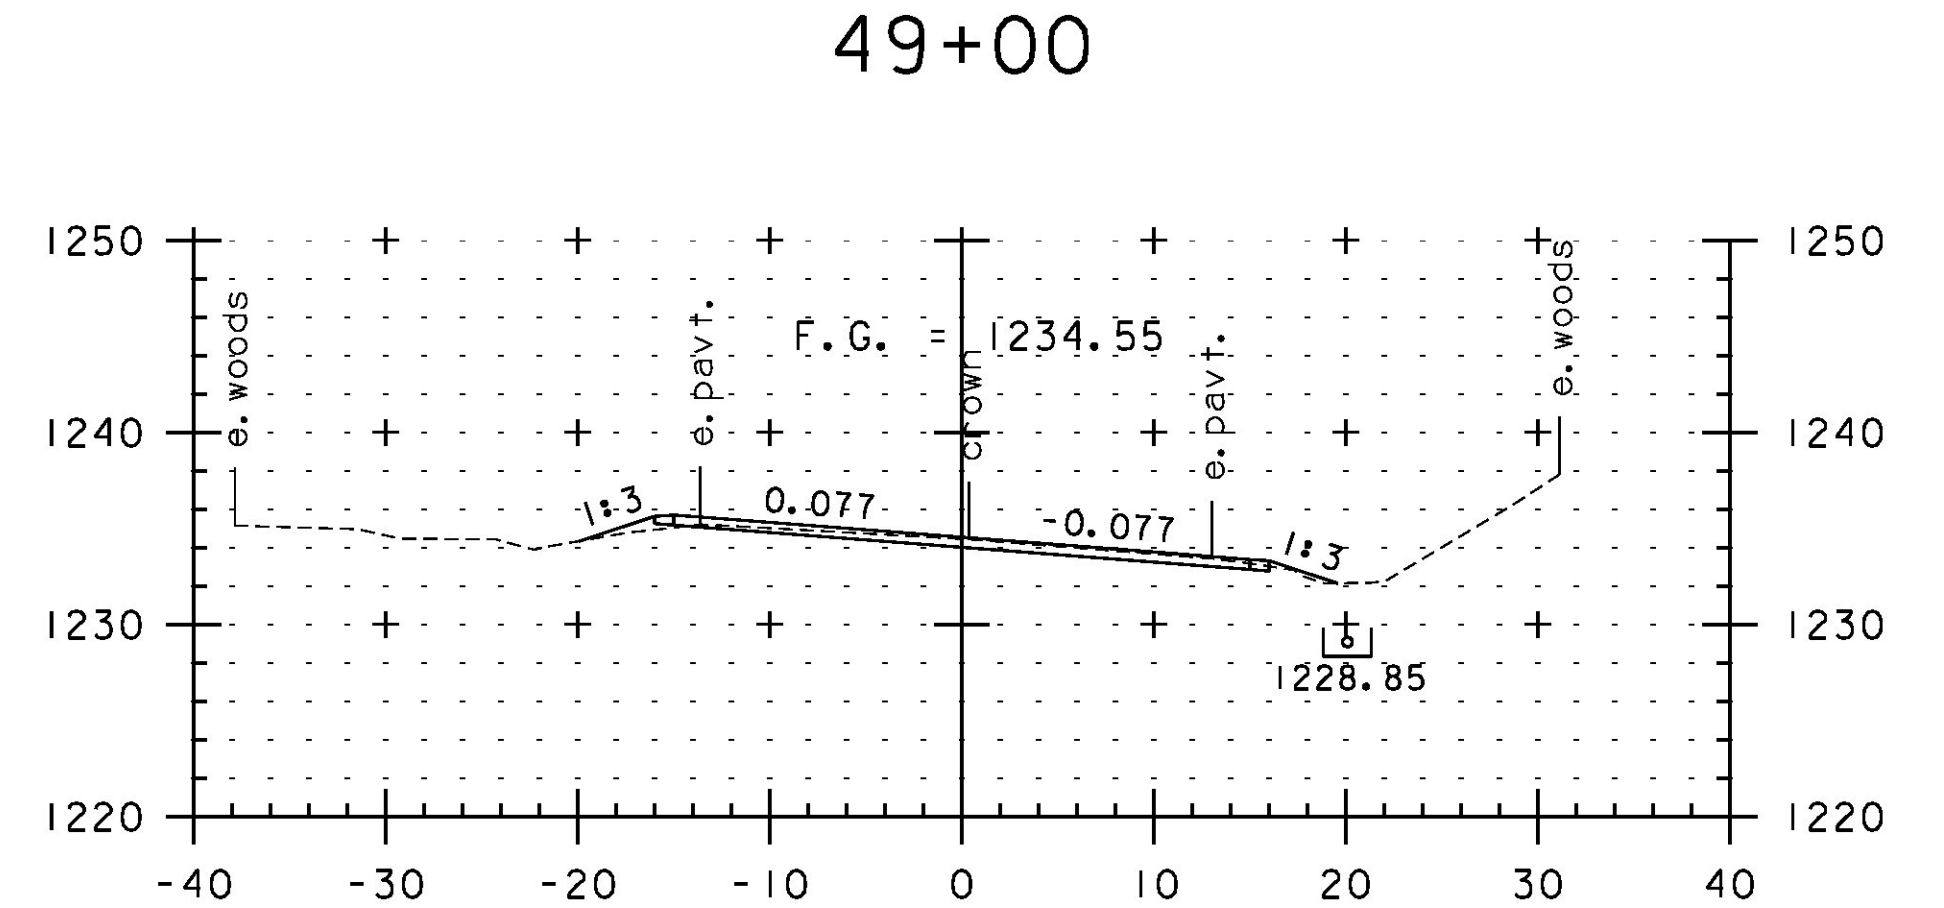

48+50



STA. 45+50 TO STA. 49+50

PROJECT NAME:	JAY-TROY	PLOT DATE:	5/16/2014
PROJECT NUMBER:	STP 2315(I)	DRAWN BY:	W. GORDON
FILE NAME:	z10b232xs.dgn	CHECKED BY:	P. SHEDD
PROJECT LEADER:	P. SHEDD	CROSS SECTION SHEET 3	SHEET 139 OF 244
DESIGNED BY:	N. LEMAY		