




51+00

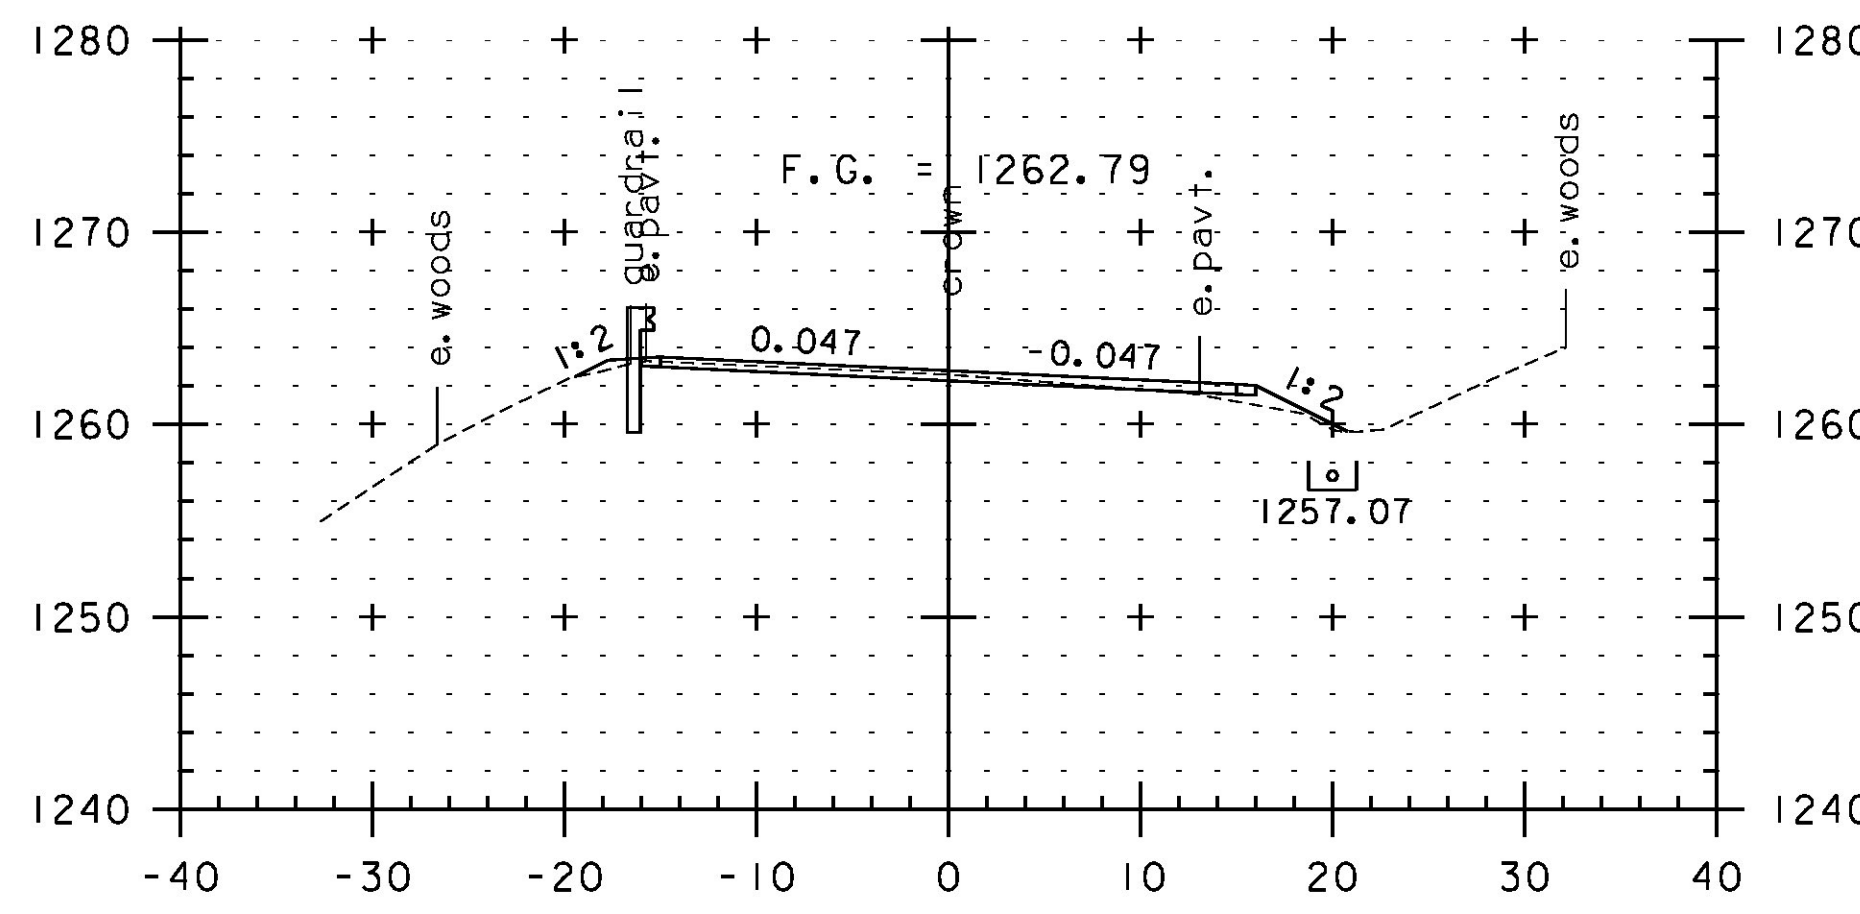


52+50

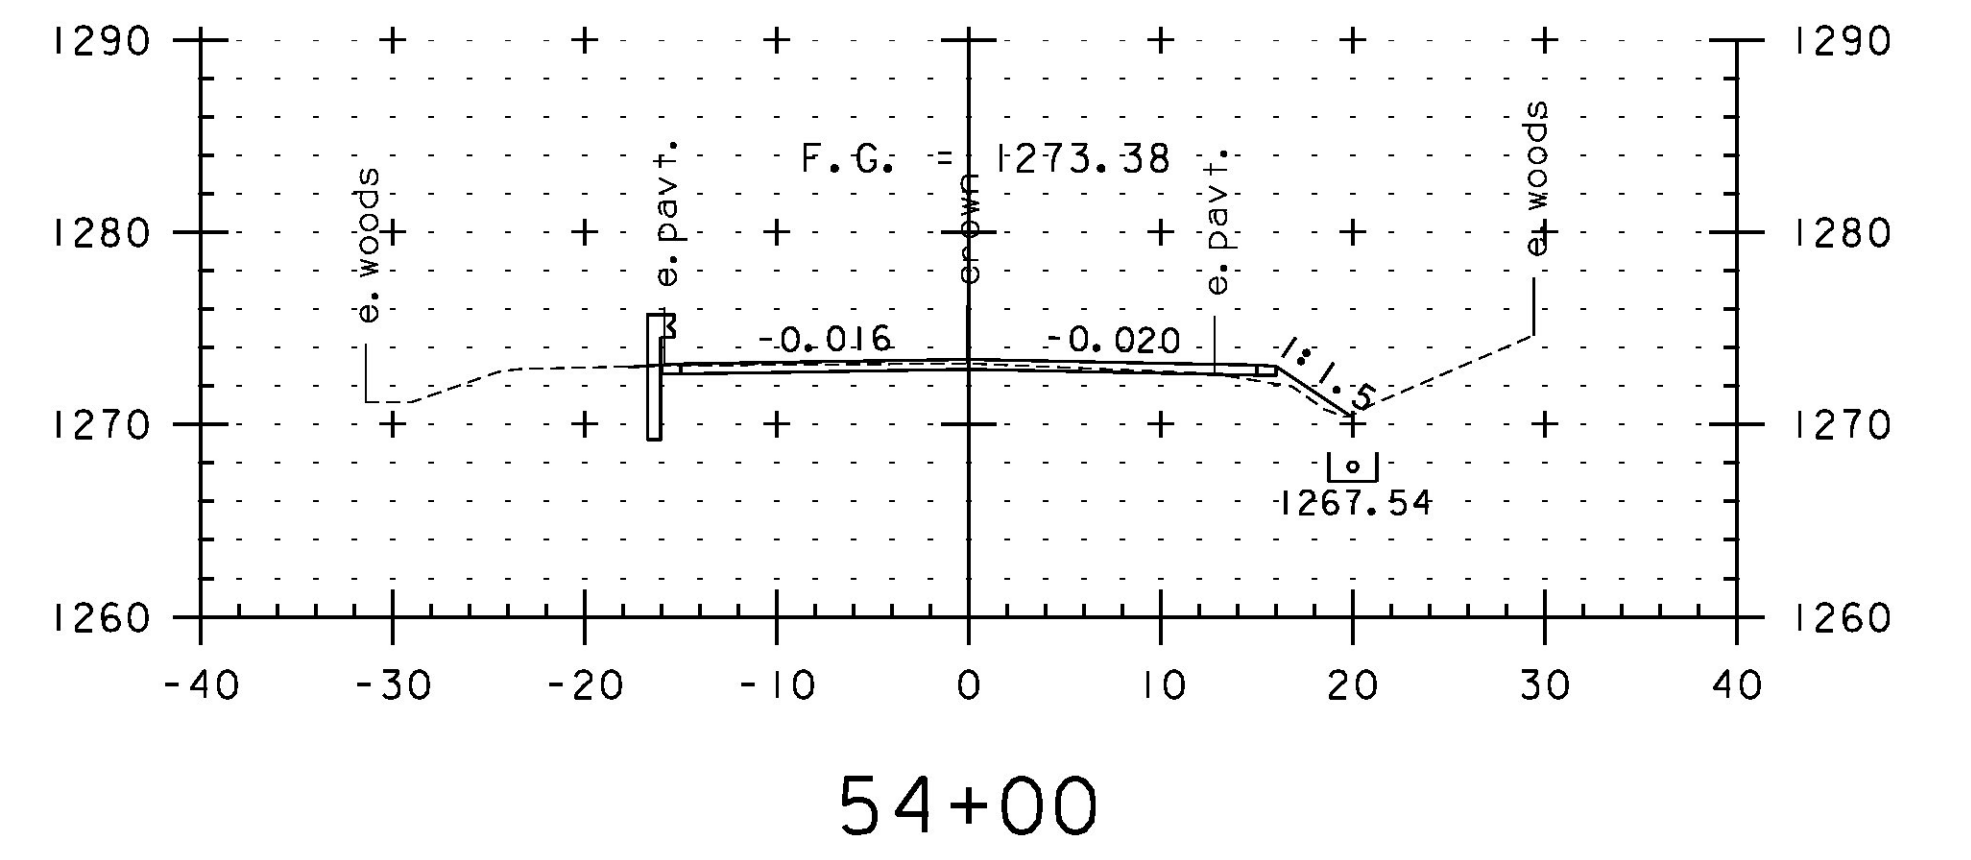


54+00

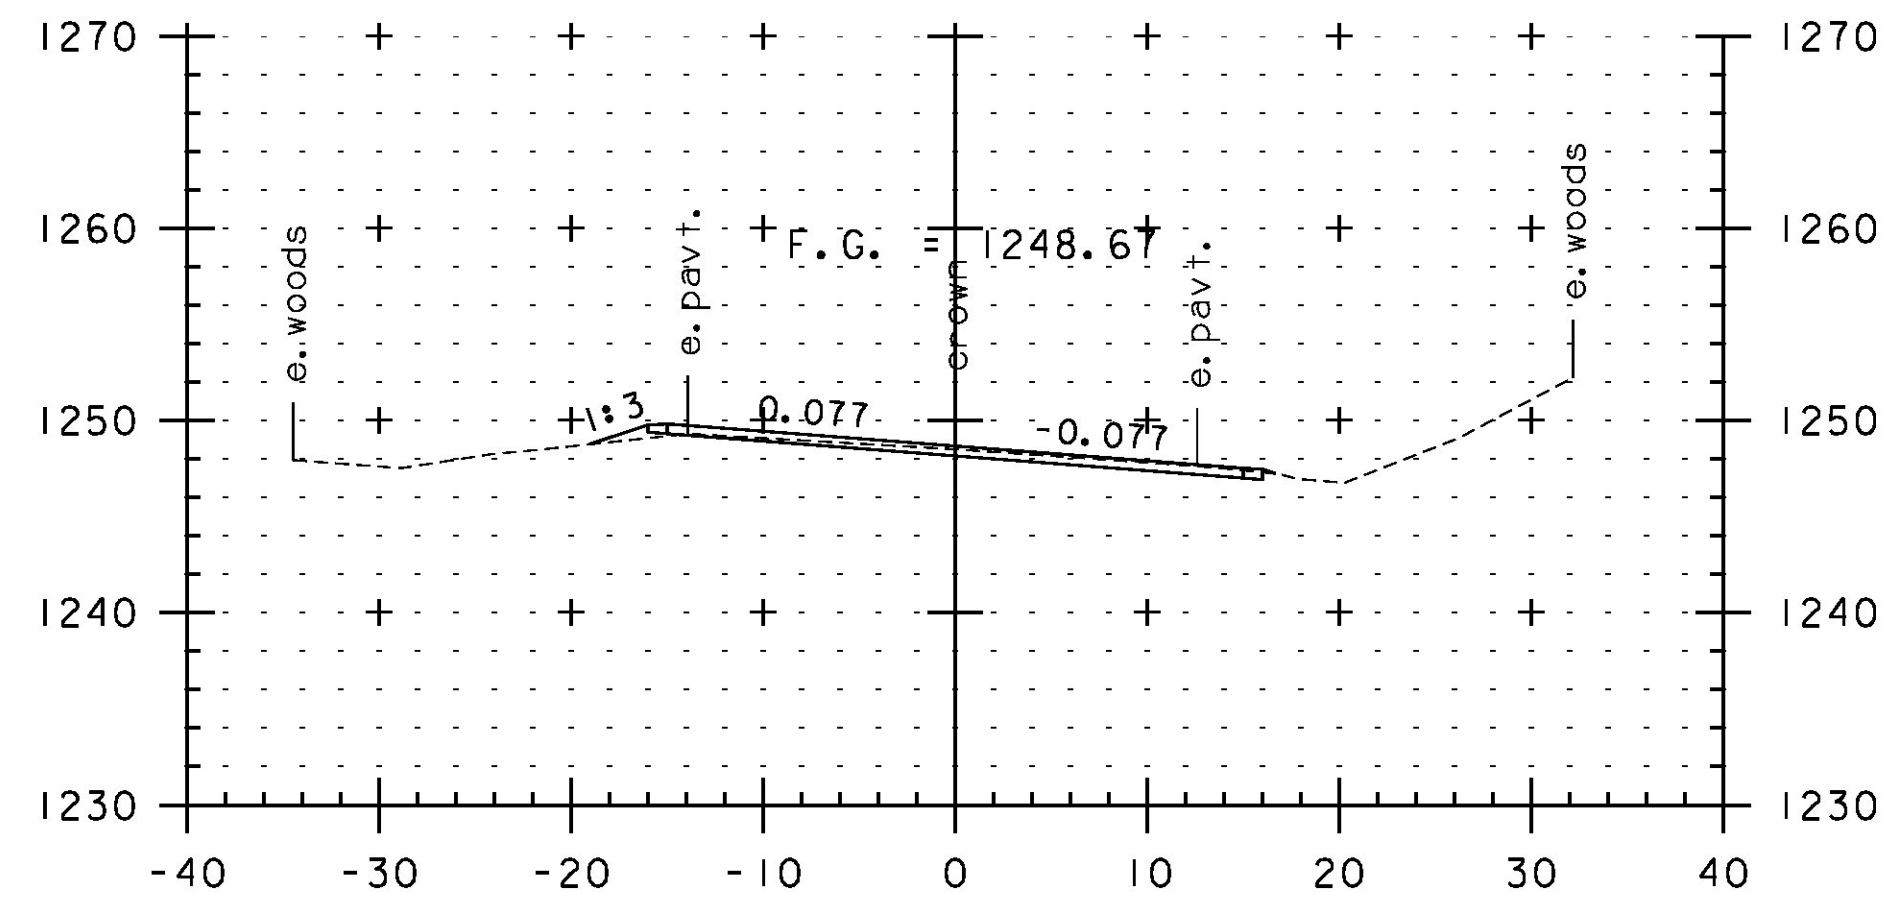


50+50

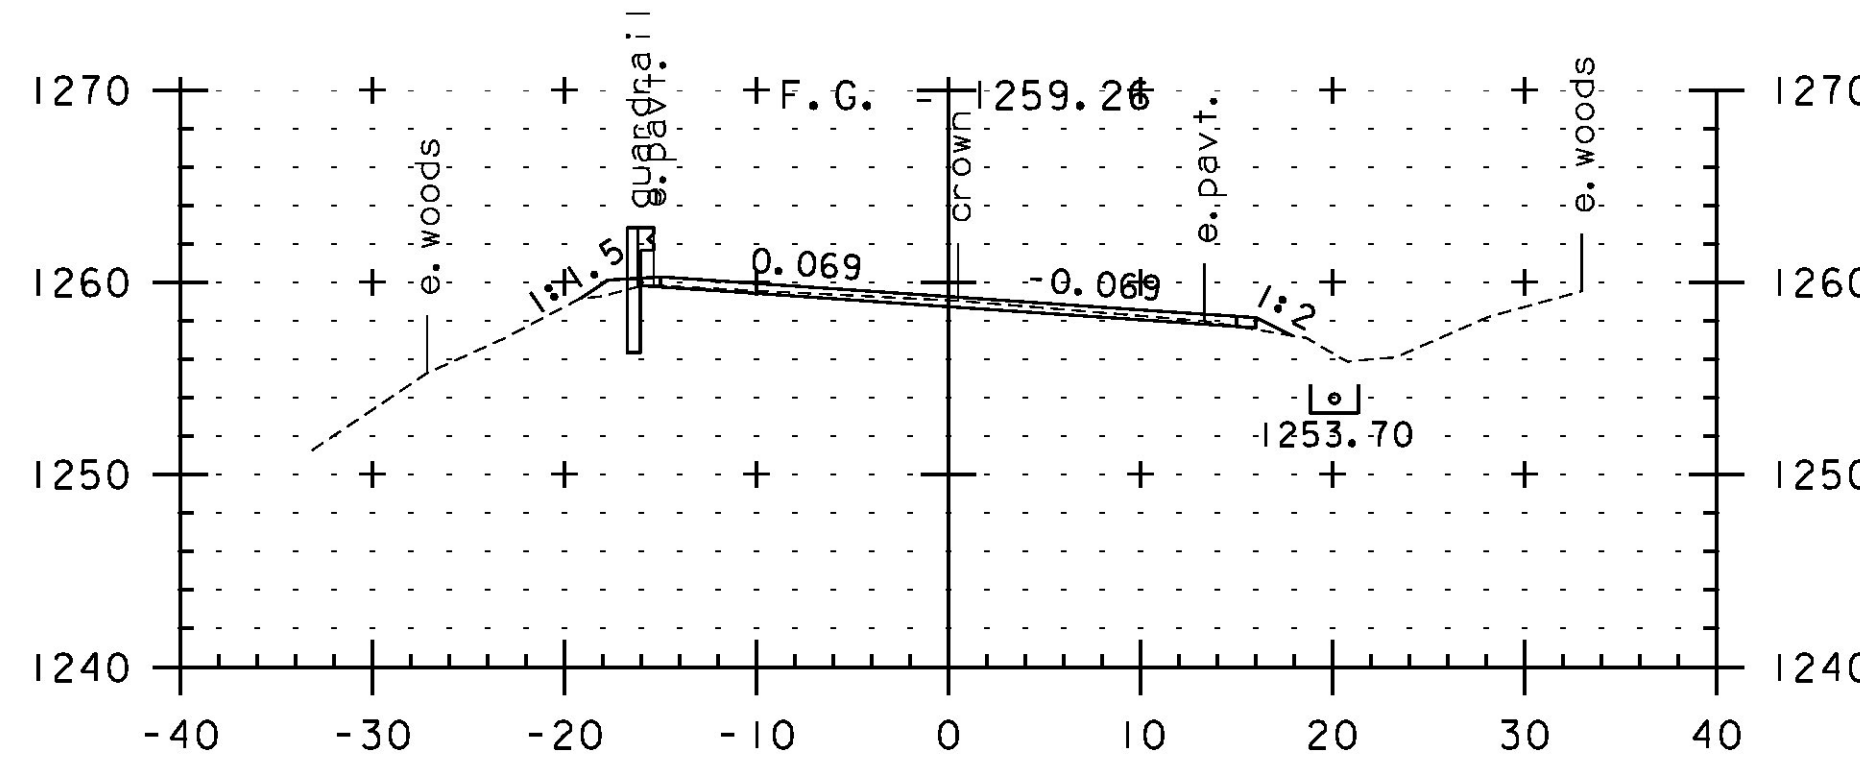


52+00

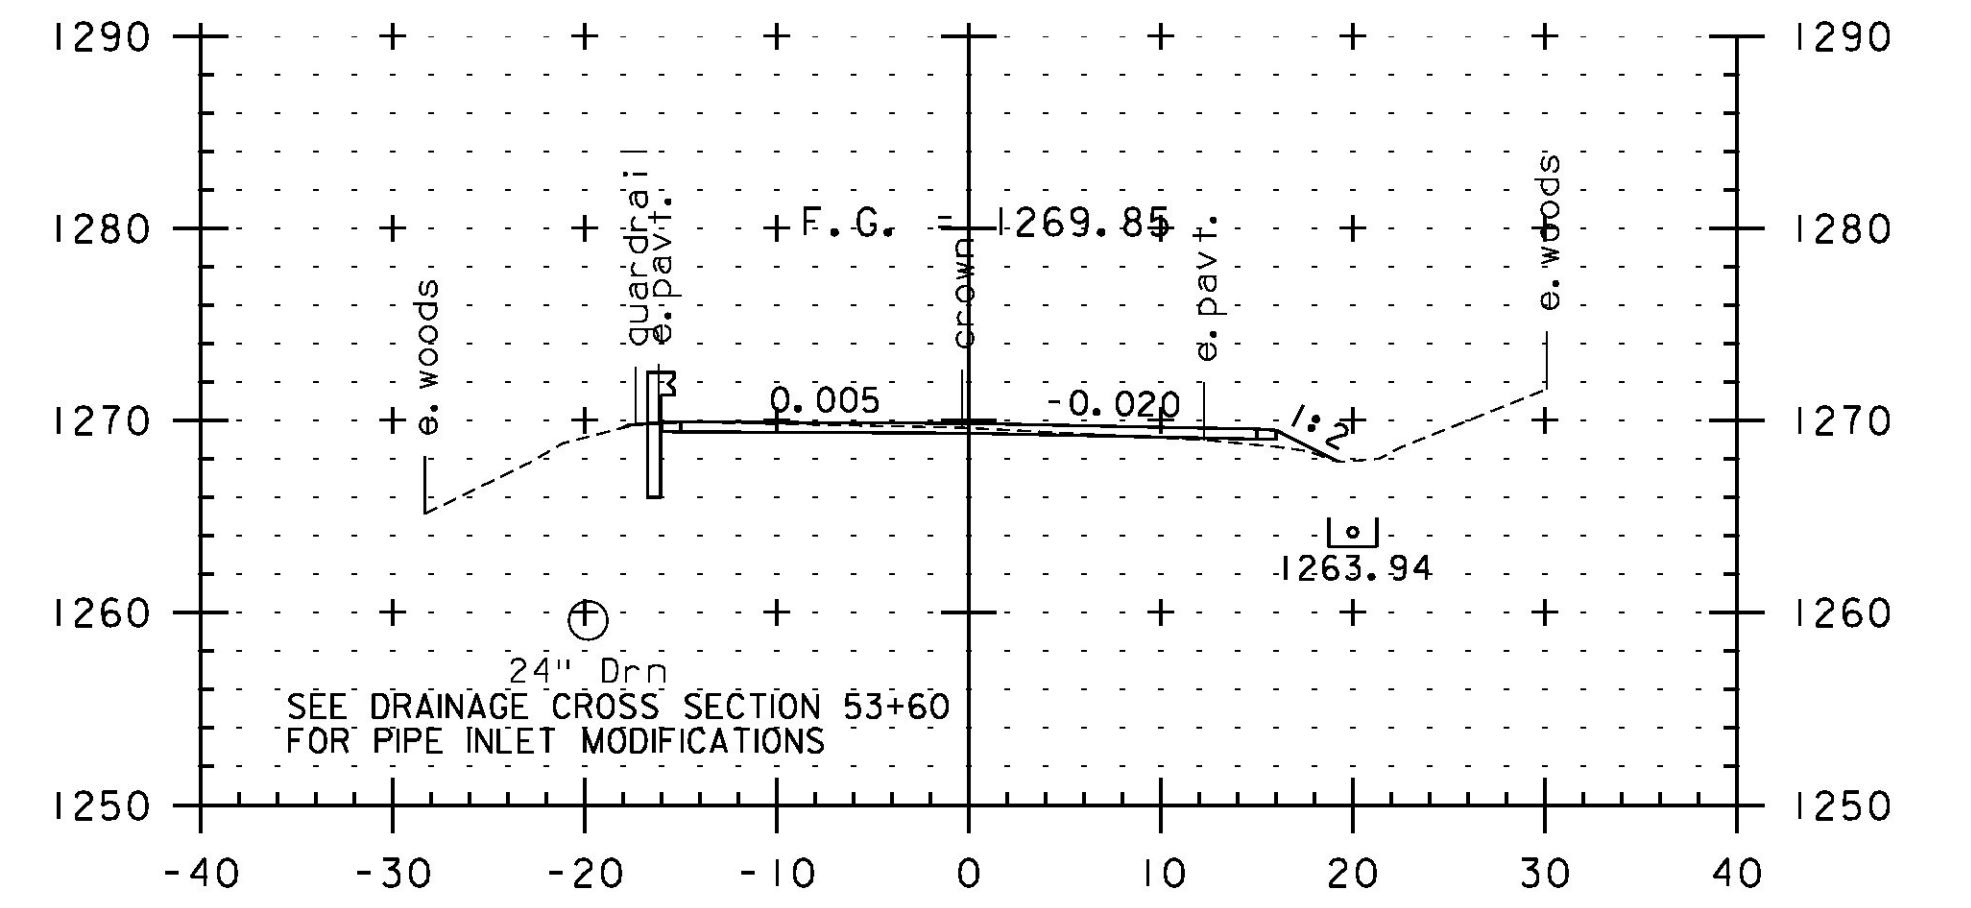


53+50

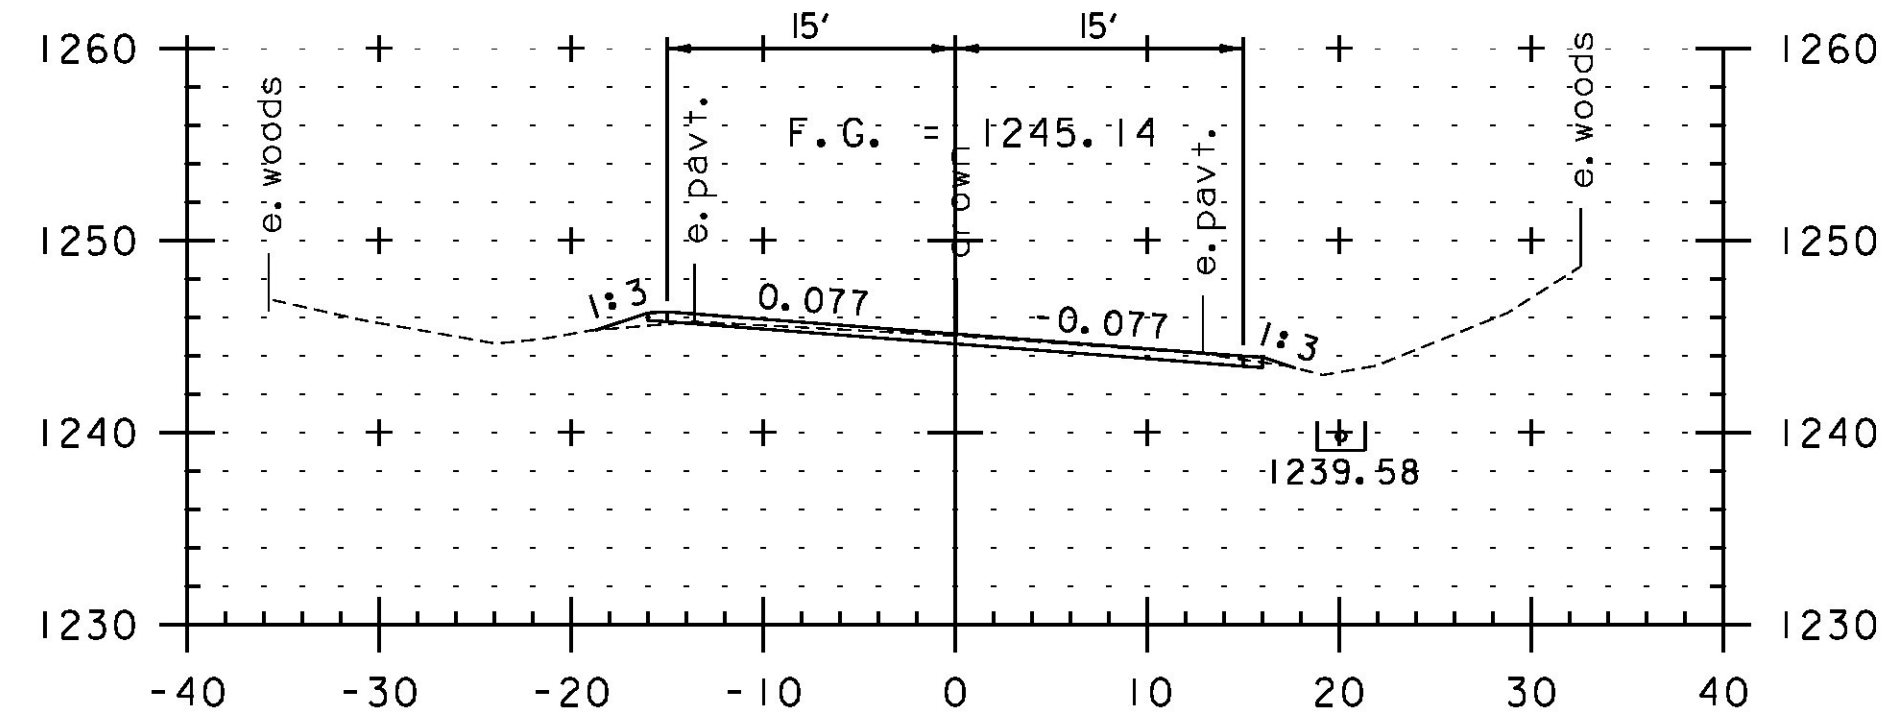

50+00

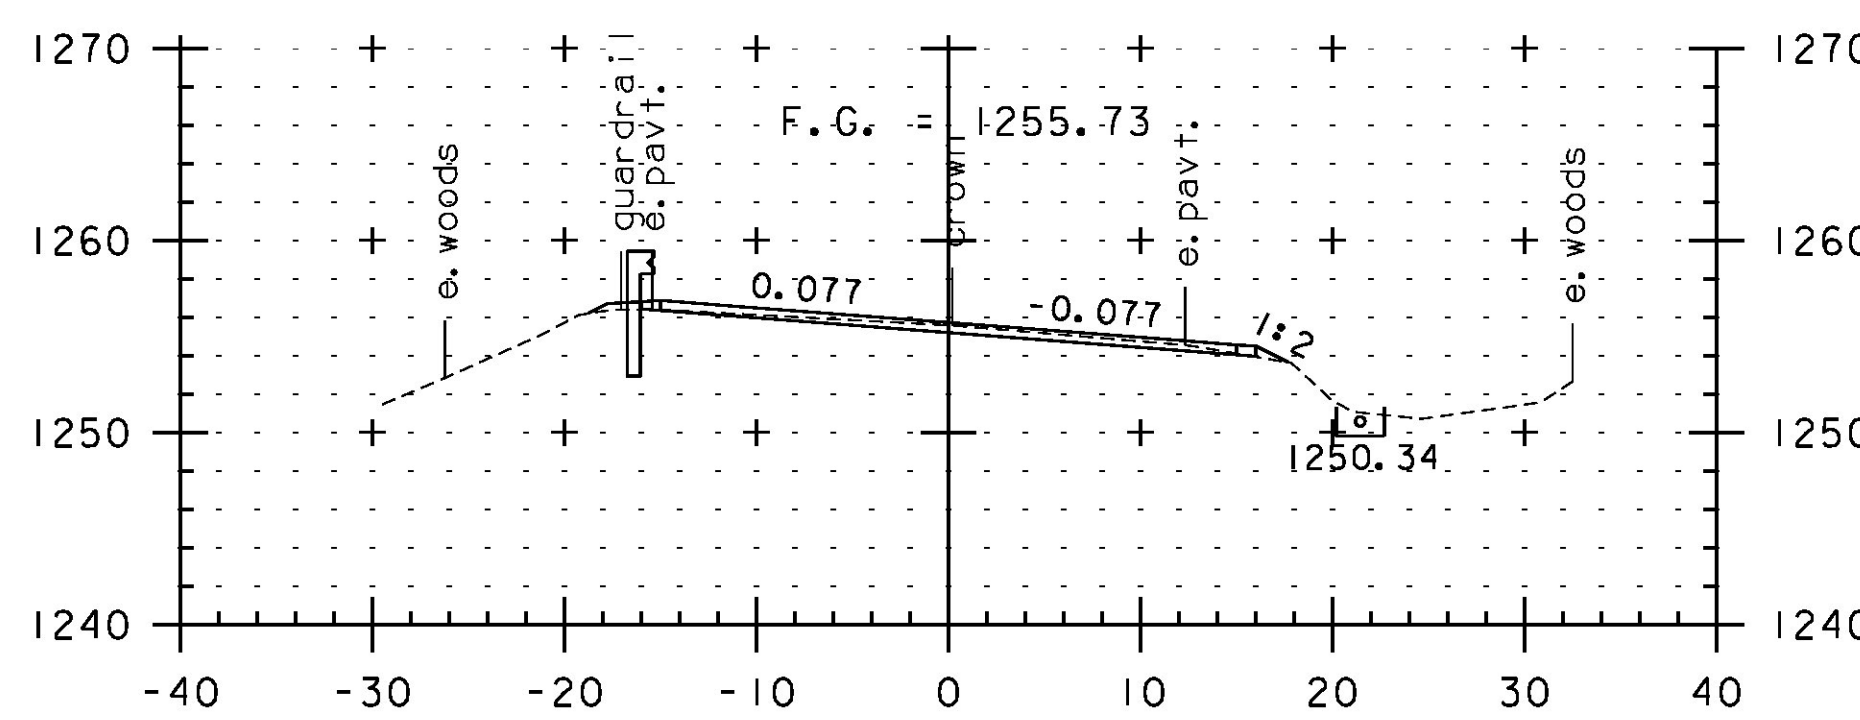

51+50

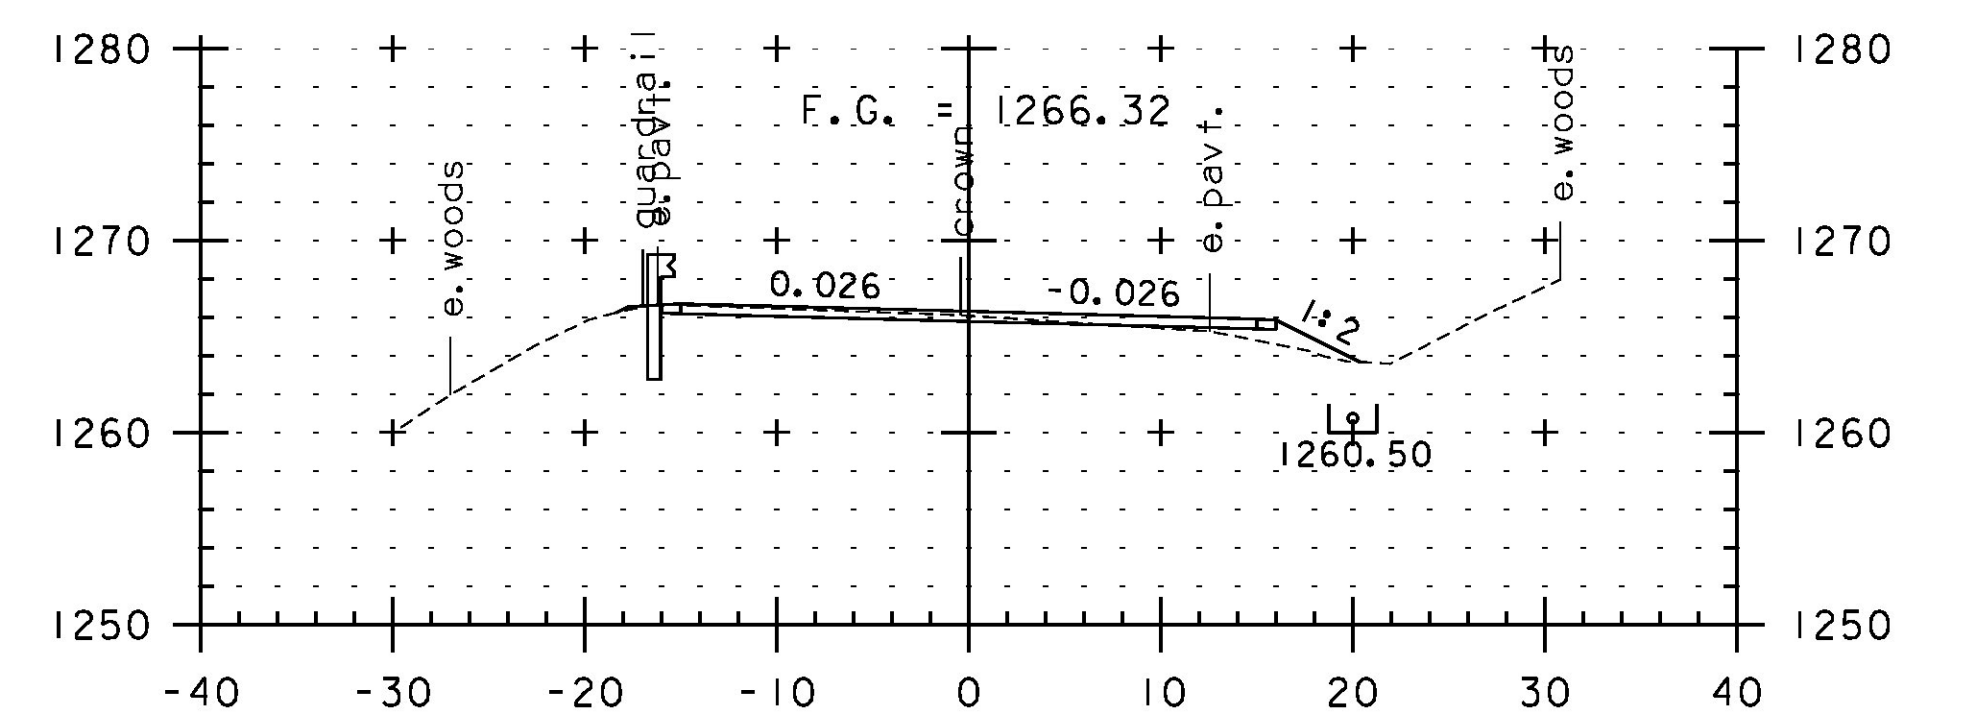

53+00



SCALE IN FEET

STA. 50+00 TO STA. 54+00

PROJECT NAME:	JAY-TROY	PLOT DATE:	5/16/2014
PROJECT NUMBER:	STP 2315(I)	DRAWN BY:	W. GORDON
FILE NAME:	z10b232xs.dgn	CHECKED BY:	P. SHEDD
PROJECT LEADER:	P. SHEDD	CROSS SECTION SHEET	4
DESIGNED BY:	N. LEMAY	SHEET	140 OF 244