




55+50

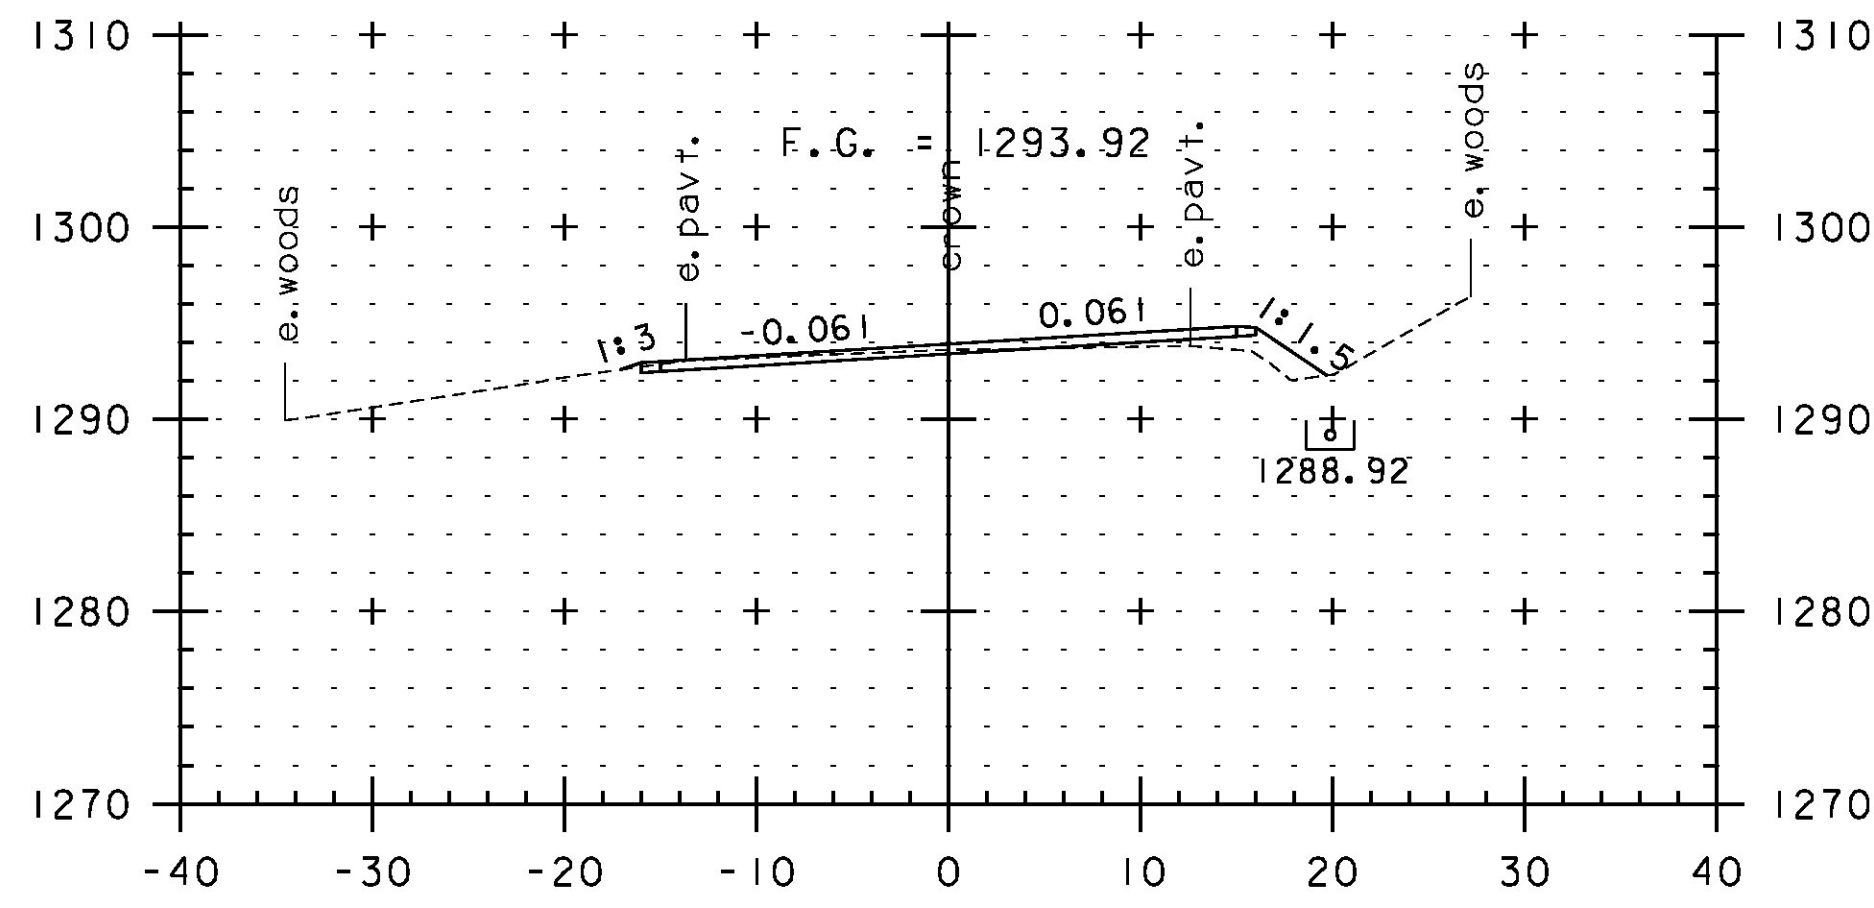


57+00

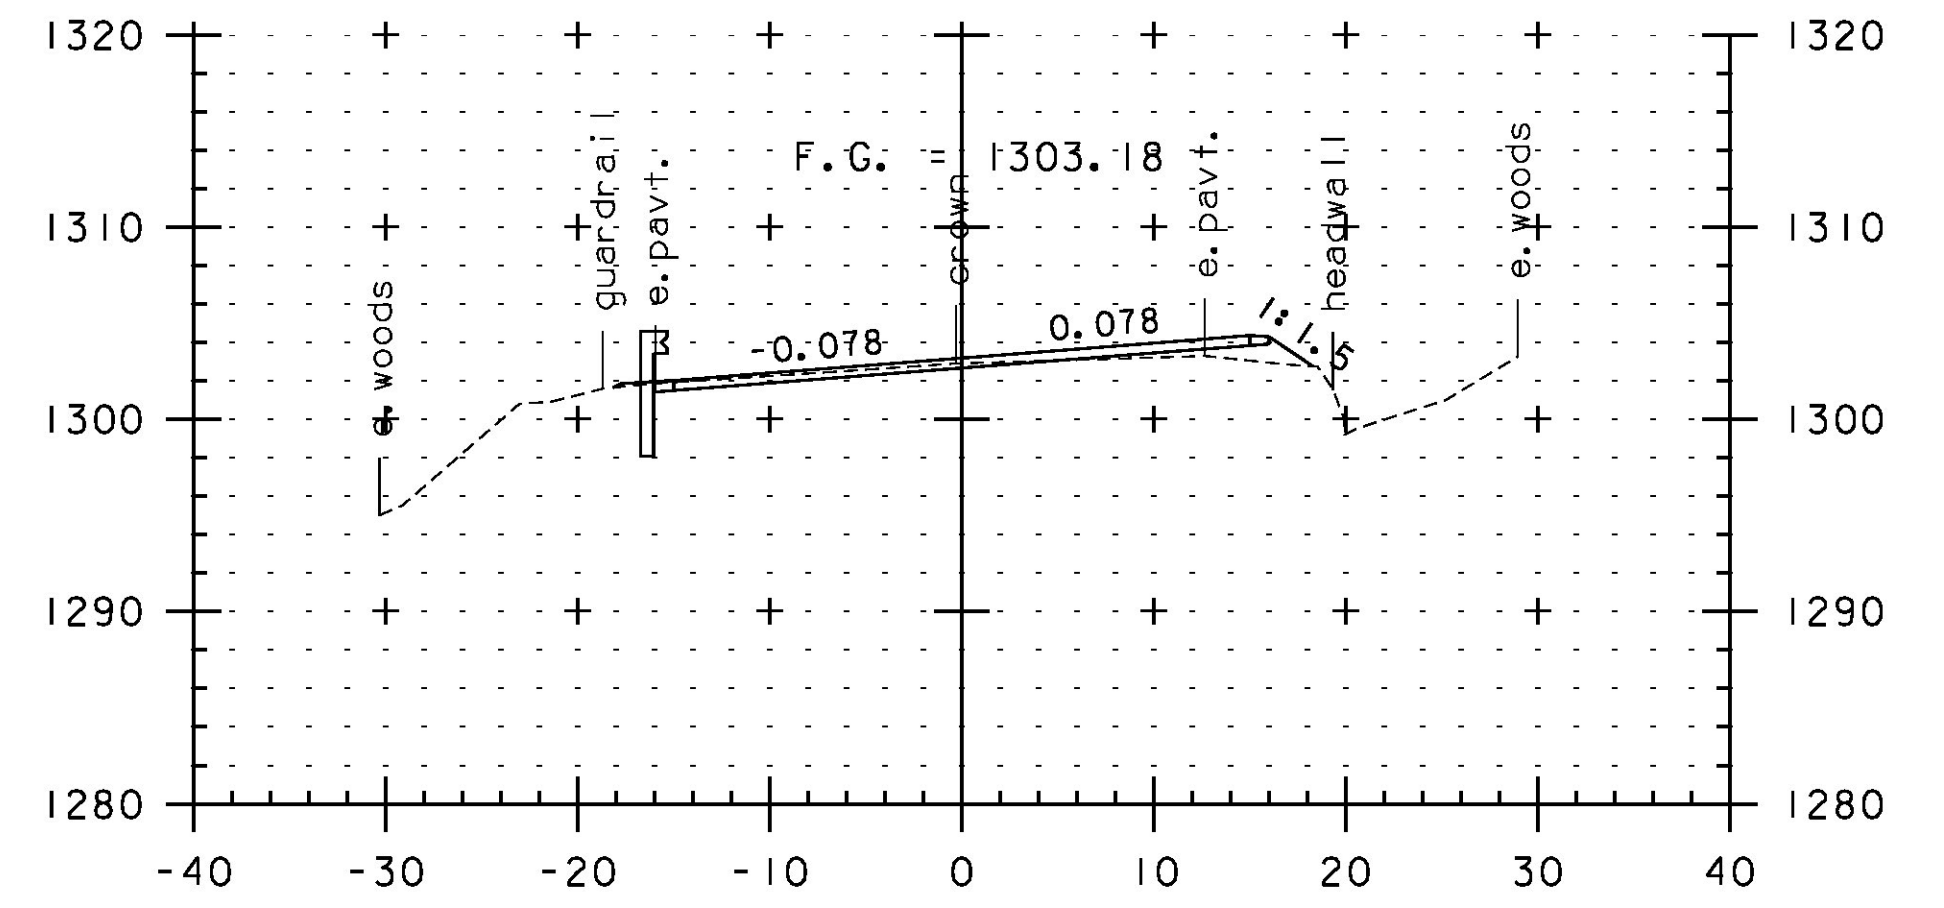


58+50

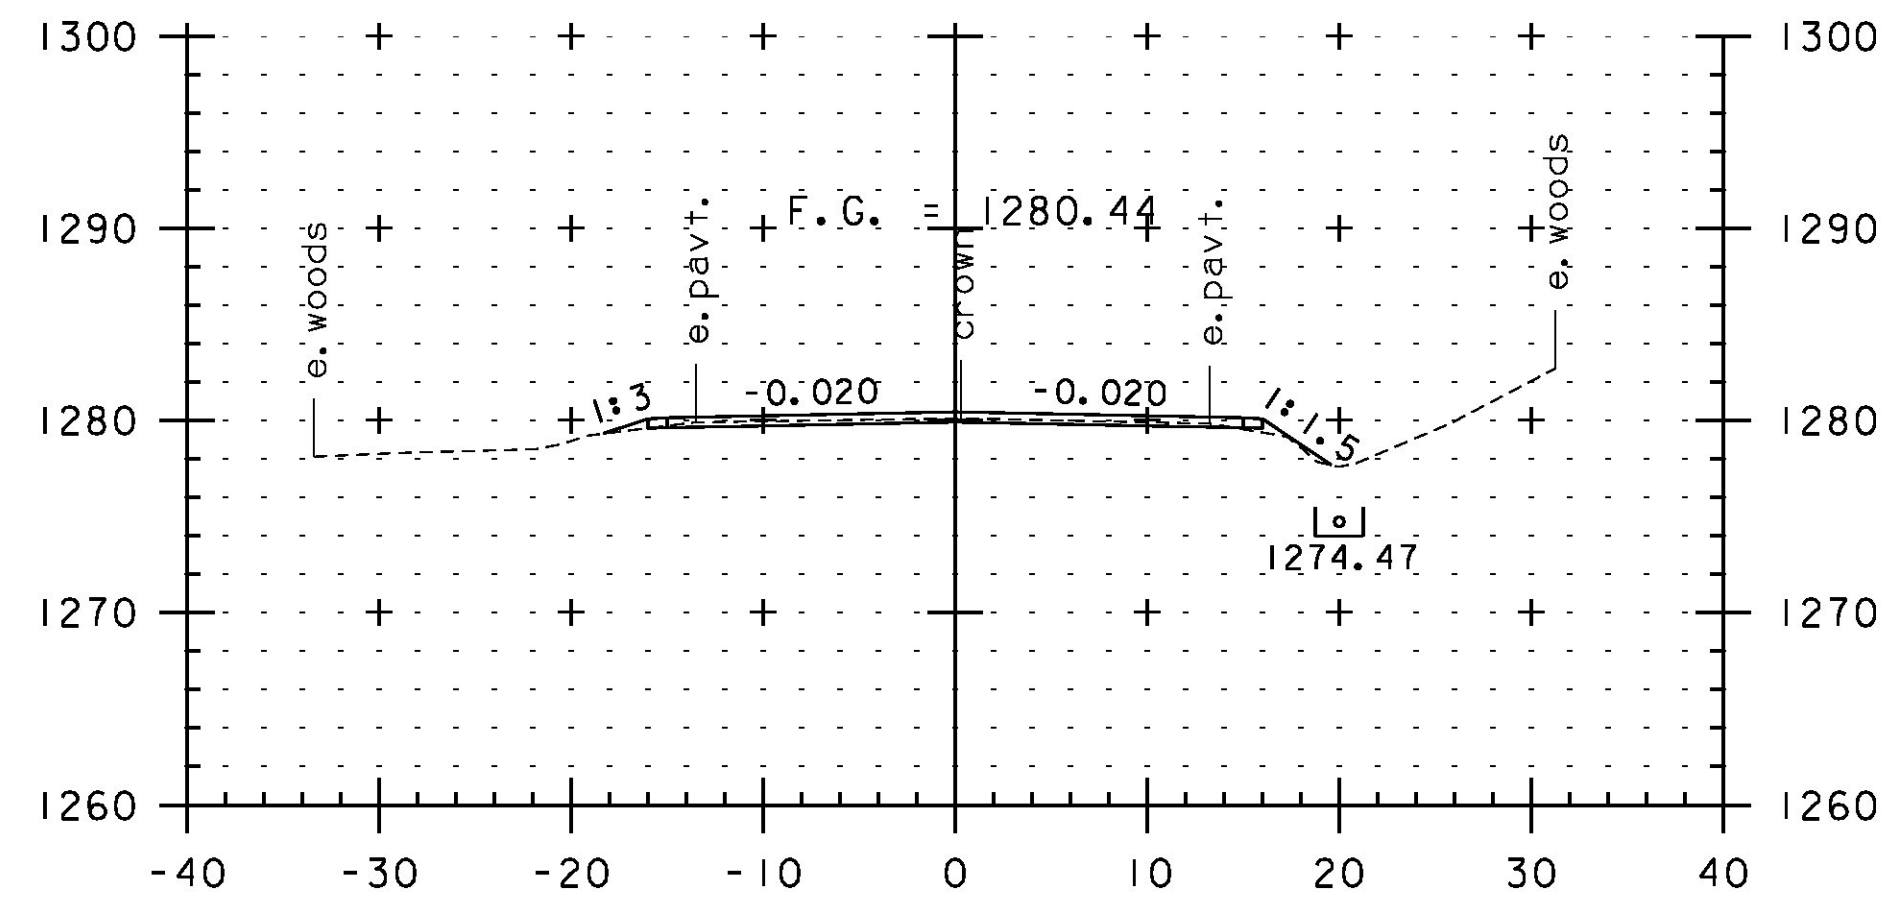


55+00

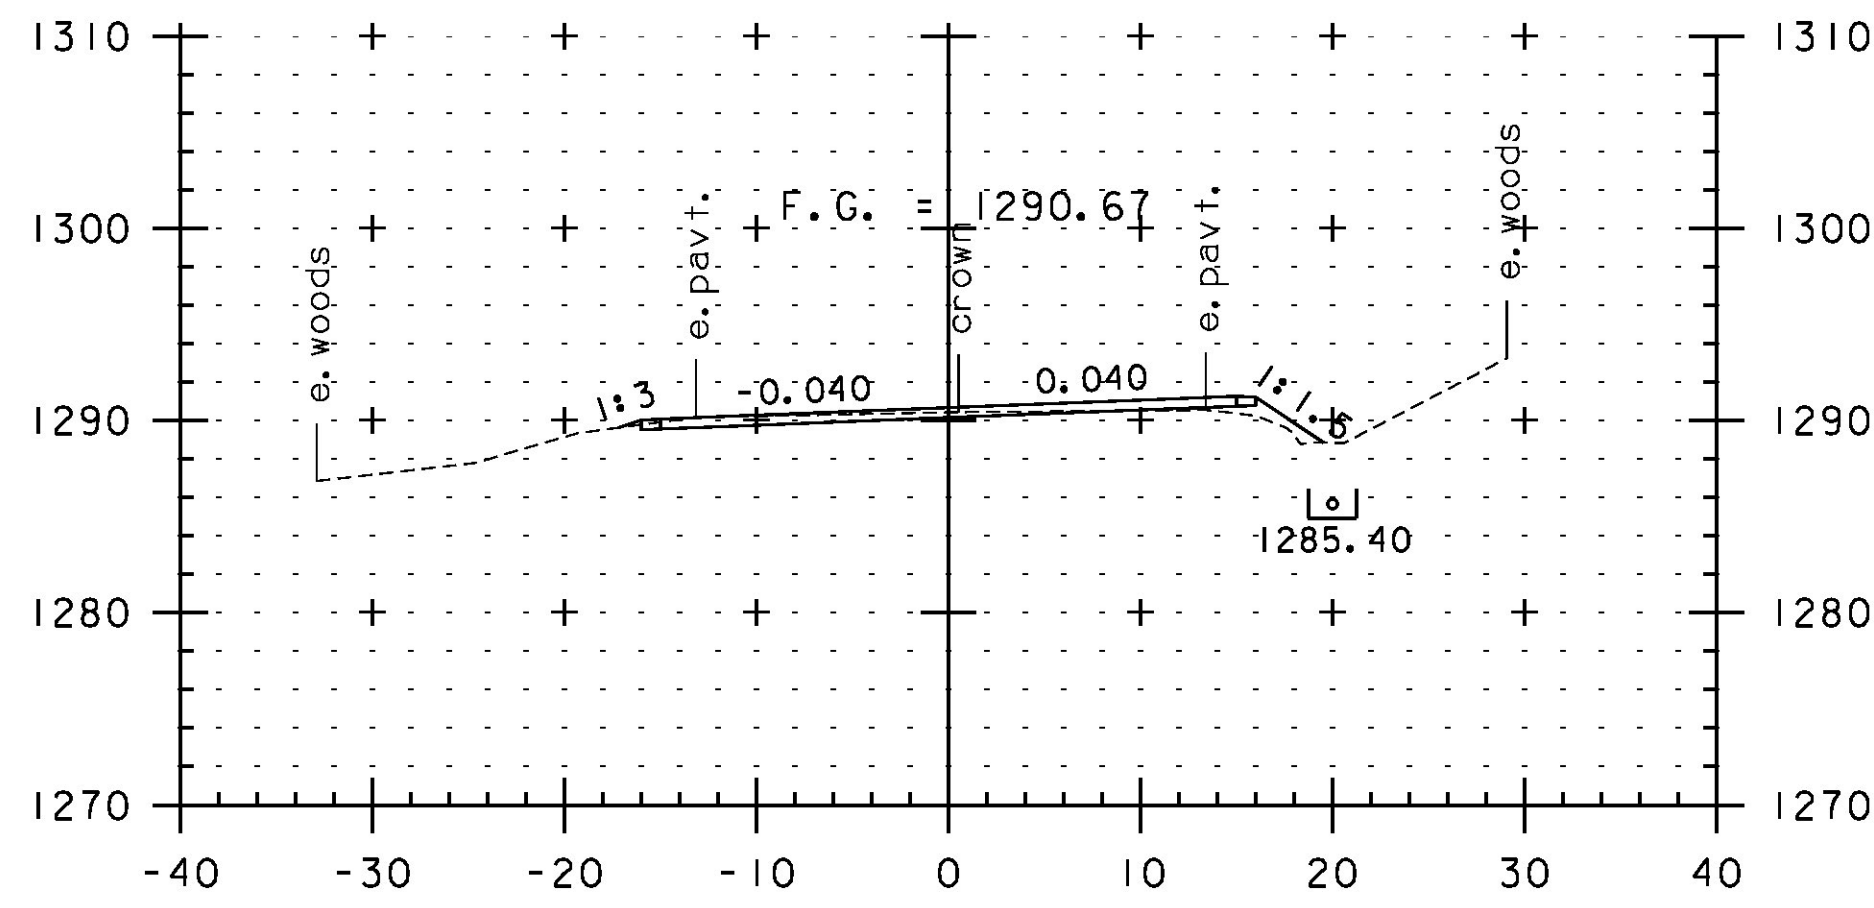


56+50

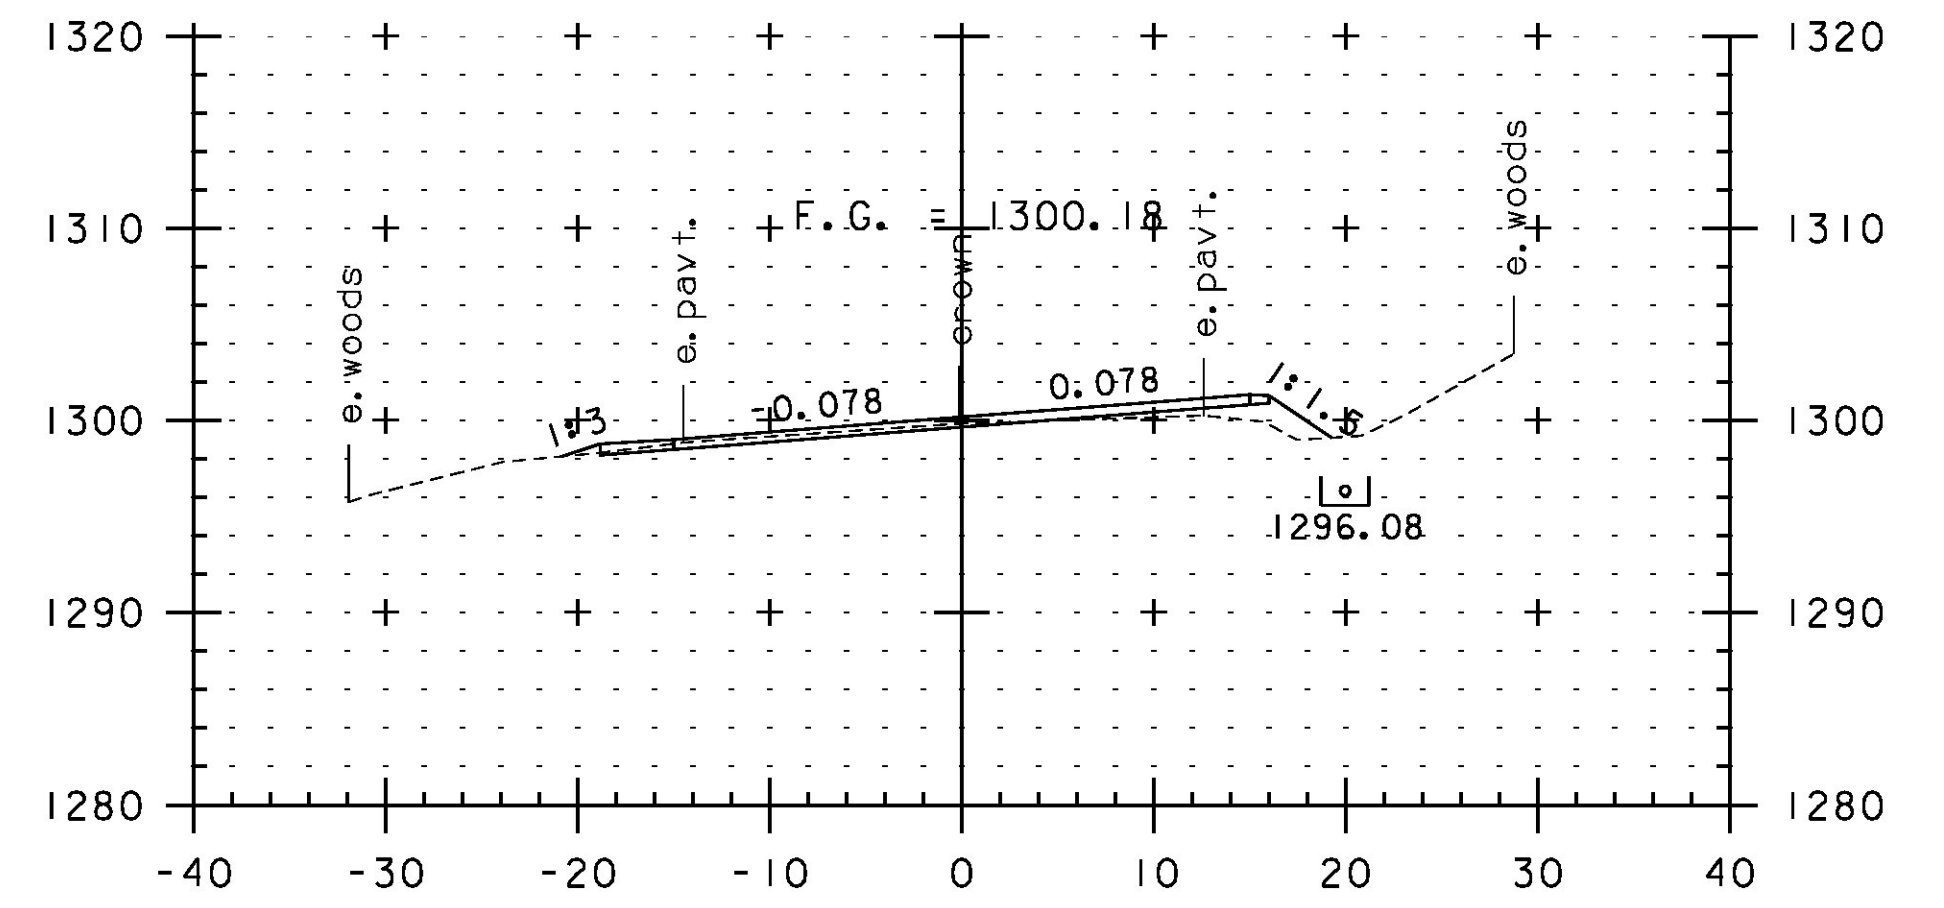


58+00

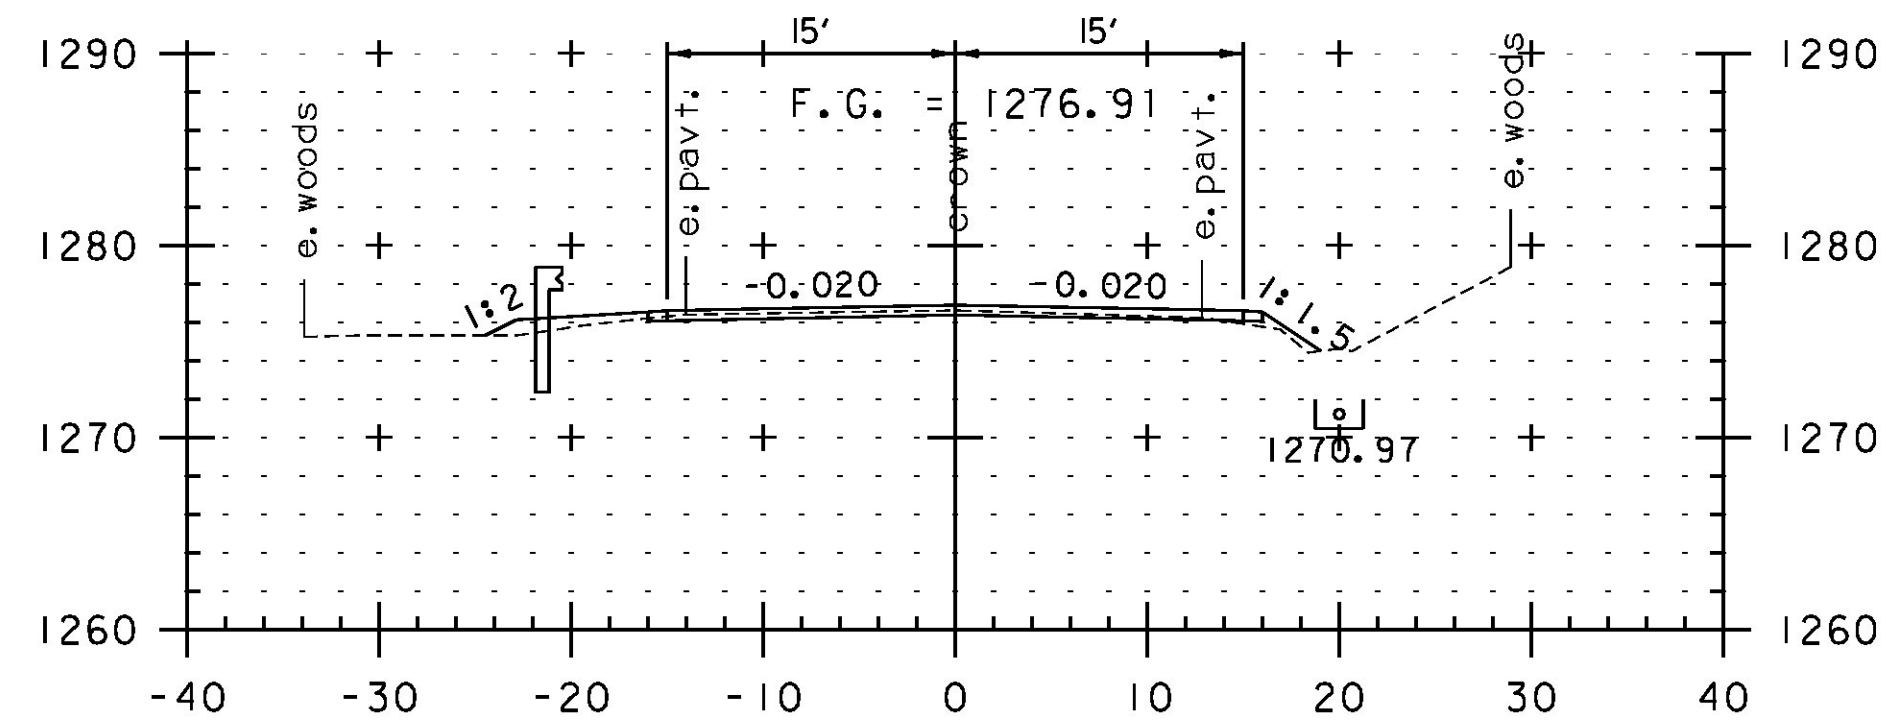

54+50

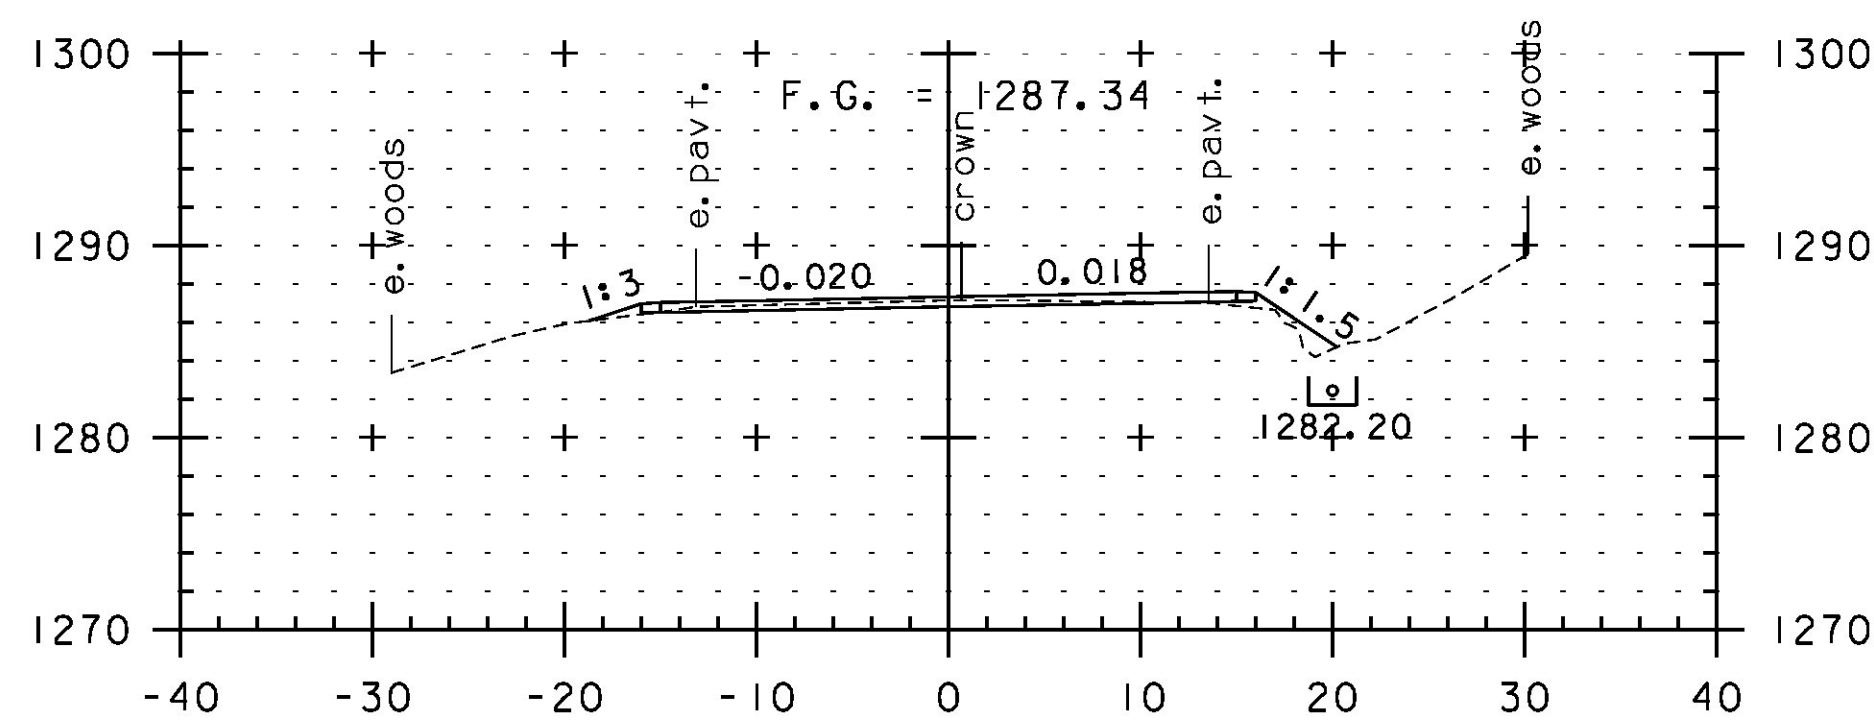

56+00

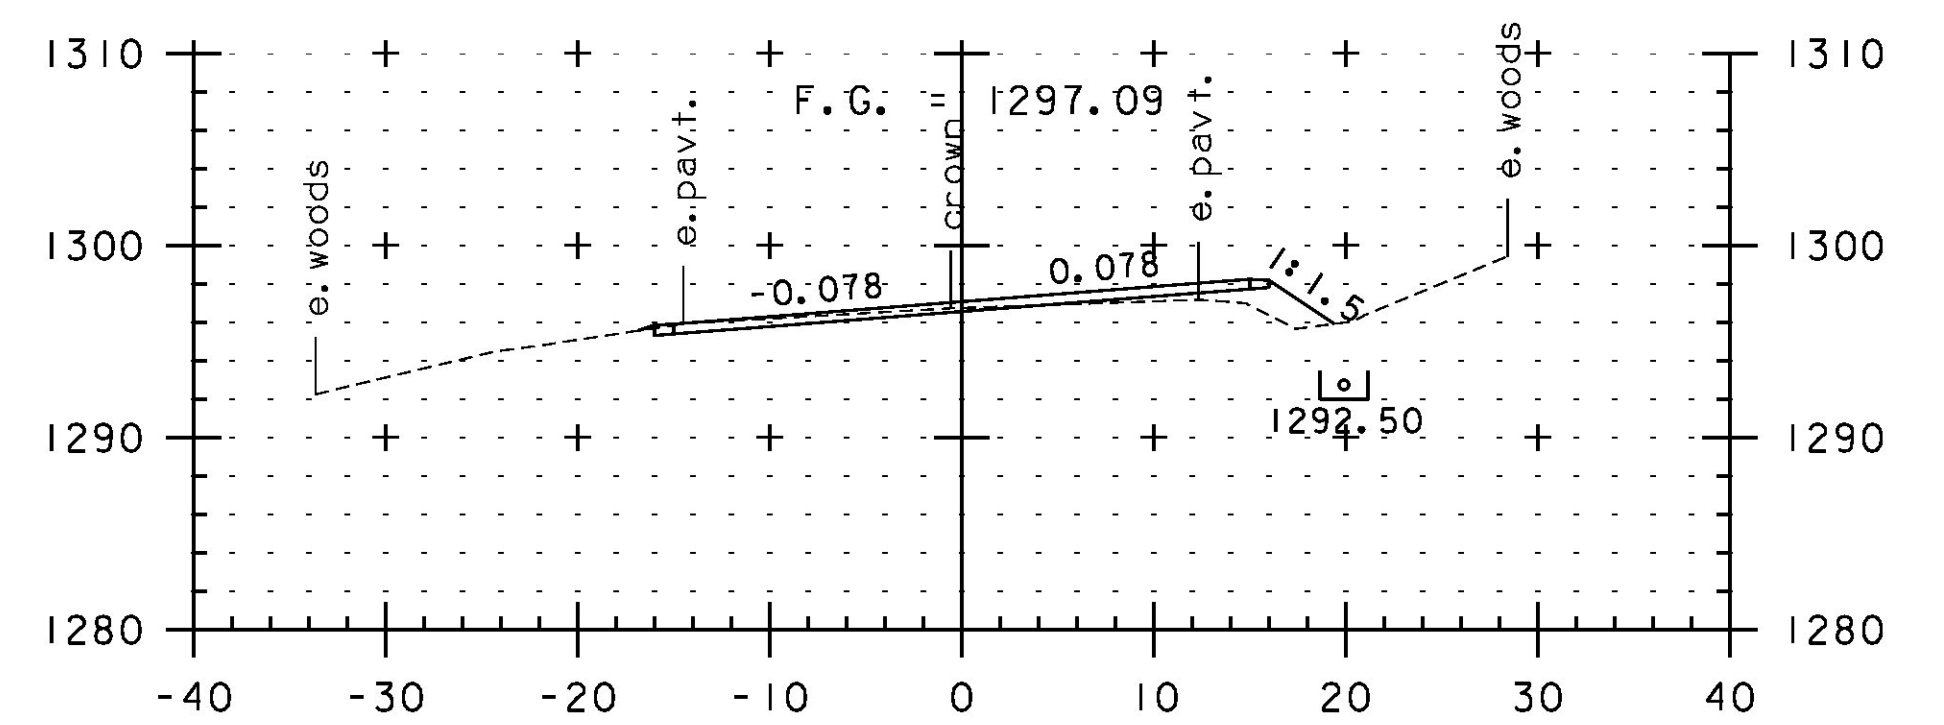

57+50



STA. 54+50 TO STA. 58+50

PROJECT NAME:	JAY-TROY	PLOT DATE:	5/16/2014
PROJECT NUMBER:	STP 2315(I)	DRAWN BY:	W. GORDON
FILE NAME:	z10b232xs.dgn	DESIGNED BY:	N. LEMAY
PROJECT LEADER:	P. SHEDD	CHECKED BY:	P. SHEDD
CROSS SECTION SHEET 5		SHEET	141 OF 244